



2 curtainwall detail Δ ADDENDUM #2
2/A902 REVISED

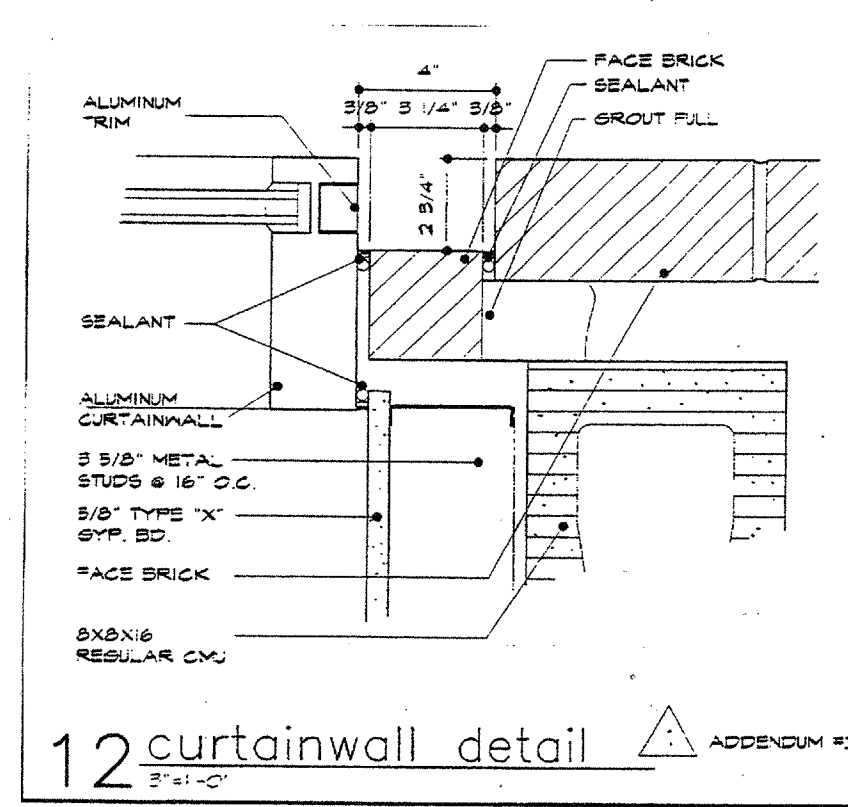

12 curtainwall detail Δ ADDENDUM #2
12/A902 REVISED

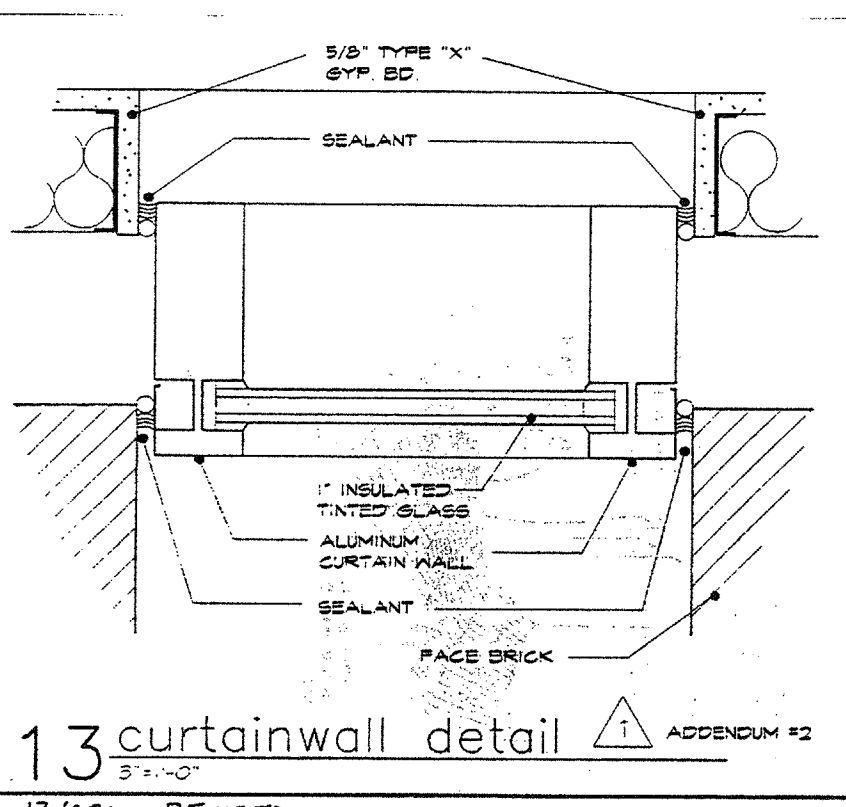

13 curtainwall detail Δ ADDENDUM #2
13/A902 REVISED

REVISED PER ADDENDUM NO. 2, DATED 03-11-02