


SHEET NO.	
BASE	
COMPOSITE	
DATE	
BY	
CHECKED	
APPROVED	

ADDISON RECREATION CENTER
 3900 BELTWAY DRIVE
 ADDISON, TEXAS

ADDISON

The Benham Group Dallas
 architects
 engineers
 planners
 1341 w. mockingbird ln.
 suite 517 e
 dallas, texas

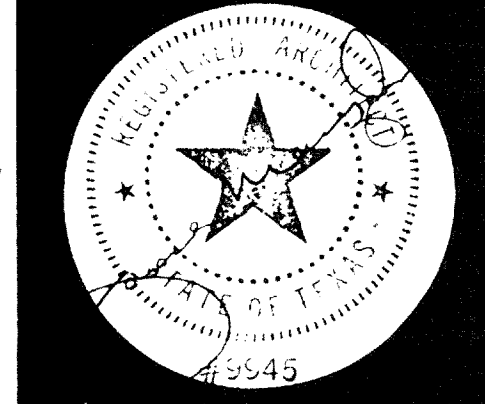


sheet title
SECOND FLOOR PLAN

drawn H. ADAMS
 chkd H. ADAMS
 date 3-19-86
 revisions

no. 1 date 4-2-86

sheet of **A-2**

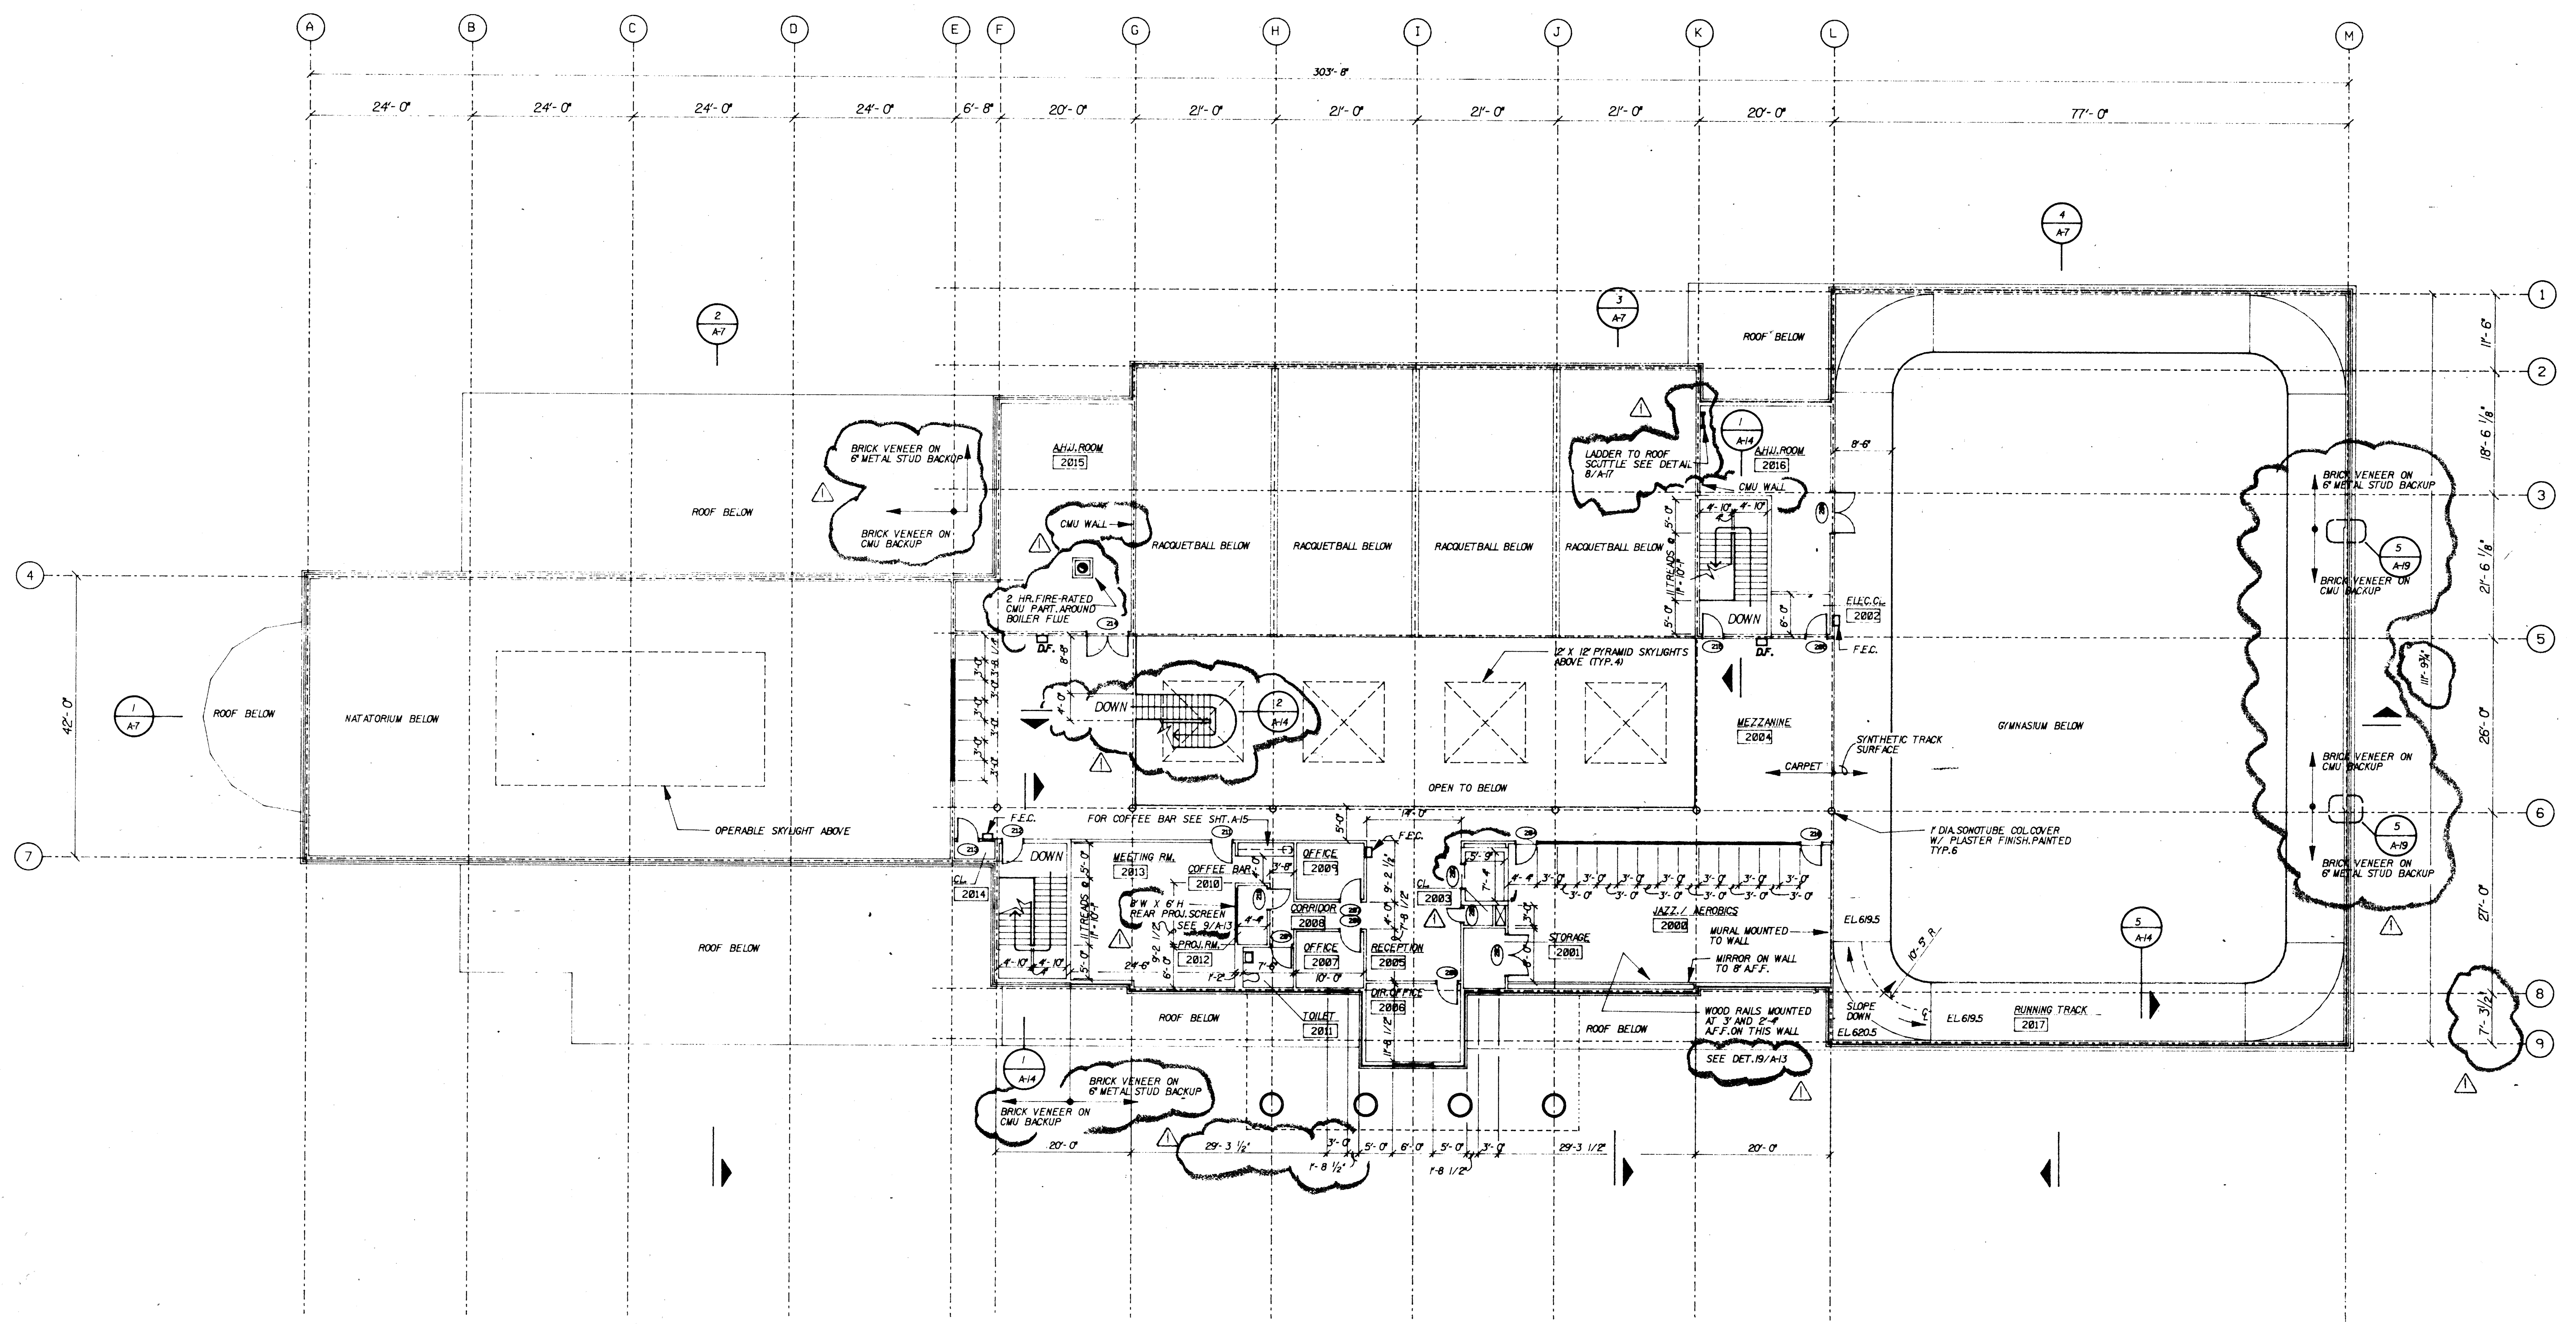

SECOND FLOOR PLAN
 SCALE: 3/32"=1'-0"

