

SHEET NO.	
BASE	
C	
D	
E	
F	
G	
H	
I	
J	
K	
L	
M	
N	
O	
P	
Q	
R	
S	
T	
U	
V	
W	
X	
Y	
Z	

**ADDISON RECREATION CENTER**  
 3900 BELTWAY DRIVE  
 ADDISON, TEXAS



**The Benham Group**  
 Dallas  
 architects  
 engineers  
 planners  
 1341 w. mockingbird ln.  
 suite 517 e  
 dallas, texas




SECOND FLOOR STEEL FRAMING PLAN

drawn by D. MESSNER  
 checked by E. KOCHIK  
 date 3-10-86

revisions

no. date  
 4-21-86

S-5

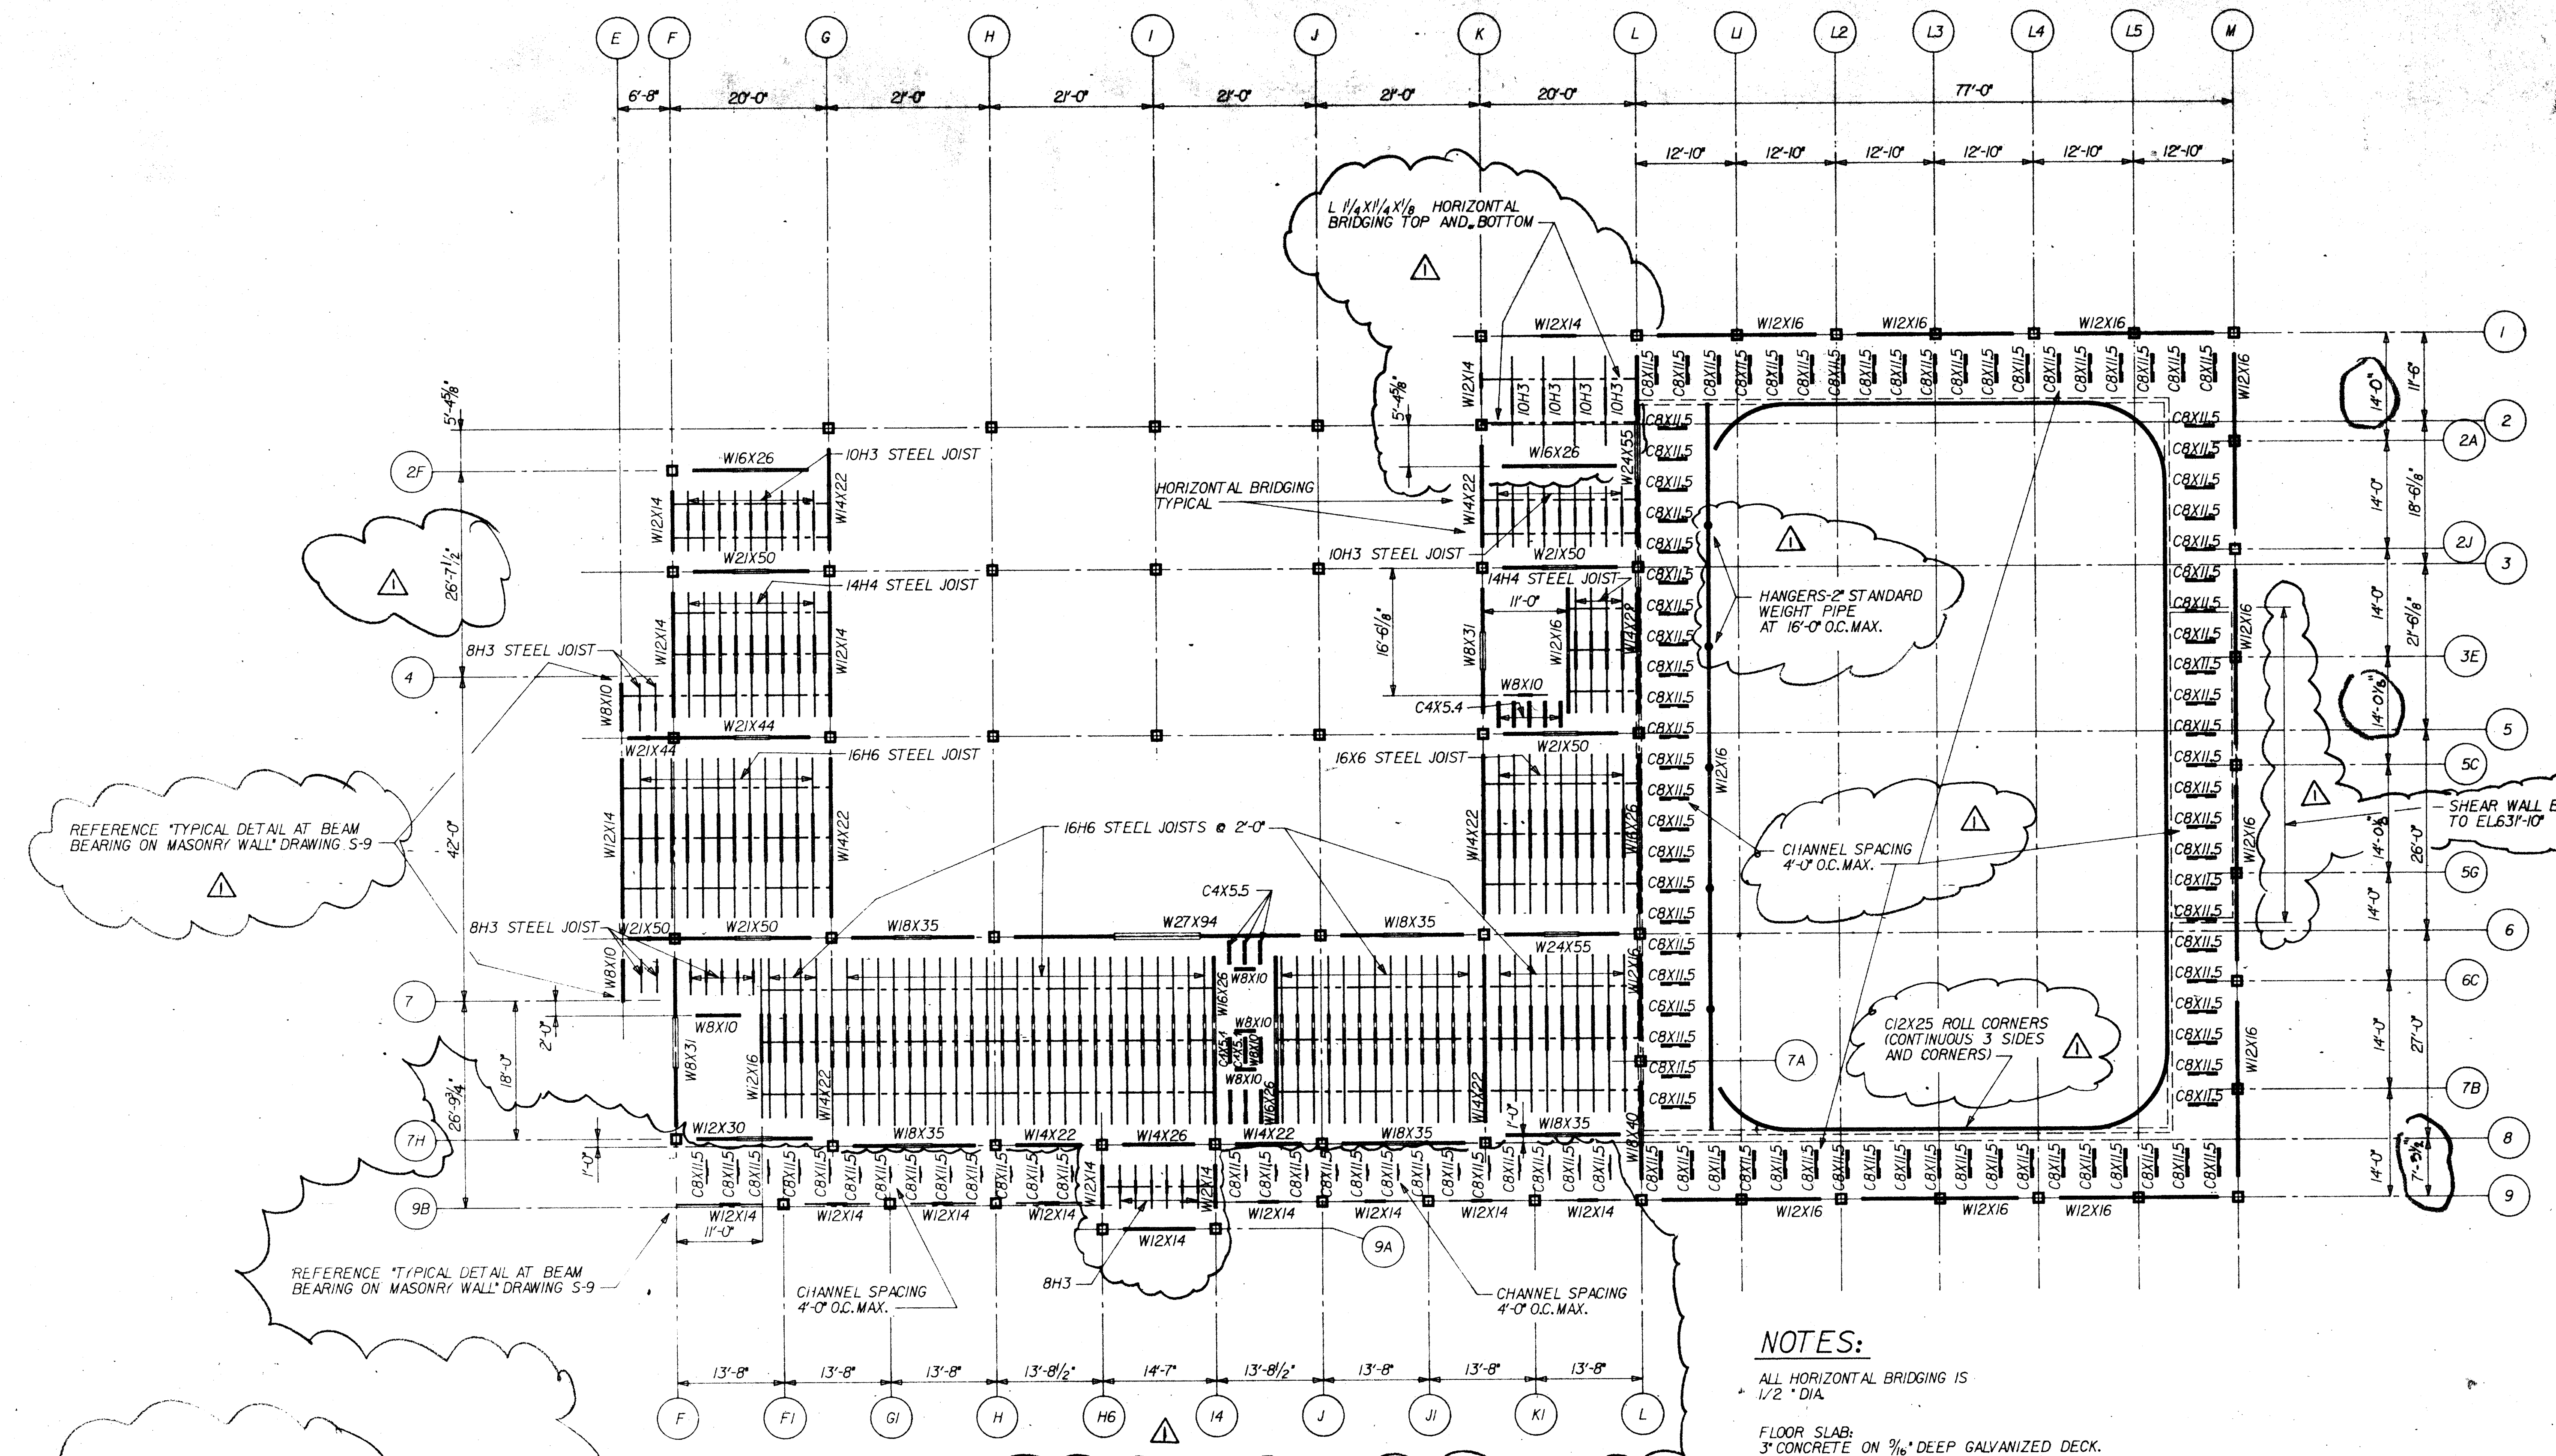


SECOND FLOOR FRAMING PLAN


FINISH FLOOR EL619'-6"  
 SCALE: 1/32" = 1'-0"

**NOTES:**

- ALL HORIZONTAL BRIDGING IS 1/2" DIA.
- FLOOR SLAB: 3" CONCRETE ON 3/16" DEEP GALVANIZED DECK. REINFORCED WITH 6X6 W29XW29 WWF.

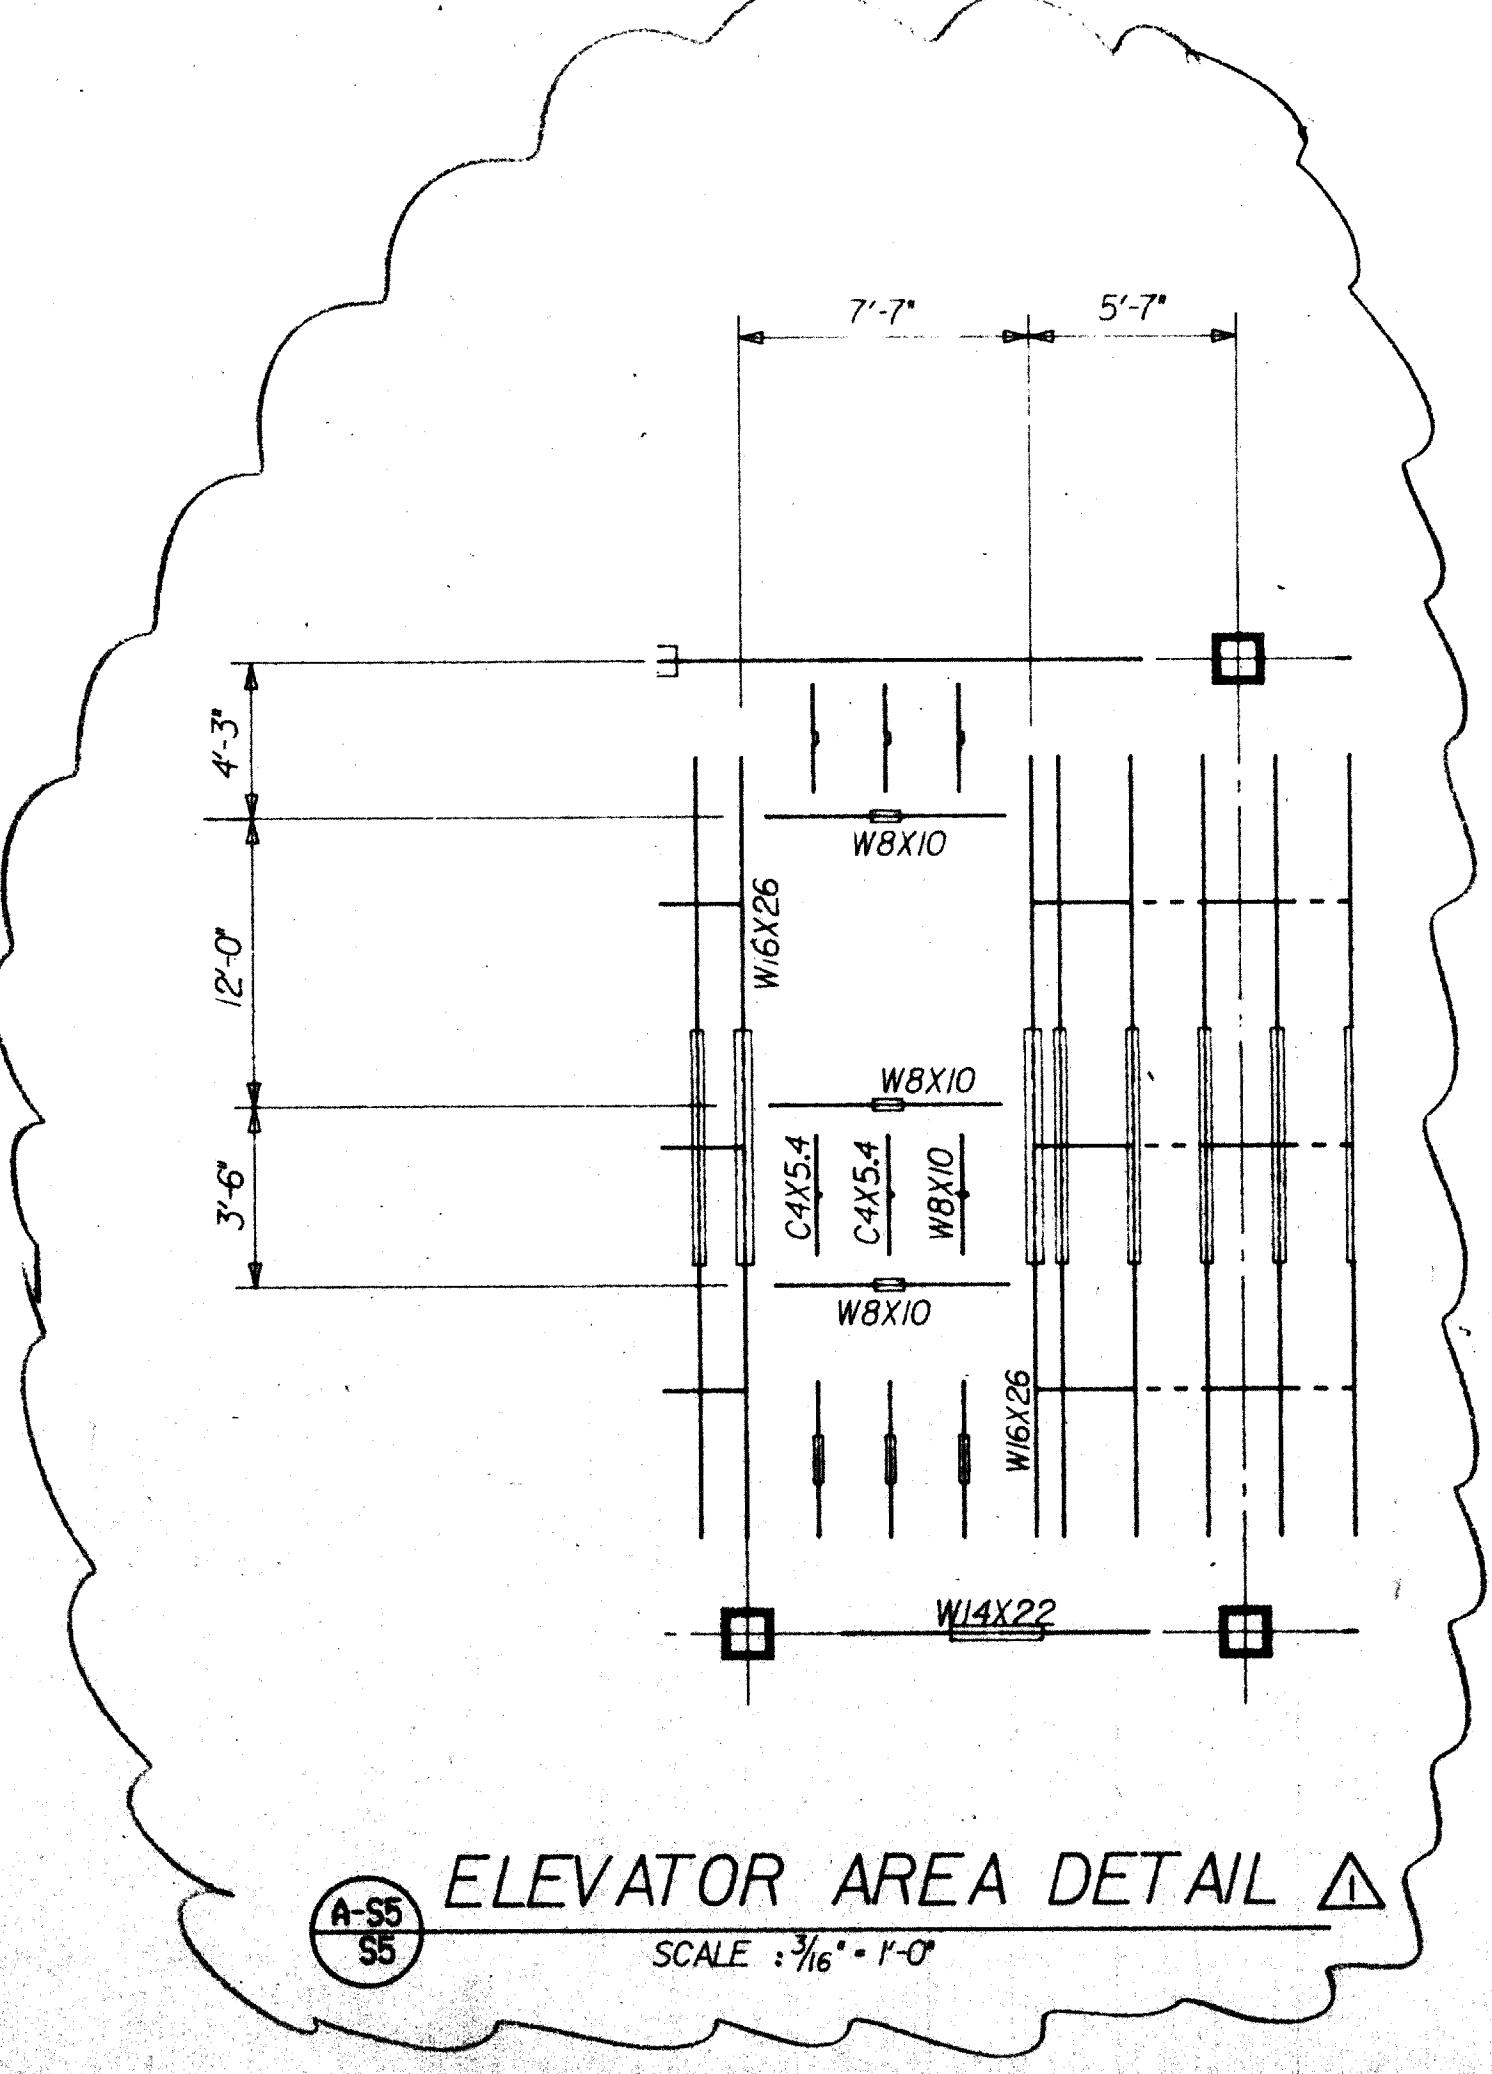

ELEVATOR AREA DETAIL  
 SCALE: 1/16" = 1'-0"

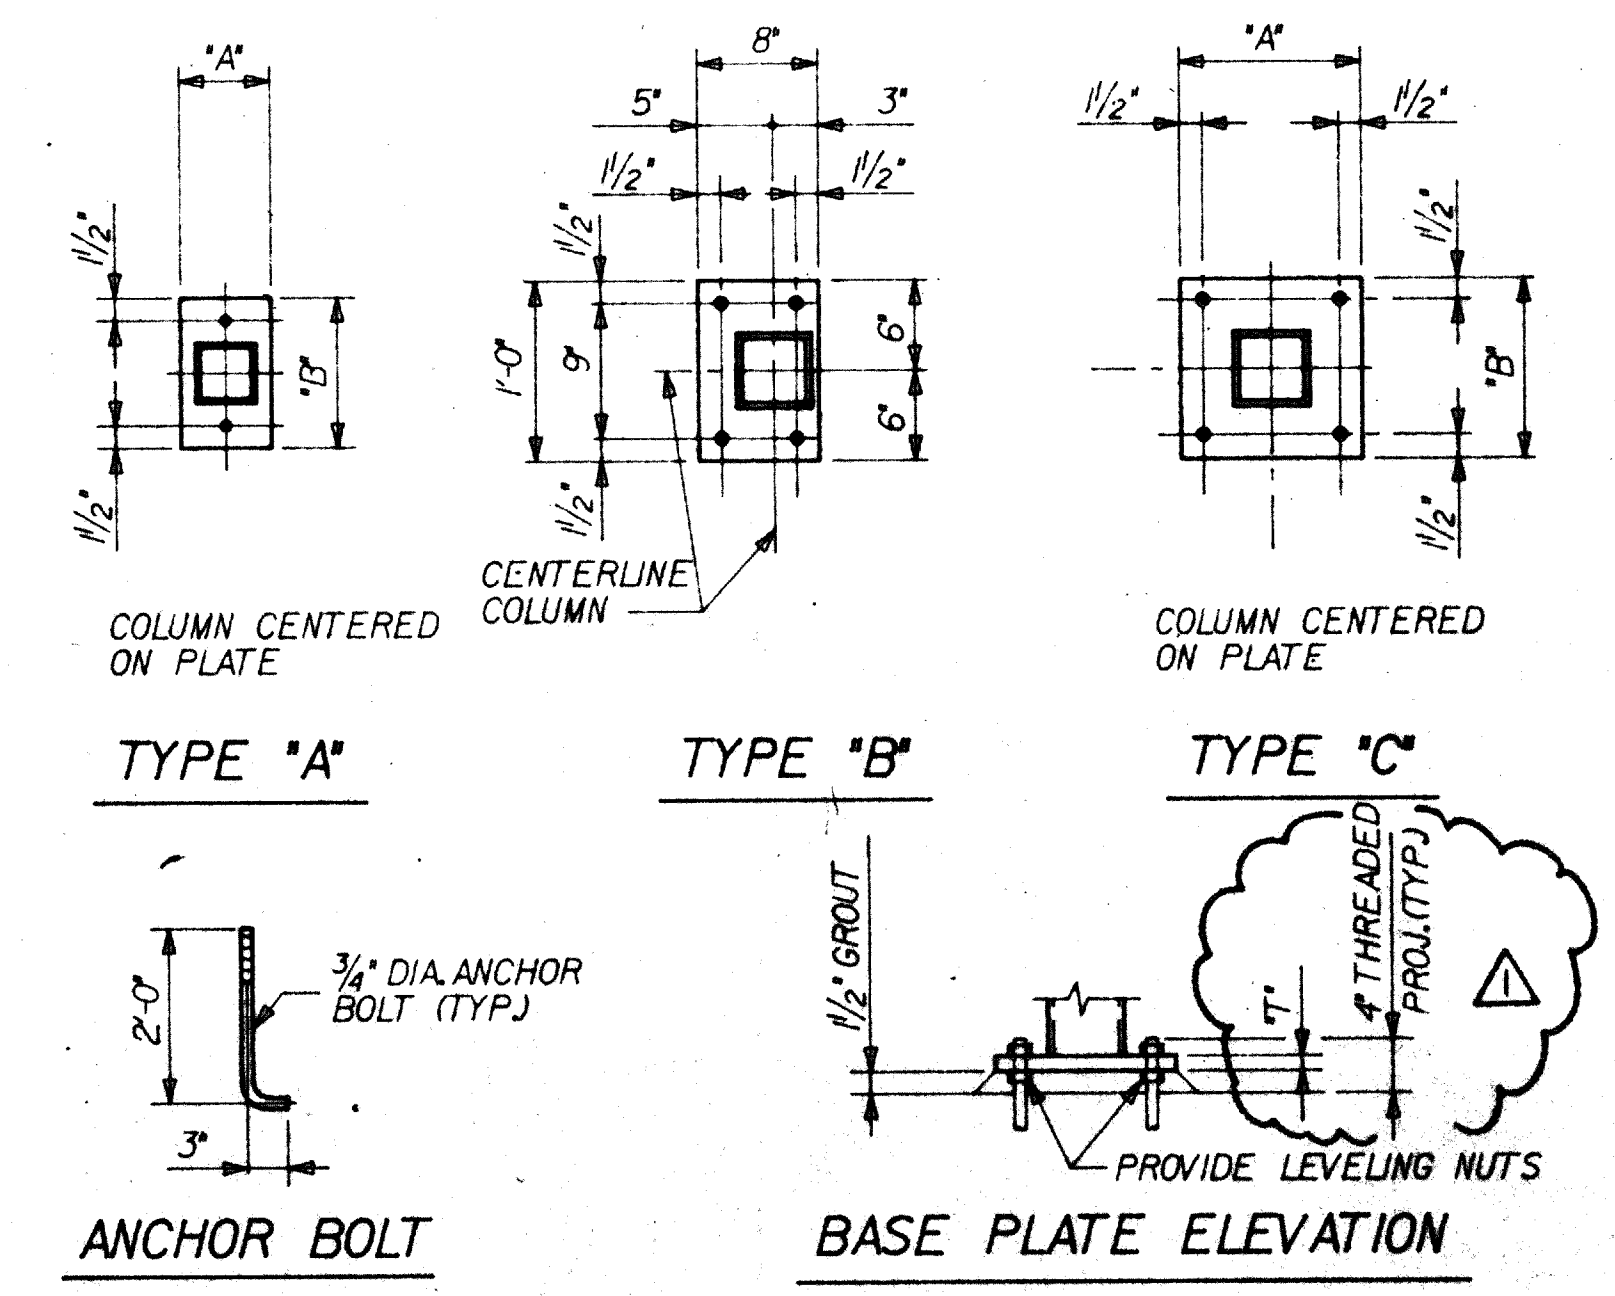

BASE PLATE AND ANCHOR BOLT DETAILS  
 NO SCALE

COLUMN SIZE	DIMENSIONS			TYPE	REMARKS
	"A"	"B"	"T"		
TS4X4X3/16	6"	10"	3/4"	A	EXTERIOR
TSS5X5X3/16	7"	11"	7/8"	A	EXTERIOR
TSS5X5X1/4	8"	12"	1"	B	GRID 5C M
TSS5X5X3/16	10"	10"	3/4"	C	EXTERIOR @ GYMNASIUM
TSS5X5X1/4	10"	10"	3/4"	C	INTERIOR
TSS5X5X3/8	12"	12"	1"	C	TYPICAL INTERIOR

LOCATION	COLUMN SIZE	SECOND FLOOR ROOF		FIRST FLOOR ROOF	
		1	2	1	2
F-2F	TS4X4X3/16	J-8	G-2	J-2	F-5
F-3	TS4X4X3/16	K-3	G-3	J-3	F-6
F-7H	TS4X4X3/16	K-8	G-4	J-4	F-7
G-8	TS4X4X3/16	L-2	H-2	K-2	F-8
H-8	TS4X4X3/16	L-9	H-3	K-5	F-9
H-9	TS4X4X3/16	L-4	H-5	L-1	F-10
H-9A	TS4X4X3/16	L-9	H-9	L-2	F-11
I-9	TS4X4X3/16	M-9	M-9	M-9	F-12
J-9	TS4X4X3/16	N-9	N-9	N-9	F-13
K-9	TS4X4X3/16	O-9	O-9	O-9	F-14
L-9	TS4X4X3/16	P-9	P-9	P-9	F-15
M-9	TS4X4X3/16	Q-9	Q-9	Q-9	F-16