


NOTE: PROVIDE 20 TOTAL FIRE EXTINGUISHERS TO BE LOCATED ON SITE BY ARCHITECT IN BOTH THE CONFERENCE CENTER AND THE THEATER.

LEVEL ONE FLOOR PLAN

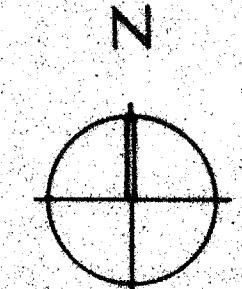

See Sk 35 ABC For CHA detail

Sk 34 for brickwork detail

Sk 15 for see panel location



ACC ADDISON ACT

OWNER Town of Addison	LANDSCAPE The Kallans Group 377-776-1417	STRUCTURAL Ellisor, Tanner 214-387-8393	HISTORIAN Alan Mason 214-891-782	Issue ISSUE FOR BID 8-17-90	Category 4	Subcategory 2	Sheet 1
ARCHITECT Cunningham Architects 2700 Fairmount Dallas, Texas 75201 214-855-9772	THEATRE CONSULTANT MEP Systems 203-431-3949 214-855-9772	M.E.P. MEP Systems 214-754-4741	LIGHTING Parade Hill Wilson 214-823-8542				
	INTERIORS CRSS 713-652-2000	CIVIL Kurtz & Associates 214-680-3222	GRAPHICS Horvath Design 214-854-8978				