



- PLAN NOTES:**
1. FINISH FLOOR ELEVATION = 92'-0" (U.N.O.)
 2. SEE SHEET 3.1.1 FOR GENERAL NOTES.
 3. SEE SHEET 3.4.1 FOR PIER SCHEDULE AND TYPICAL PIER DETAILS
 4. SEE SHEET 3.4.1 FOR TYPICAL FOUNDATION DETAILS
 5. FLOOR SLAB IS 6" SLAB ON GRADE REINFORCE WITH #4 AT 12" (EA. WAY) AT MID DEPTH. SEE SOILS REPORT FOR SUBGRADE PREPARATION.

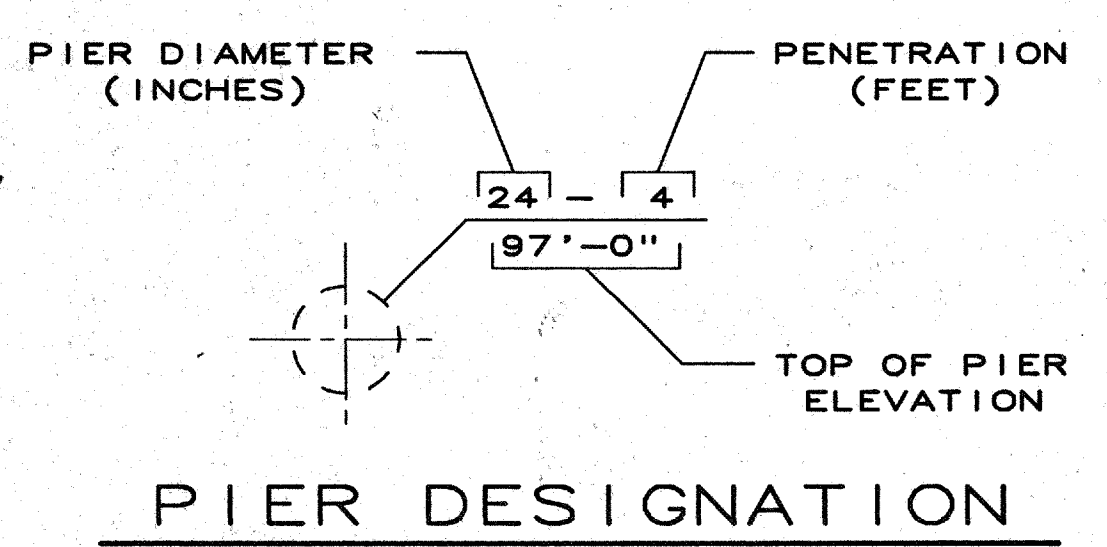

01 BASEMENT AND DIMENSIONAL LAYOUT PLAN
SCALE: 1/8"=1'-0"

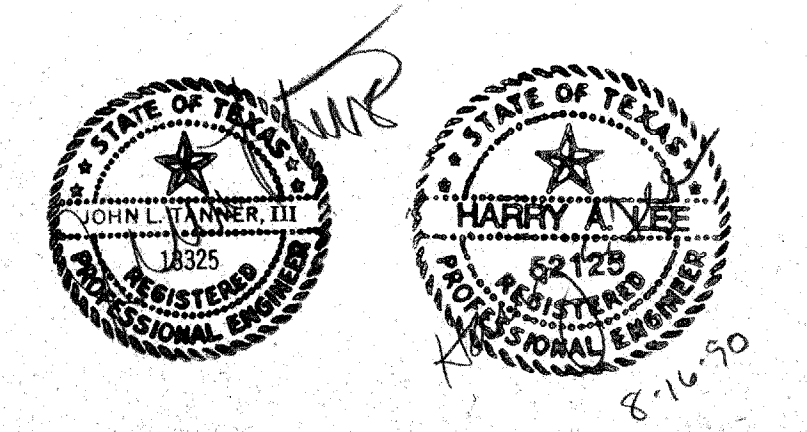

ACC ADDISON ACT

OWNER	LANDSCAPE	STRUCTURAL	HISTORIAN	Issue	Category	Subcategory	Sheet
Town of Addison The Kellams Group 317-76-417	THEATRE CONSULTANT 2700 Fairmount Dallas, Texas 75201 214-855-5272	Elhor Raner 214-387-8333	Alan Mason 214-681-7652	ISSUE FOR BID 8-17-90	3	2	3
ARCHITECT Cunningham Architects 2700 Fairmount Dallas, Texas 75201 214-855-5272	ME.P ME.P Systems 214-754-4741	CIVIL Kurtz & Associates 214-680-3322	GRAPHICS Netherland Design 214-954-1678				