



02 TRUSS ELEVATION 'T101'

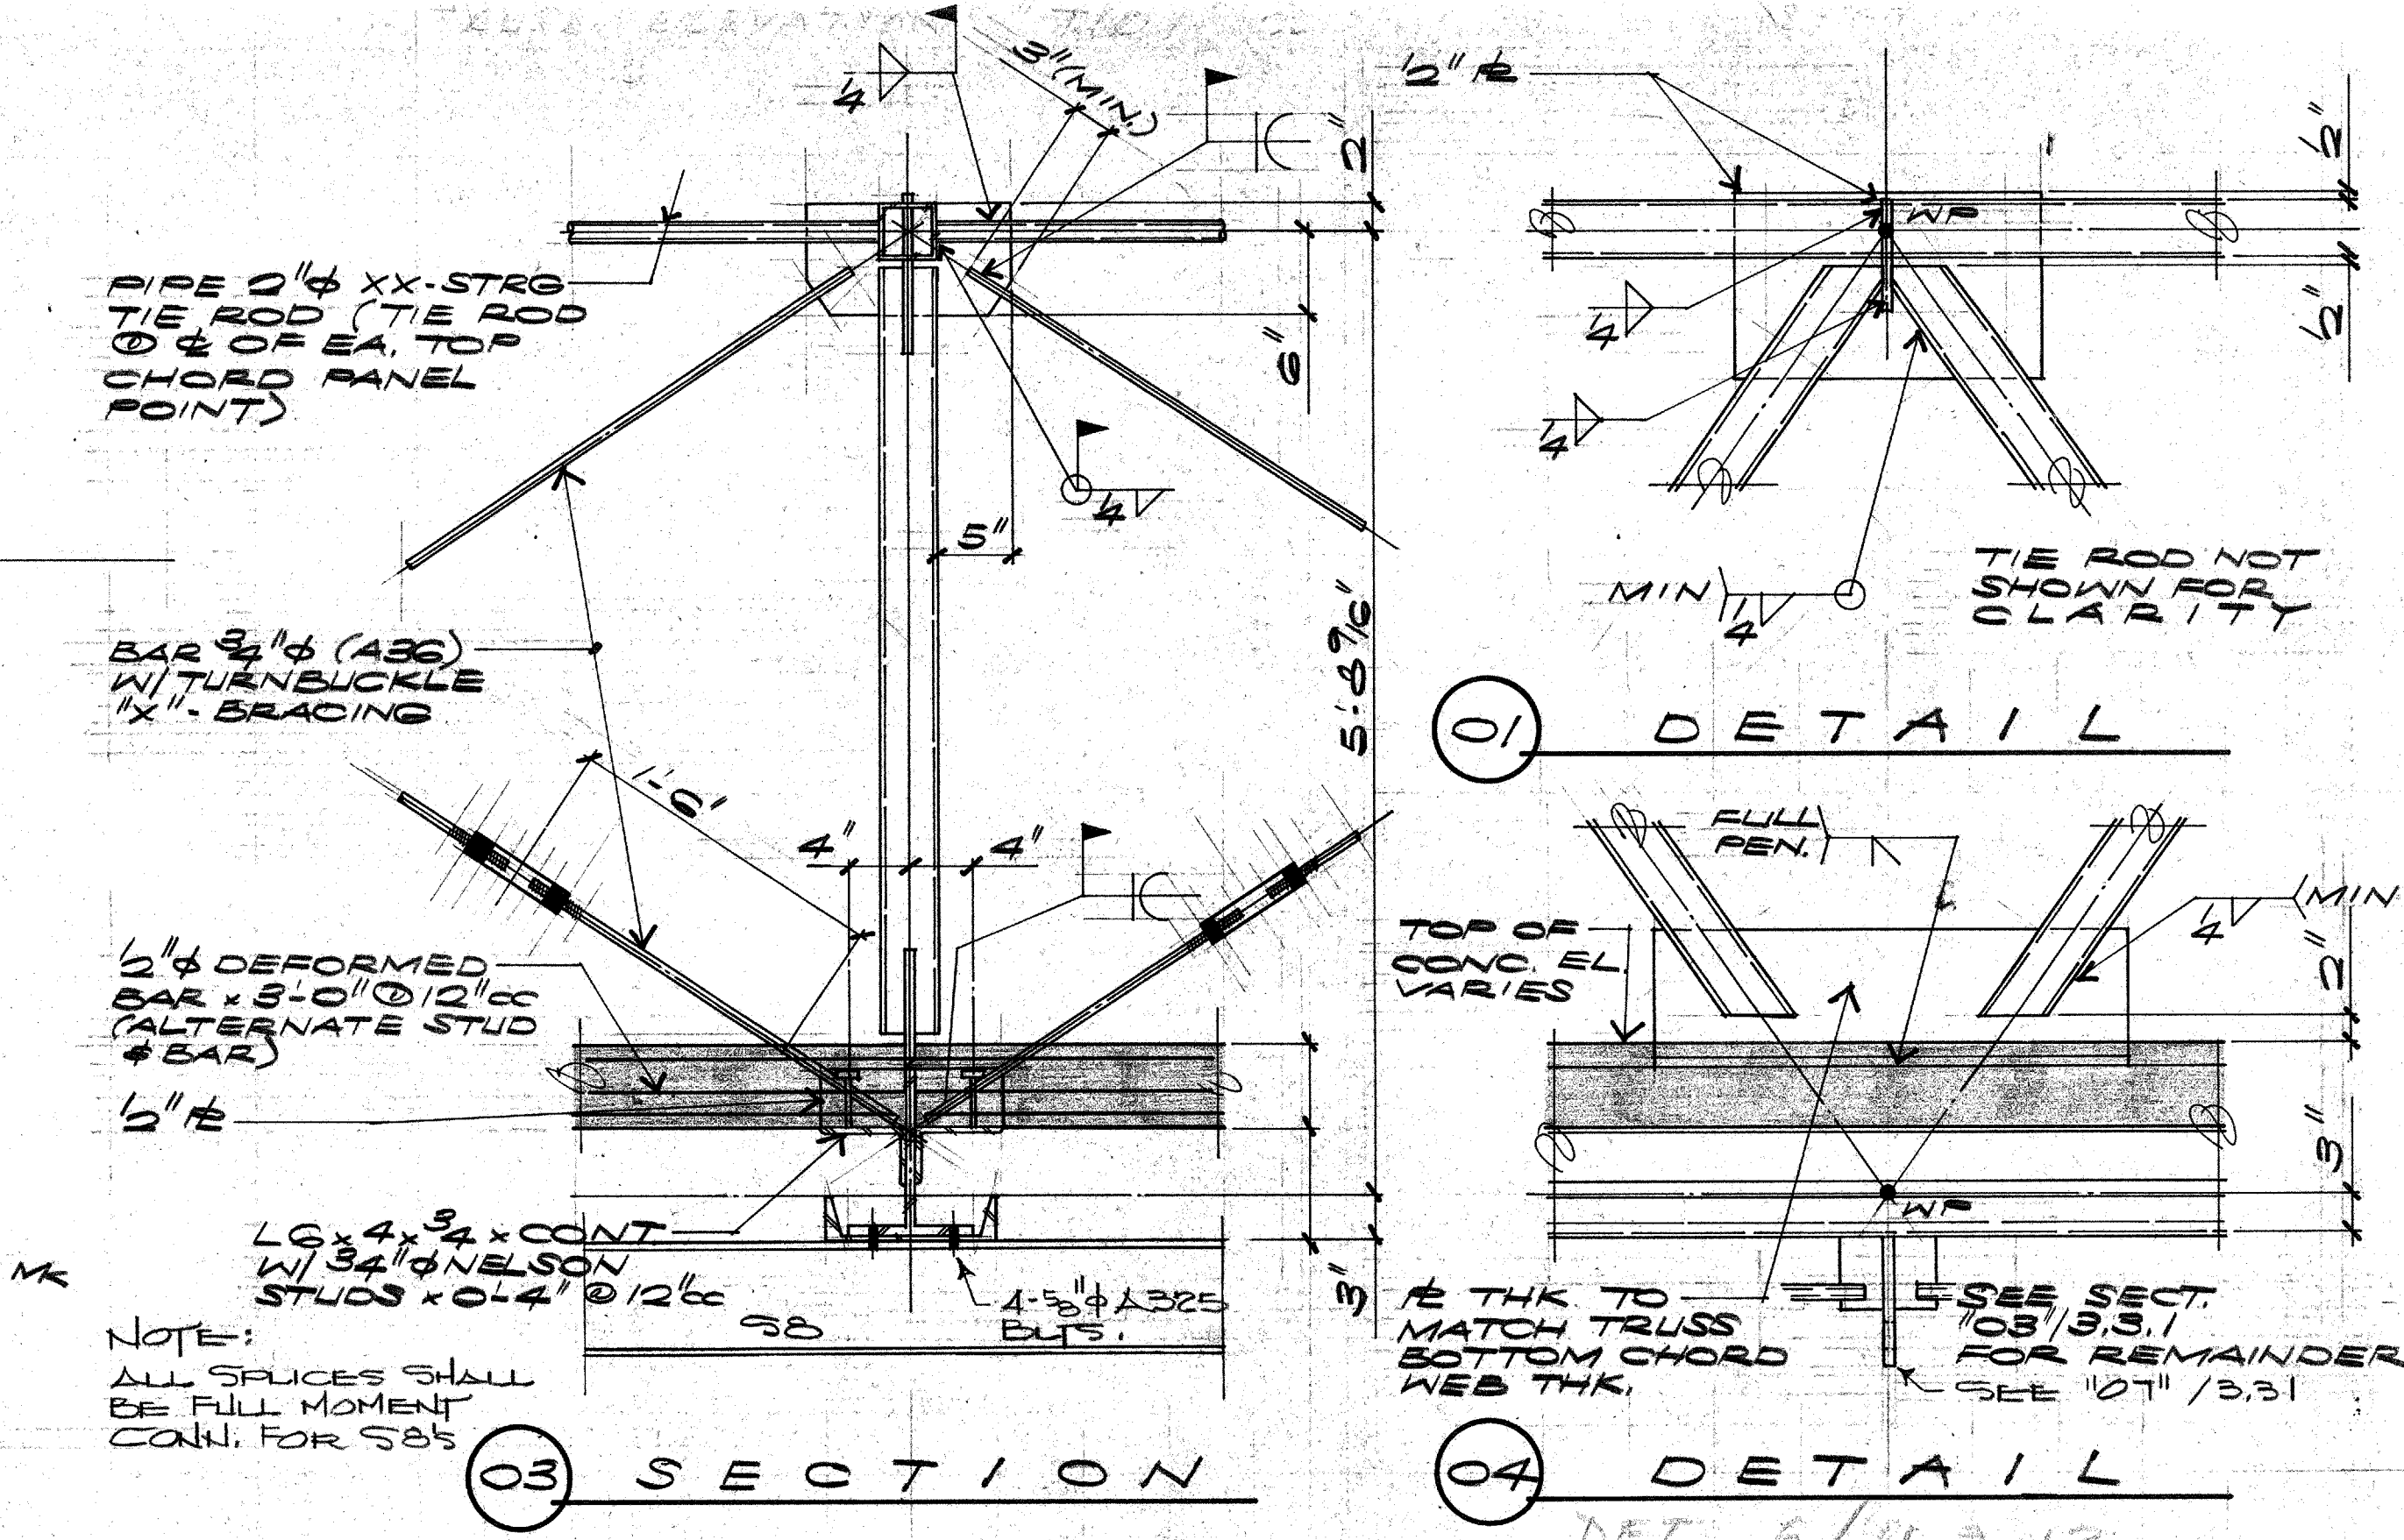


03 SECTION


04 DETAIL

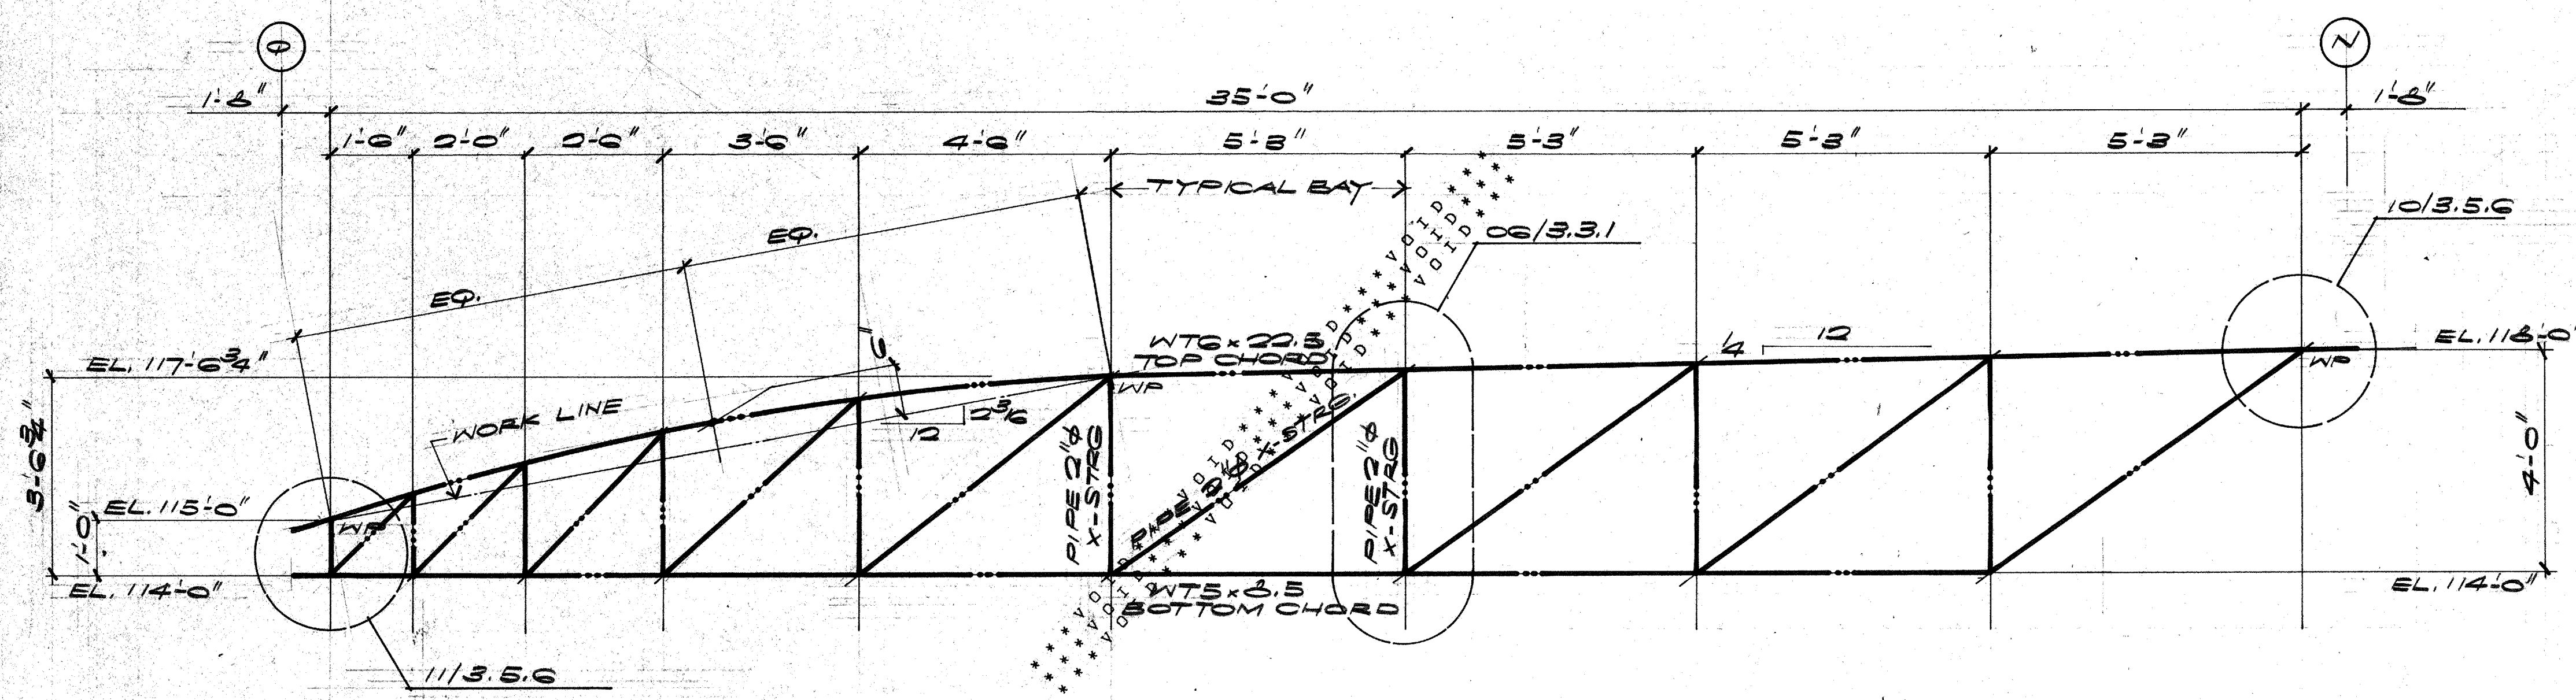


05 TRUSS ELEVATION 'T102'

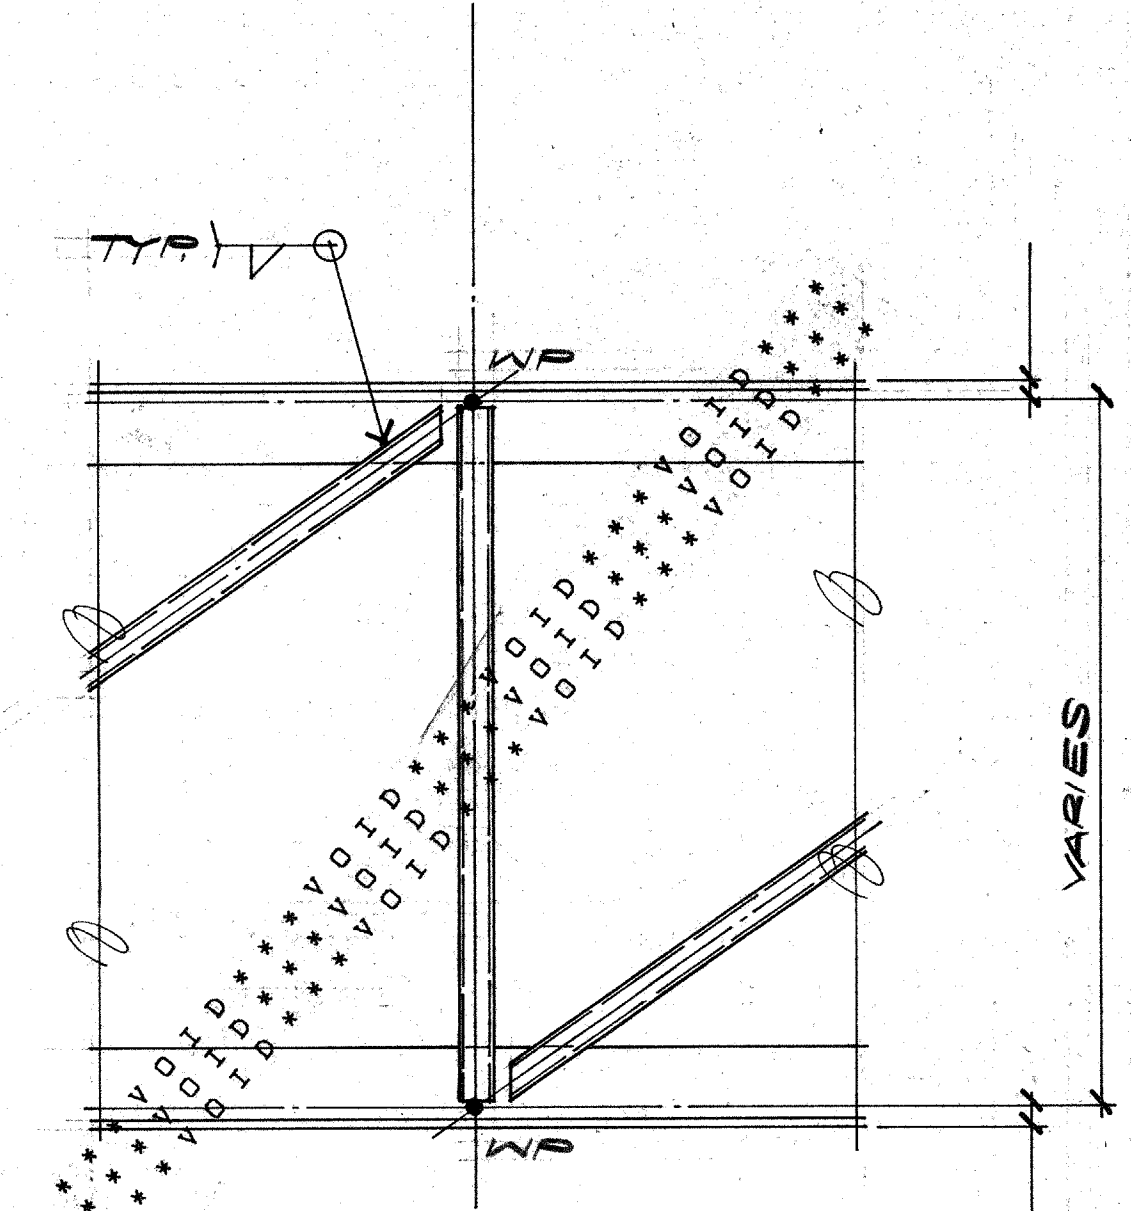


06 DETAIL

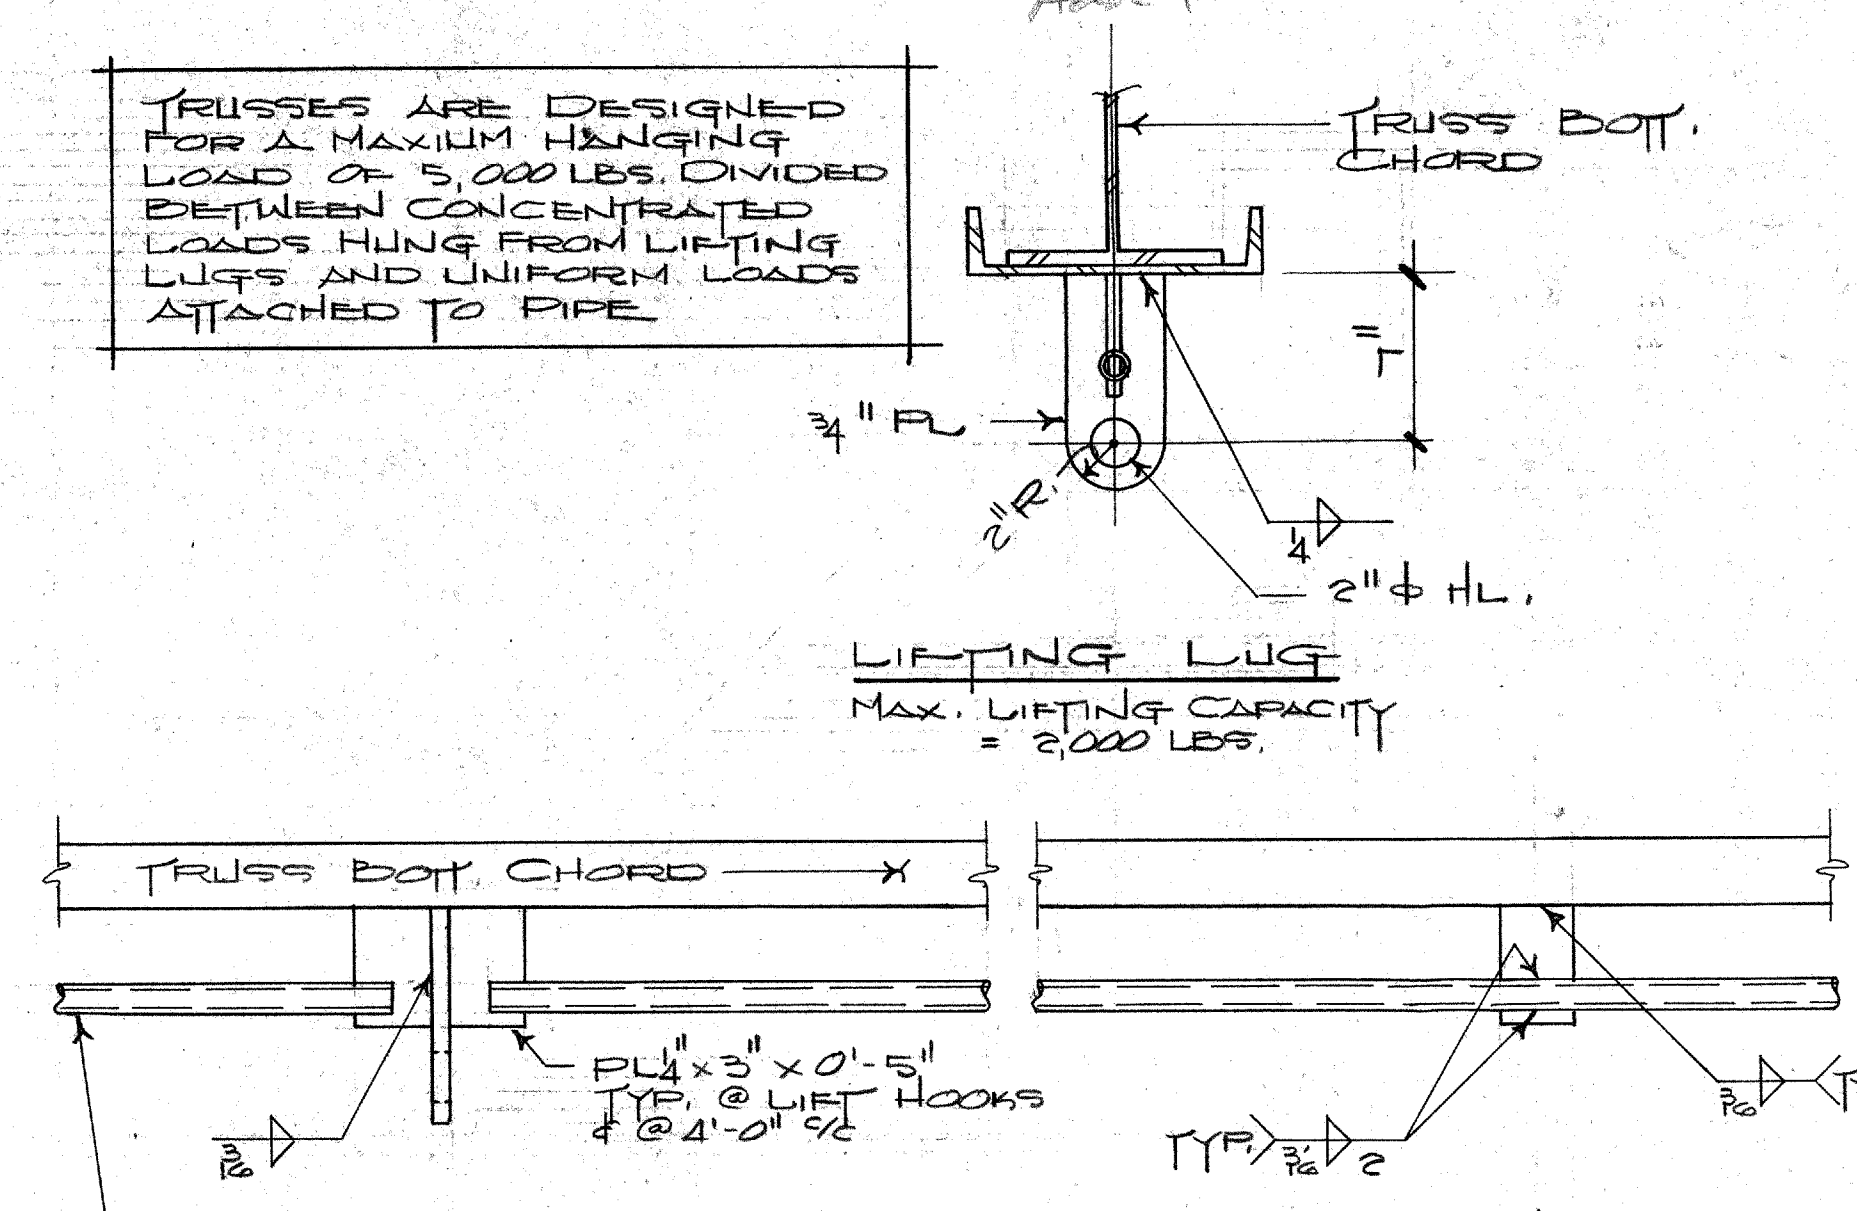

07 DETAIL

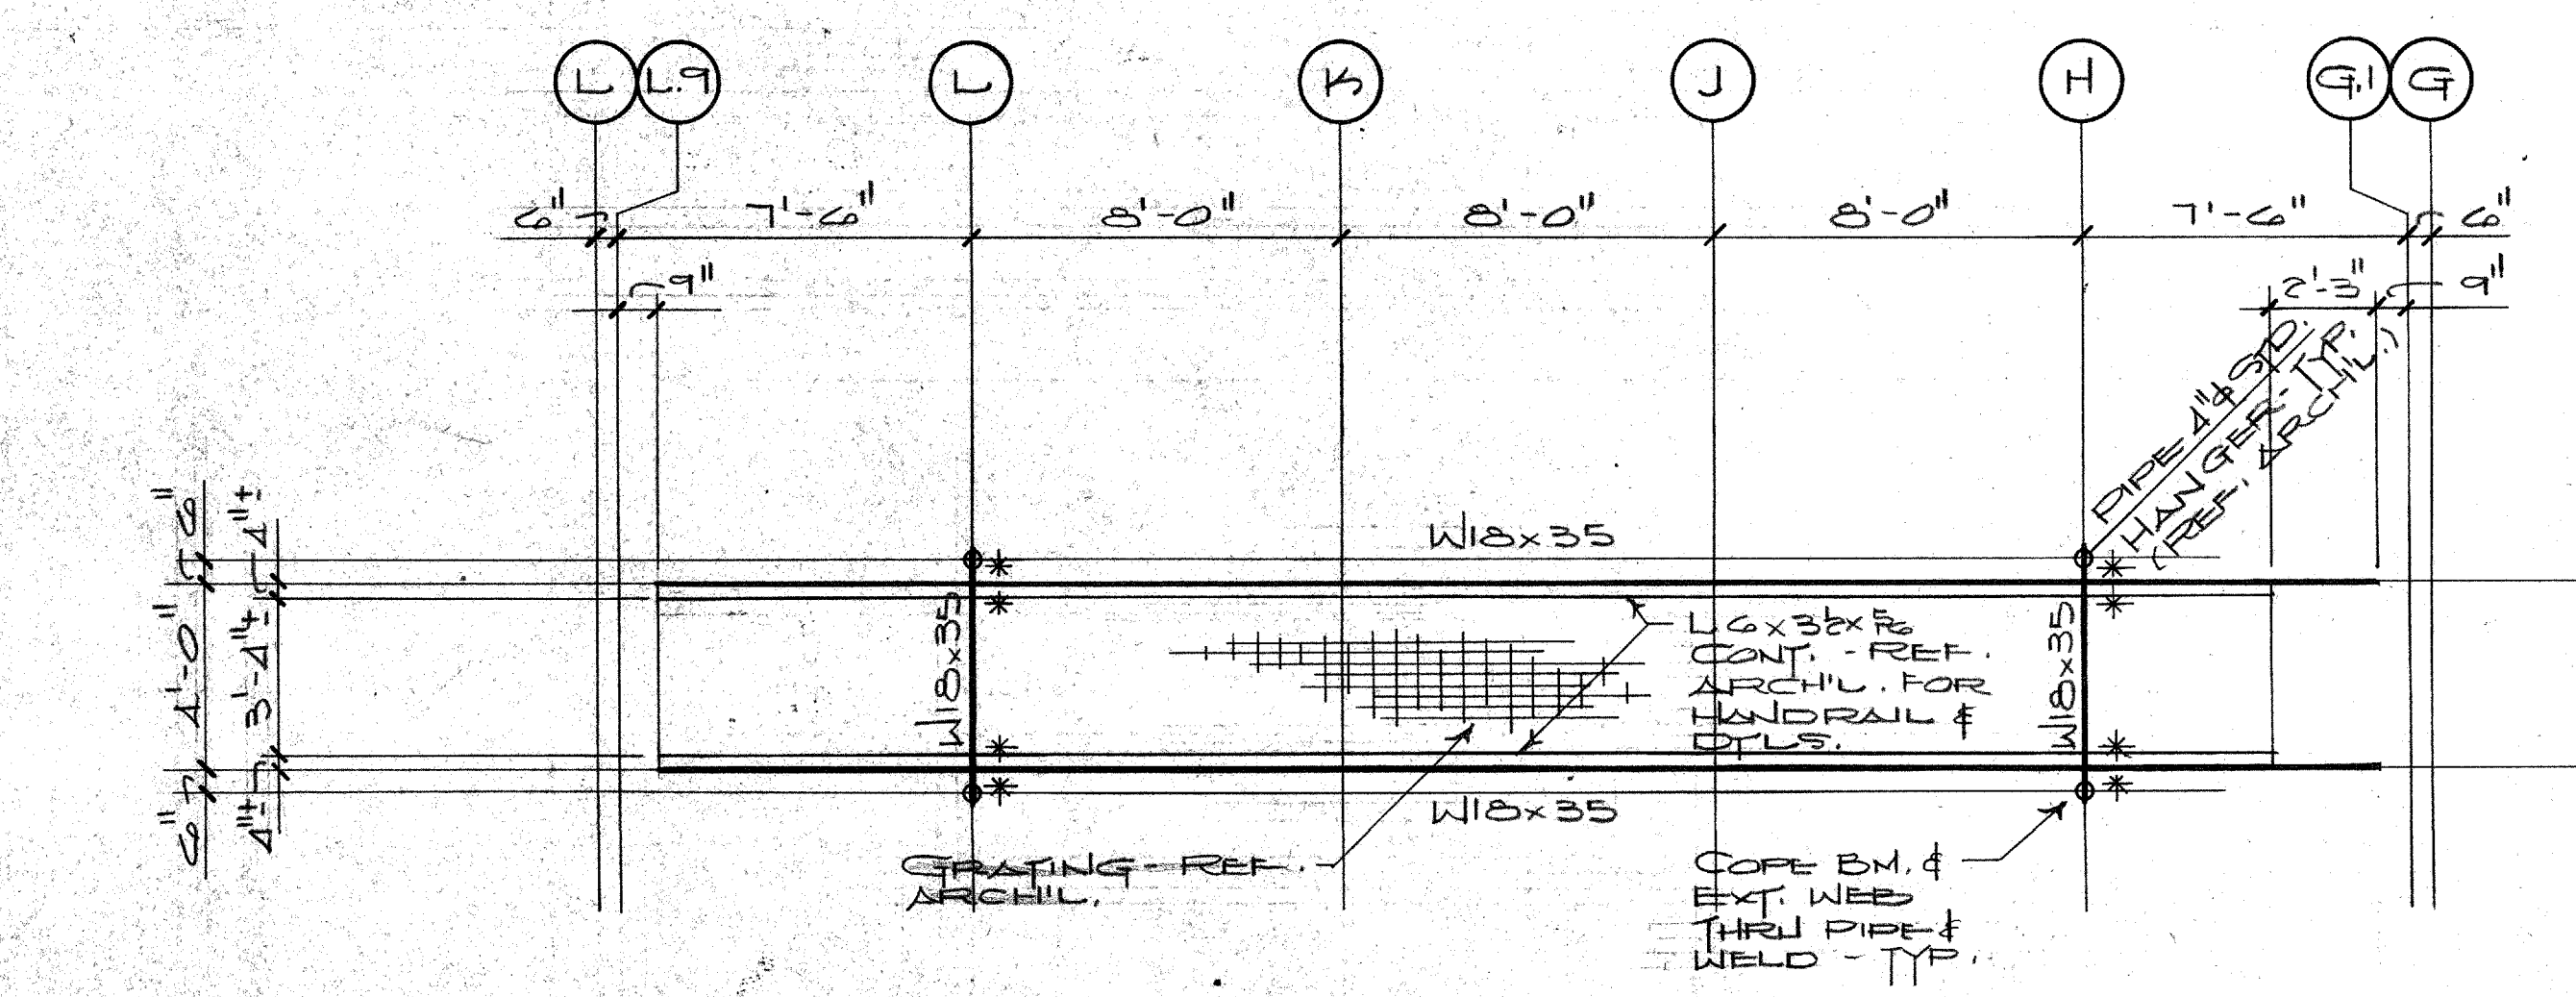

09 ROLLING CATWALK FRAMING PLAN

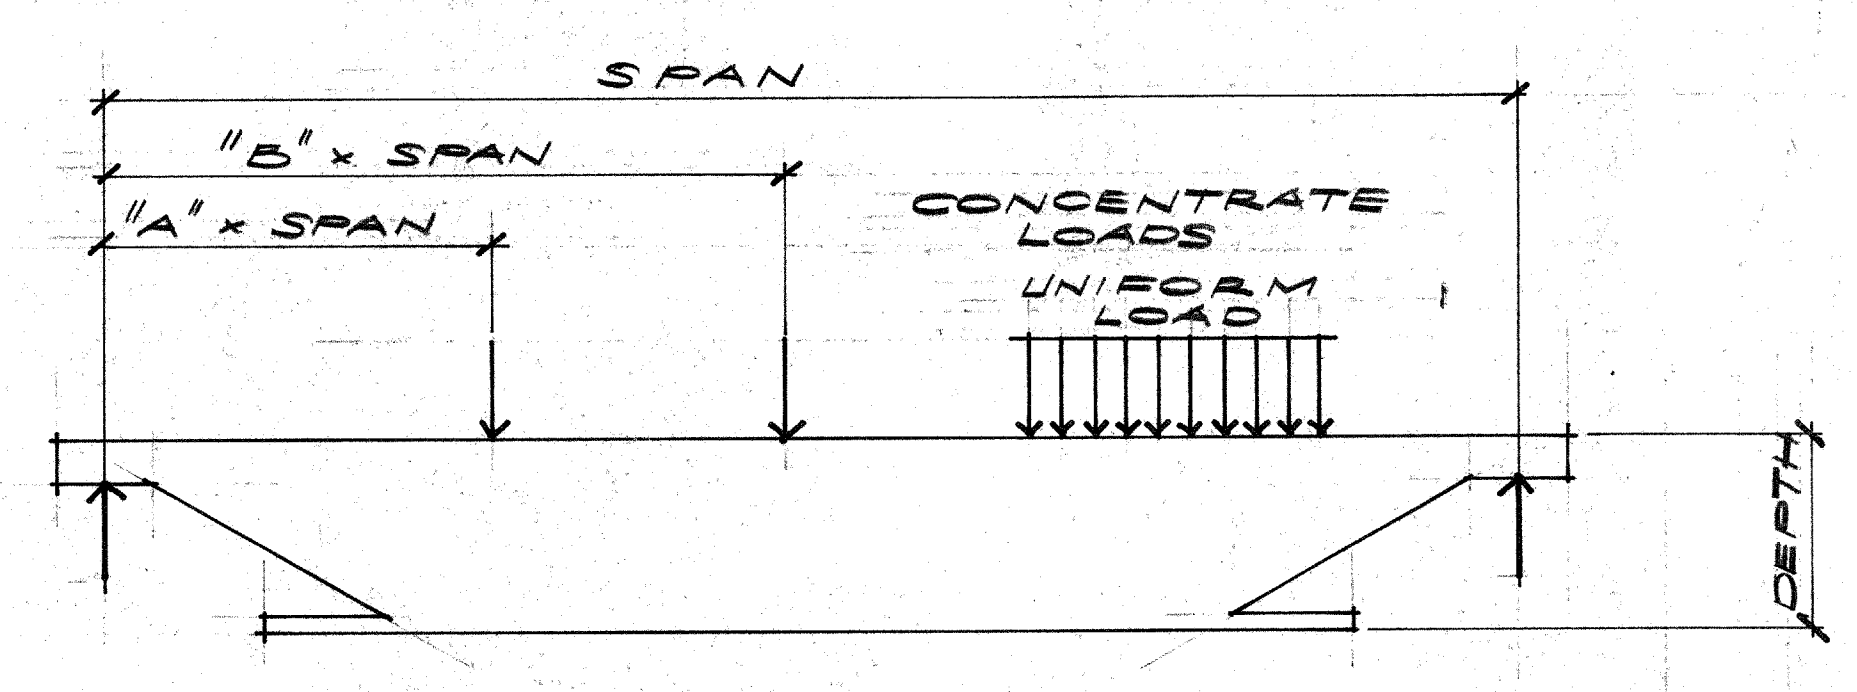


JOIST Nr	SPAN	UNIFORM LOAD (PLD)	CONG. LOAD (LBS)	DEPTH (INS)	A(2)	B(3)	REMARKS
J1	↑	200	2000	14	0.25	0.5	
J2	↑	200	1100	13	0.10	0.5	
J3	↑	200	1200	13	0.10	0.5	
J4	↑	200	1200	13	0.15	0.5	
J5	↑	200	350	12	0.15	0.5	
J6	↑	200	1500	12	0.25	0.5	
J7	↑	200	500	12	0.20	0.5	
J8	↑	225	1675	12	0.25	0.5	SEE NOTE #4
J9	↑	225	475	16	0.15	0.25	SEE NOTE #4
J10	↑	200	1400	14	0.20	0.5	
		375 OR 775	1000 OR 500	14	.15	0.5	

11 DETAIL

SPECIAL JOIST SCHEDULE NOTES:

- PLUS JOIST "SELF-WEIGHT".
- POSITION OF CONCENTRATED LOAD FOR MAXIMUM SHEAR AND/OR WEB STRESS REVERSAL, EACH END.
- POSITION OF CONCENTRATED LOAD FOR MAXIMUM MOMENT.
- THIS JOIST HAS MULTIPLE CONCENTRATED LOADS.

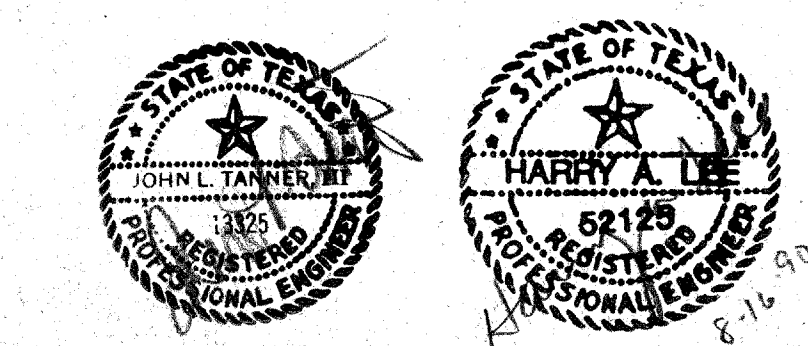

ACC ADDISON ACT

OWNER: Town of Addison
 LANDSCAPE: The Kellams Group
 STRUCTURAL: Ellison Tanner
 HISTORIAN: Alan Mason
 ISSUE FOR BID 8-17-90
 Category: 3
 Subcategory: 3
 Sheet: 1