


RT BAND	(A) MIDSPAN (FROM BOT.)	(B) COLUMN (FROM TOP)	(C) CANT. END (FROM BOT.)	REMARKS
1	11 1/4"	14"	5"	
2	9 1/2"	14"	5"	
3	7 3/4"	14"	5"	
4	6"	14"	5"	

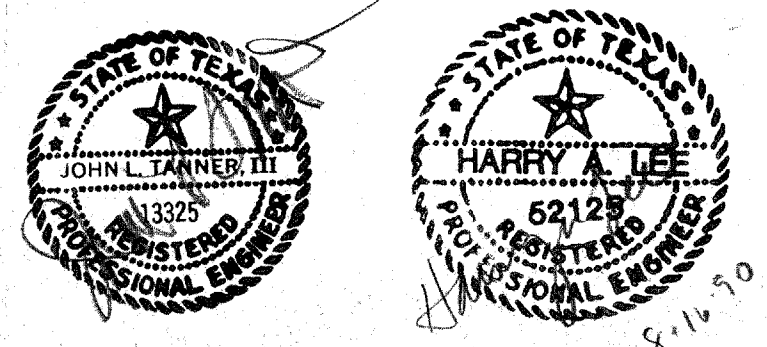

ACC ADDISON ACT

OWNER: Town of Addison
 ARCHITECT: Cunningham Architects
 LANDSCAPE: The Kellams Group
 STRUCTURAL: Ellis Tanner
 HISTORIAN: Alan Mason
 ISSUE: ISSUE FOR BID 8-17-99
 CATEGORY: 3
 SUBCATEGORY: 3
 SHEET: 2