


DOOR SCHEDULE

| LEVEL | NUMBER | LOCATION | DOOR SIZE | | | | DOOR MATERIAL | | | | | | | FRAME MATERIAL | | DOOR DETAILS | | | | | REMARKS | | | | |
|-------|--------|------------------|-----------|--------|----------------------------------|-----------|---------------|---|---|---|---|---|---|----------------|----|--------------|------|------|------|------------|---------|-------|--|--|----------------|
| | | | WIDTH | HEIGHT | THICKNESS 1 3/4" unless noted | DOOR TYPE | | | | | | | | | | TRANSON | HEAD | JAMB | SILL | SIDE LIGHT | | LABEL | | | |
| | | | | | | | DOOR MATERIAL | | | | | | | FRAME MATERIAL | | | | | | | | | | | |
| | | | | | | 1 | 2 | 3 | 4 | 5 | 6 | 7 | 8 | 9 | 10 | 11 | 12 | 13 | | | | | | | |
| | C101 | STAIR | | | | A | / | | | | | | | | | | | | | | | | | | |
| | C102 | ROOF | | | | A | / | | | | | | | | | | | | | | | | | | |
| | C103 | DIMMER | 2'-0" | 7'-0" | | A | / | | | | | | | | | | | | | | | | | | |
| | C104 | AMPS | 2'-0" | 7'-0" | | A | / | | | | | | | | | | | | | | | | | | |
| | C105 | E. GALLERY | 2'-0" | 7'-0" | | E | / | | | | | | | | | | | | | | | | | | |
| | C106 | LIGHTING GALLERY | 3'-0" | 7'-0" | | B | / | | | | | | | | | | | | | | | | | | |
| | C107 | THEATRE | 2'-0" | 7'-0" | | F | / | | 4 | 5 | | | | | | | | | | | | | | | |
| | C108 | N. GALLERY | 2'-0" | 7'-0" | | B | / | | 4 | 5 | | | | | | | | | | | | | | | |
| | C109 | N. GALLERY | 2'-0" | 7'-0" | | B | / | | 4 | 5 | | | | | | | | | | | | | | | |
| | C110 | THEATRE | 2'-0" | 7'-0" | | E | / | | 4 | 5 | | | | | | | | | | | | | | | |
| | C111 | N. GALLERY | 2'-0" | 7'-0" | | B | / | | 4 | 5 | | | | | | | | | | | | | | | |
| | C112 | THEATRE | 2'-0" | 7'-0" | | E | / | | 4 | 5 | | | | | | | | | | | | | | | |
| | C113 | N. GALLERY | 2'-0" | 7'-0" | | B | / | | 4 | 5 | | | | | | | | | | | | | | | |
| | C114 | THEATRE | 2'-0" | 7'-0" | | E | / | | 4 | 5 | | | | | | | | | | | | | | | |
| | C115 | THEATRE | 1'-4" | 1'-4" | | C | / | | | | | | | | | | | | | | | | | | SEE SPEC. 8305 |
| | C116 | THEATRE | 2'-0" | 7'-0" | | A | / | | | | | | | | | | | | | | | | | | |
| | C117 | THEATRE | 2'-0" | 7'-0" | | E | / | | 4 | | | | | | | | | | | | | | | | |
| | C118 | THEATRE | 2'-0" | 7'-0" | | E | / | | 4 | | | | | | | | | | | | | | | | |
| | C119 | THEATRE | 2'-0" | 7'-0" | | E | / | | 4 | | | | | | | | | | | | | | | | |
| | C120 | THEATRE | 2'-0" | 7'-0" | | E | / | | 4 | | | | | | | | | | | | | | | | |
| | C121 | THEATRE | 2'-0" | 7'-0" | | E | / | | 4 | | | | | | | | | | | | | | | | |
| | C122 | THEATRE | 2'-0" | 7'-0" | | E | / | | 4 | | | | | | | | | | | | | | | | |
| | C123 | THEATRE | 2'-0" | 7'-0" | | E | / | | 4 | | | | | | | | | | | | | | | | |
| | C124 | ROOF | 2'-0" | 7'-0" | | A | / | | | | | | | | | | | | | | | | | | |
| | C125 | THEATRE | 2'-0" | 7'-0" | | E | / | | 4 | | | | | | | | | | | | | | | | |
| | C126 | ROOF | 1'-4" | 1'-4" | | C | / | | | | | | | | | | | | | | | | | | SEE SPEC 8305 |
| | C127 | THEATRE | 2'-4" | 7'-0" | | A | / | | 4 | | | | | | | | | | | | | | | | |
| | C128 | THEATRE | 2'-4" | 7'-0" | | A | / | | 4 | | | | | | | | | | | | | | | | |
| | C129 | THEATRE | 2'-4" | 7'-0" | | A | / | | 4 | | | | | | | | | | | | | | | | |
| | C130 | THEATRE | 2'-8" | 7'-0" | | E | / | | 4 | | | | | | | | | | | | | | | | |
| | C131 | ROOF | 1'-4" | 1'-4" | | C | / | | | | | | | | | | | | | | | | | | SEE SPEC 8305 |
| | C132 | ROOF | 8' | 8' | | C | / | | | | | | | | | | | | | | | | | | SEE SPEC 8305 |
| | C133 | STAIR | 8' | 10' | | F | / | | 2 | | | | | | | | | | | | | | | | |

THIRD FLOOR
THEATRE

DOOR SCHEDULE

| LEVEL | NUMBER | LOCATION | DOOR SIZE | | | | DOOR MATERIAL | | | | | | | FRAME MATERIAL | | DOOR DETAILS | | | | | REMARKS | | | | | |
|-------|--------|----------|-----------|--------|----------------------------------|-----------|---------------|---|---|---|---|---|---|----------------|----|--------------|------|------|------|------------|---------|-------|--|--|--|--|
| | | | WIDTH | HEIGHT | THICKNESS 1 3/4" unless noted | DOOR TYPE | | | | | | | | | | TRANSON | HEAD | JAMB | SILL | SIDE LIGHT | | LABEL | | | | |
| | | | | | | | DOOR MATERIAL | | | | | | | FRAME MATERIAL | | | | | | | | | | | | |
| | | | | | | 1 | 2 | 3 | 4 | 5 | 6 | 7 | 8 | 9 | 10 | 11 | 12 | 13 | | | | | | | | |

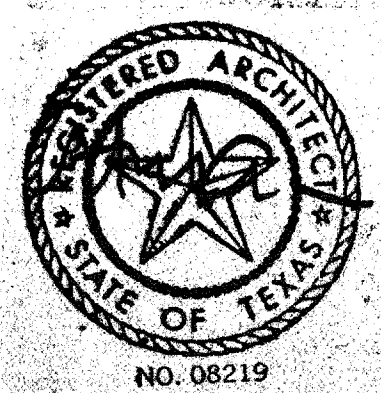

ACC ADDISON ACT

OWNER: The Kellum Group
ARCHITECT: Cunningham Architects
LANDSCAPE: The Kellum Group
THEATRE CONSULTANT: Theatre Projects
INTERIORS: CROSS
STRUCTURAL: Etkin Tenner
MEP: M&E Systems
ELECTRICAL: Kurtz & Associates
HISTORIAN: High Mason
LIGHTING: Stanley Hull Wilson
GRAPHICS: Nutritional Design
ISSUE FOR BID 8-17-90
Category: 4 Subcategory: 1 Sheet: 4