


1 ROOF PLAN  
8/1/01

Add 1  
Drawn: Shannan Long (19)

See JK-9, 9A  
for RTU loc.

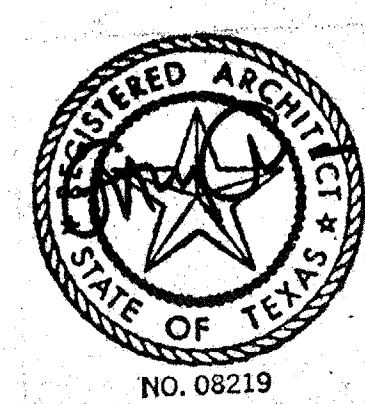

ACC ADDISON ACT

OWNER	LANDSCAPE	STRUCTURAL	HISTORIAN	Issue	Category	Subcategory	Sheet
Town of Addison	The Kellams Group 307-776-1417	Elliot Lerner 214-387-8383	Alan Wilson 214-681-782	ISSUE FOR BID 8-17-90	4	2	2
ARCHITECT	THEATRE CONSULTANT	M.E.P.	LIGHTING				
Carrington Architects 2700 Fairmount Dallas, Texas 75201 214-855-5277	Theatre Projects 203-431-3949	M.E.P. Systems 214-754-4741	Patricia Hill Wilson 214-823-8542				
INTERIORS	CRSS	CIVIL	GRAPHICS				
214-552-2000	214-690-3322	Kurtz & Associates 214-954-9378	Notated Design 214-954-9378				