



LEVEL 1 DOOR / PARTITION PLAN

Add: See Section 08330

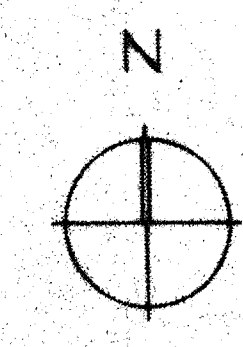

ACC  ACT

OWNER	LANDSCAPE	STRUCTURAL	HISTORIAN	ISSUE	CATEGORY	SUBCATEGORY	SHEET
The Williams Group 317-76-1477	The Williams Group 317-76-1477	Estor Tower 214-387-8383	Alan Mason 214-681-7822	Issue ISSUE FOR BID 8-17-98	4	2	4D
ARCHITECT Cunningham Architects 2700 Fairmont Dallas, Texas 75201 214-856-5272	THEATRE CONSULTANT Theatre Projects 203-431-3949	M.E.P. MEP Systems 214-754-4789	LIGHTING Parade Hall Wilson 214-823-8642				
INTERIORS CRSS 713-562-2000	CIVIL Kutz & Associates 214-680-3322	GRAPHICS Northward Design 214-664-8978					

T