


- GLASS SCHEDULE
- Key Type
- Ⓐ 1/4" Clear Float Glass in Zipper Gasket System
 - Ⓑ 1/4" Patterned Float Glass in Zipper Gasket System
 - Ⓒ 1/4" Ceramic Coated Spandrel Tempered Glass in Zipper Gasket System
 - Ⓓ 1/4" Clear Tempered Glass in Zipper Gasket System
 - Ⓔ 1/4" Clear Float Glass in Aluminum Storefront System
 - Ⓕ 1/4" Clear Tempered Glass in Aluminum Storefront System
 - Ⓖ 1/4" Patterned Float Glass in Aluminum Storefront System
 - Ⓗ 1/4" Patterned Tempered Glass in Aluminum Storefront System
 - Ⓙ 1-3/4" Insulating Acoustic Unit (1/4" x .020 x 1/4" x 1/8" + 1/8" + 1/8") in Grouted Hollow Metal Frame
 - Ⓚ 1-3/4" Insulating Acoustic Unit (1/4" x .020 x 1/4" x 1/8" + 1/8" + 1/8") in Custom Steel Tube Glazing or Door
 - Ⓛ 1/4" Clear Laminated (1/8" x .020 + 1/8") Glass in Single Hung Aluminum Window
 - Ⓜ 1/4" Tempered Patterned Glass in Single Hung Aluminum Window
 - Ⓝ 1/4" Clear Float Glass in Grouted Hollow Metal Frame

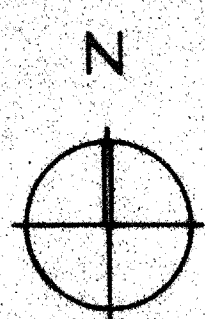

LEVEL TWO FLOOR PLAN

ACC ADDISON ACT

OWNER	LANDSCAPE	STRUCTURAL	HISTORIAN	Issue	Category	Subcategory	Sheet
Town of Addison 317.776.1417	The Kellams Group 214.381.8383	Eliseo Terner 214.381.8383	Alan Mason 214.591.7922	ISSUE FOR BID 8-17-90	4	2	5
ARCHITECT Cunningham Architects 2700 Fairmount Dallas, Texas 75201 214.855.5272	THEATRE CONSULTANT Theatre Projects 203.431.3949 214.855.5272	M.E.P. MEP Systems 214.754.4749	LIGHTING Parsons Hill Wilson 462.824.642				
INTERIORS CRSS 713.552.2000	CIVIL Kurtz & Associates 214.690.3322	GRAPHICS Northwest Design 214.654.8778					