




1 ENLARGED PLAN
1/4" = 1'-0"

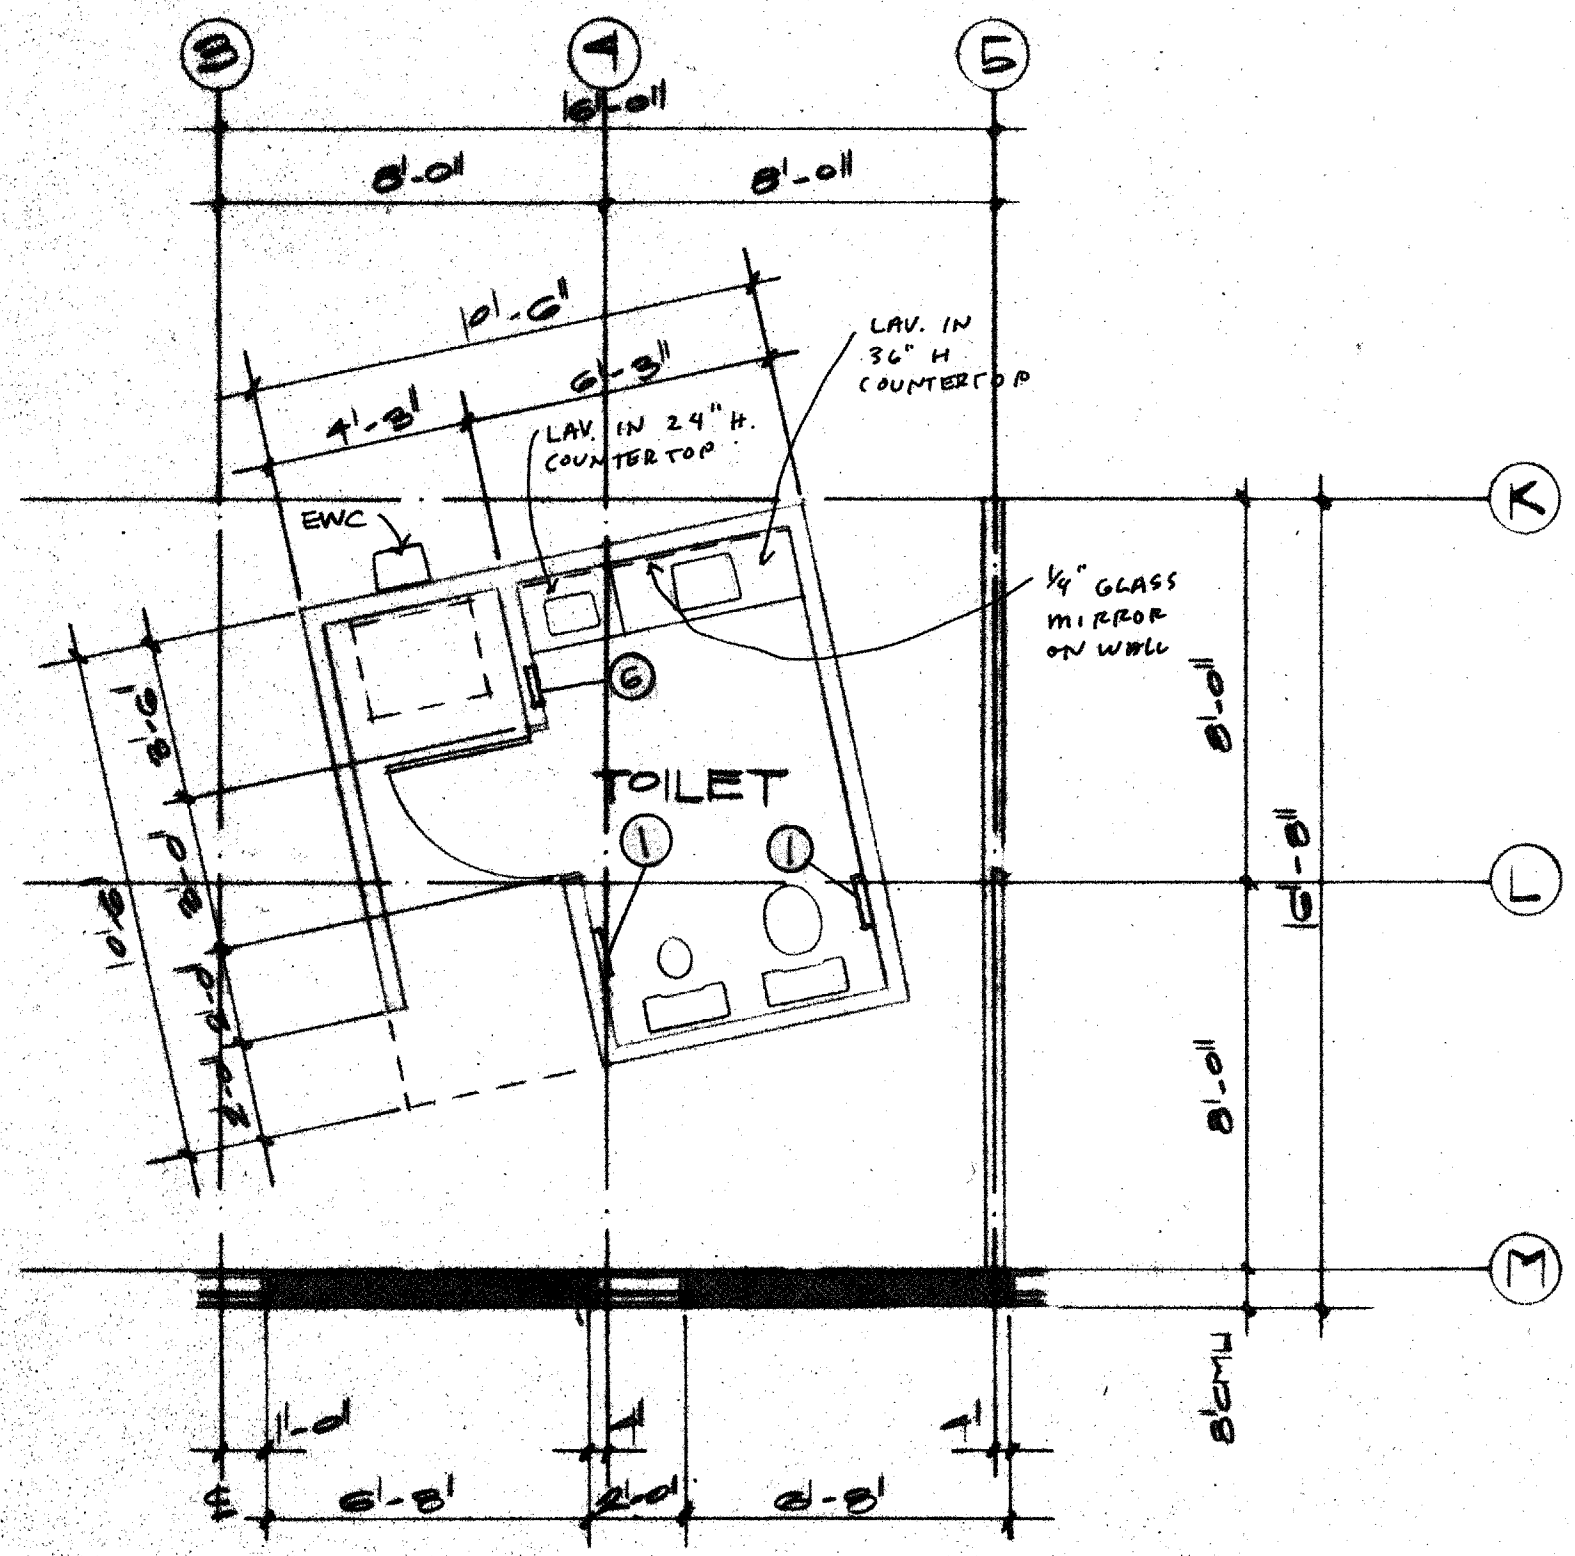

3 ENLARGED PLAN
1/4" = 1'-0"

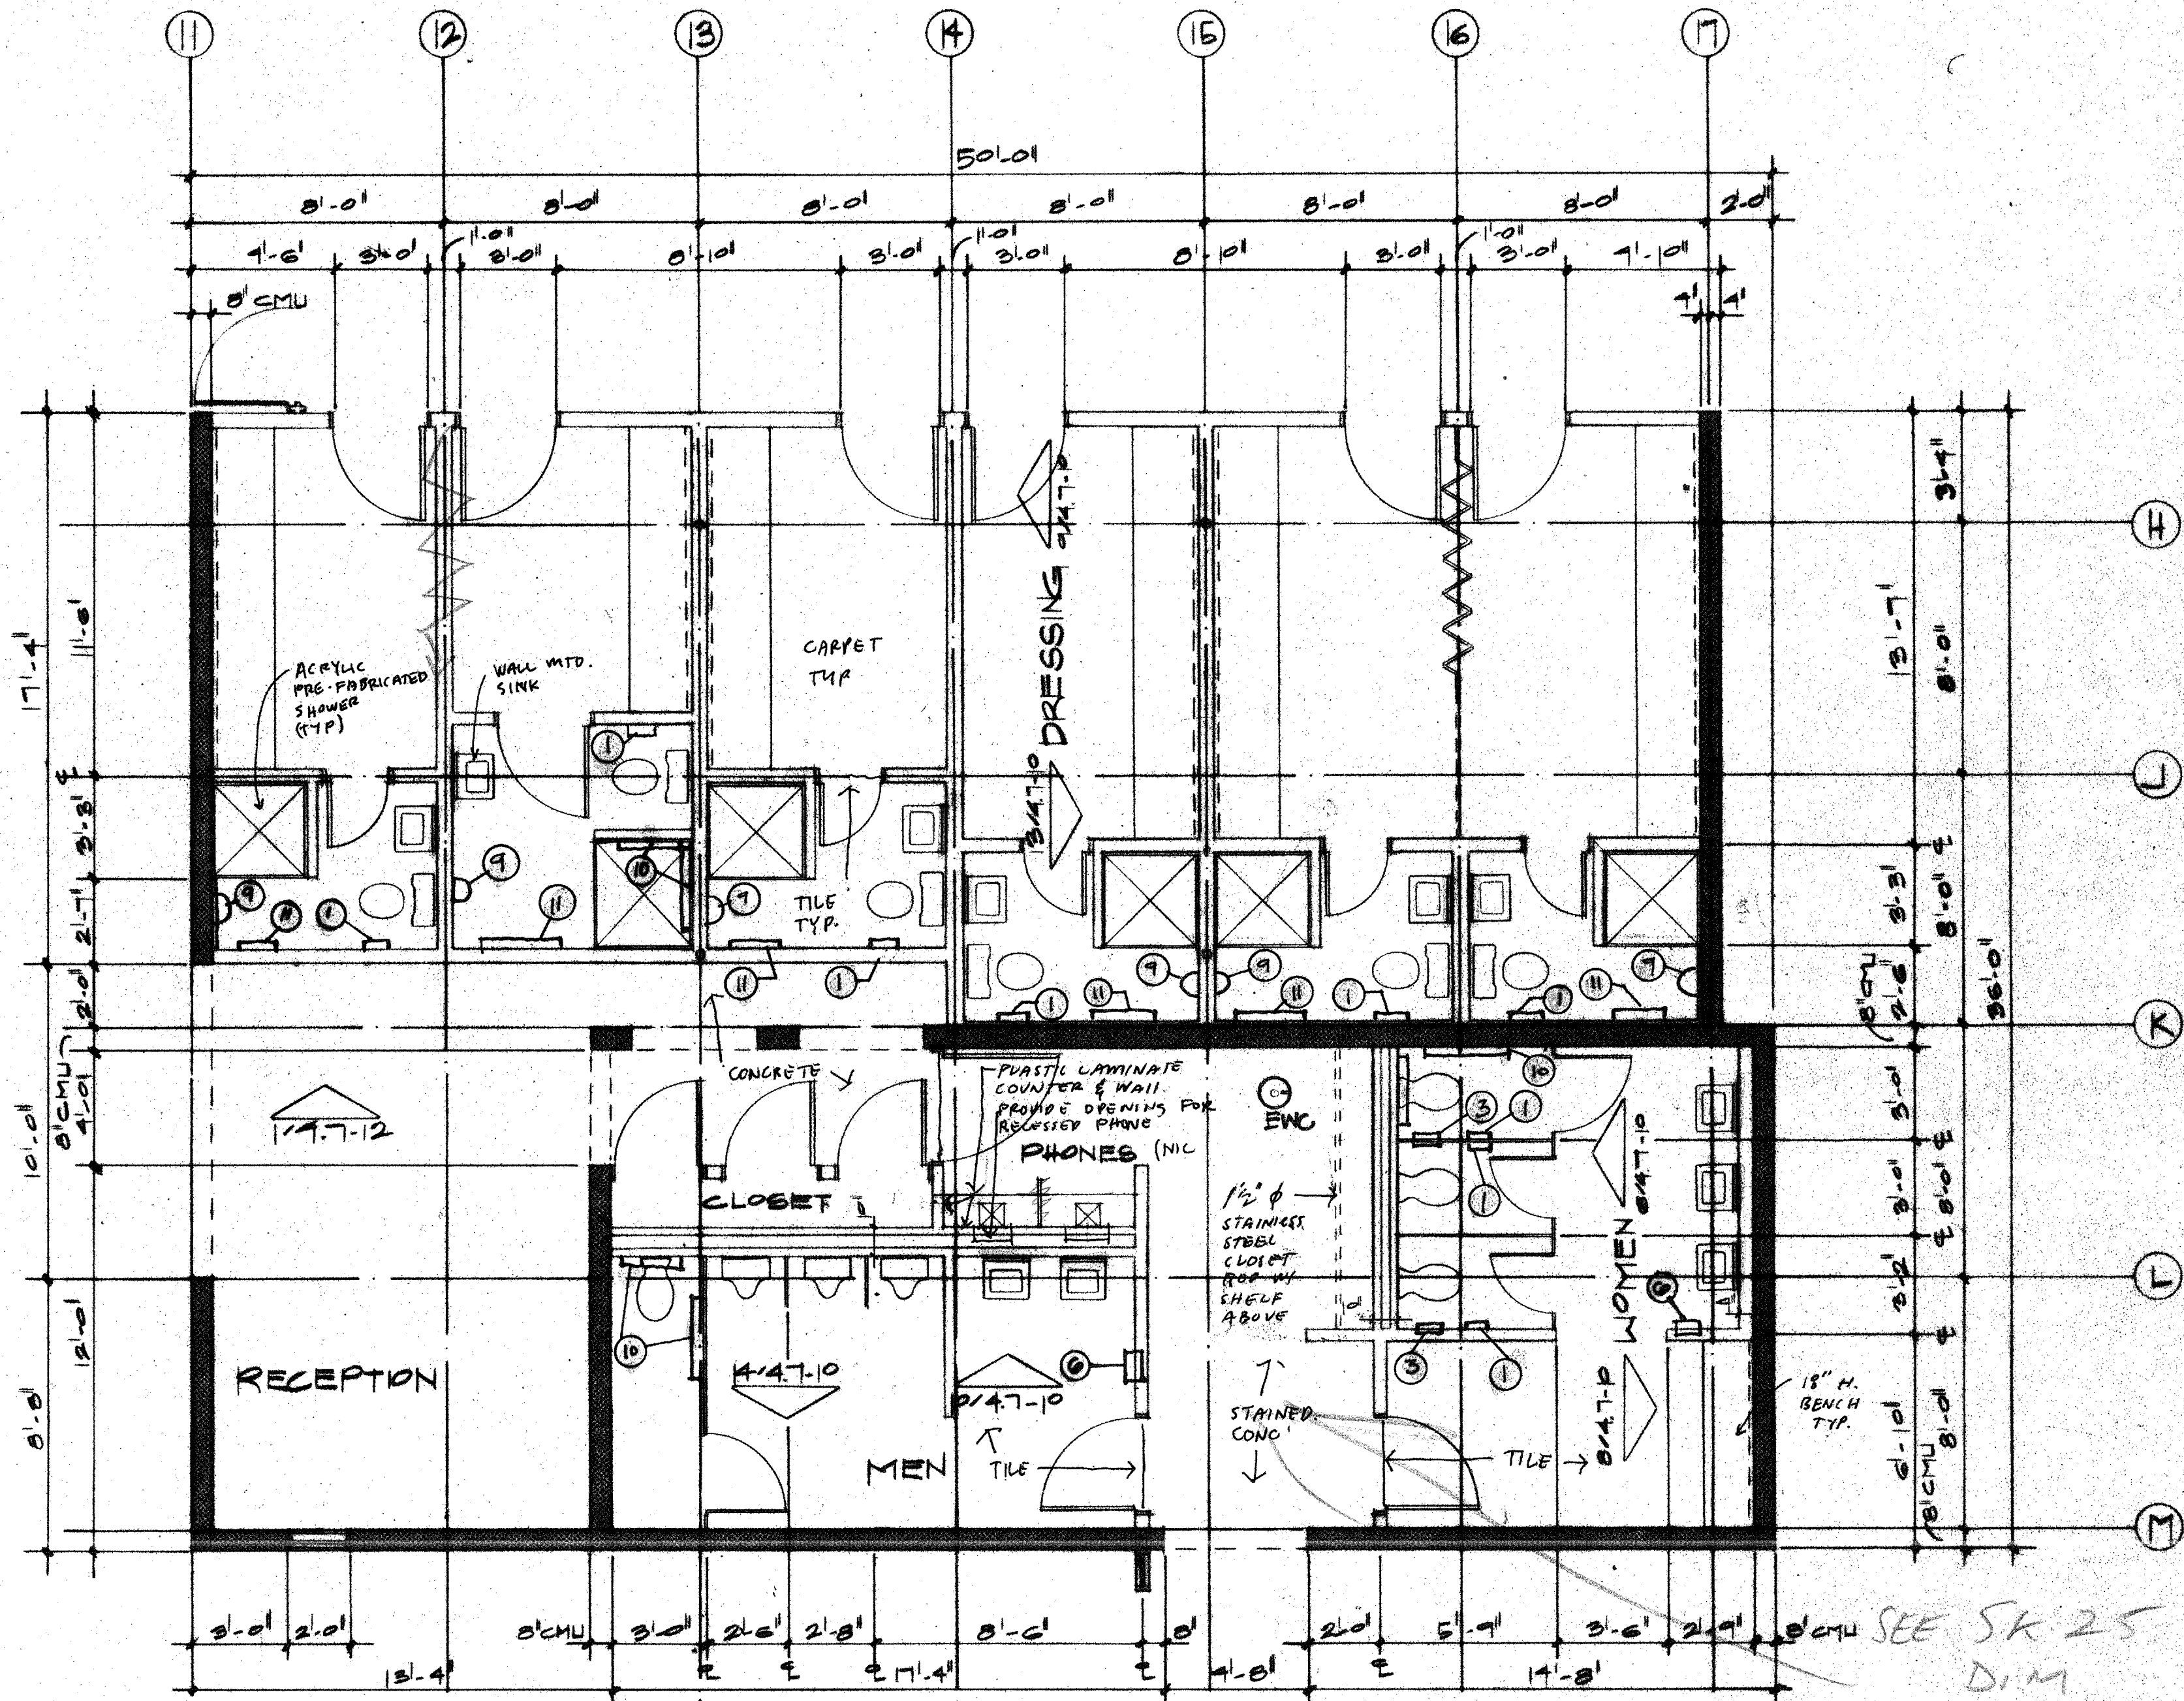

2 ENLARGED PLAN
1/4" = 1'-0"

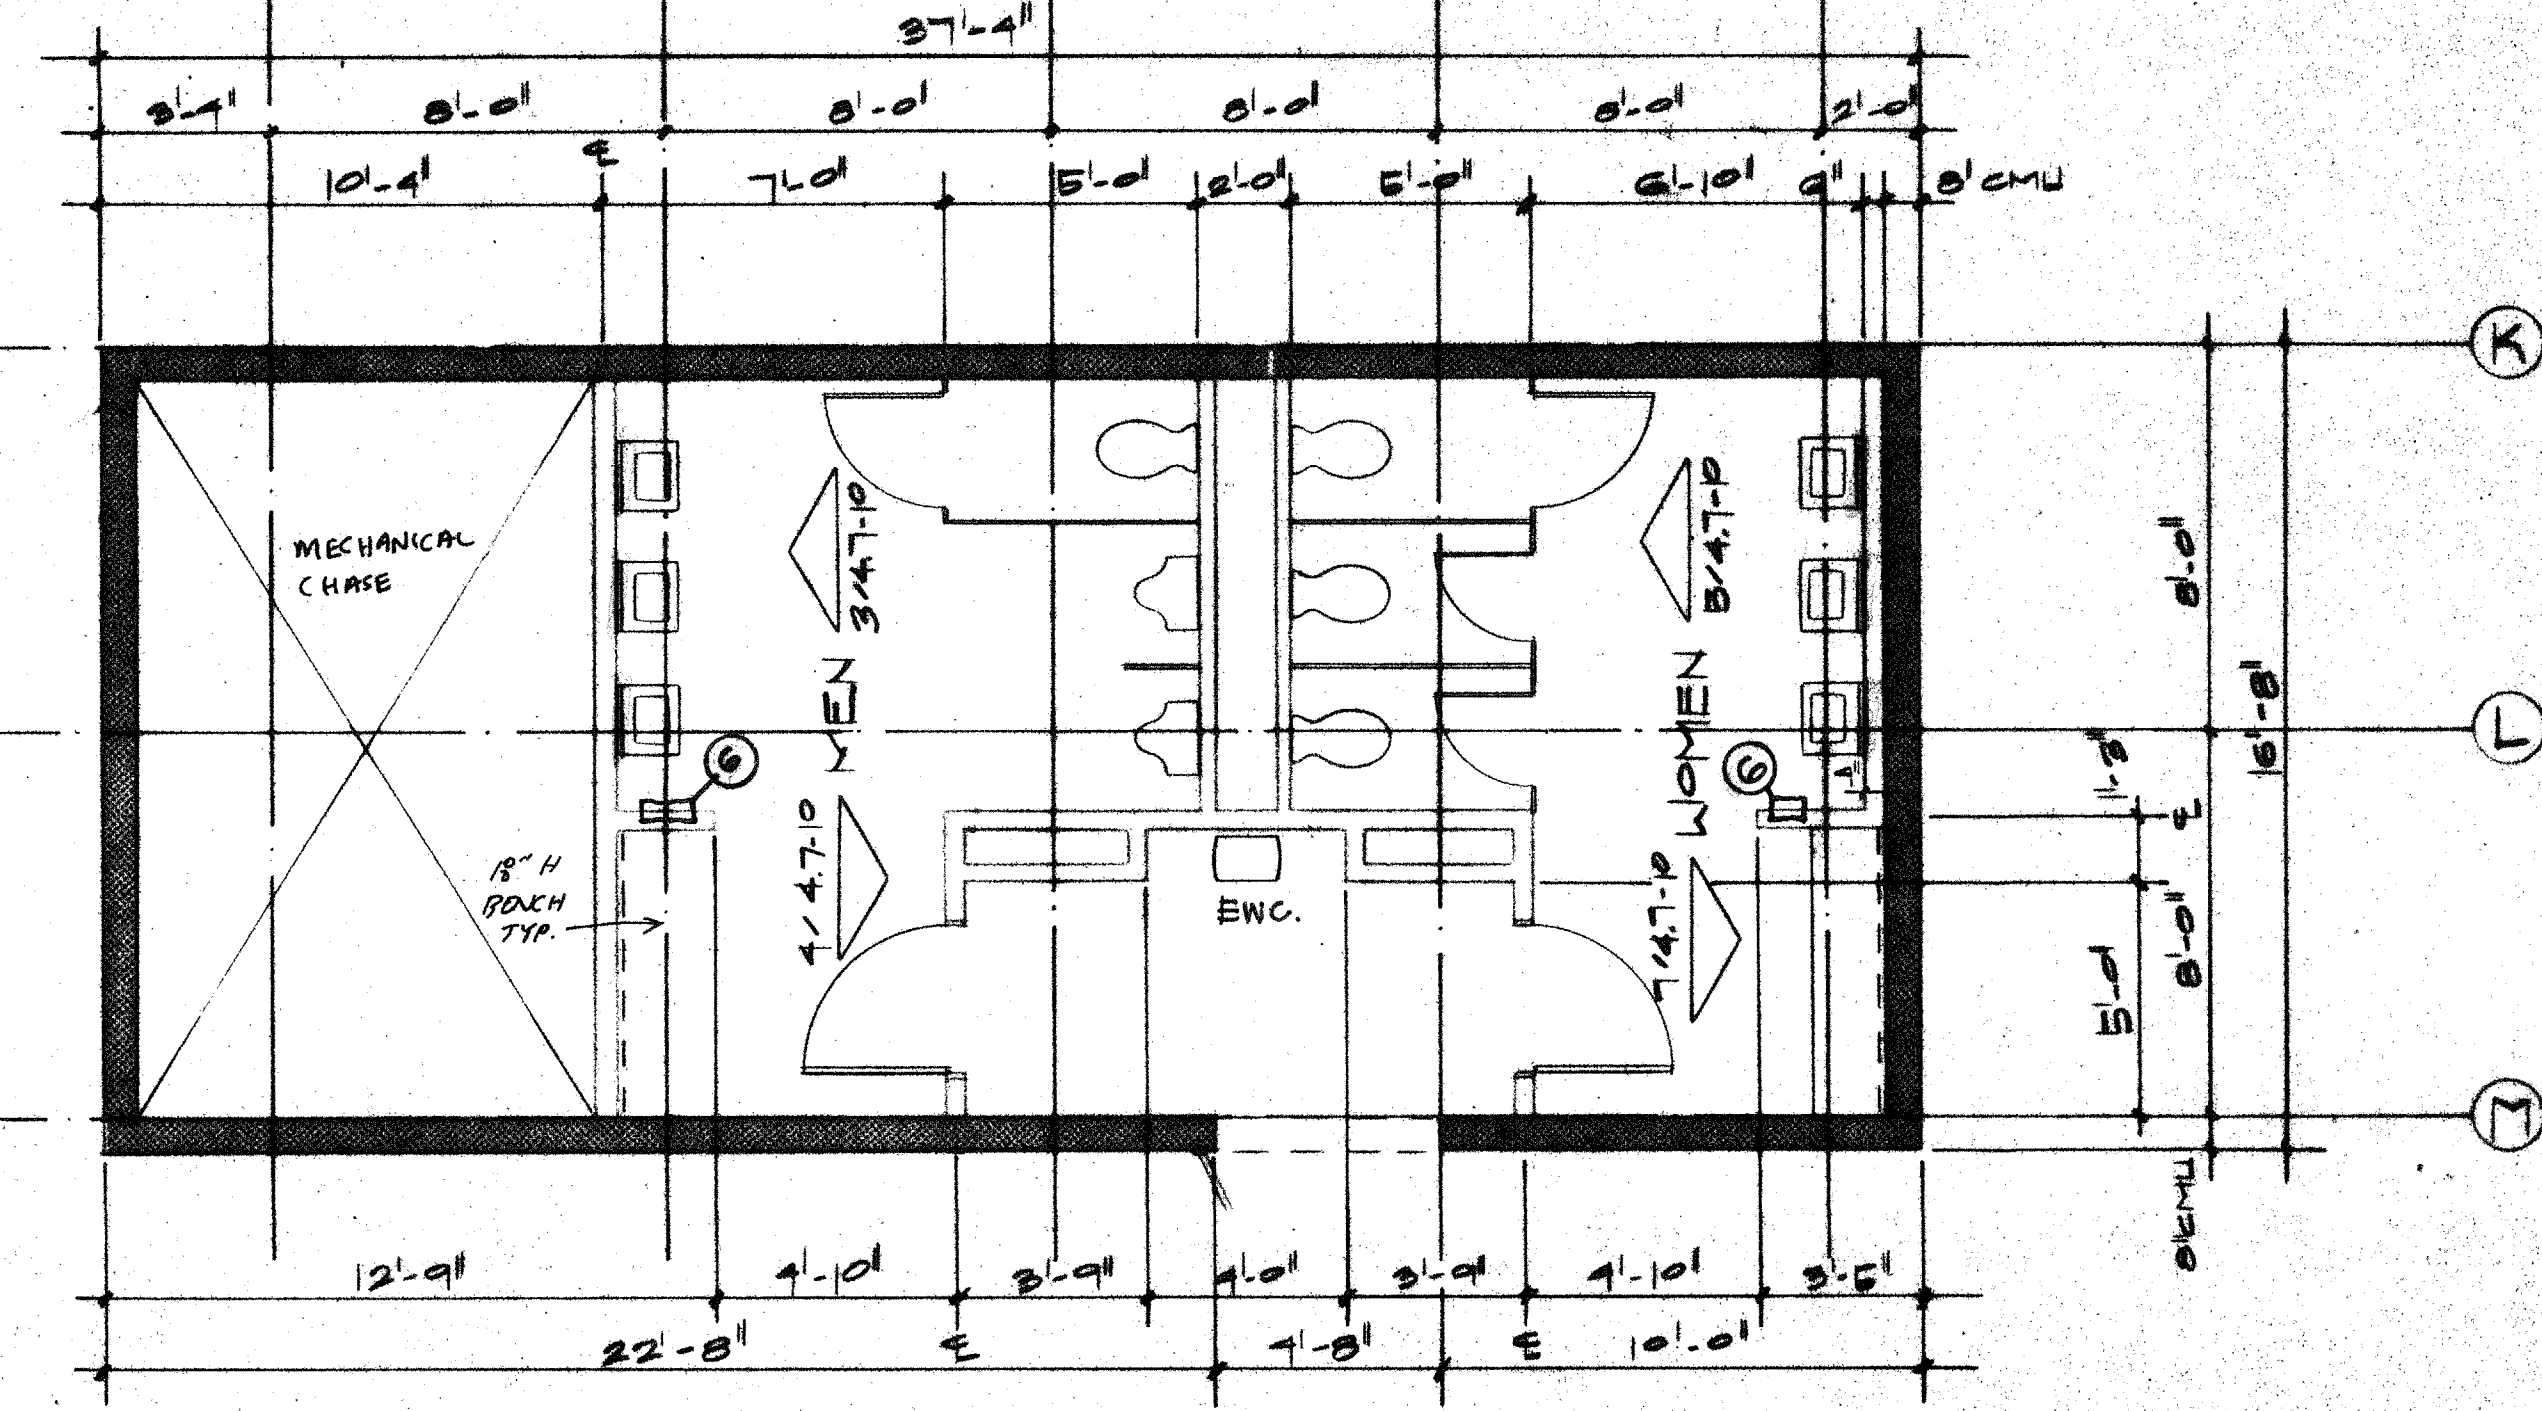

1 ENLARGED PLAN
1/4" = 1'-0"

- SCHEDULE OF TOILET AND BATH ACCESSORIES
- KEY ITEM
- 1 Toilet Paper Dispenser, Bobrick # B-274
 - 2 Paper Towel Dispenser, Bobrick # B-317
 - 3 Sanitary Napkin Disposal, Bobrick #B-354
 - 4 Sanitary Napkin Disposal, Bobrick #B-353
 - 5 Waste Paper Can, Bobrick # B-2260
 - 6 Trash Disposal, Bobrick # B-2200
 - 7 Utility Shelf, Bobrick # B-224, 36" long
 - 8 Shower Cupfawn and Bed, Bobrick # 302-2 w/204-1 hooks w/B-5107 Rod
 - 9 Towel Holder, Bobrick # B-423
 - 10 Handicap Bag, Bobrick # B-6206, one of 42" length, one of 30" length
 - 11 Shower Bars, Bobrick # B-530, 24" long

SEE SK 25 FOR TOILET ROOM DIM

