


1 LEVEL ONE REFLECTED CEILING PLAN

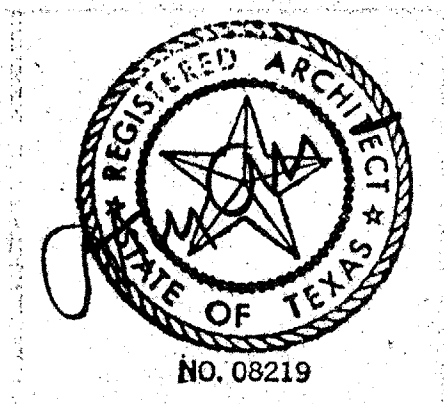

ACC • ACT
ADDISON

OWNER	LANDSCAPE	STRUCTURAL	HISTORIAN	Issue	Category	Subcategory	Sheet
The Kollins Group 317-76-447	The Kollins Group 317-76-447	Eliaz Turner 214-387-8283	Algo Mason 214-681-7852	ISSUE FOR BID 8-17-80	4	4	2
ARCHITECT: Cunningham Architects 2700 Fairmount Dallas, Texas 75201 214-865-5272	MECHANICAL CONSULTANT Theatre Projects 203-431-3949 214-865-5272	M.E.P. MEP Systems 214-754-4788	LIGHTING Pamela Hall Wilson 214-865-8642				
INTERIORS CRSS 713-582-2000		CIVIL Kurtz & Associates 214-688-3222	GRAPHERS Horstmann Design 214-864-8978				

T