


1 LEVEL TWO REFLECTED CEILING PLAN

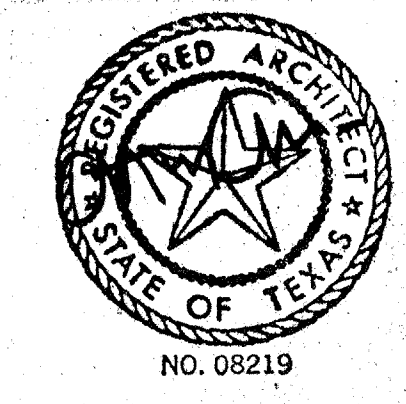

ACC ABDISON ACT

OWNER	LANDSCAPE	STRUCTURAL	HISTORIAN	ISSUE	CATEGORY	SUBCATEGORY	SHEET
The Kellam Group 214-387-8383	The Kellam Group 214-387-8383	Elcor Turner 214-691-782	Alan Mason 214-691-782	ISSUE FOR BID 8-17-90	4	4	3
ARCHITECT Carrington Architects 2703 Fernmount Dallas, Texas 75201 214-855-5272	THEATRE CONSULTANT Theatre Projects 203-431-3949	M.E.P. MEP Systems 214-754-4789	LIGHTING Pamela Hall Wilson 214-853-8542				
INTERIORS CRSS 713-552-2000	CIVIL Kurtz & Associates 214-680-3322	GRAPHICS Hatched Design 214-854-8976					