


1 LEVEL THREE REFLECTED CEILING PLAN
1/21/01

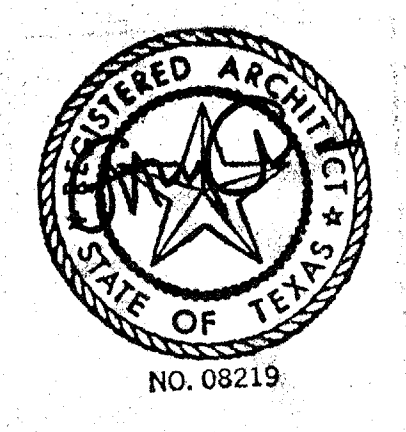

ACC ADDISON ACT

OWNER	LANDSCAPE	STRUCTURAL	HISTORIAN	Issue	Category	Subcategory	Sheet
The Kollens Group 307-78-447	The Kollens Group 307-78-447	Elsor Turner 214-367-8383	Algo Mason 214-891-7882	ISSUE FOR BID 8-17-00	4	4	4
ARCHITECT Cunneighan Architects 2700 Fairmount Dallas, Texas 75201 214-855-5272	THEATRE CONSULTANT Theatre Projects 202-431-3848	M.E.P. MEP Systems 214-754-4788	LIGHTING Pamela Hall Wilson 214-625-8842				
INTERIORS CRSS 710-552-2000		CIVIL Kurtz & Associates 214-688-3222	GRAPHICS Northland Design 214-854-1878				

T