




4 WEST ELEVATION

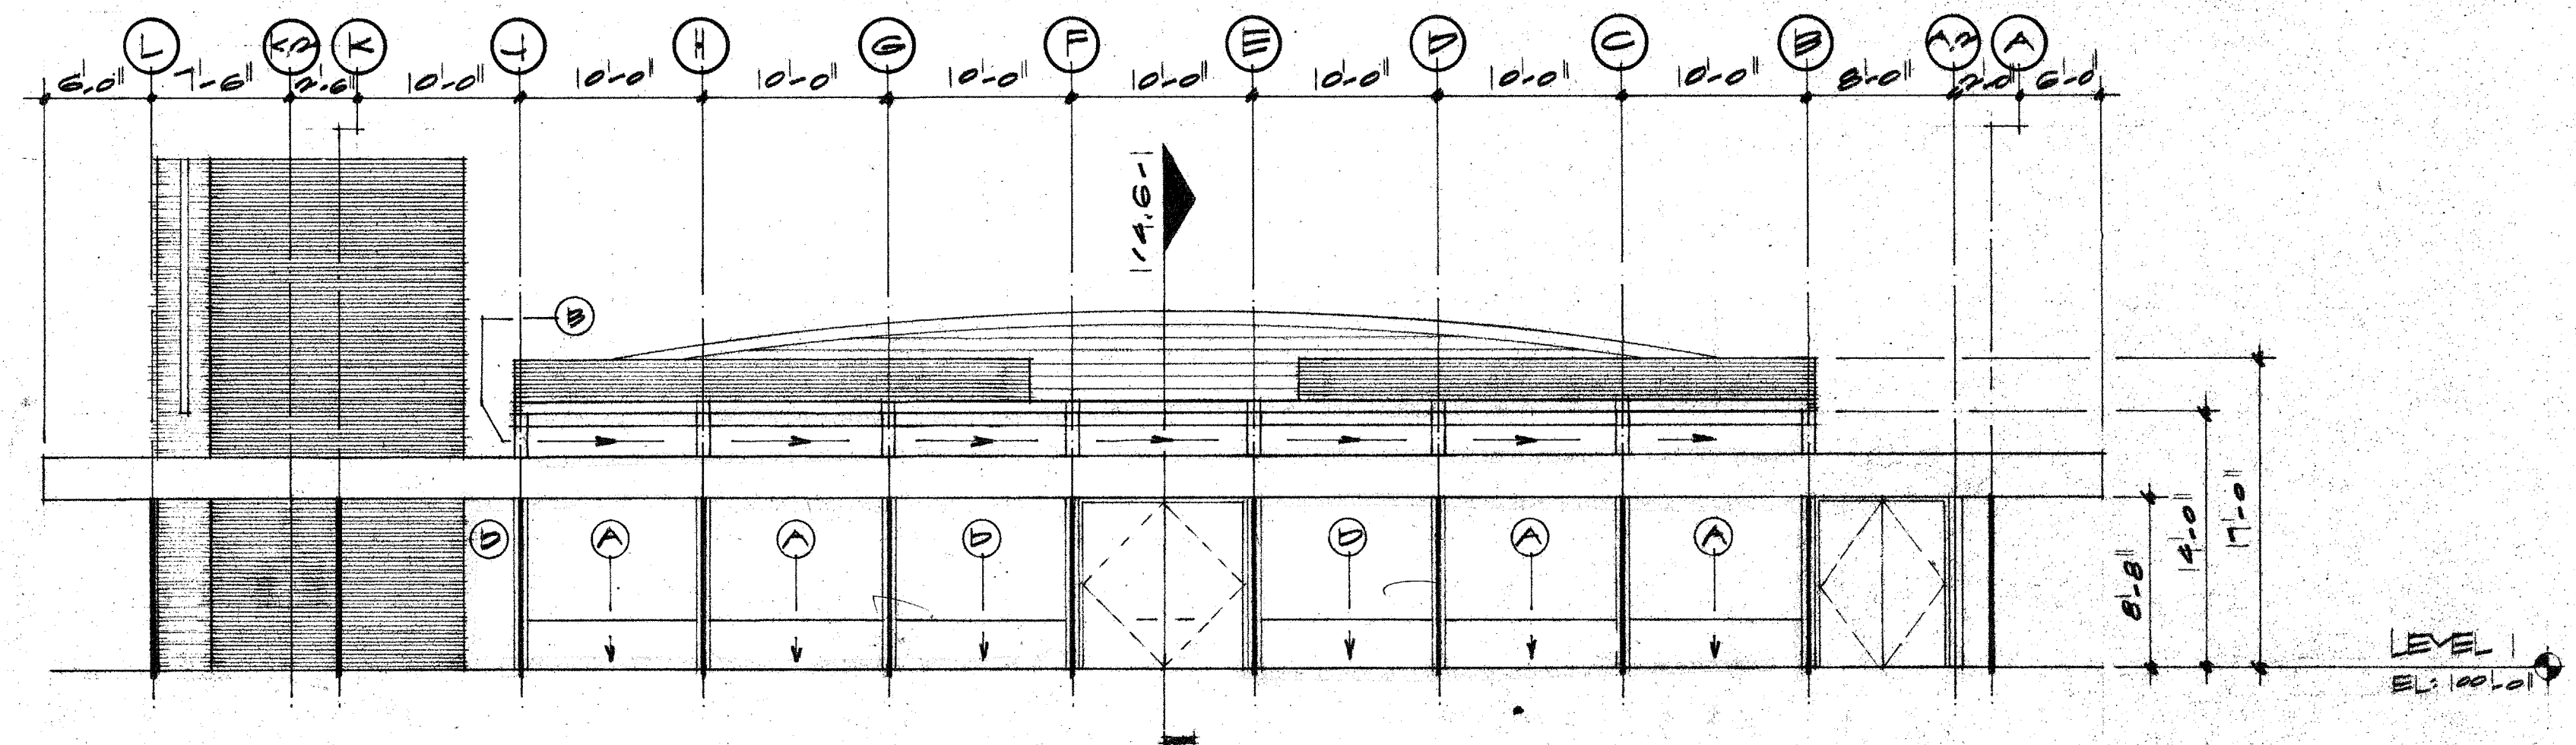

3 EAST ELEVATION

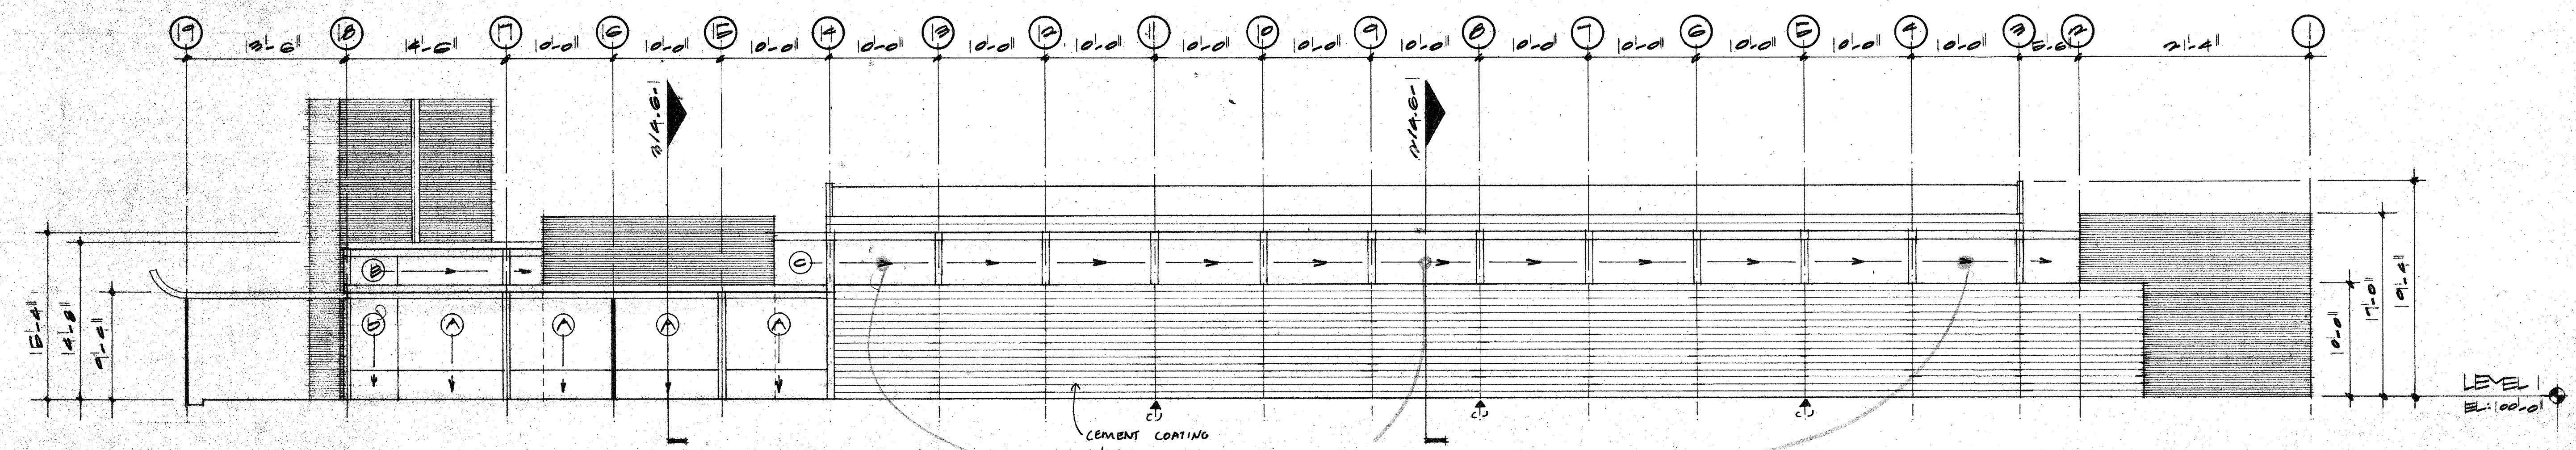


2 NORTH ELEVATION

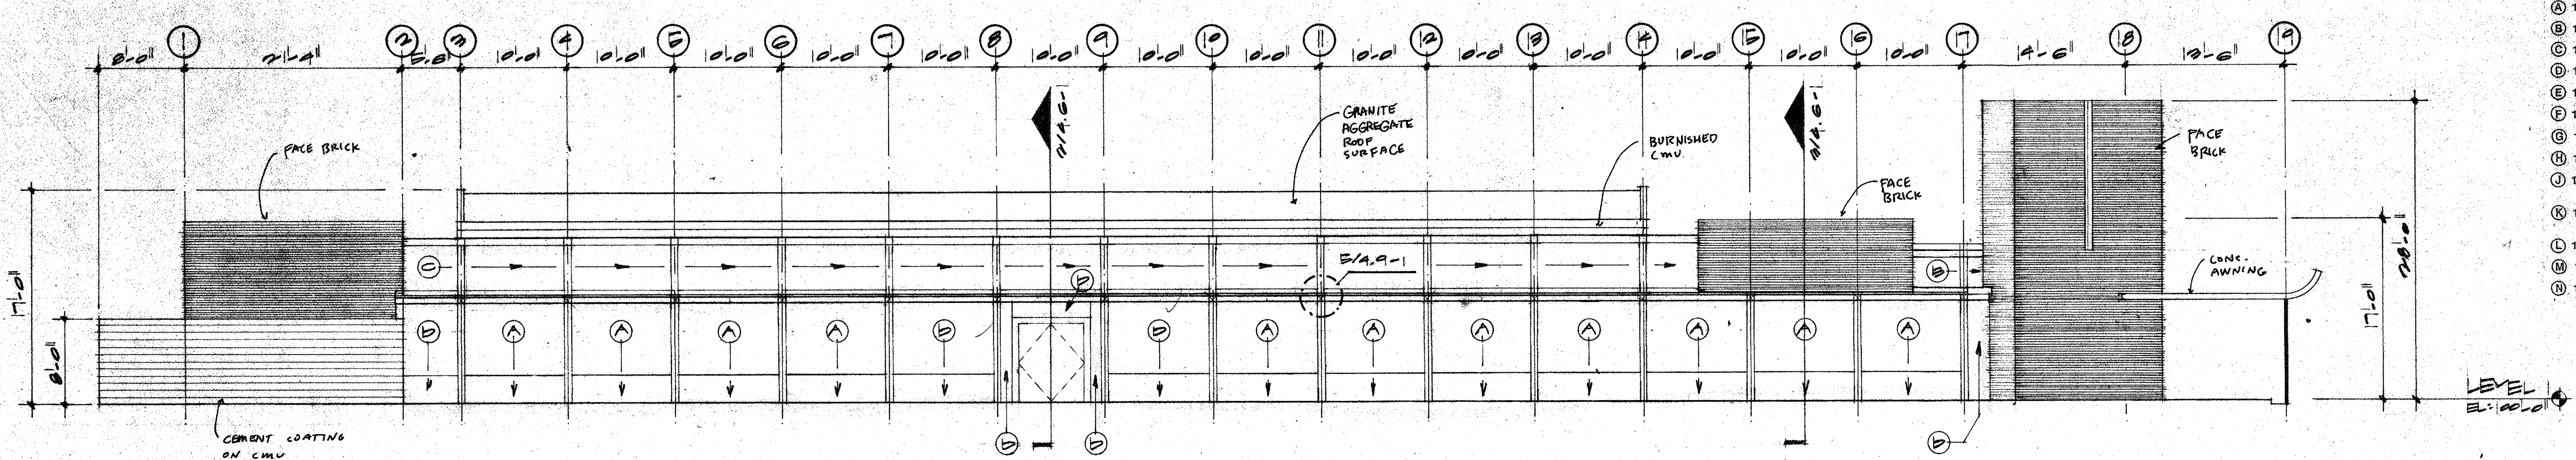

1 SOUTH ELEVATION

- GLASS SCHEDULE
- Key Type
- (A) 1/4" Clear Float Glass in Zipper Gasket System
 - (B) 1/4" Patterned Float Glass in Zipper Gasket System
 - (C) 1/4" Ceramic Coated Spandrel Tempered Glass in Zipper Gasket System
 - (D) 1/4" Clear Tempered Glass in Zipper Gasket System
 - (E) 1/4" Clear Float Glass in Aluminum Storefront System
 - (F) 1/4" Clear Tempered Glass in Aluminum Storefront System
 - (G) 1/4" Patterned Float Glass in Aluminum Storefront System
 - (H) 1/4" Patterned Tempered Glass in Aluminum Storefront System
 - (I) 1-3/4" Insulating Acoustic Unit (1/4" x .030 x 1/4" x 1/8" x 1/8") in Gouted Hollow Metal Frame
 - (K) 1-3/4" Insulating Acoustic Unit (1/4" x .030 x 1/4" x 1/8" x 1/8") in Custom Steel Tube Glazing or Door
 - (L) 1/4" Clear Laminated (1/8" x .030 x 1/8") Glass in Single Hung Aluminum Window
 - (M) 1/4" Tempered Patterned Glass in Single Hung Aluminum Window
 - (N) 1/4" Clear Float Glass in Gouted Hollow Metal Frame

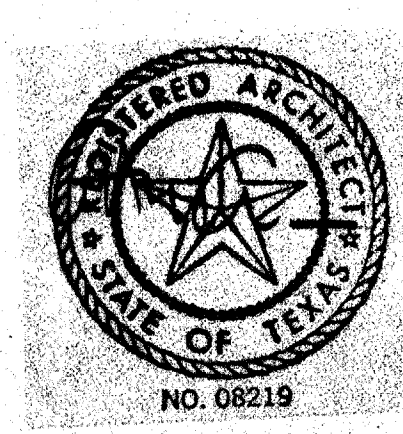

ACC ADDISON ACT

OWNER	LANDSCAPE	STRUCTURAL	HISTORICAL	Issue	Category	Subcategory	Sheet
Town of Addison The Kellams Group 317-776-1417	CAVINGHAM ARCHITECTS 2700 Fairmont Dallas, Texas 75201 214-855-9272	THEATRE CONSULTANT Theatre Projects 203-431-3849	M.E.P. MEP Systems 214-754-4741	INTERIORS CRSS 713-552-2000	ISSUE FOR BID 6-17-00	4	5
							1

C