


1 WEST SITE ELEVATION
 1/8" = 1'-0"

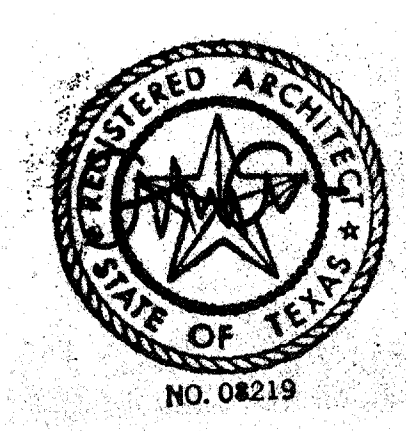

ACC ADDISON ACT

OWNER Town of Addison	LANDSCAPE The Kellams Group 317-776-1417	STRUCTURAL Ellisor Tanner 214-831-8333	HISTORIAN Alan Mason 214-831-7182	Issue	Category	Subcategory	Sheet
ARCHITECT Cunningham Architects 2700 Fairmount Dallas, Texas 75201 214-855-5272	THEATRE CONSULTANT Theatre Projects 203-431-3949	M.E.P. MEP Systems 214-754-4741	LIGHTING Pamela Hull Wilson 214-823-6542	ISSUE FOR BID 8-17-90	4	5	2
INTERIORS CRSS 713-552-2000	CIVIL Kurtz & Associates 214-890-3322	GRAPHICS Hottelstad Design 214-954-1876					

c