


**GLASS SCHEDULE**

Key Type

- (A) 1/4" Clear Float Glass in Zipper Gasket System
- (B) 1/4" Patterned Float Glass in Zipper Gasket System
- (C) 1/4" Ceramic Coated Spandrel Tempered Glass in Zipper Gasket System
- (D) 1/4" Clear Tempered Glass in Zipper Gasket System
- (E) 1/4" Clear Float Glass in Aluminum Storefront System
- (F) 1/4" Clear Tempered Glass in Aluminum Storefront System
- (G) 1/4" Patterned Float Glass in Aluminum Storefront System
- (H) 1/4" Patterned Tempered Glass in Aluminum Storefront System
- (J) 1-3/4" Insulating Acoustic Unit (1/4"x.030x1/4"x.1as+1/8"x1/8") in Grouted Hollow Metal Frame
- (K) 1-3/4" Insulating Acoustic Unit (1/4"x.030x1/4"x.1as+1/8"x1/8") in Custom Steel Tube Glazing or Door
- (L) 1/4" Clear Laminated (1/8"x.030x1/8") Glass in Single Hung Aluminum Window
- (M) 1/4" Tempered Patterned Glass in Single Hung Aluminum Window
- (N) 1/4" Clear Float Glass in Grouted Hollow Metal Frame

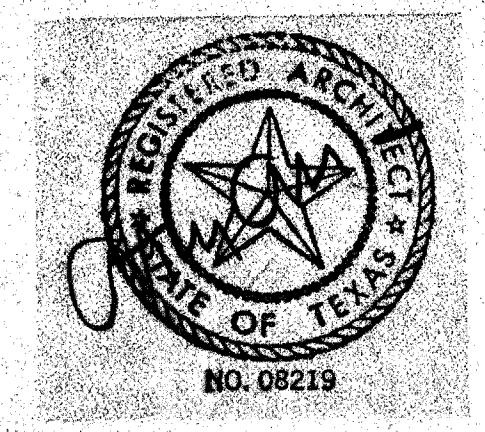

ACC ADDISON ACT

<b>OWNER</b> Town of Addison The Kallias Group 317-778-1417	<b>LANDSCAPE</b> The Kallias Group 317-778-1417	<b>STRUCTURAL</b> Ellisor Tanner 214-367-4333	<b>HISTORIAN</b> Alan Mason 214-691-7182
<b>ARCHITECT</b> Cunningham Architects 2700 Fairmount Dallas, Texas 75201 214-855-5272	<b>THEATRE CONSULTANT</b> Theatre Projects 214-431-3943	<b>M.E.P.</b> MEP Systems 214-754-4741	<b>LIGHTING</b> Pancate Hall Wilson 214-823-8542
<b>INTERIORS</b> CRSS 713-552-2000	<b>CIVIL</b> Kurtz & Associates 214-690-3322	<b>GRAPHICS</b> Motivated Design 214-694-8078	

Issue	Category	Subcategory	Sheet
ISSUE FOR BID 8-17-00	4	5	4

T