

Add 2 Channel

The drawing shows a corner of a room. The left wall is 6" thick, and the right wall is 3 1/2" thick. A horizontal line extends from the top of the 6" wall to the right, labeled "3 1/2\" data-bbox="450 100 550 150"/> GYP. BRD (PAINTED) ON 3 1/2" MTL STUD.


~~3 1/2" GYP. BRD  
ON 3 1/2" MTL STUD.~~

~~3 1/2" GYP. BRD  
ON 6" MTL STUD. (BEYOND)~~

~~6" Ø PIPE COL~~

FALLING CP  
NOT SHOWN  
CLARITY.

A large, bold, black-outlined font spells out the word "COACH". The letter "O" is particularly large and prominent. In the center of the letter "O", there is a small circular logo featuring a profile of a person's head facing left, with the word "ADDISON" printed below it.

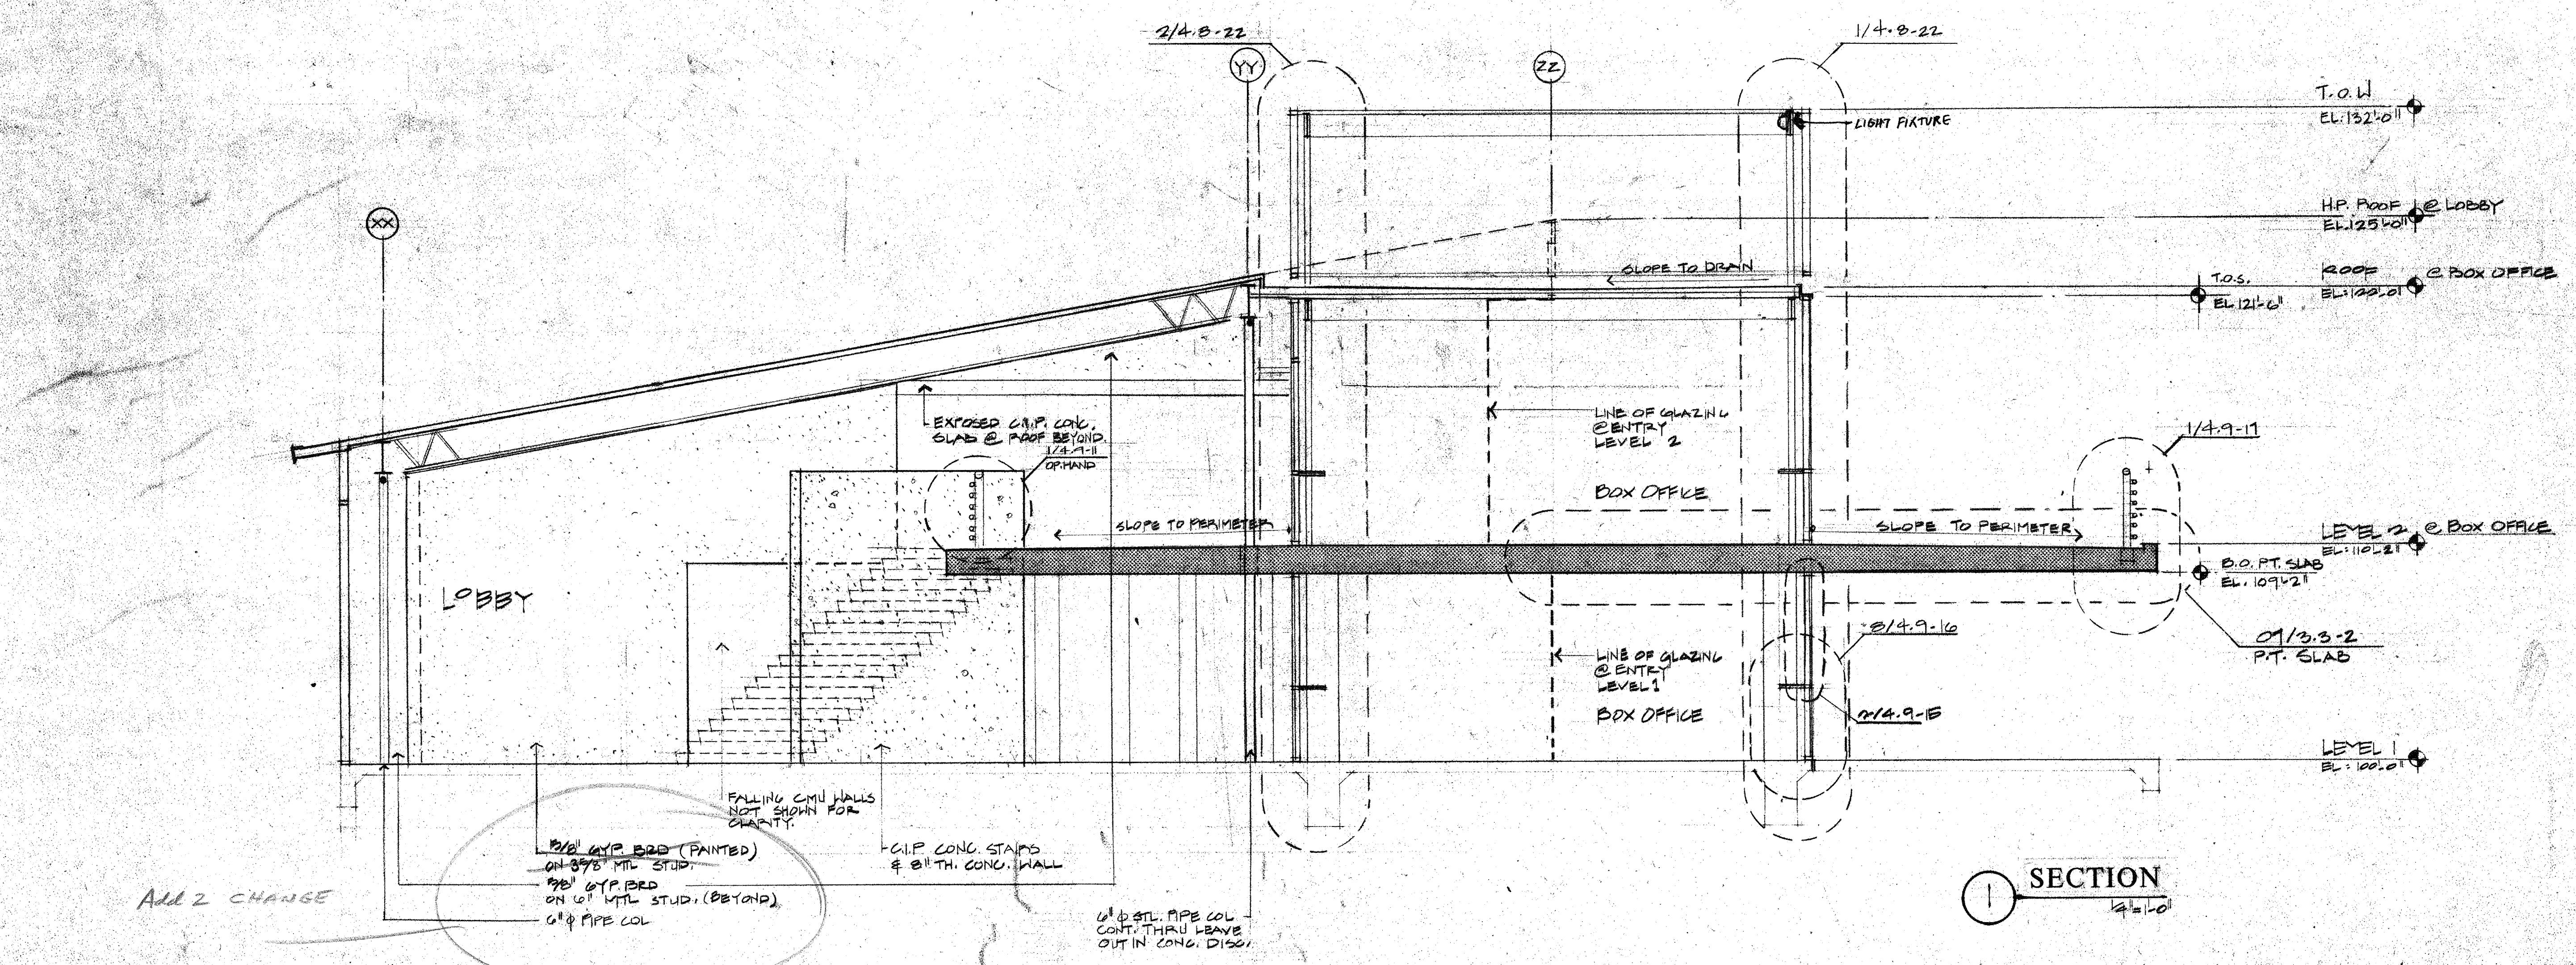

<b>OWNER</b>	<b>LANDSCAPE</b>	<b>STRUCTURAL</b>	<b>HISTORIAN</b>	<b>ISSUE</b>
<b>Town of Addison</b>	The Kellams Group 317-776-1417	Ellisor Tanner 214-387-8393	Alan Mason 214-691-7182	<b>ISSUE FOR BID 8-17-90</b>
<b>ARCHITECT</b>				
<b>Cunningham Architects</b> 2700 Fairmount Dallas, Texas 75201 214-855-5272	<b>THEATRE CONSULTANT</b> Theatre Projects 203-431-3949	<b>M.E.P.</b> MEP Systems 214-754-4741	<b>LIGHTING</b> Pamela Hull Wilson 214-823-6542	
	<b>INTERIORS</b> CRSS 713-552-2000	<b>CIVIL</b> Kurtz & Associates 214-690-3322	<b>GRAPHICS</b> Nottestad Design 214-954-1978	

ISSUE FOR BID 8-17-90

**Category**      **Subcategory**      **Sheet**