




11 MEN'S TOILET  
1/4" = 1'-0"

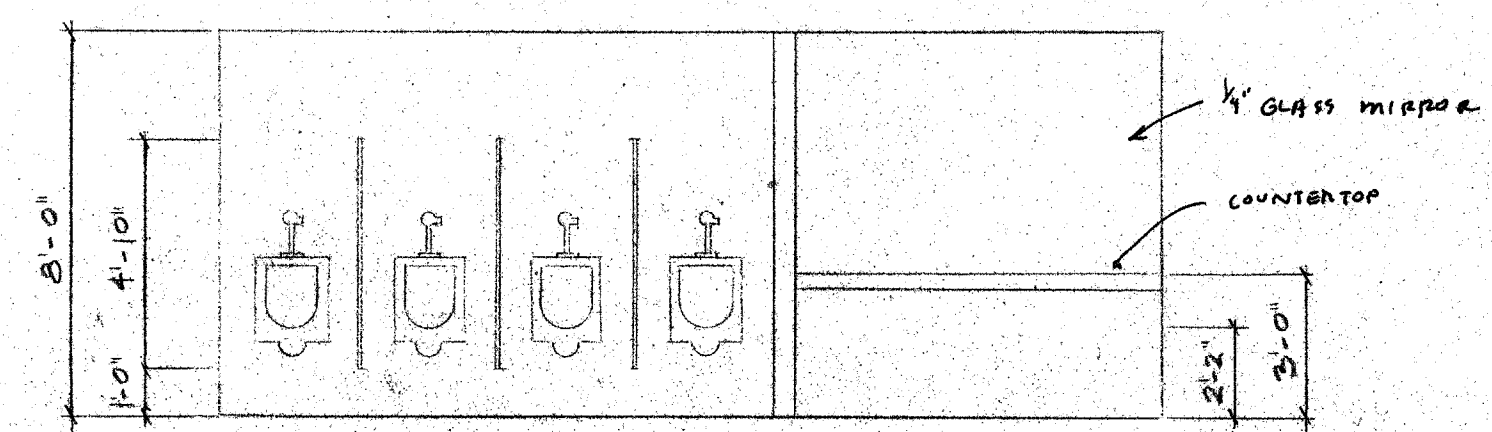


7 MEN'S TOILET  
1/4" = 1'-0"

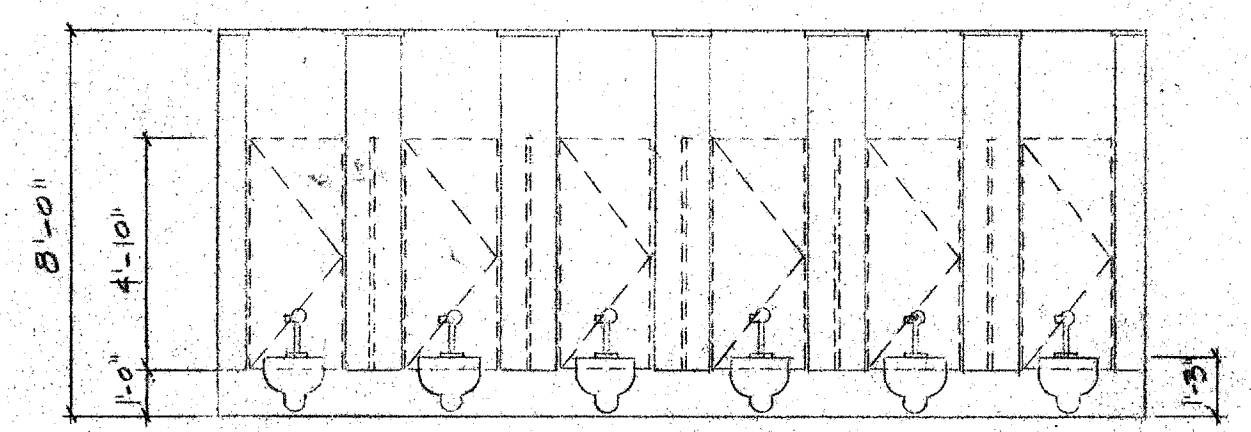

6 WOMEN'S TOILET  
1/4" = 1'-0"

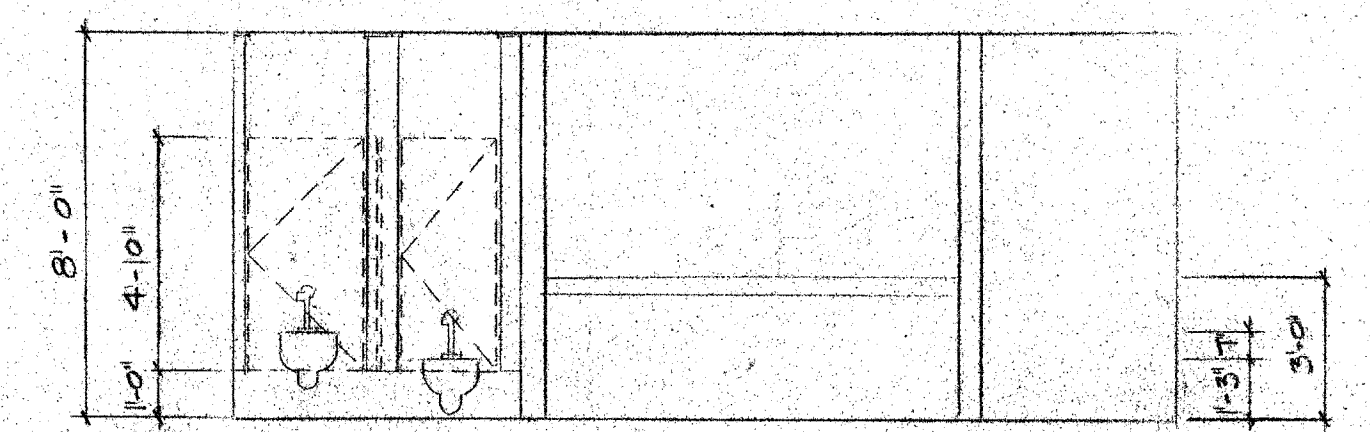


4 WOMEN'S TOILET  
1/4" = 1'-0"

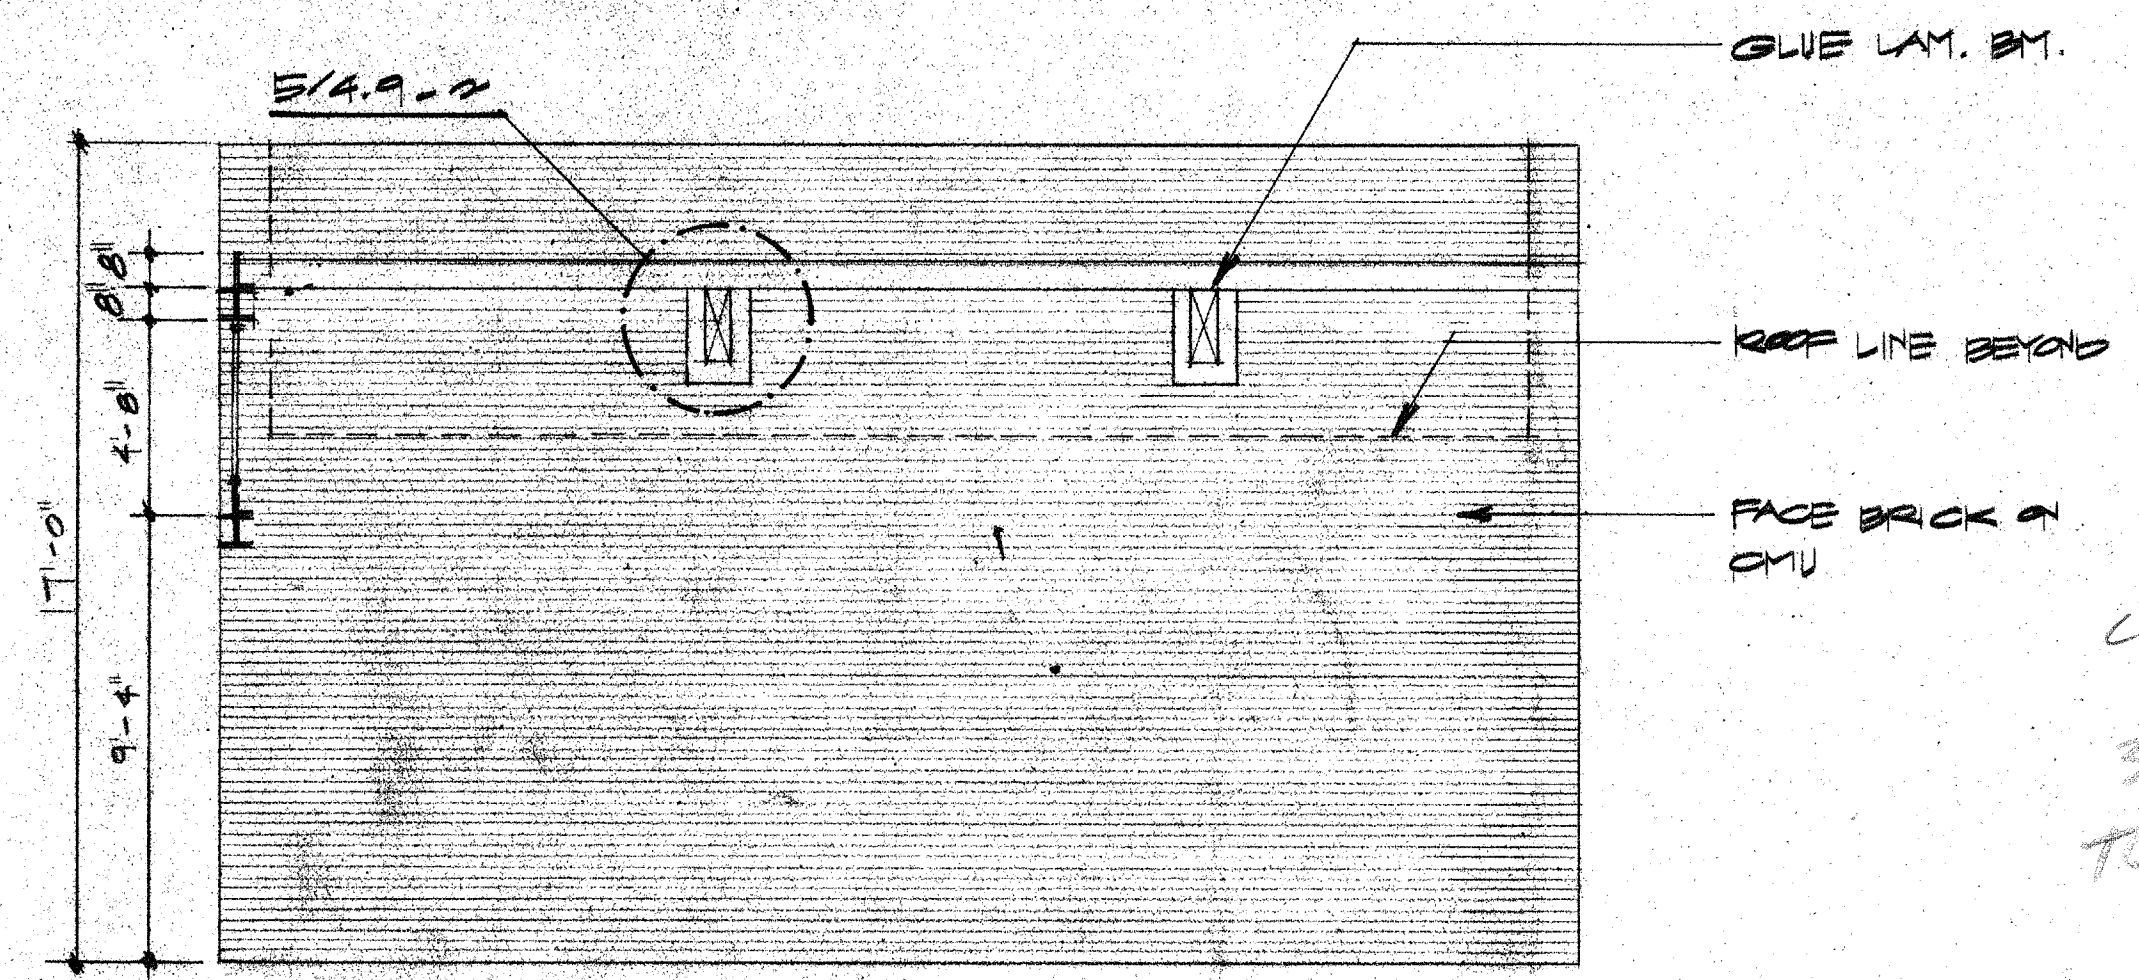


10 LOBBY  
1/4" = 1'-0"


DUCT SIZE CHANGED BY CORRY TO 30" x 26" TO ACCOMMODATE STRUCTURE

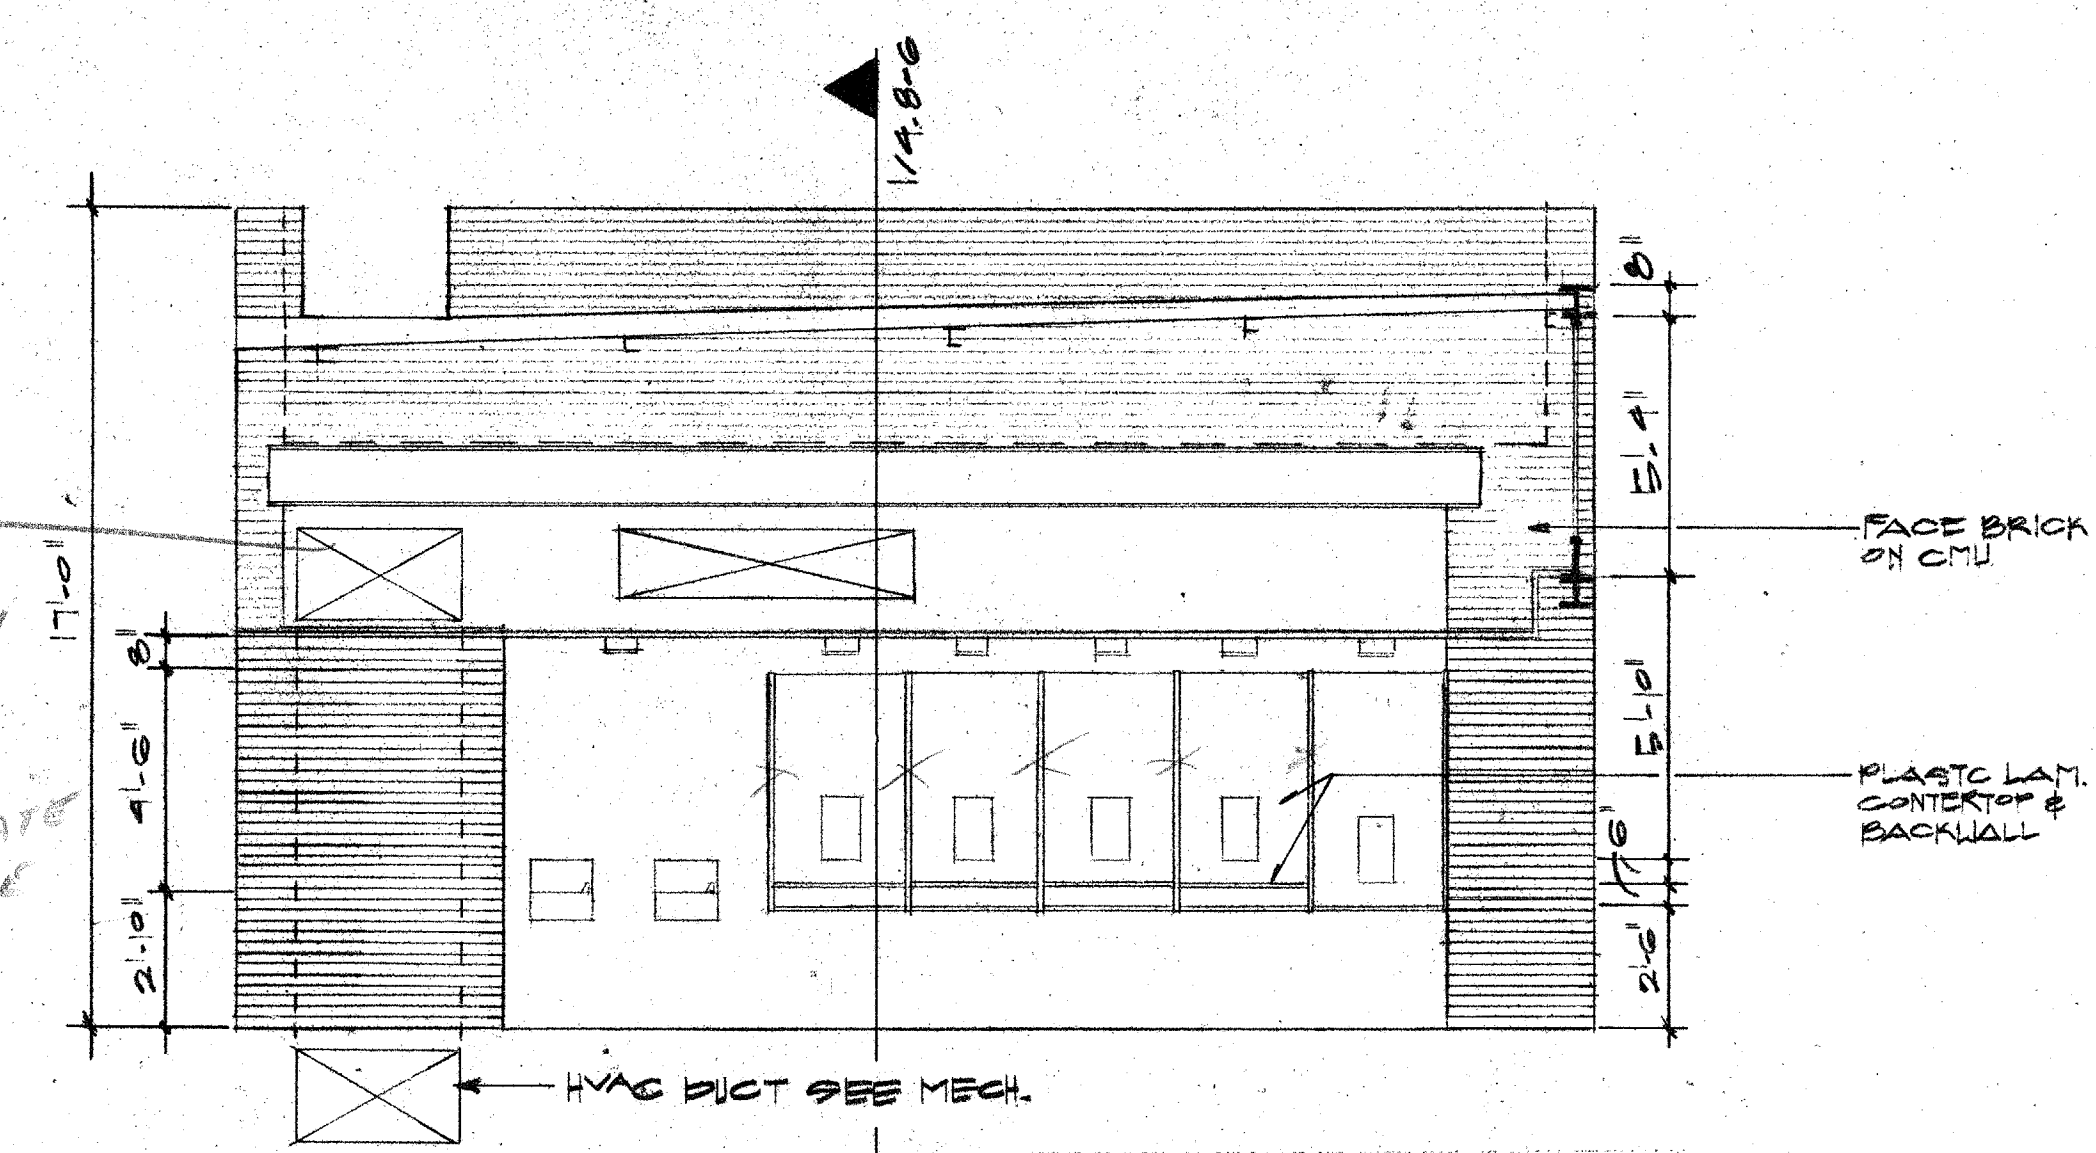


5 LOBBY @ PHONES  
1/4" = 1'-0"

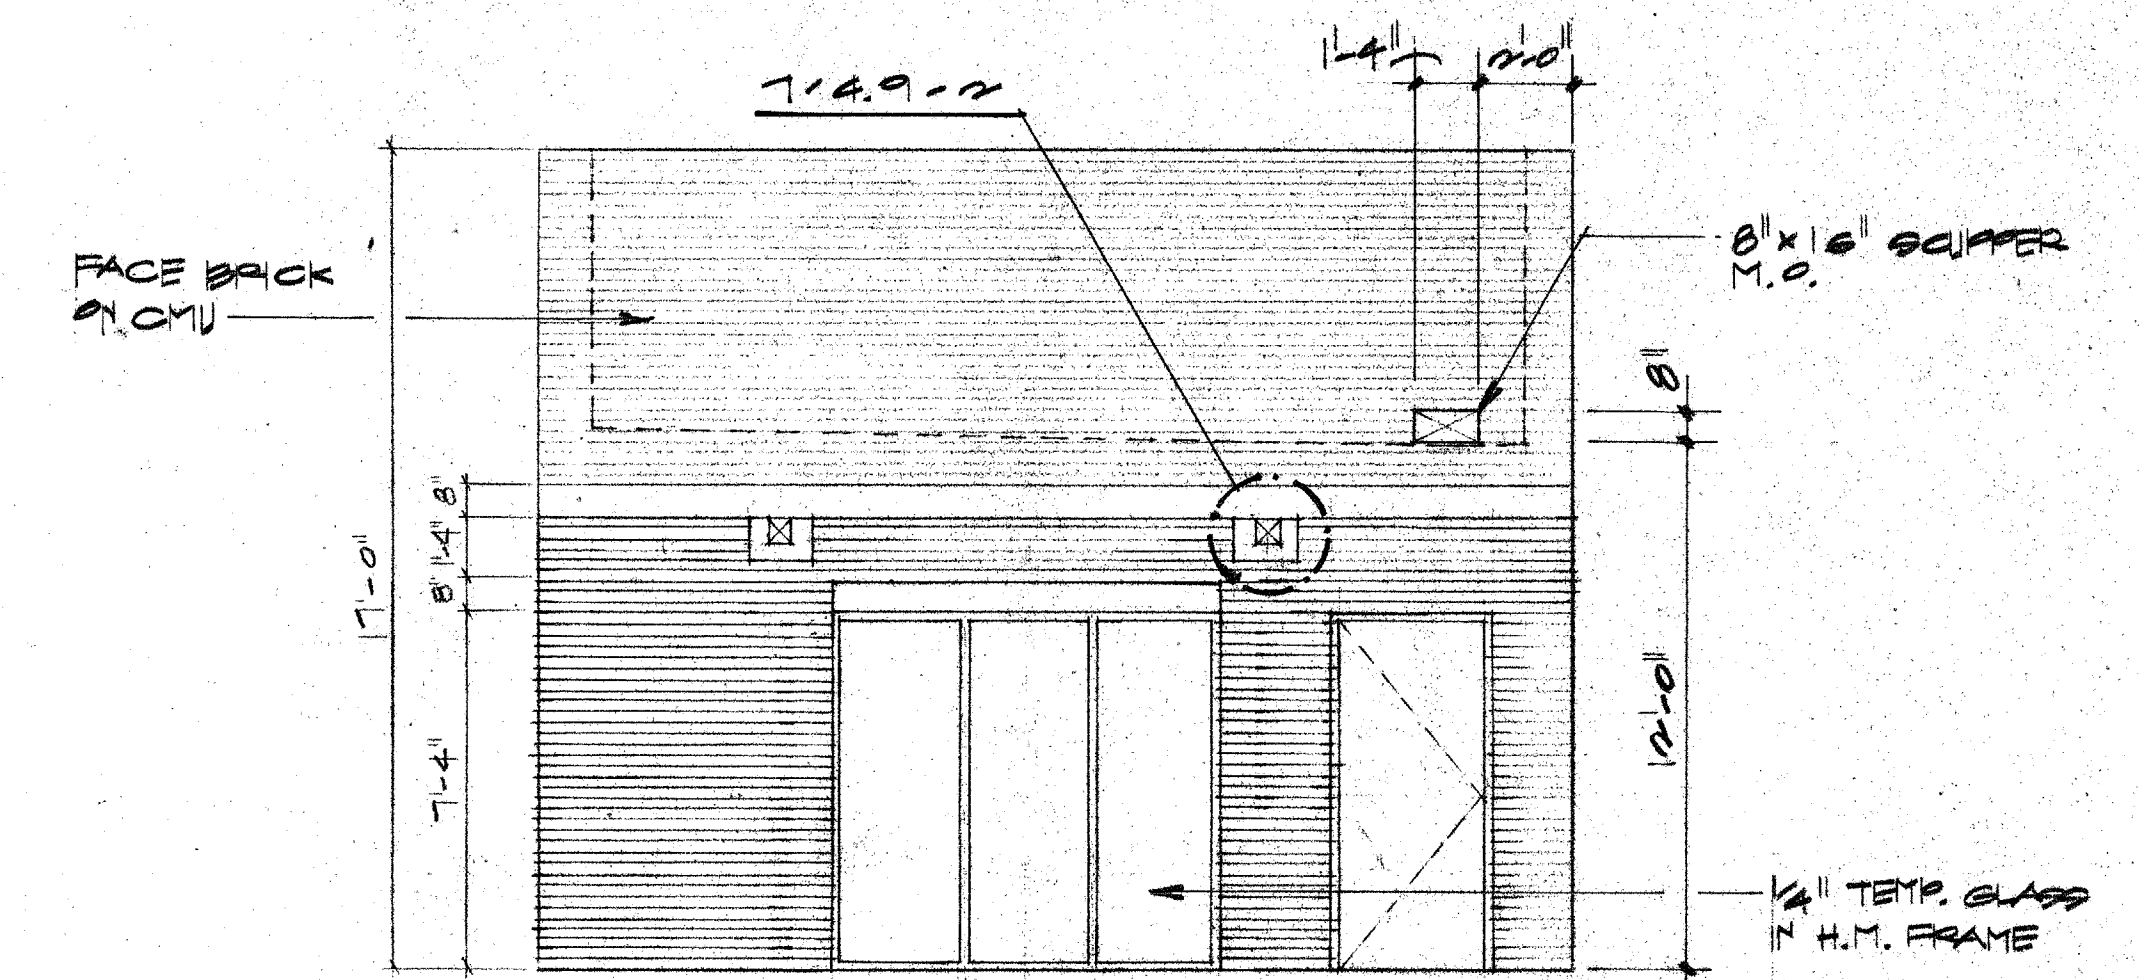


3 LOBBY @ OFFICE  
1/4" = 1'-0"

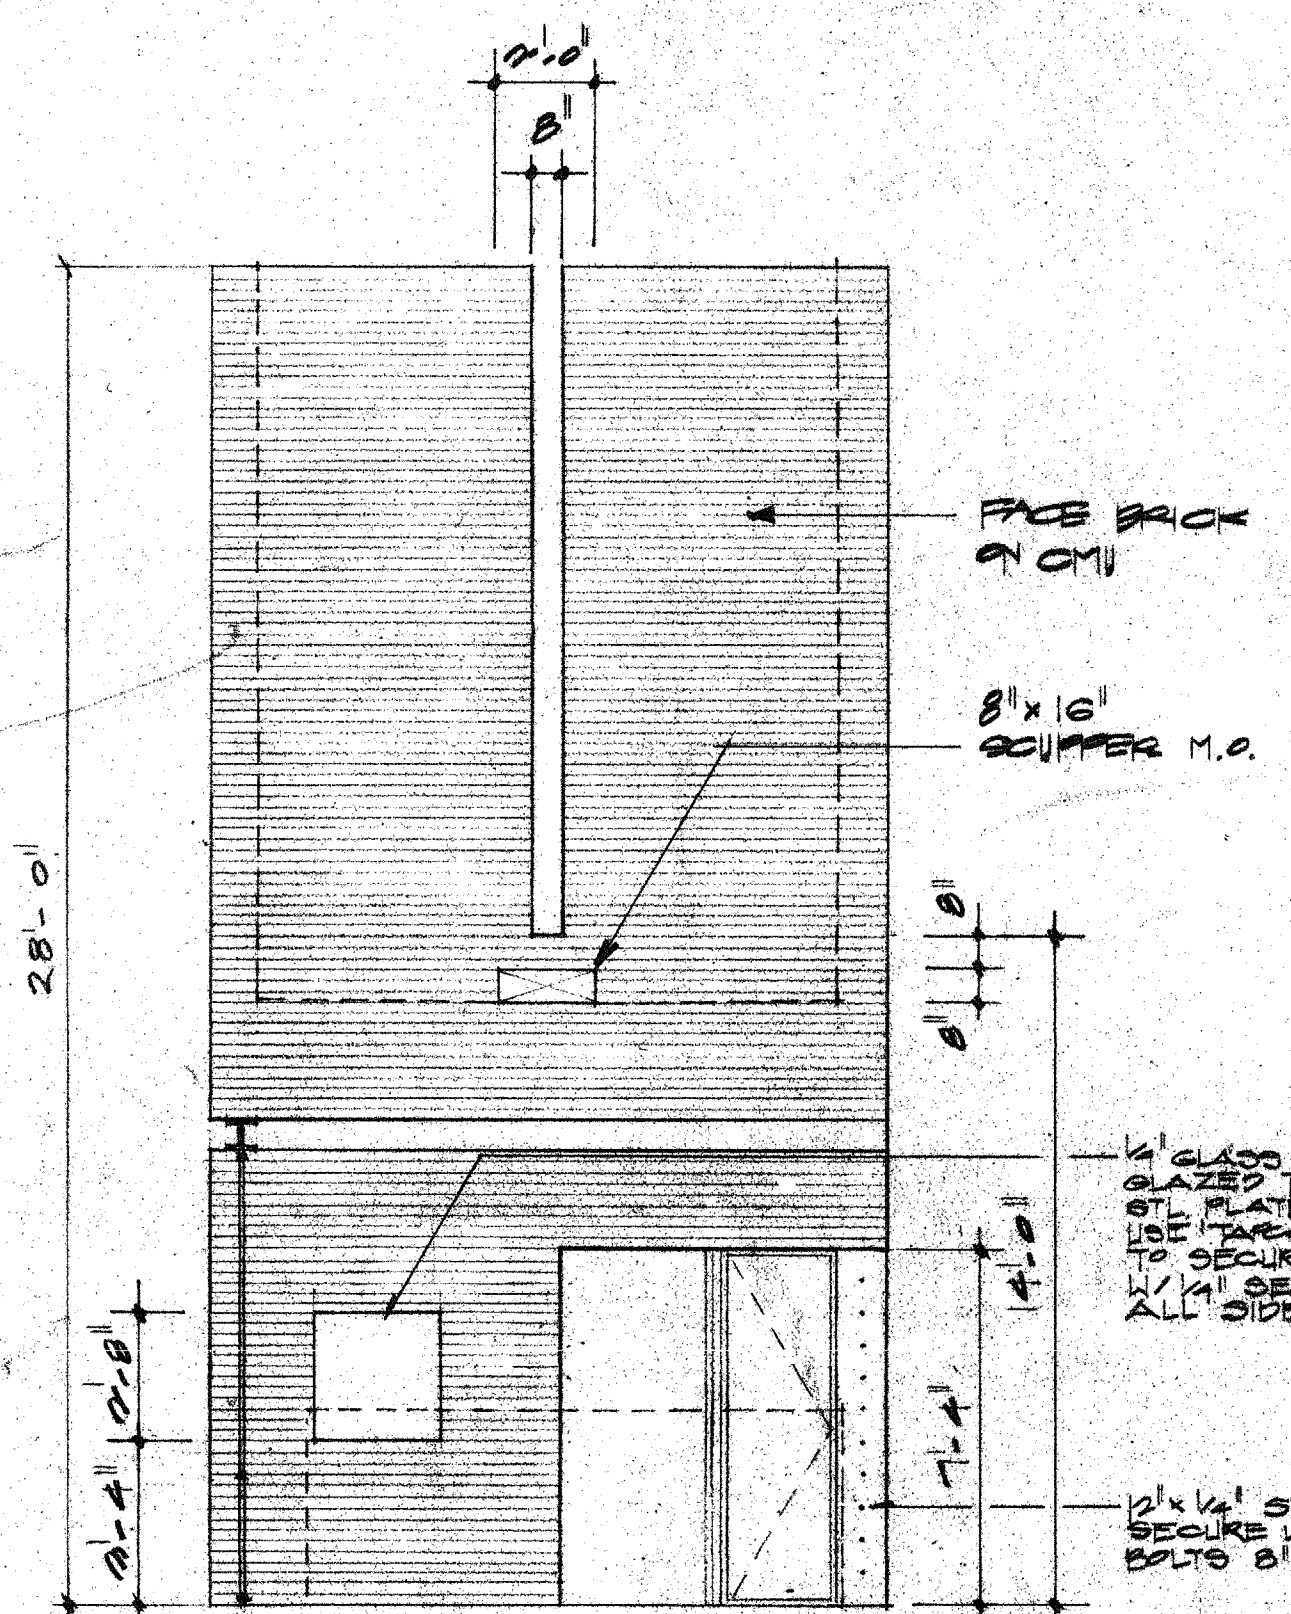


8 LOBBY @ RECEPTION  
1/4" = 1'-0"

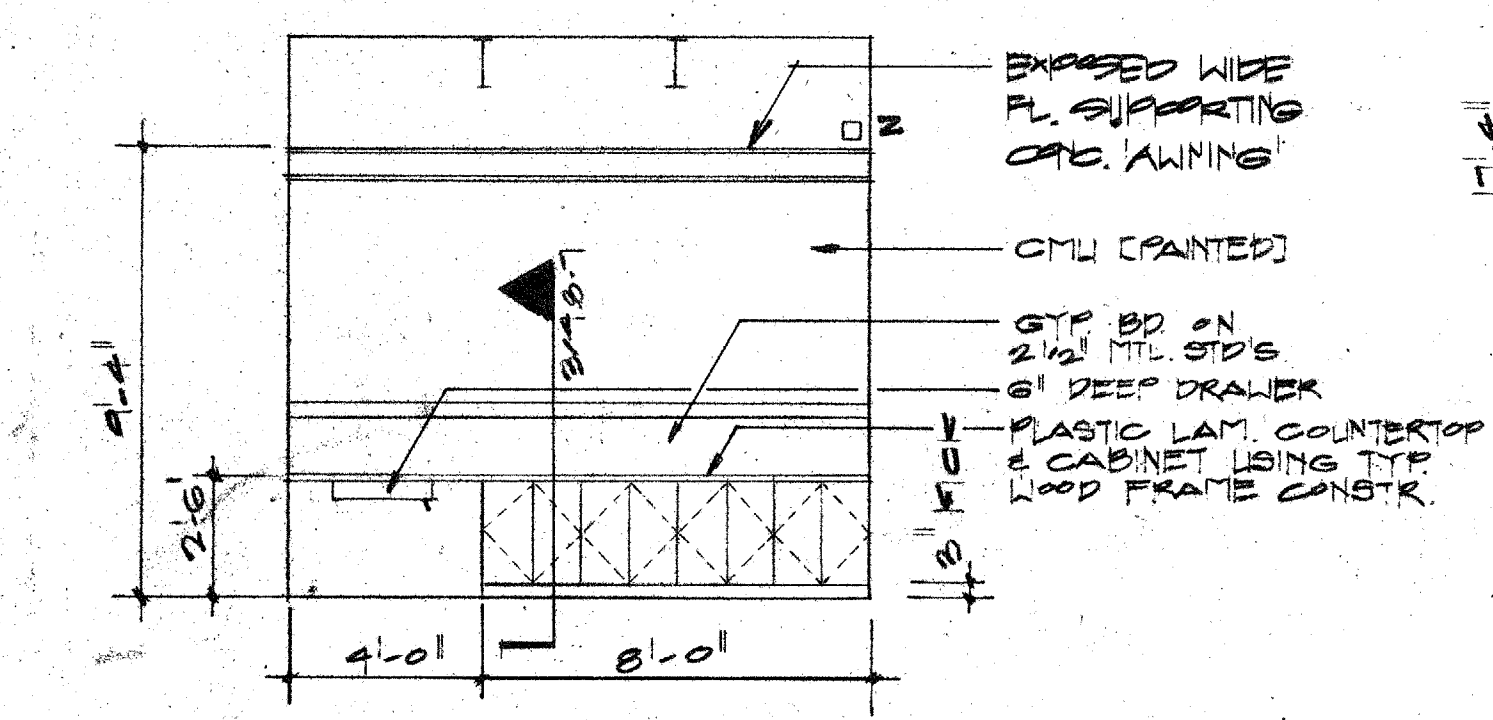

9 RECEPTION OFFICE  
1/4" = 1'-0"

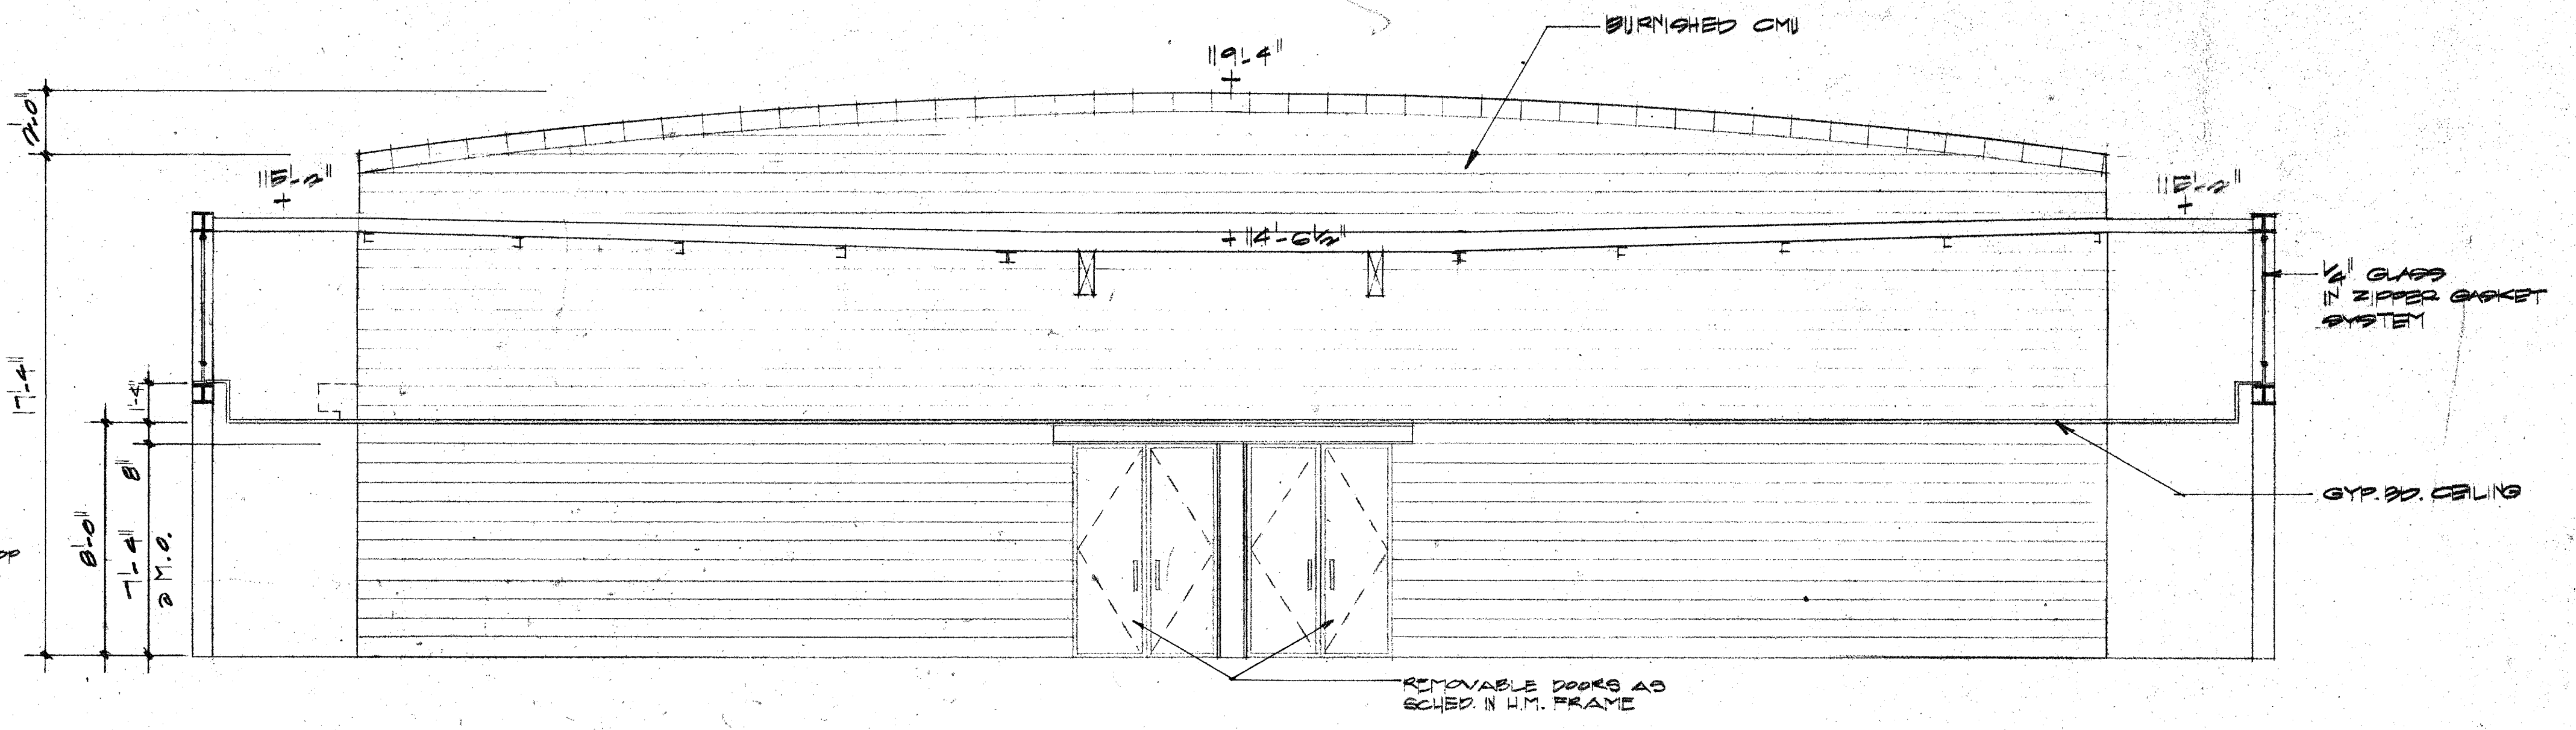

2 CONFERENCE CENTER  
1/4" = 1'-0"

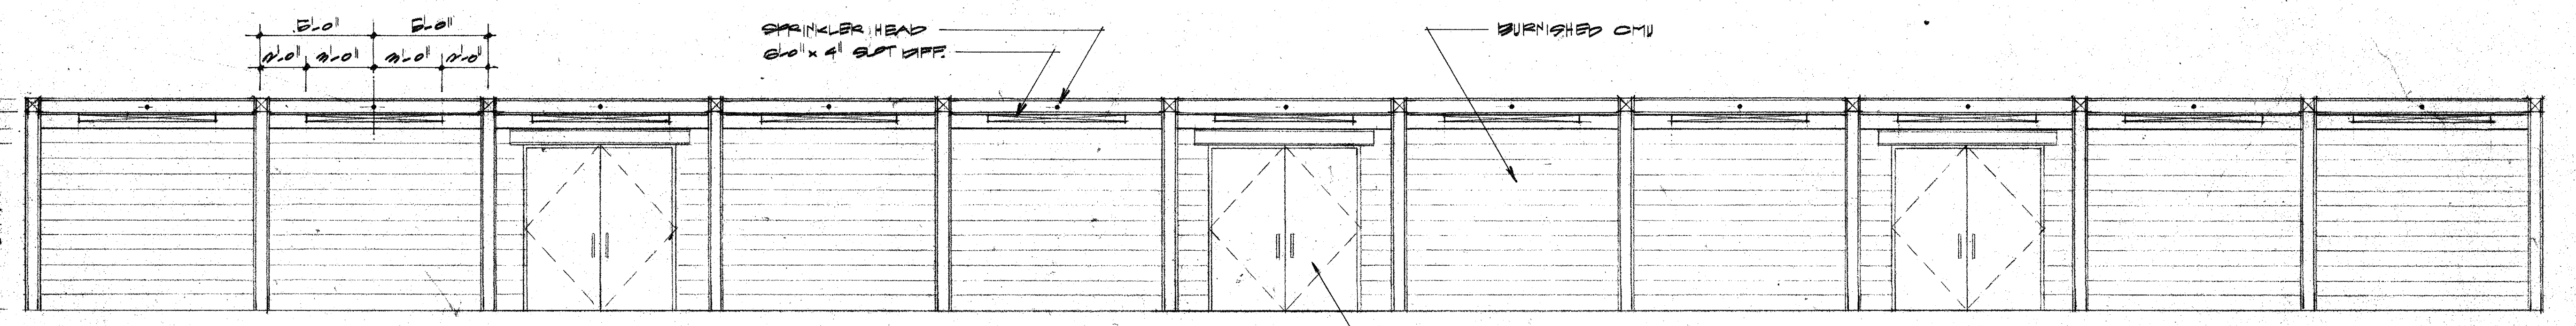

1 PRE-FUNCTION  
1/4" = 1'-0"



ACC ADDISON ACT

OWNER	LANDSCAPE	STRUCTURAL	HISTORIAN	Issue	Category	Subcategory	Sheet
Town of Addison The Kellars Group 312-776-1477	The Kellars Group 312-776-1477	Elliot Janner 214-387-8393	Alan Mason 214-698-7192	Issue FOR BID 8-17-90	4	7	1
ARCHITECT Cunningham Architects 2700 Fairmount Dallas, Texas 75201 214-855-5272	THEATRE CONSULTANT Theatre Projects 203-431-3949	M.E.P. MEP Systems 214-754-4741	LIGHTING Pamela Hull Wilson 281-823-8542				
INTERIORS CRSS 713-552-2000		CIVIL Kurtz & Associates 214-690-3322	GRAPHICS Notstard Design 214-354-9178				