


2 INTERIOR ELEVATION DETAIL
1/4" = 1'-0"


EXTENT OF GLUE LAM. HIGH POINT

TOP OF STEEL
EL: 108'0 1/2"

FF EL 100'-0"
FF EL 100'-0"

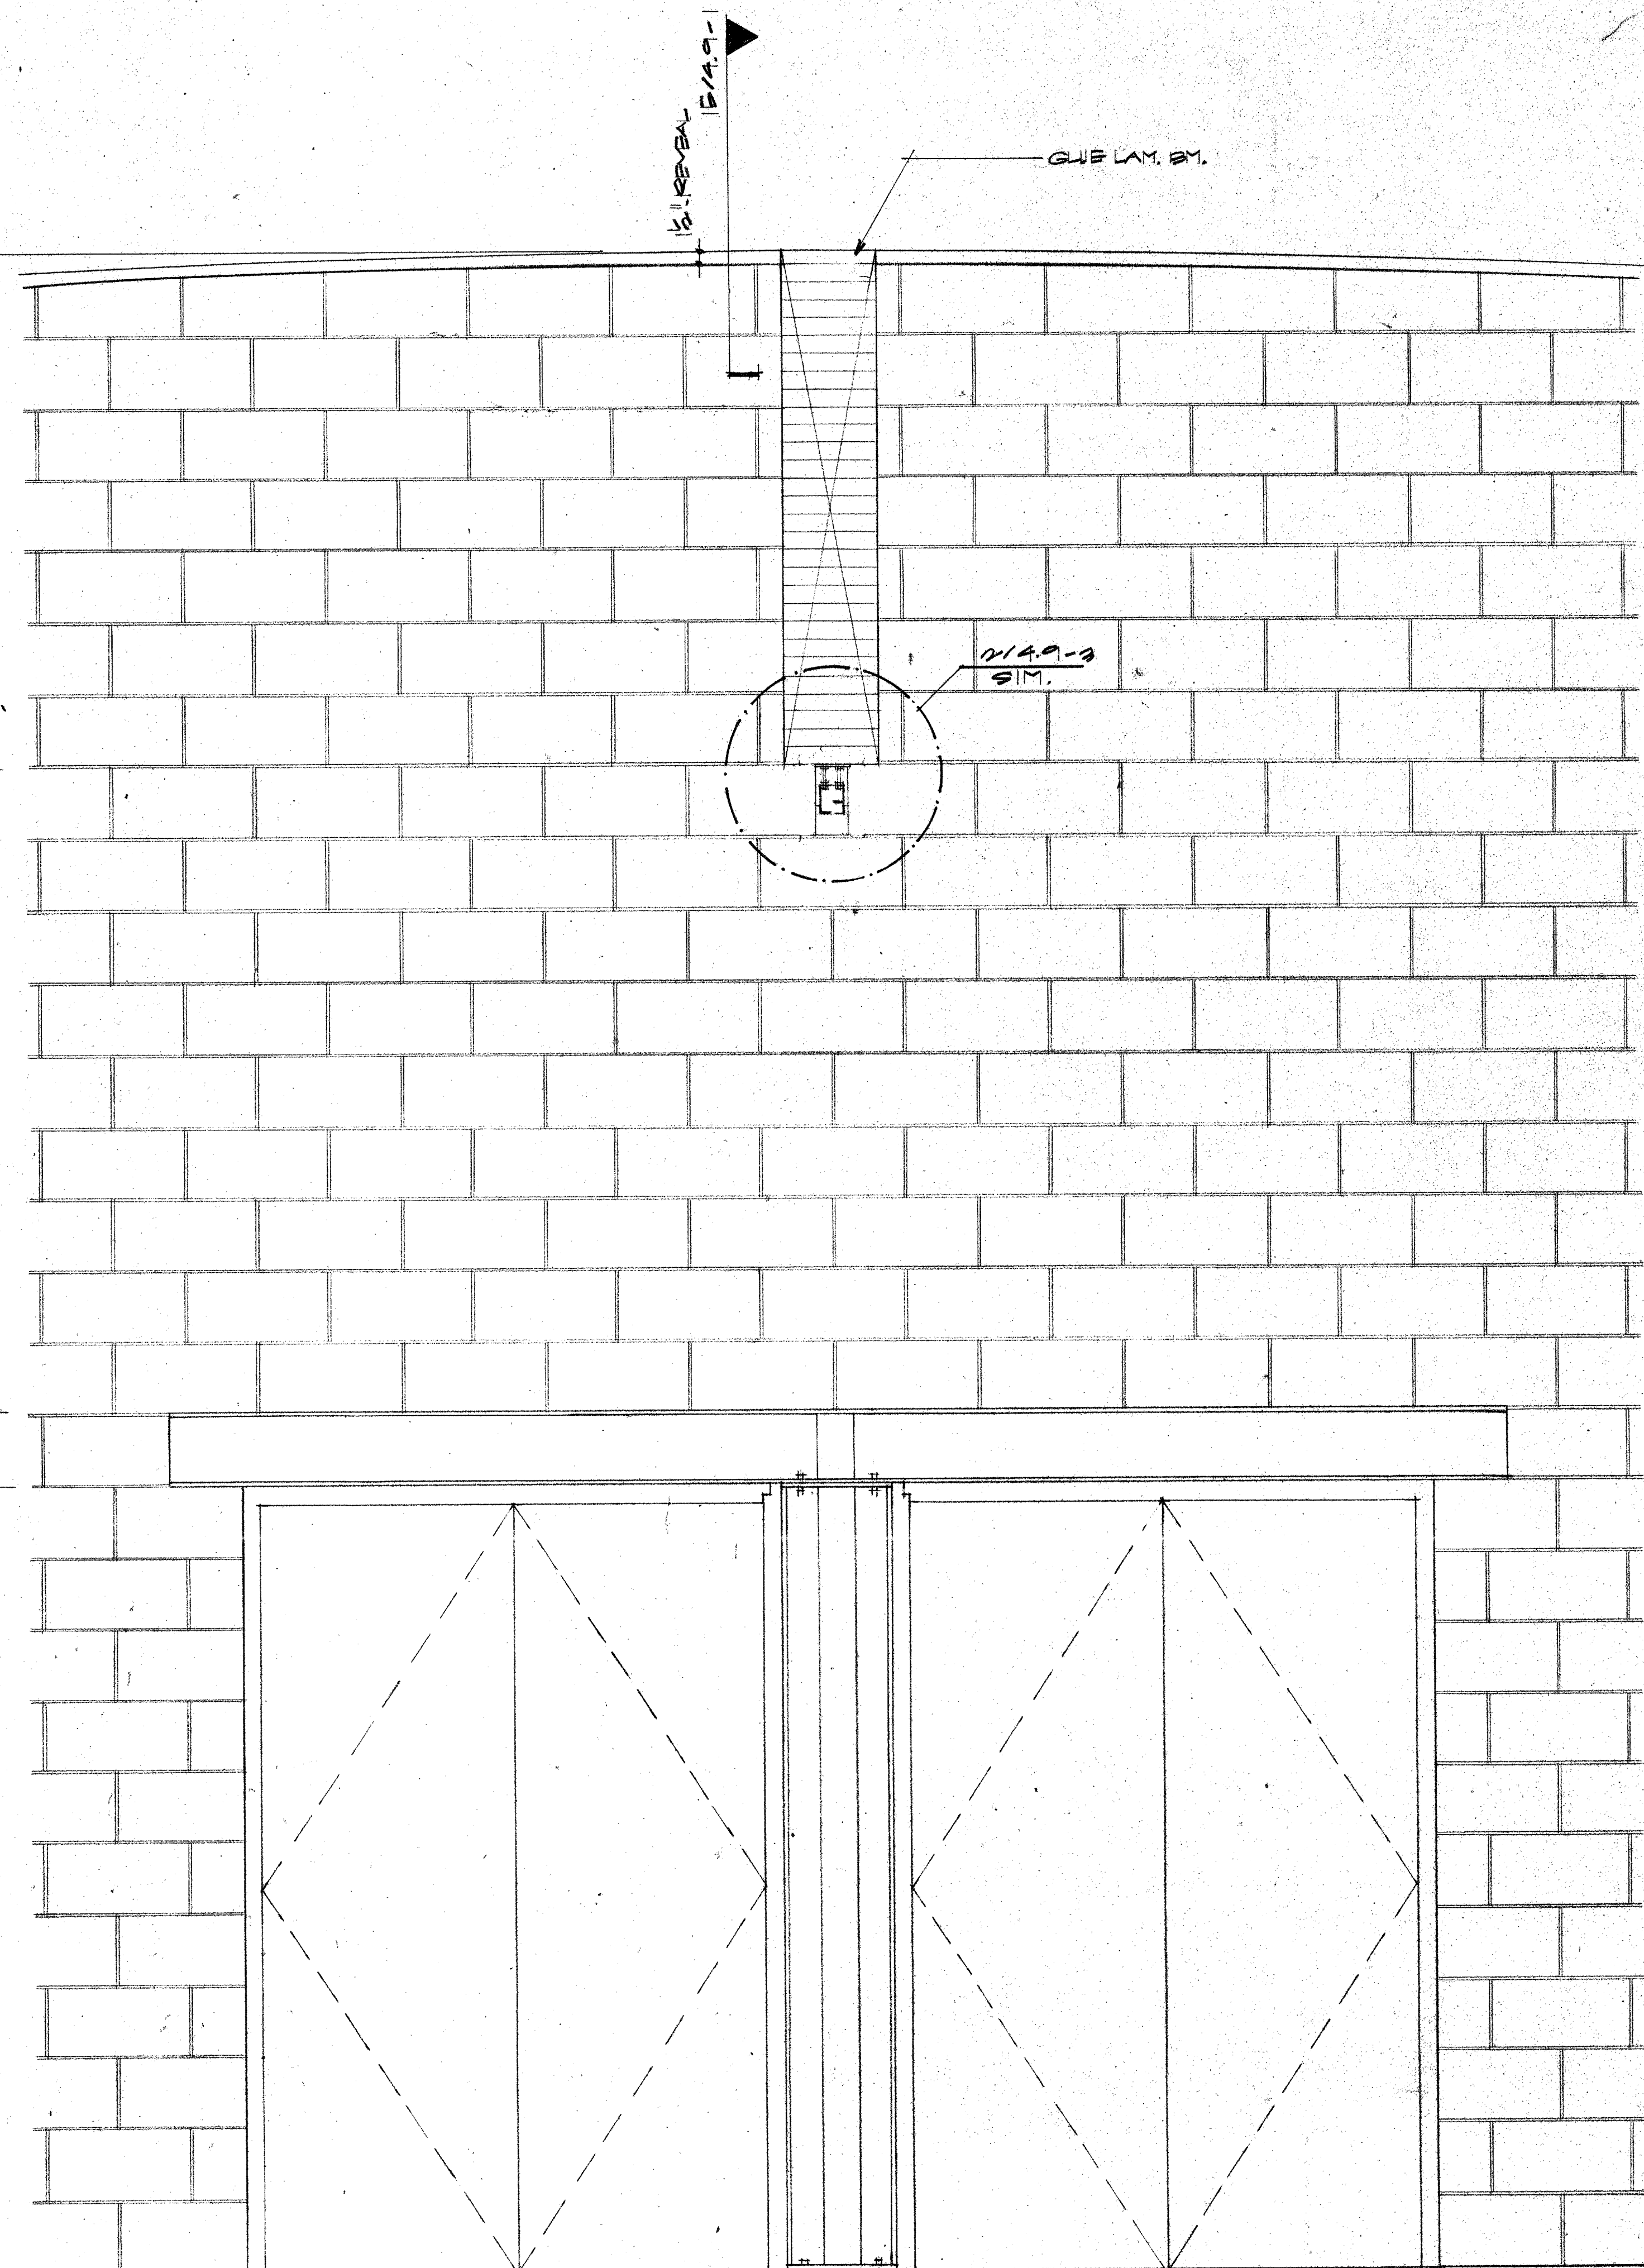

1 INTERIOR ELEVATION DETAIL
1/4" = 1'-0"

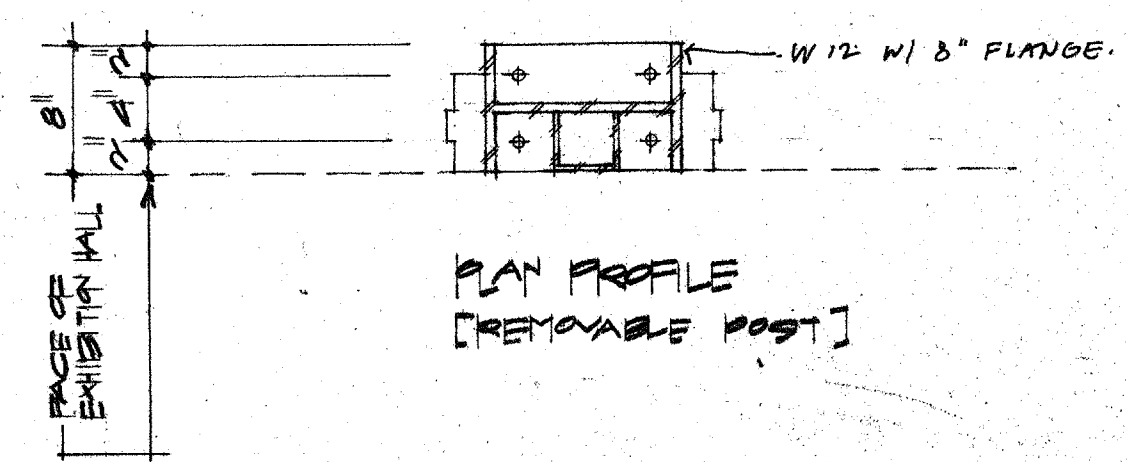

ACC ADDISON ACT

OWNER	LANDSCAPE	STRUCTURAL	HISTORIAN	Issue	Category	Subcategory	Sheet
Town of Addison The Kallens Group 337-776-4407		Ellisor Turner 214-387-8383	Alan Mason 214-891-7100	ISSUE FOR BID 8-17-90	4	7	2
ARCHITECT Cunningham Architects 2700 Fairmont Dallas, Texas 75201 214-856-5272	THEATRE CONSULTANT Theatre Projects 202-451-3045	MEP MEP Systems 214-751-4741	LIGHTING Parola Hull Wilson 214-828-6542				
INTERIORS CSSS 713-582-2000		CIVIL Kurtz & Associates 214-690-3322	GRAPHICS Northland Design 214-954-9776				