



2 WALL SECTION
1/2" = 1'-0"

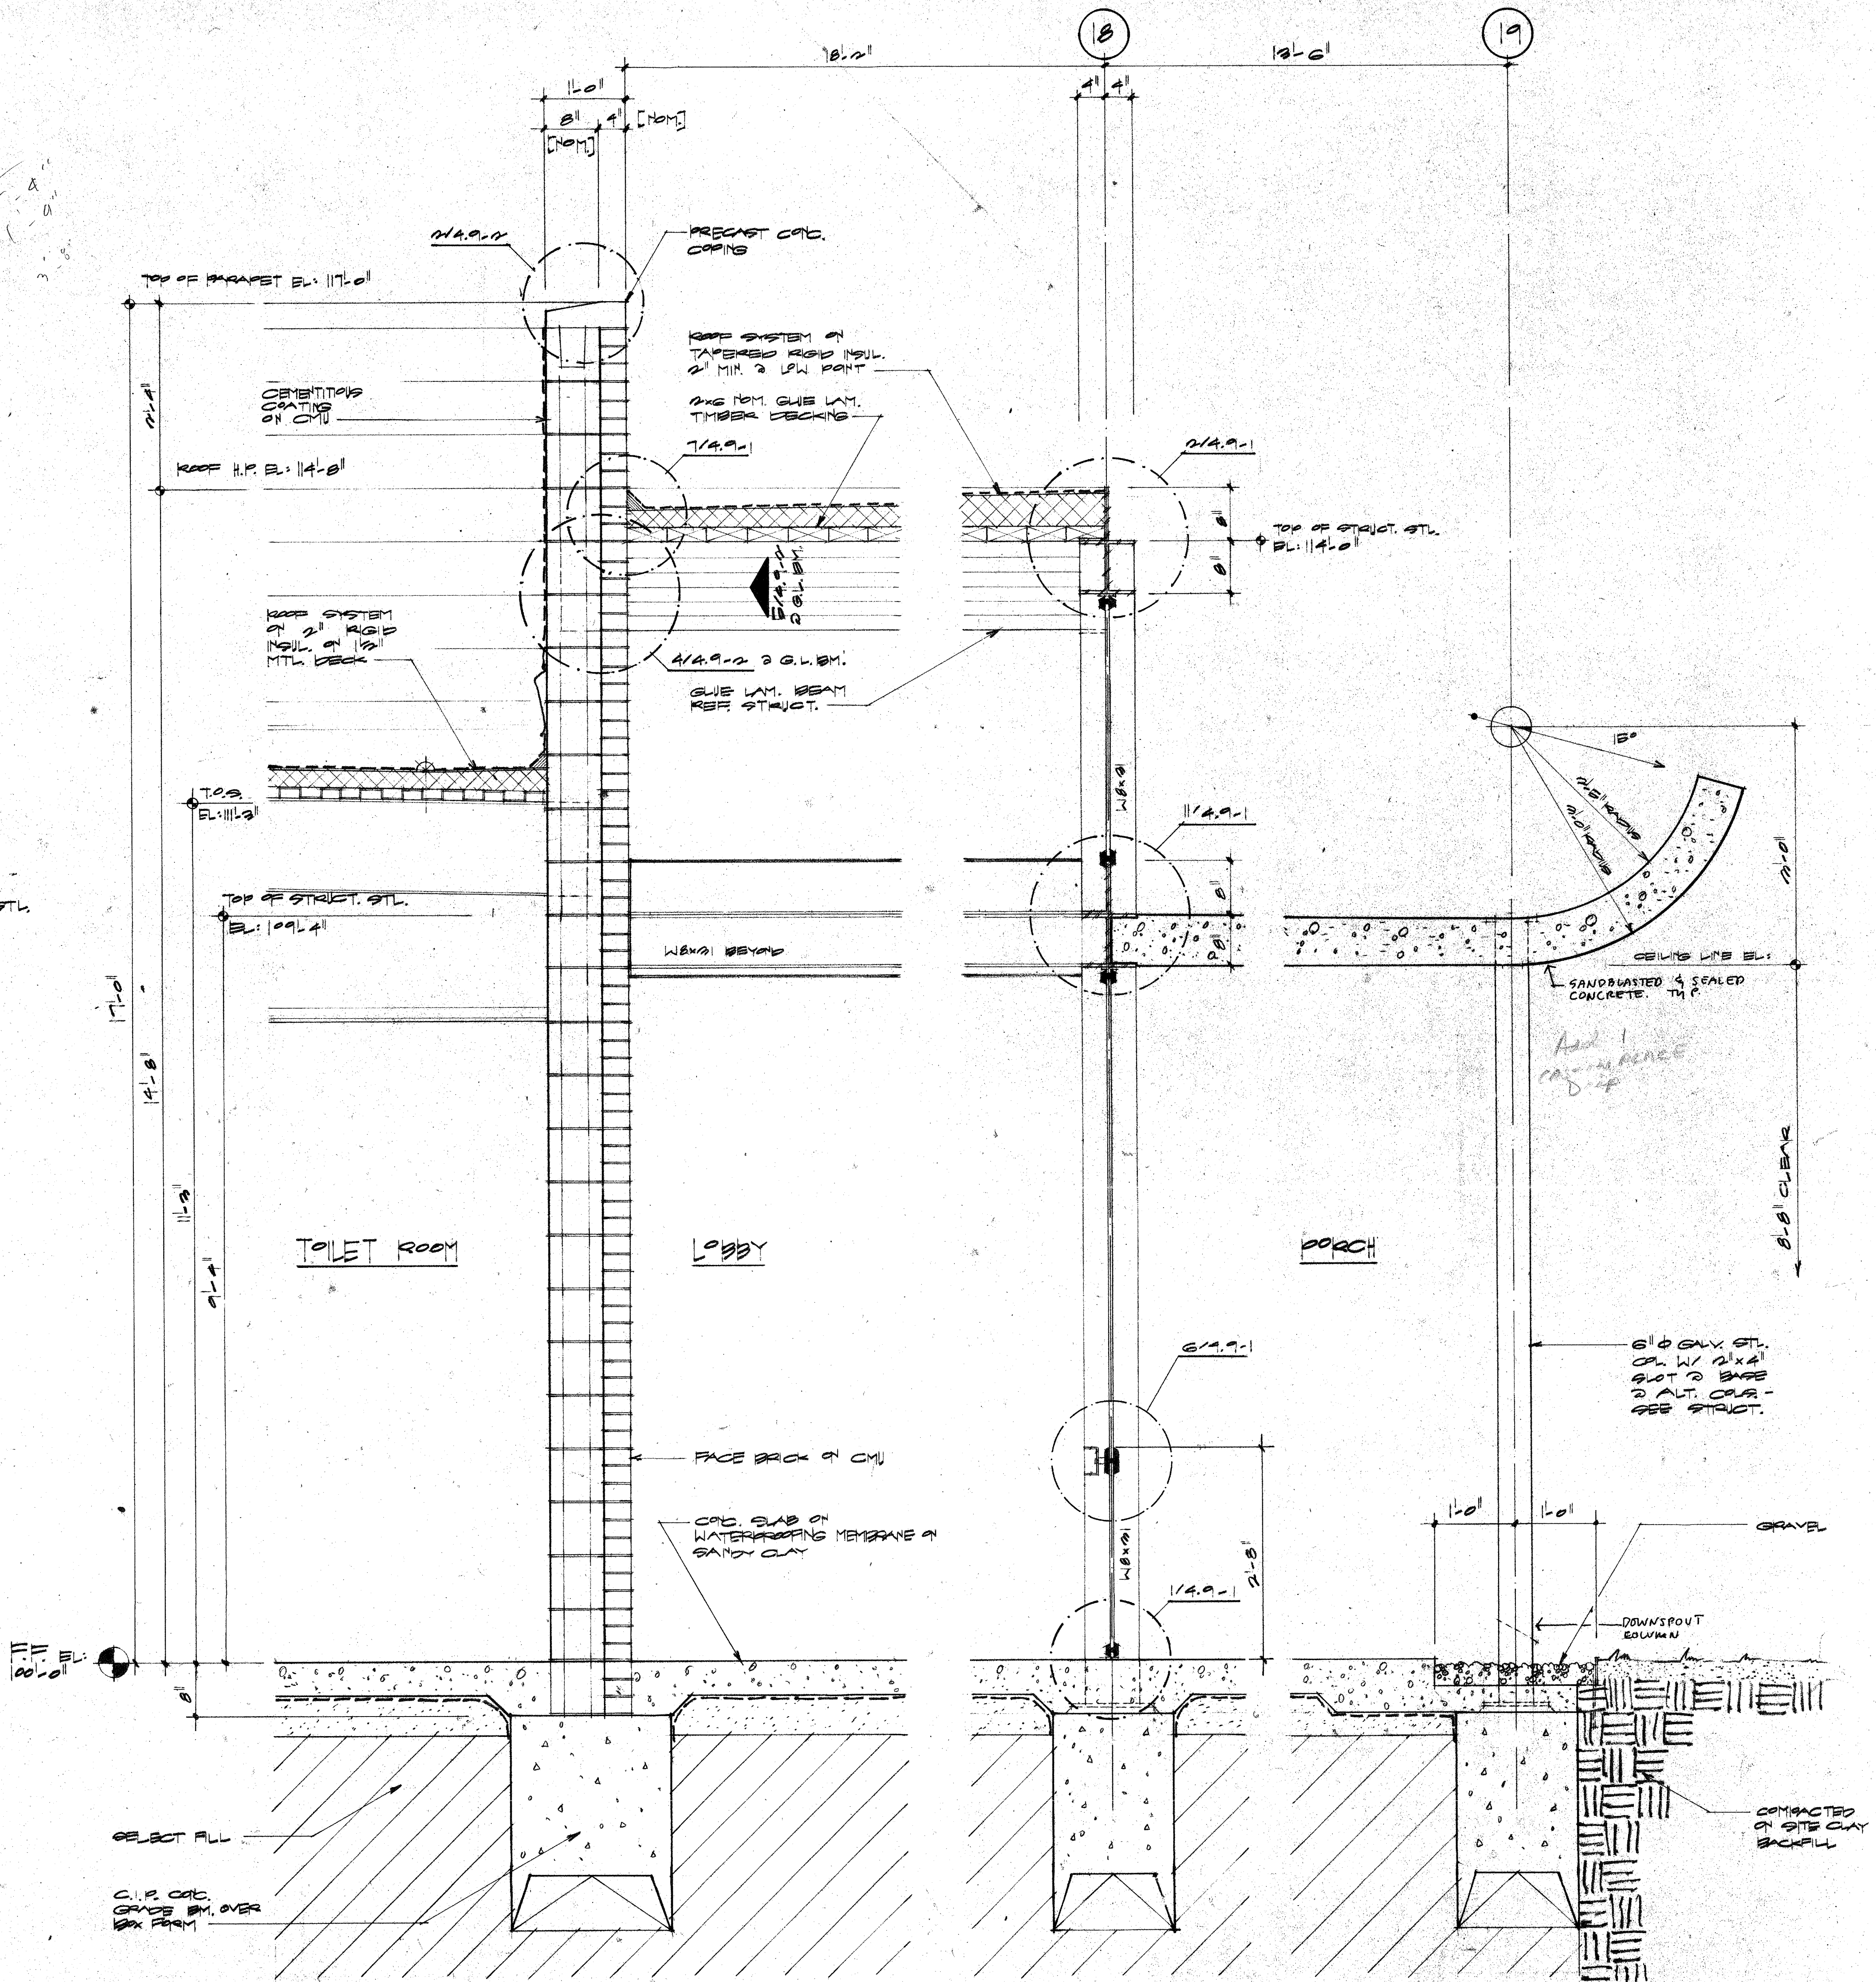

1 WALL SECTION
1/2" = 1'-0"

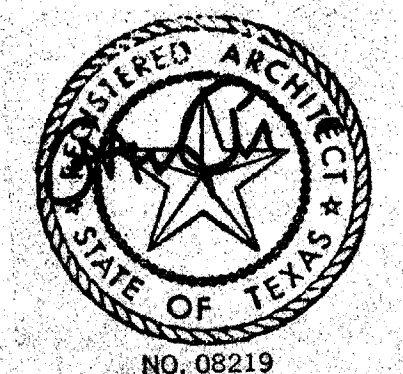

ACC ADDISON ACT

OWNER	LANDSCAPE	STRUCTURAL	HISTORIAN	Issue	Category	Subcategory	Sheet
Town of Addison The Kellams Group 307-776-1417	M.E.P. MEP Systems 214-754-4741	M.E.P. MEP Systems 214-754-4741	Alan Mason 214-891-7182	ISSUE FOR BID 8-17-00	4	8	1
ARCHITECT Cunningham Architects 2700 Fairmont Dallas, Texas 75201 214-855-5272	THEATRE CONSULTANT Theatre Projects 203-431-3949	CIVIL Kurtz & Associates 214-690-3322	LIGHTING Pamela Hull Wilson 214-823-8542				
INTERIORS CRSS 710-552-2000			GRAPHICS Notestad Design 214-984-8978				