



2 WALL SECTION

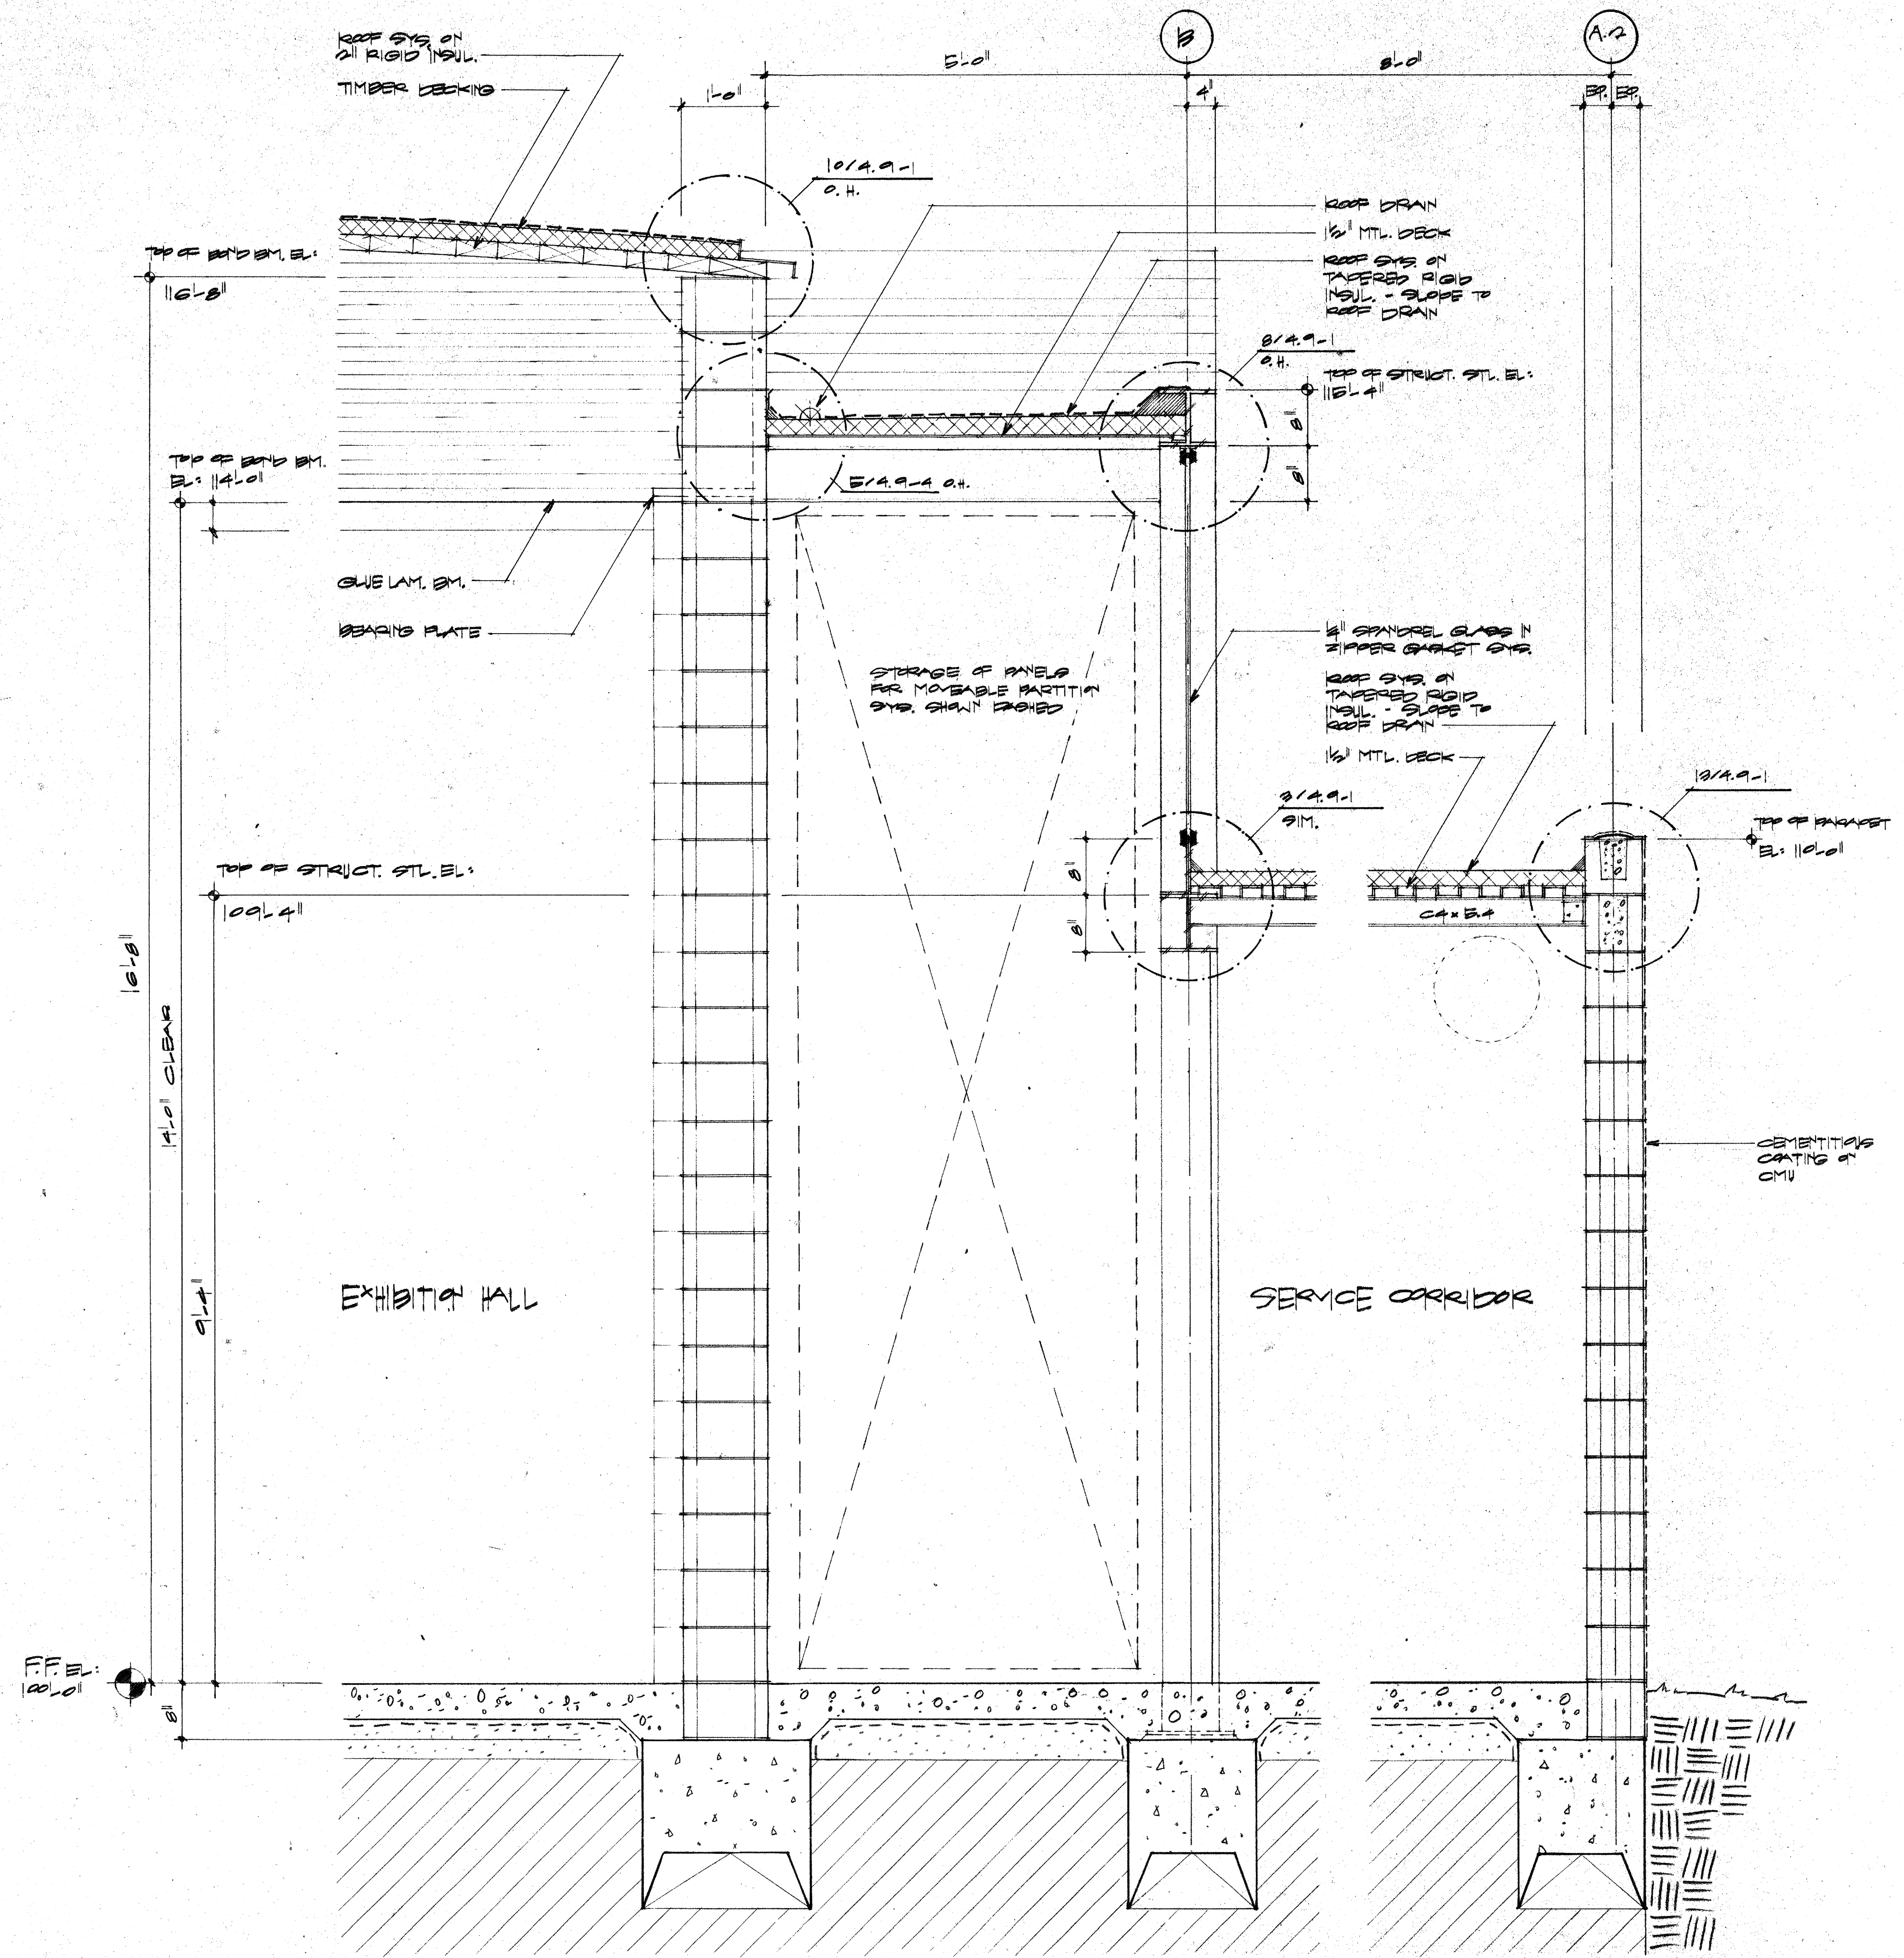

1 WALL SECTION

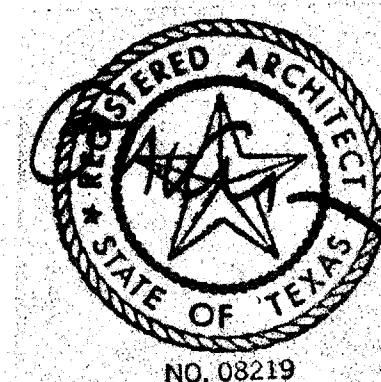

ACC ADDISON ACT

OWNER	LANDSCAPE	STRUCTURAL	HISTORIAN	Issue	Category	Subcategory	Sheet
Town of Addison The Kollins Group 370-776-4177	Elisor Turner 214-881-6383	Elisor Turner 214-881-6383	Alan Mason 214-881-7862	Issue FOR BID 9-17-90	4	8	3
Cunningham Architects 2700 Fairmount Dallas, Texas 75201 214-855-5272	THEATRE CONSULTANT Theatre Projects 202-431-3949	M.E.P. MEP Systems 214-754-4741	LIGHTING Pamela Hall Wilson 214-823-6642				
	INTERIORS CRSS 715-552-2000	CIVIL Kurtz & Associates 214-688-3322	GRAPHICS Nottingham Design 214-954-1978				