


SECTION 2
1/2" = 1'-0"



SECTION 1
1/2" = 1'-0"

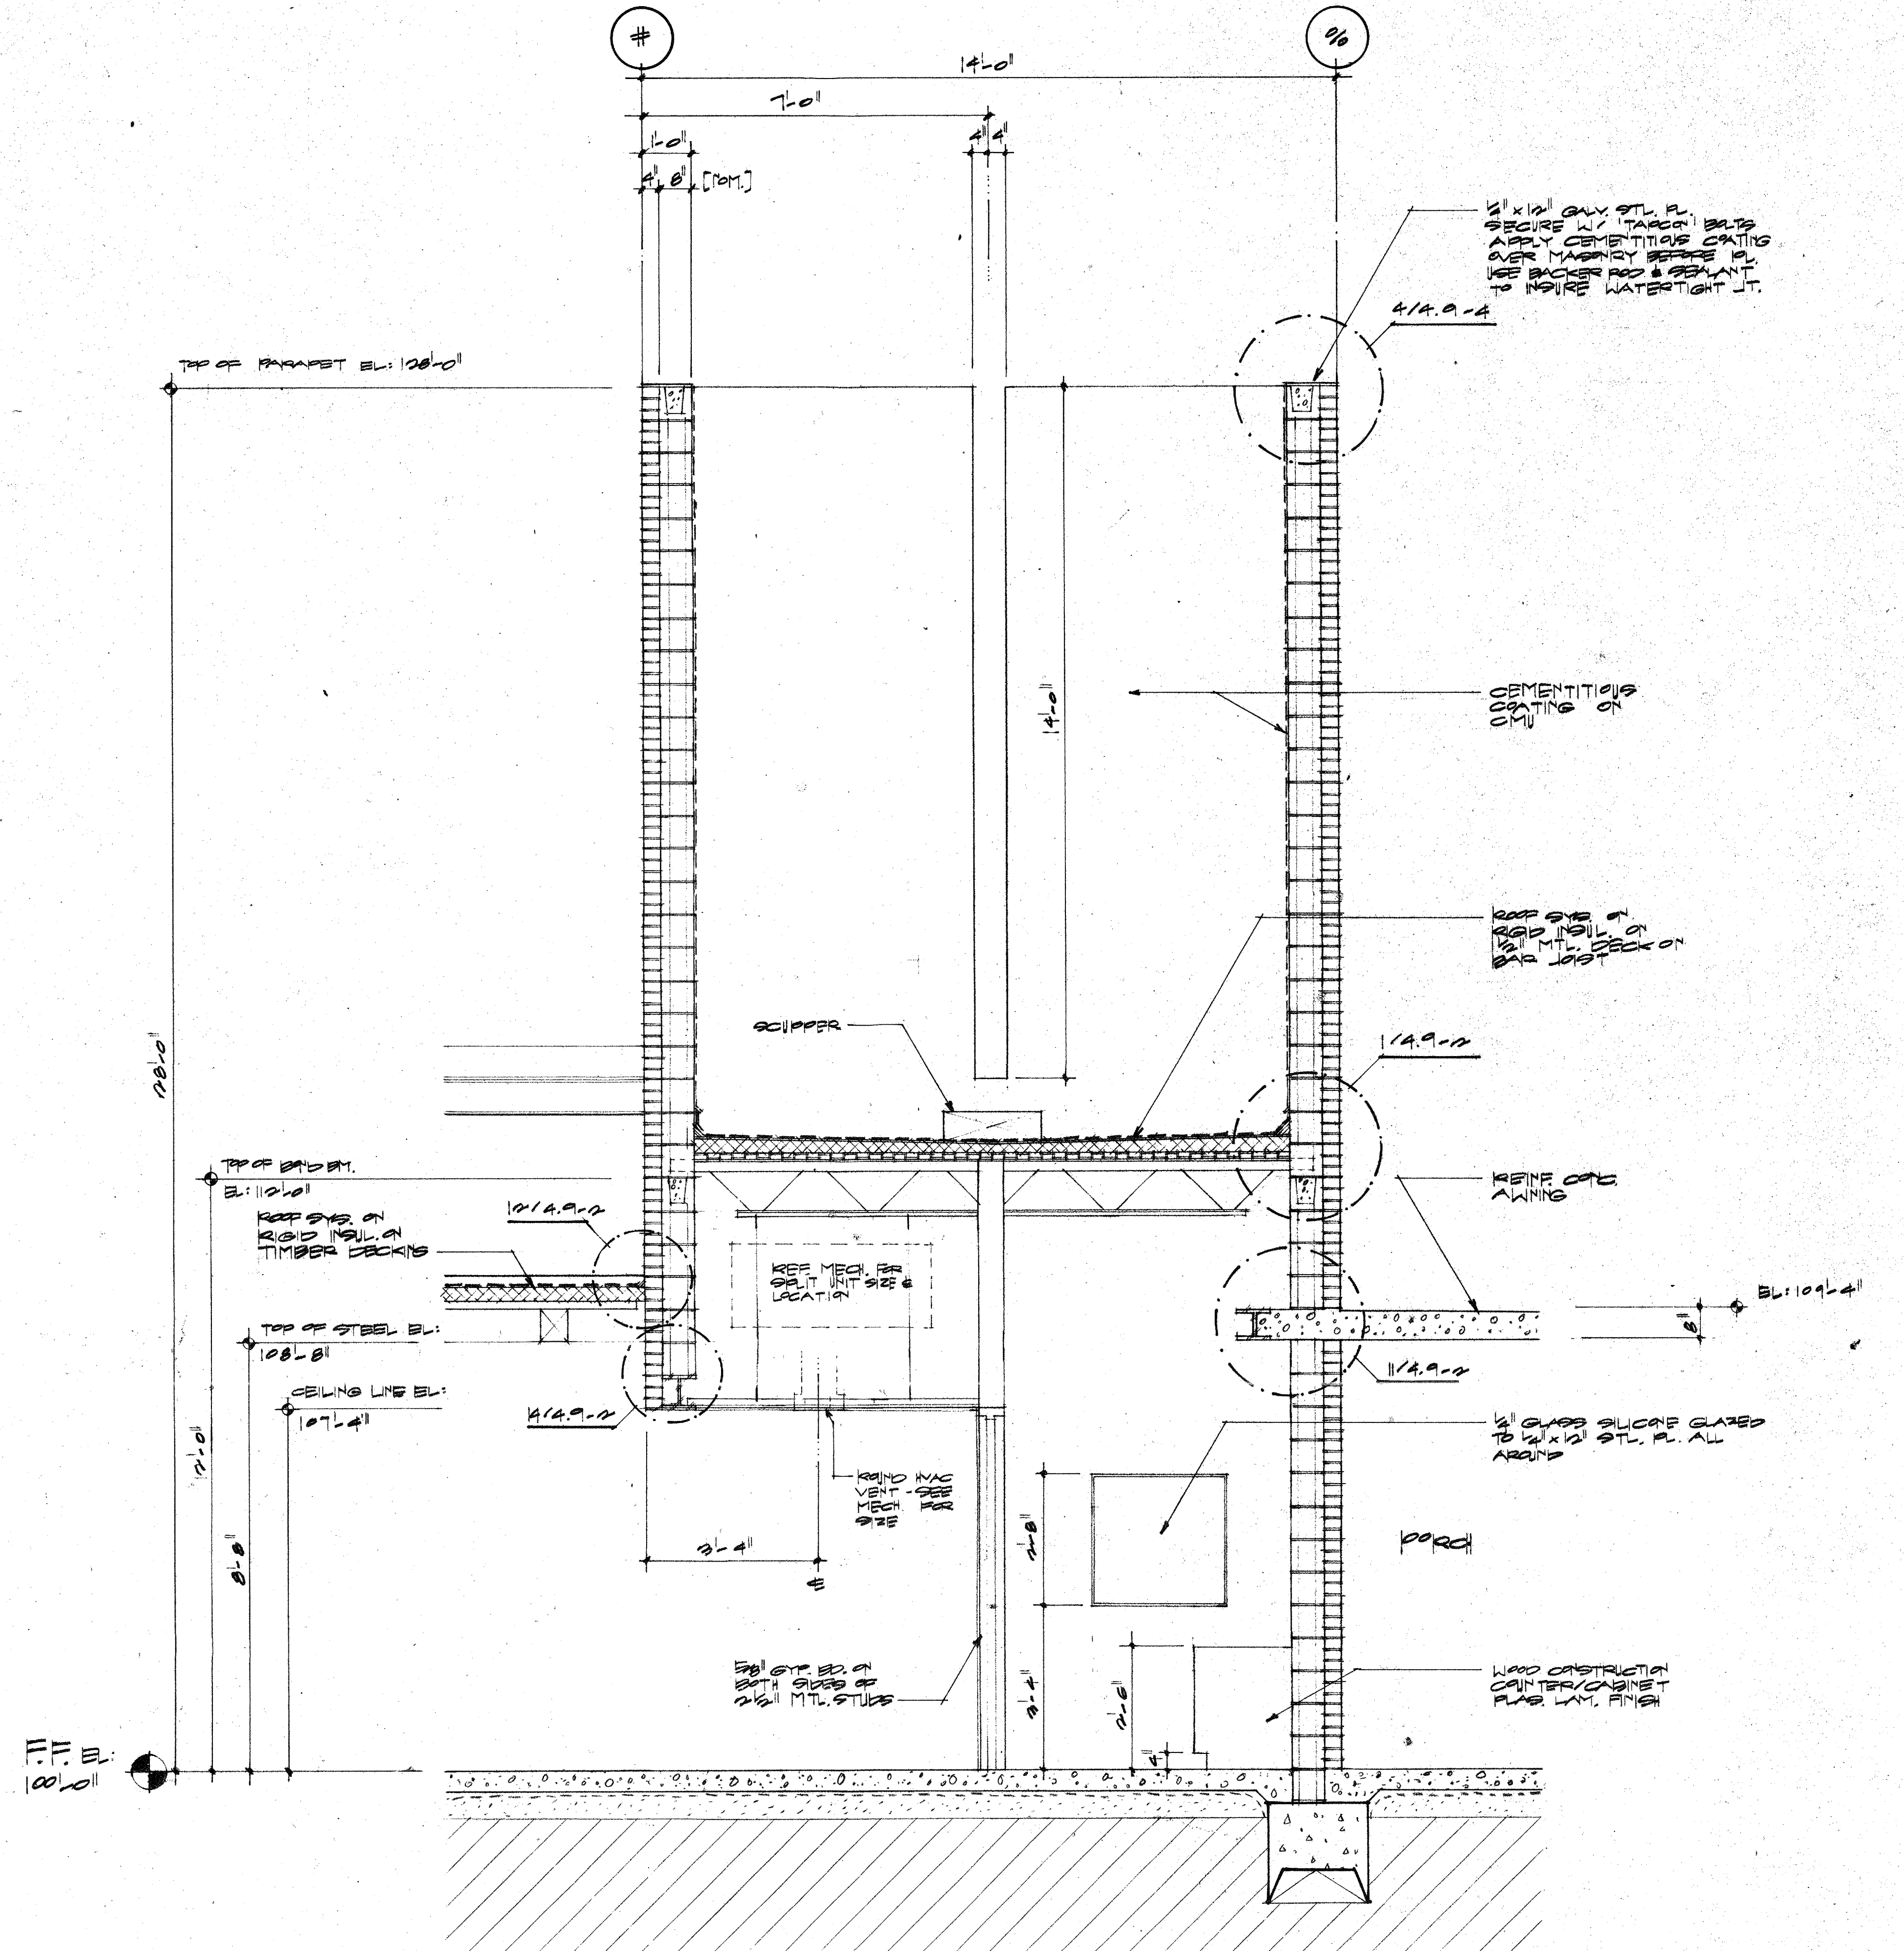

ACC ADDISON ACT

OWNER	LANDSCAPE	STRUCTURAL	HISTORIAN	Issue	Category	Subcategory	Sheet
Town of Addison The Kellams Group 317-776-4417		Ellisor Turner 214-367-8393	Alan Mason 214-691-7822	ISSUE FOR BID 8-17-90	4	8	4
ARCHITECT Cunningham Architects 2700 Fairmount Dallas, Texas 75201 214-855-5272	THEATRE CONSULTANT Theatre Projects 203-431-3949	M.E.P. MEP Systems 214-754-4741	LIGHTING Pamela Hill Wilson 214-823-8542				
	INTERIORS CRSS 713-552-2000	CIVIL Kurtz & Associates 214-690-3322	GRAPHICS Nottersted Design 214-954-1876				