



3 DETAIL
1" = 1'-0"

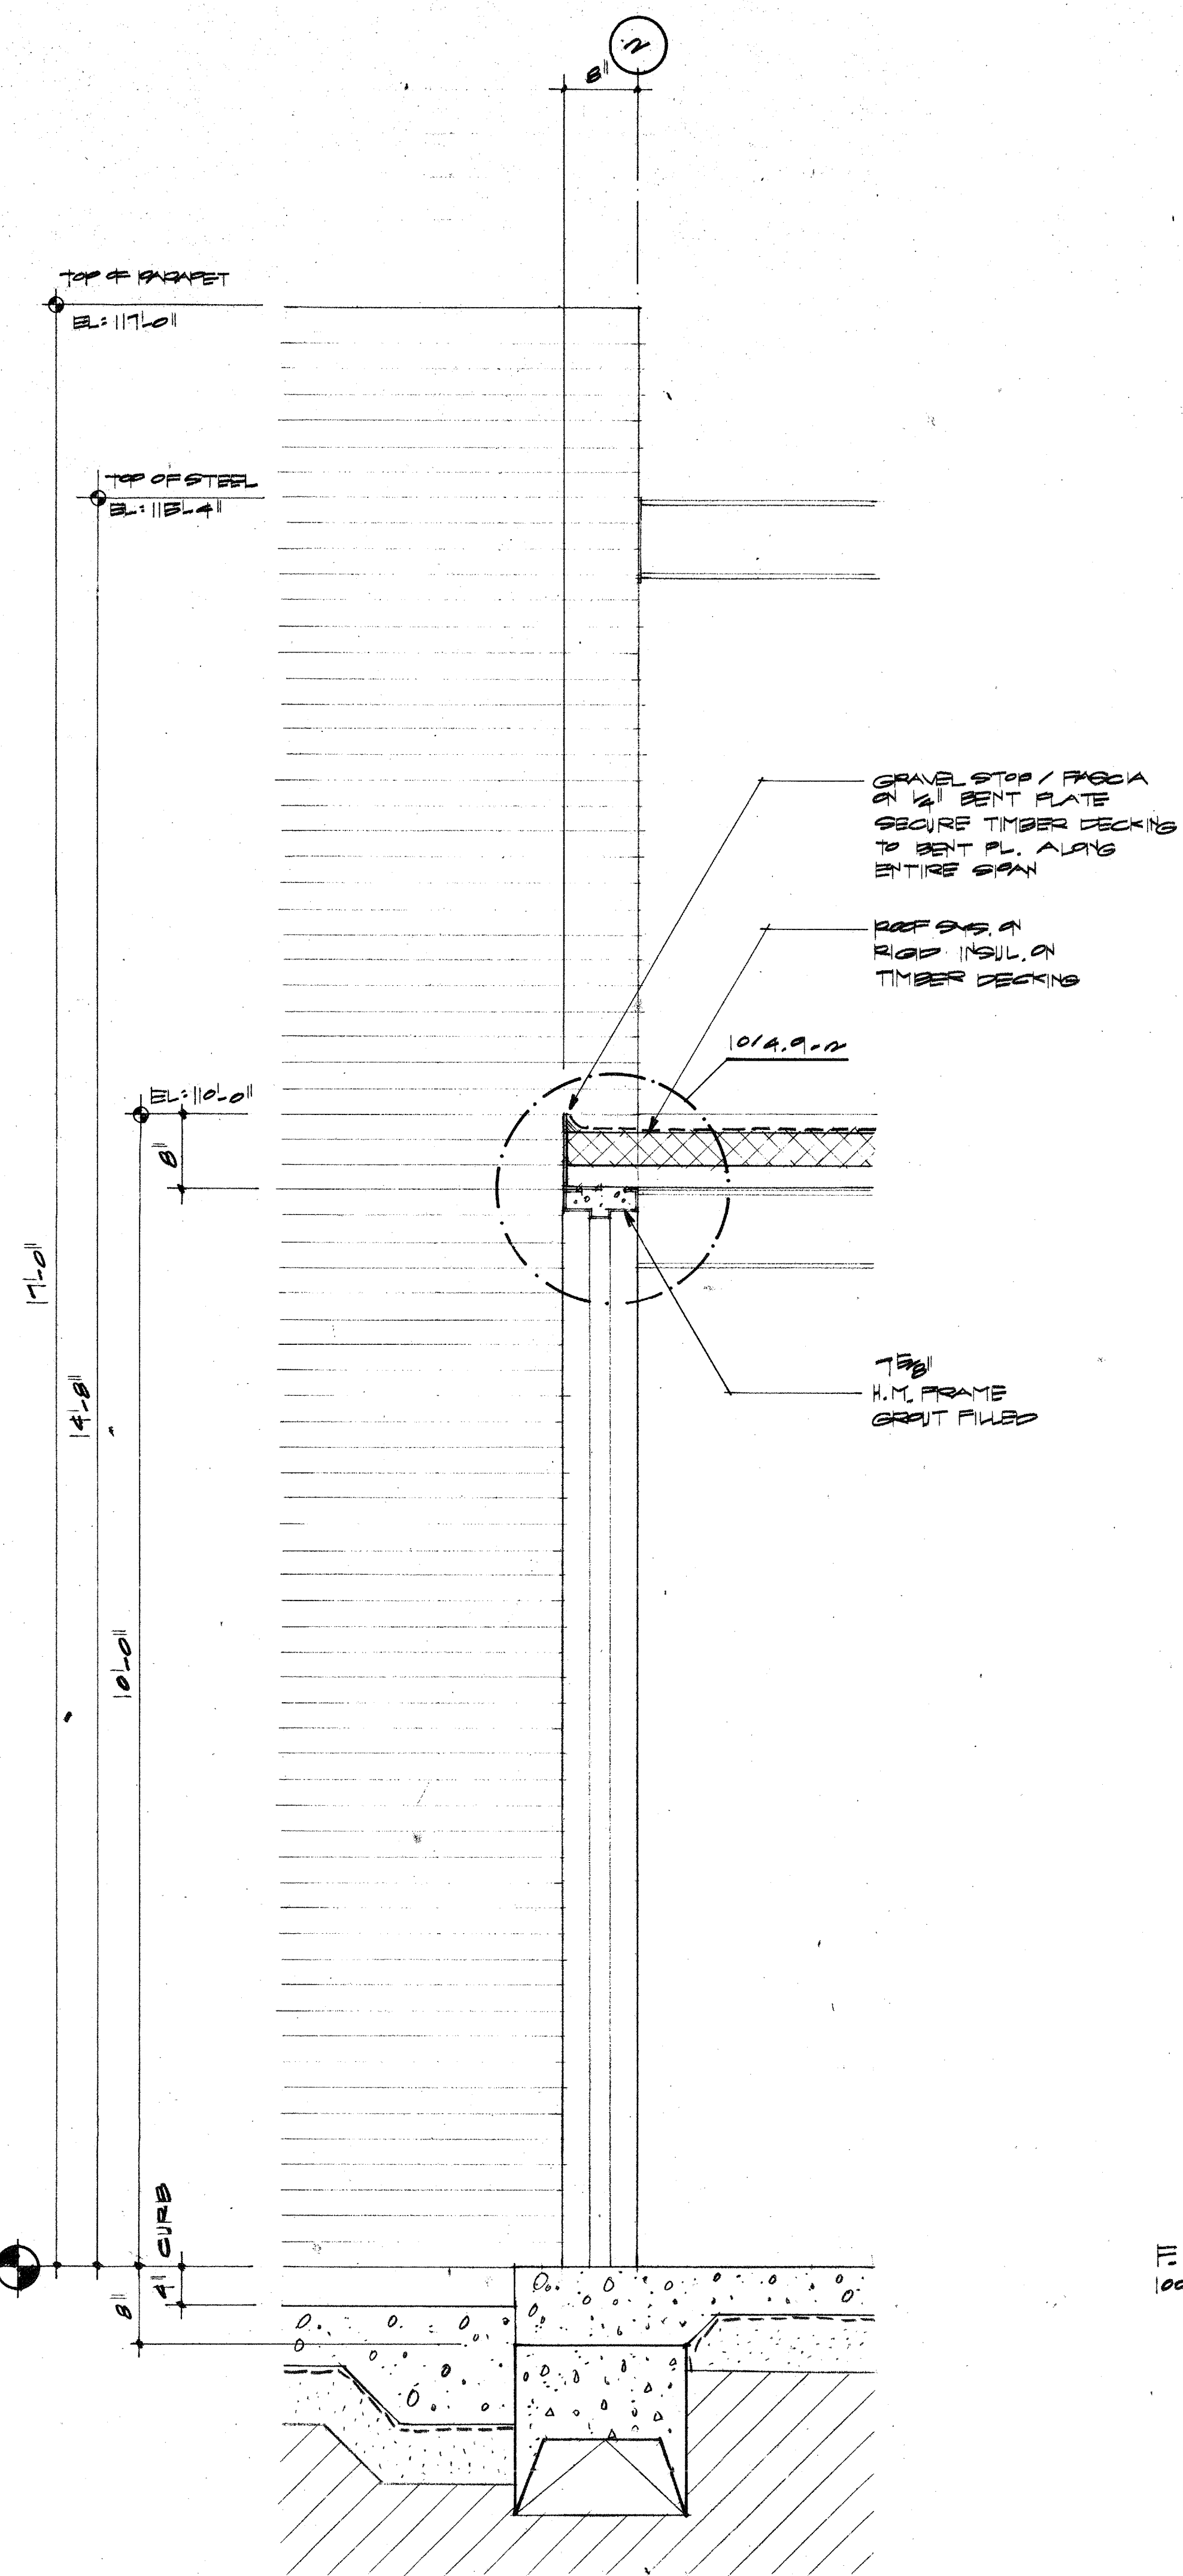

2 DETAIL
1" = 1'-0"

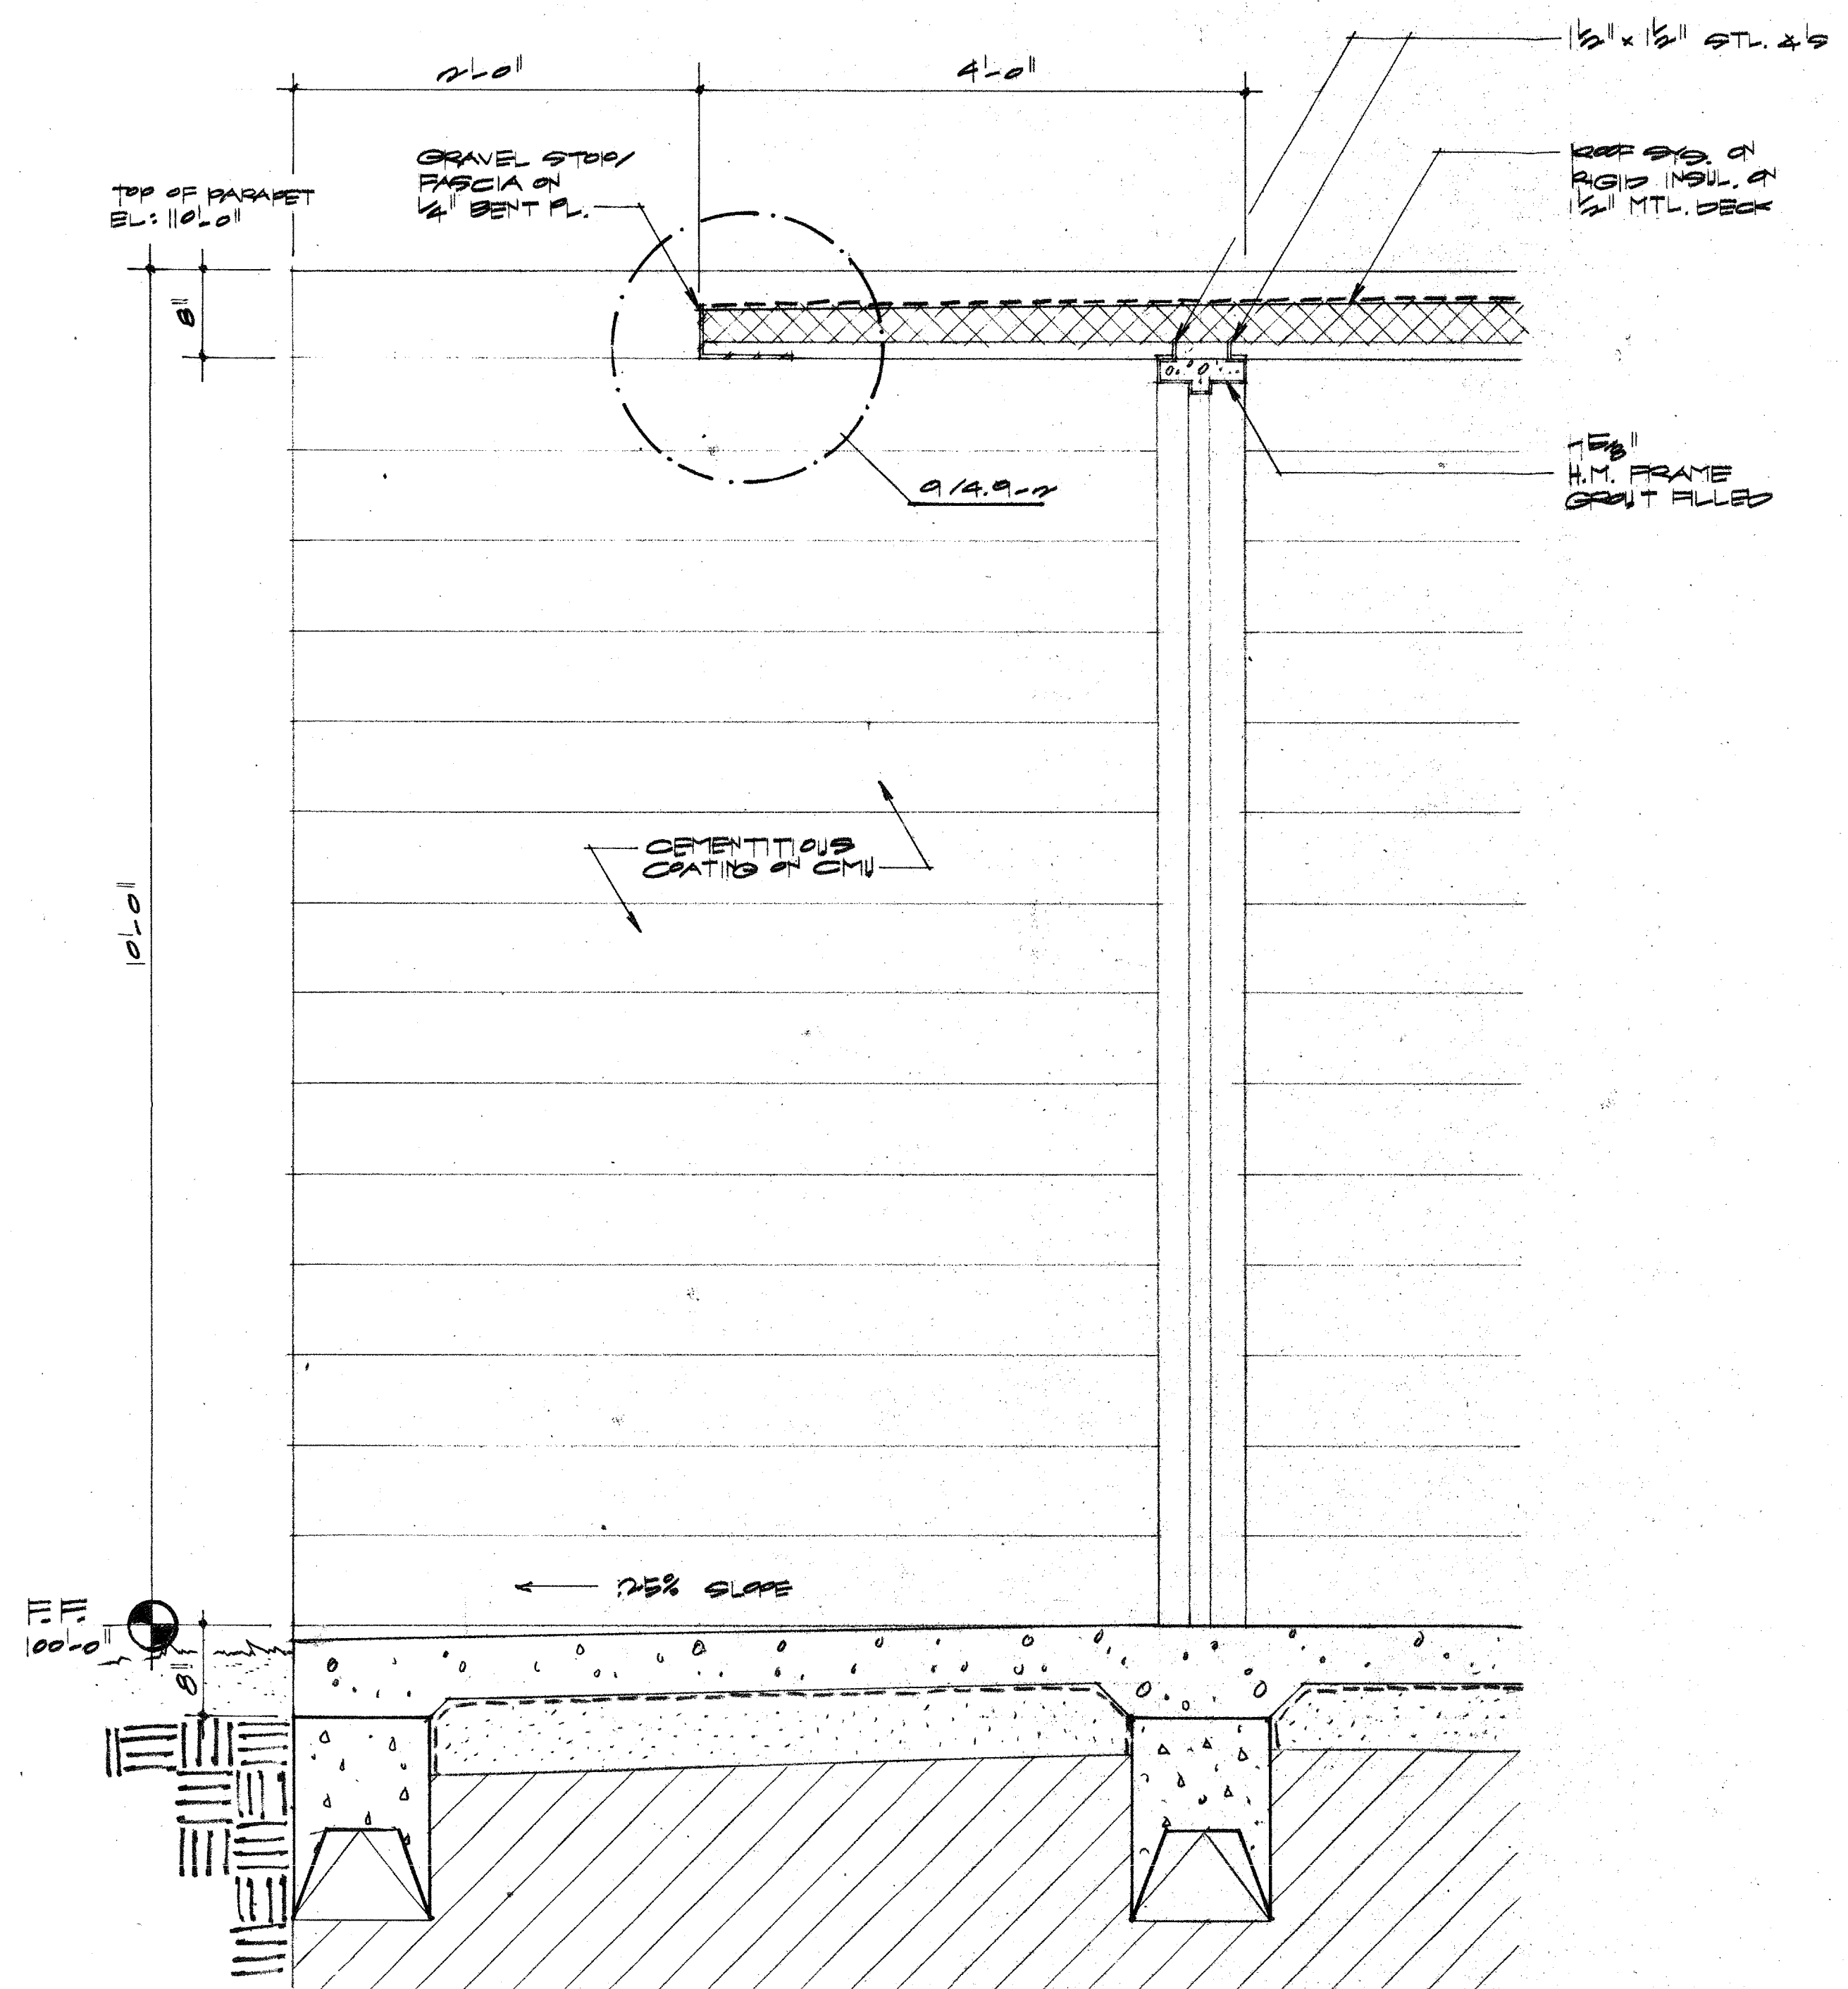

1 DETAIL
1" = 1'-0"



ACC ADDISON ACT

OWNER	LANDSCAPE	STRUCTURAL	HISTORIAN	Issue	Category	Subcategory	Sheet
Town of Addison The Kellars Group 317-76-1417	214-387-8393	Elisor Tanner 214-387-8393	Alan Mason 214-881-7822	ISSUE FOR BID 8-17-90	4	8	5
ARCHITECT Cunningham Architects 2700 Fairmount Dallas, Texas 75201 214-855-5272	THEATRE CONSULTANT Theatre Projects 203-431-3949	M.E.P. MEP Systems 214-754-4741	LIGHTING Parola Hull Wilson 214-823-6542				
INTERIORS CRSS 713-552-2000		CIVIL Kurtz & Associates 214-850-3322	GRAPHICS Notstedt Design 214-854-1978				