




6 STAIR ELEVATION
1/2" = 1'-0"

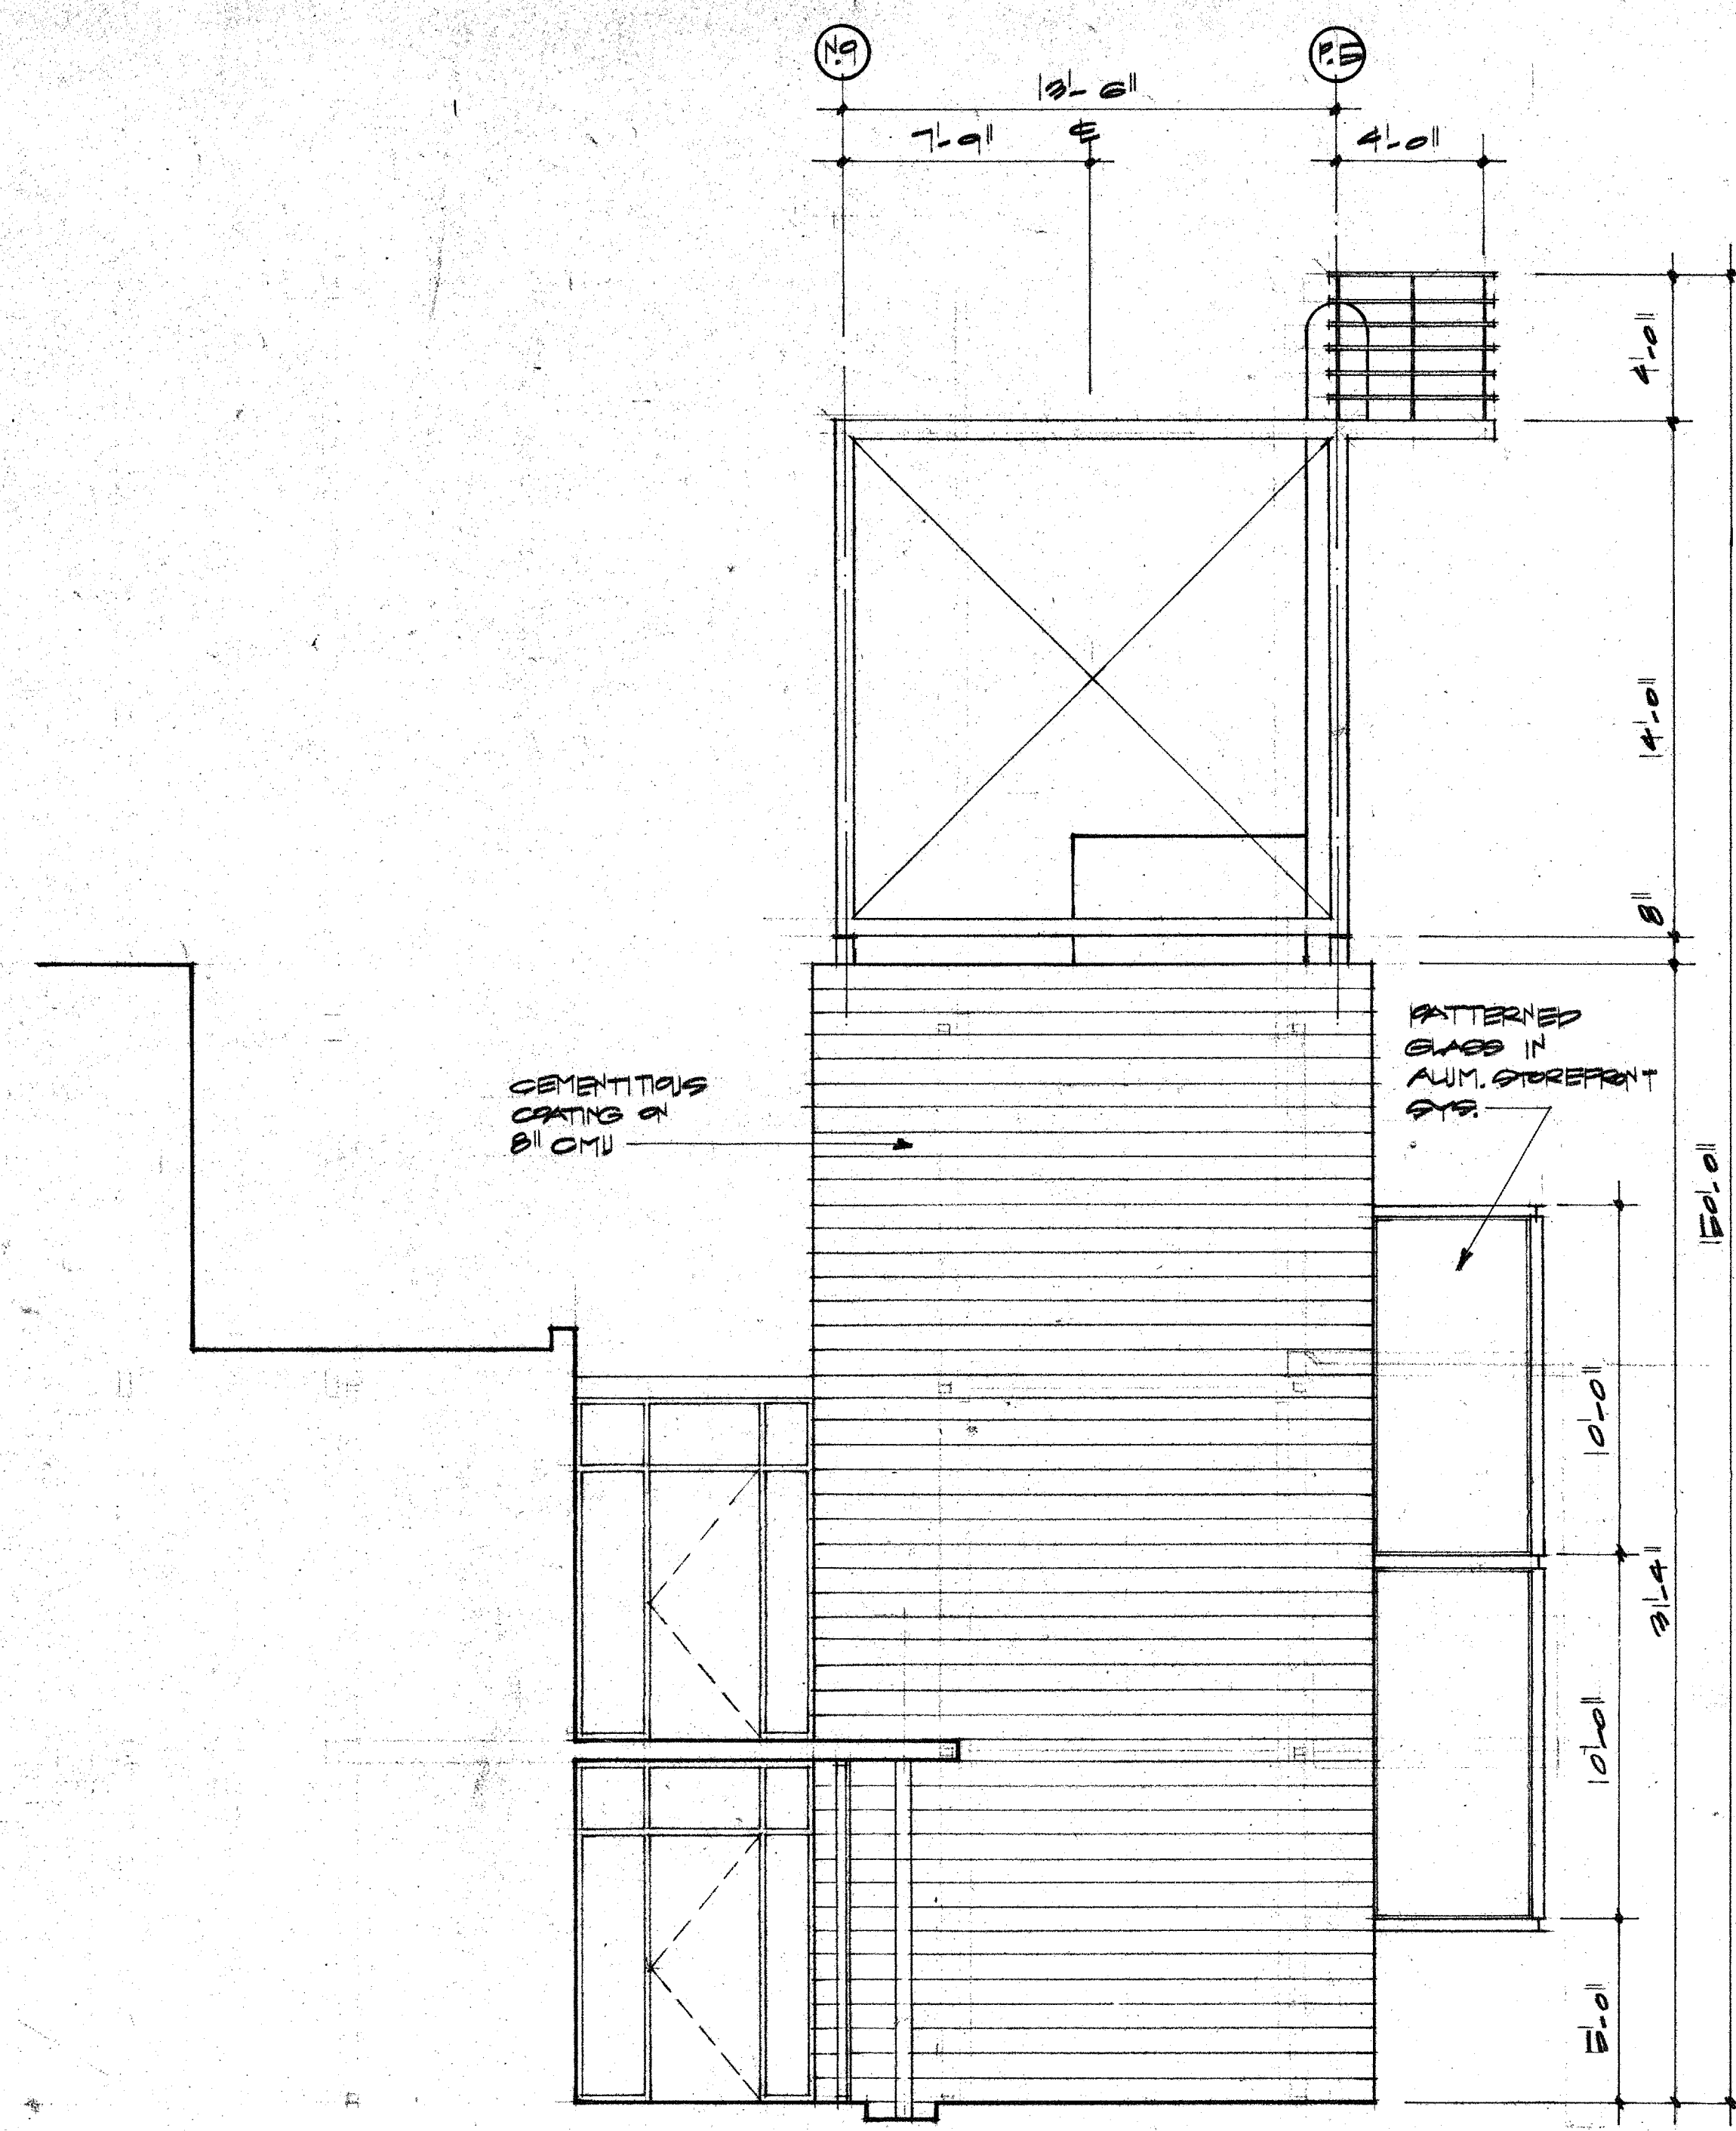


7 STAIR ELEVATION
1/2" = 1'-0"

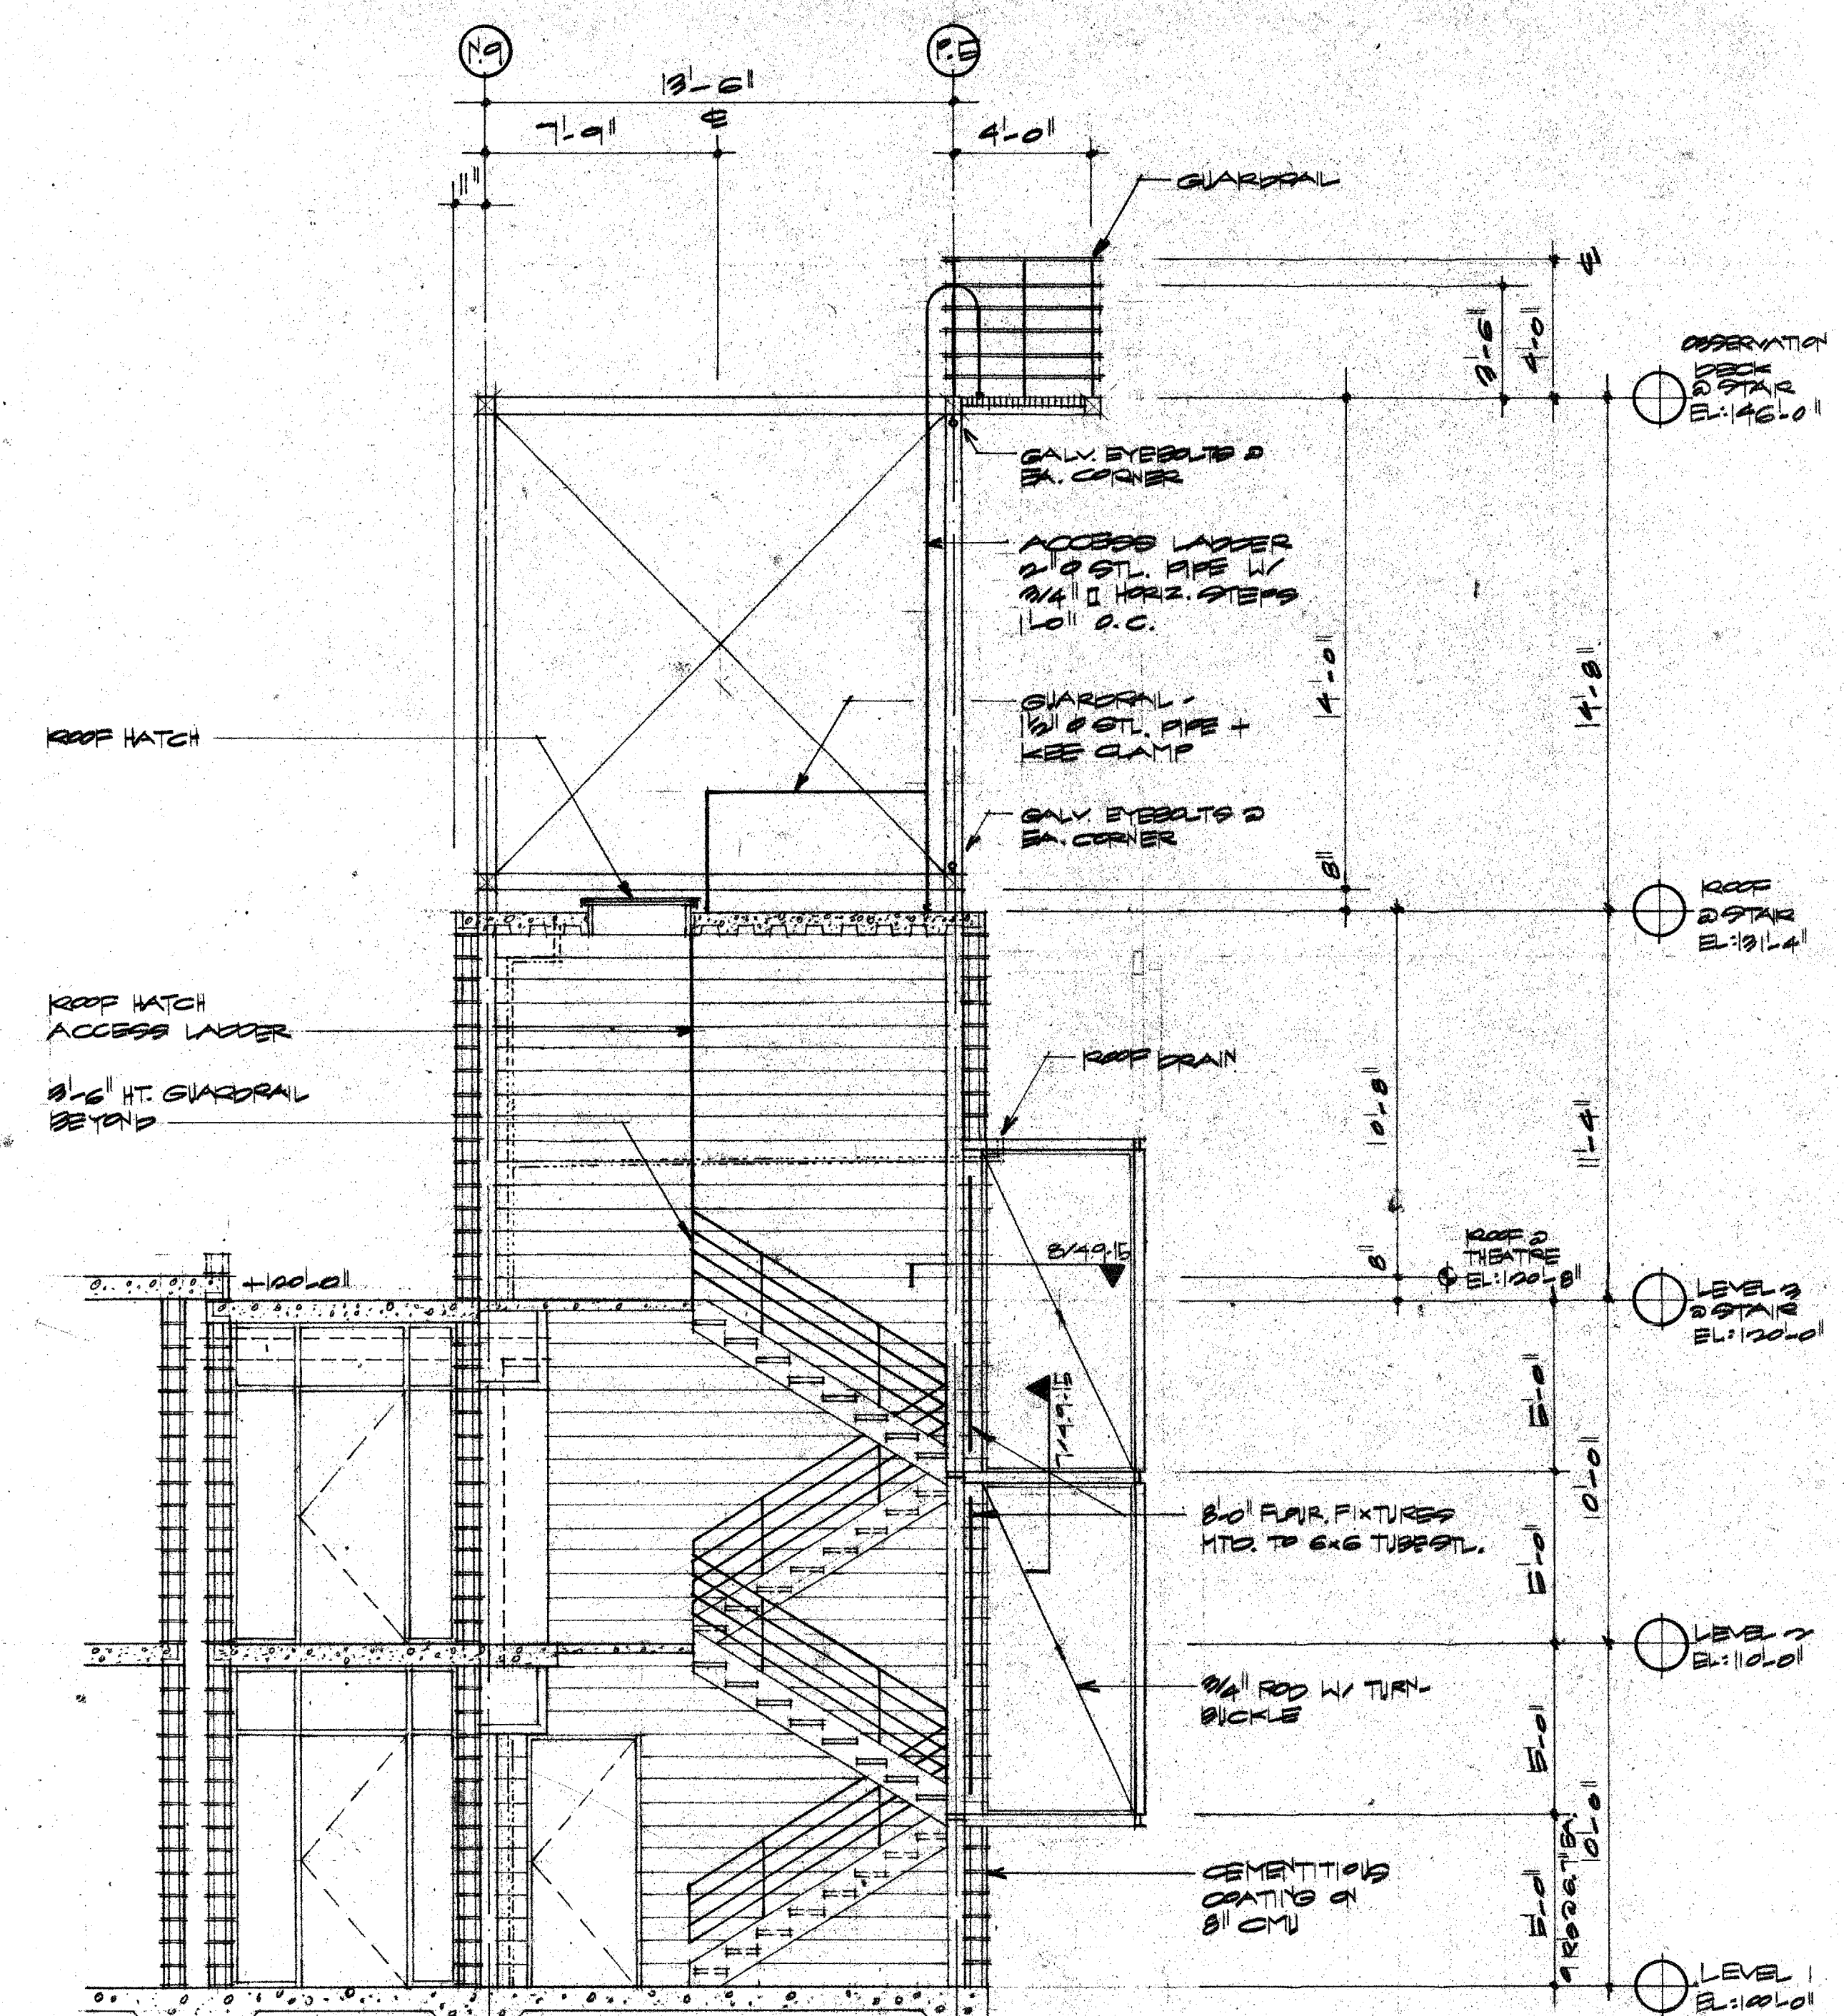


8 STAIR SECTION
1/4" = 1'-0"

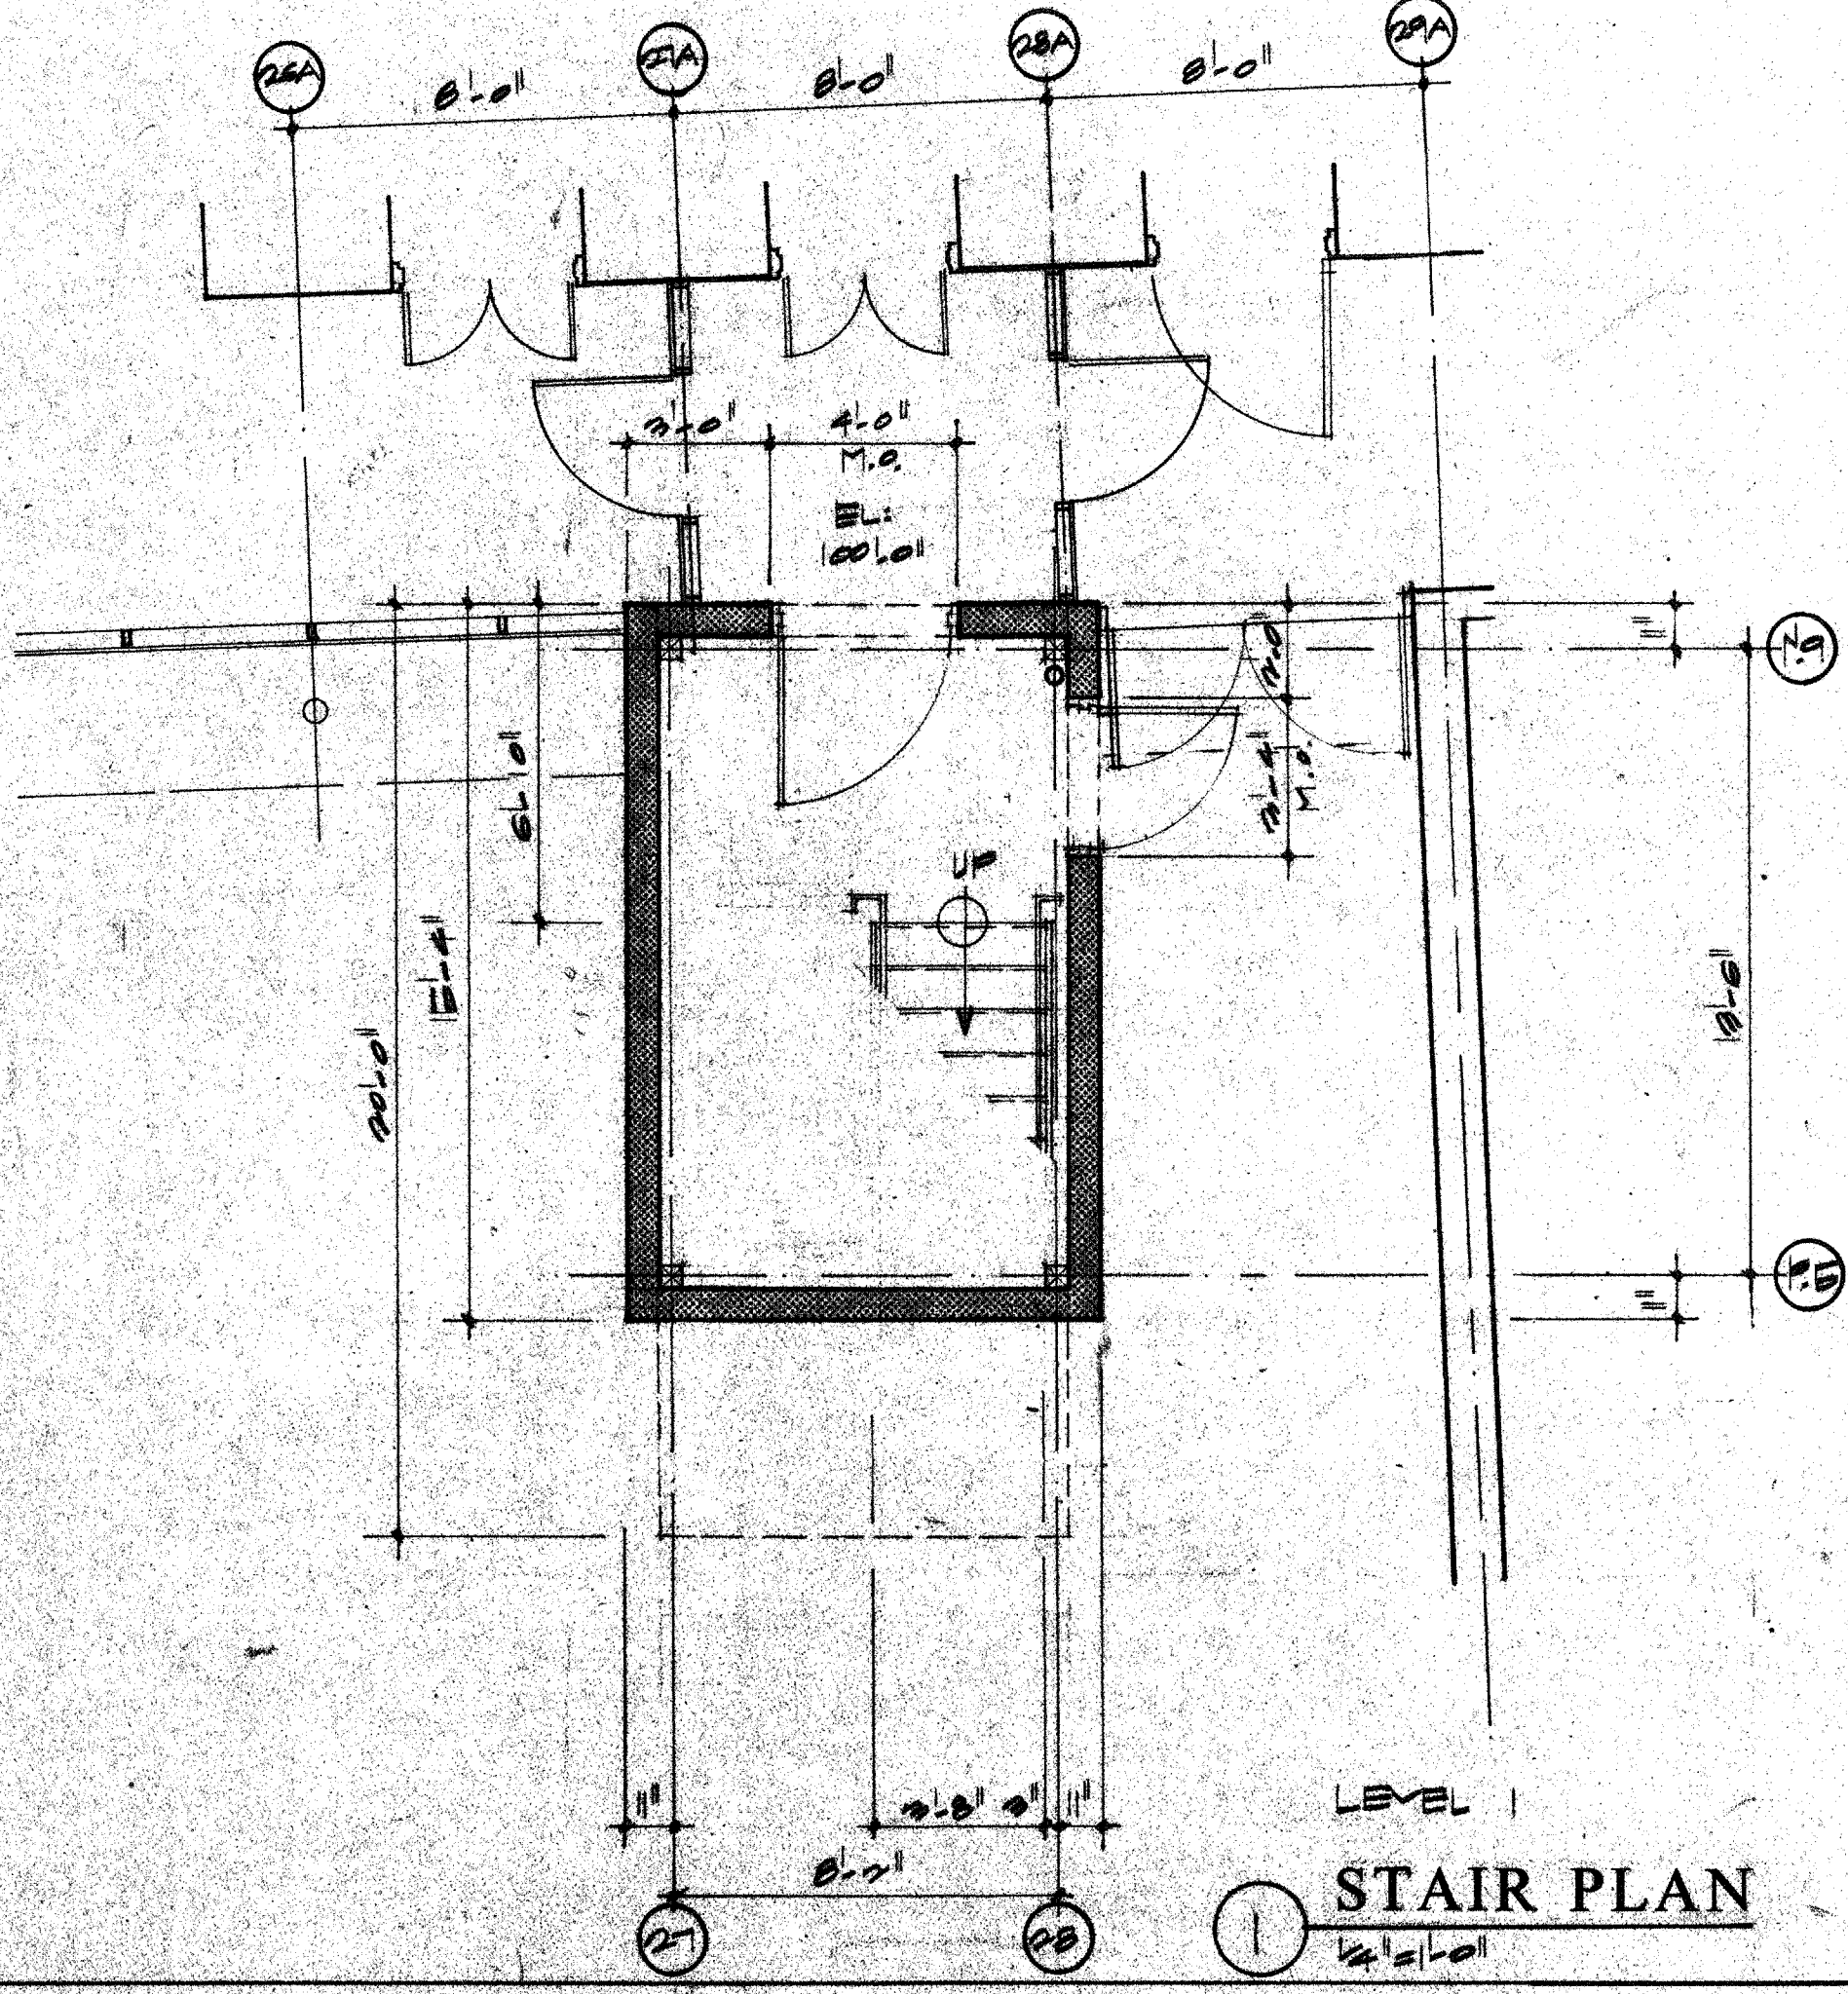


1 LEVEL 1 STAIR PLAN
1/2" = 1'-0"

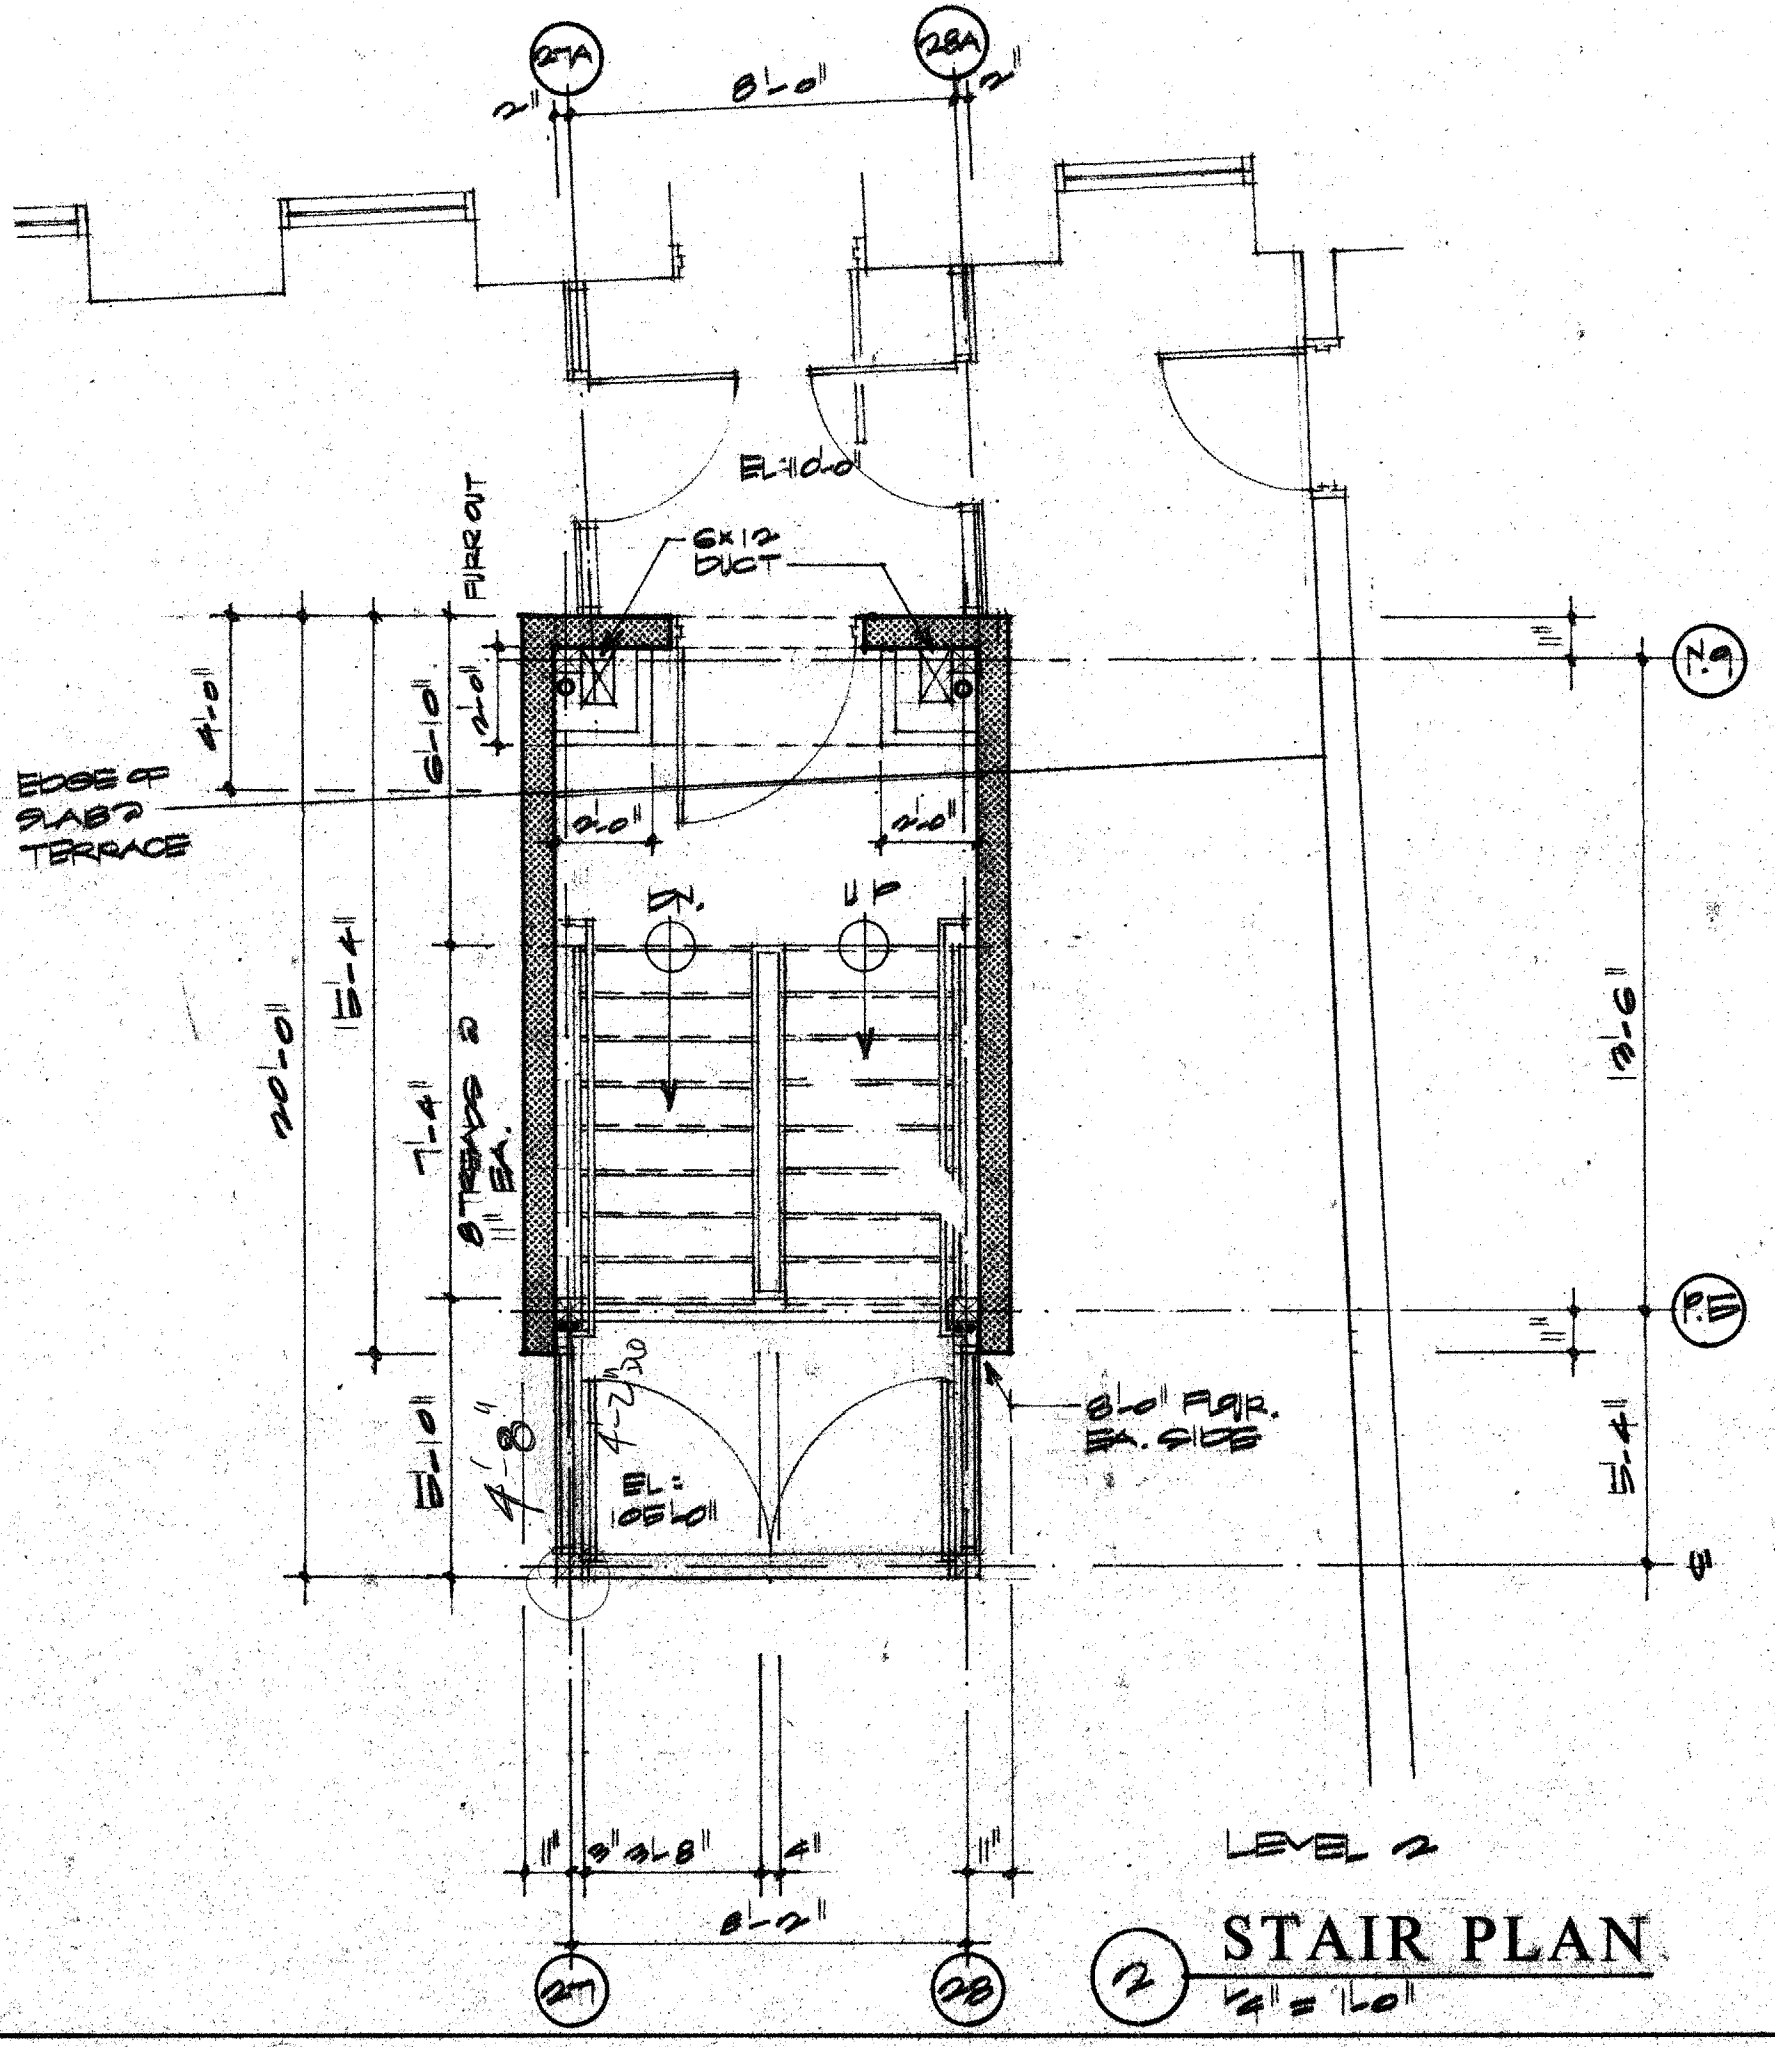


2 LEVEL 2 STAIR PLAN
1/2" = 1'-0"

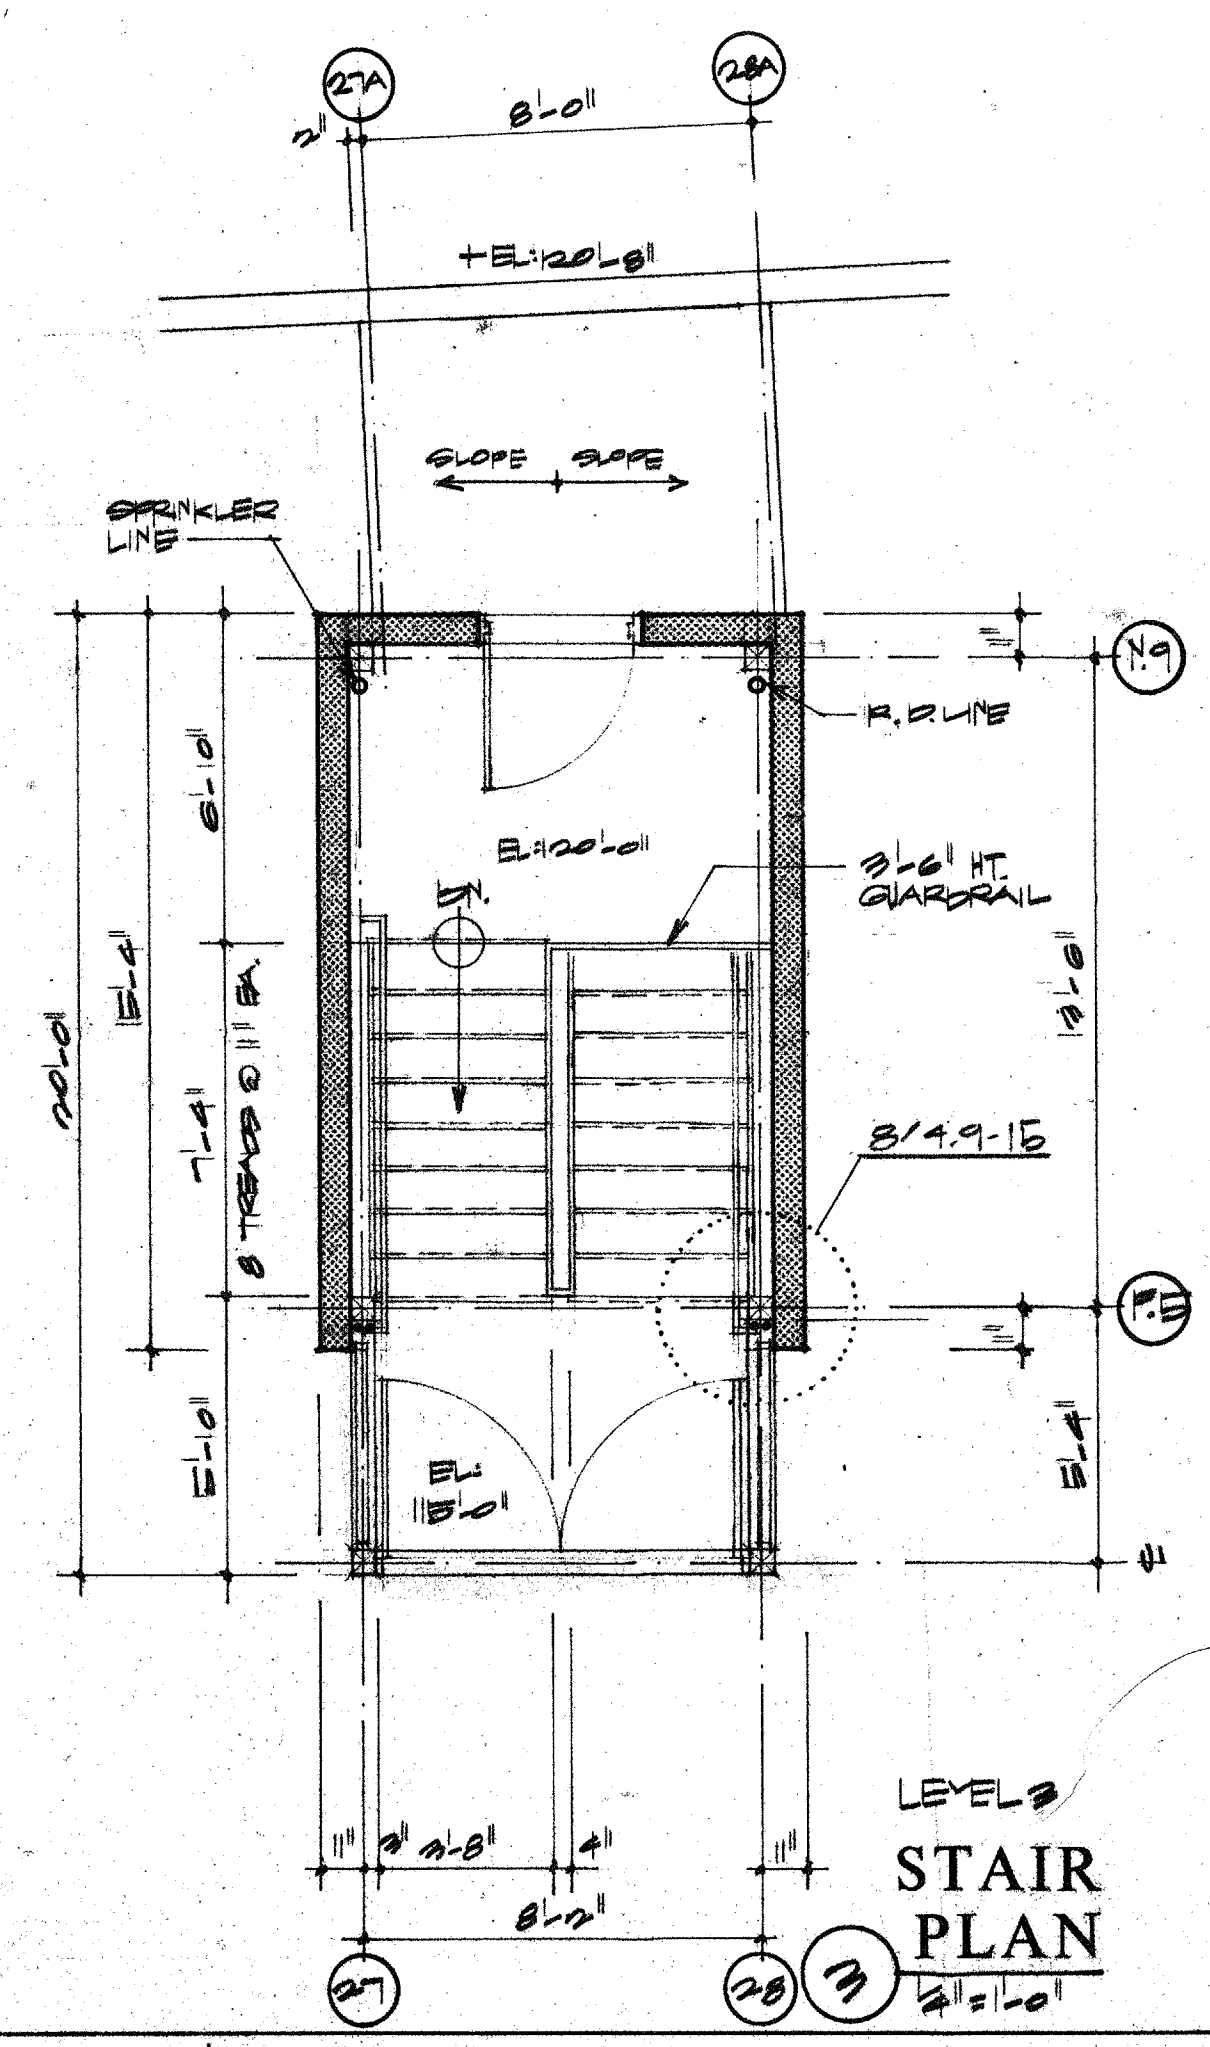

3 LEVEL 3 STAIR PLAN
1/2" = 1'-0"

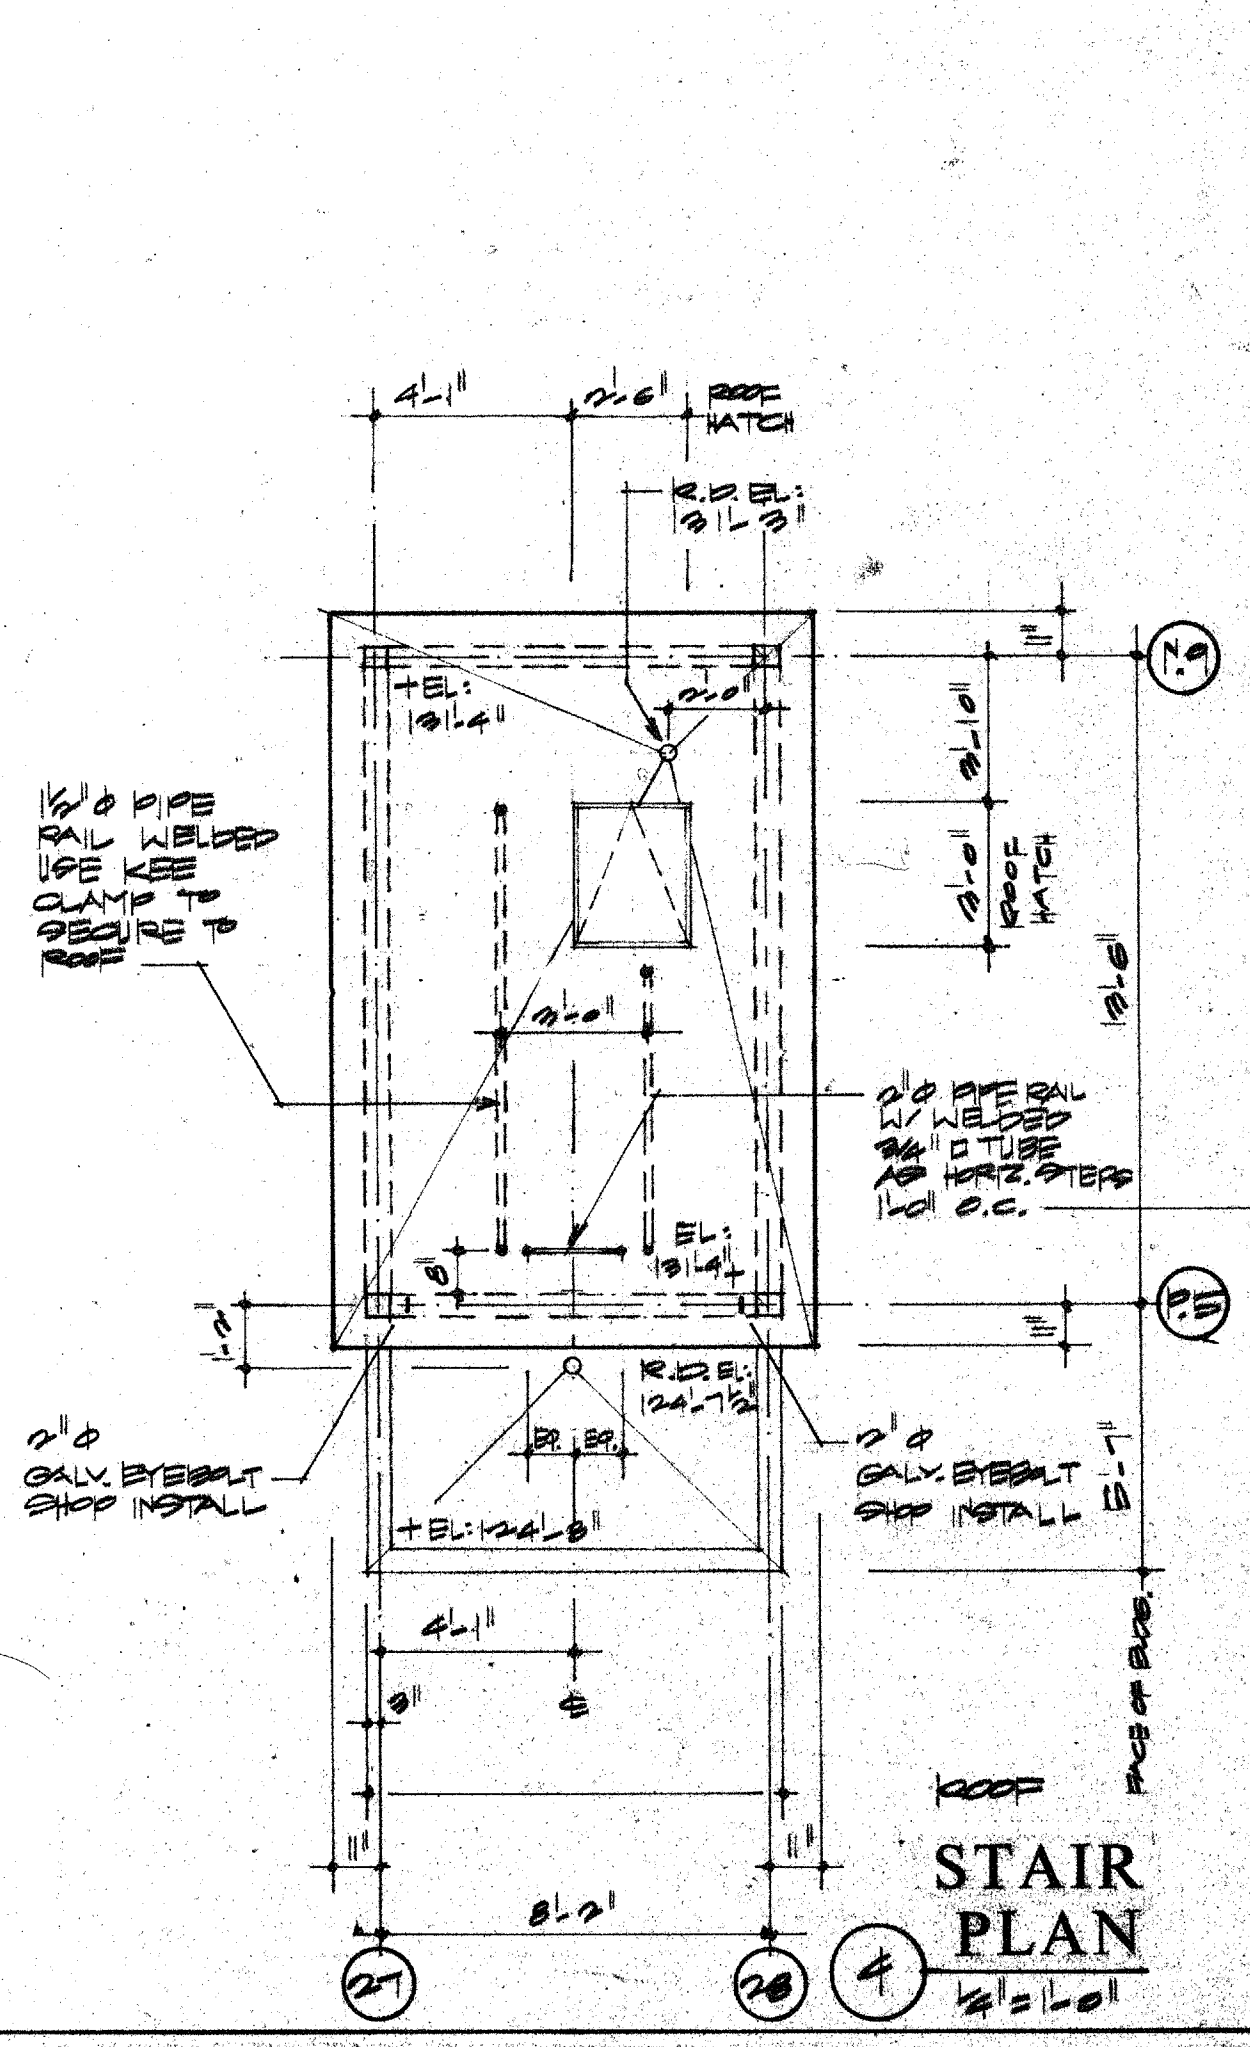

4 STAIR PLAN
1/2" = 1'-0"

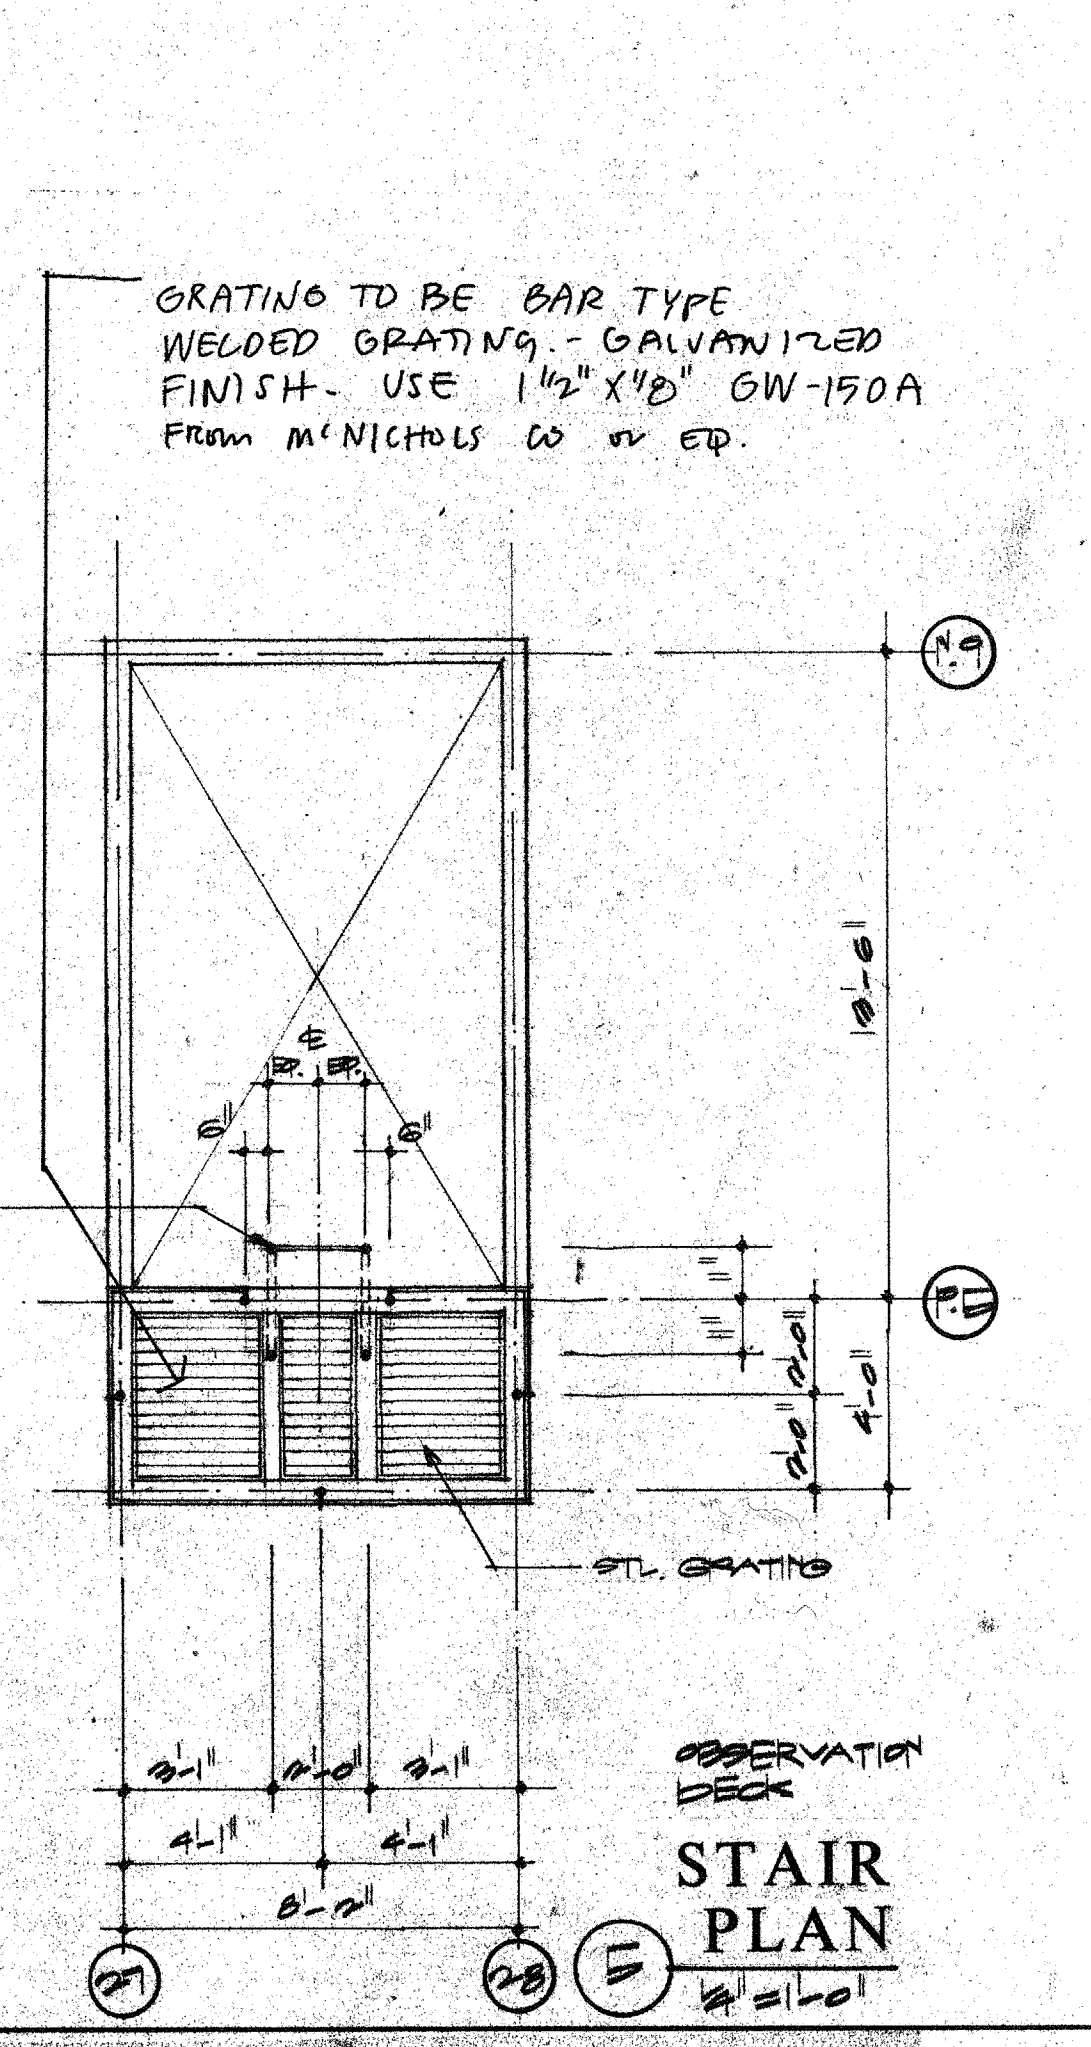

5 STAIR PLAN
1/2" = 1'-0"

GRATINGS TO BE BAR TYPE WELDED GRATING - GALVANIZED FINISH - USE 1 1/2" X 1" GW-150A From M'NICHOLS CO. or EP.



ACC ADDISON ACT

OWNER Town of Addison	LANDSCAPE The Ballens Group 317-76-1417	STRUCTURAL Alan Meador 214-387-8393	MECHANICAL Alan Meador 214-387-7822	Issue ISSUE FOR BID 8-17-00
ARCHITECT Cunningham Architects 2703 Fairmount Dallas, Texas 75201 214-855-5272	THEATRE CONSULTANT Theatre Projects 203-431-9849 214-855-5272	M.E.P. MEP Systems 214-754-4741	LIGHTING Parsons Hill Wilson 214-823-9542	Category 4
INTERIORS CRSS 713-552-2000	CMU Kurtz & Associates 214-680-3322	GRAPHICS Northland Design 214-954-1979	Subcategory 10	Sheet 1