



⑥ ELEVATION
1" = 1'-0"


⑤ ELEVATION
1" = 1'-0"

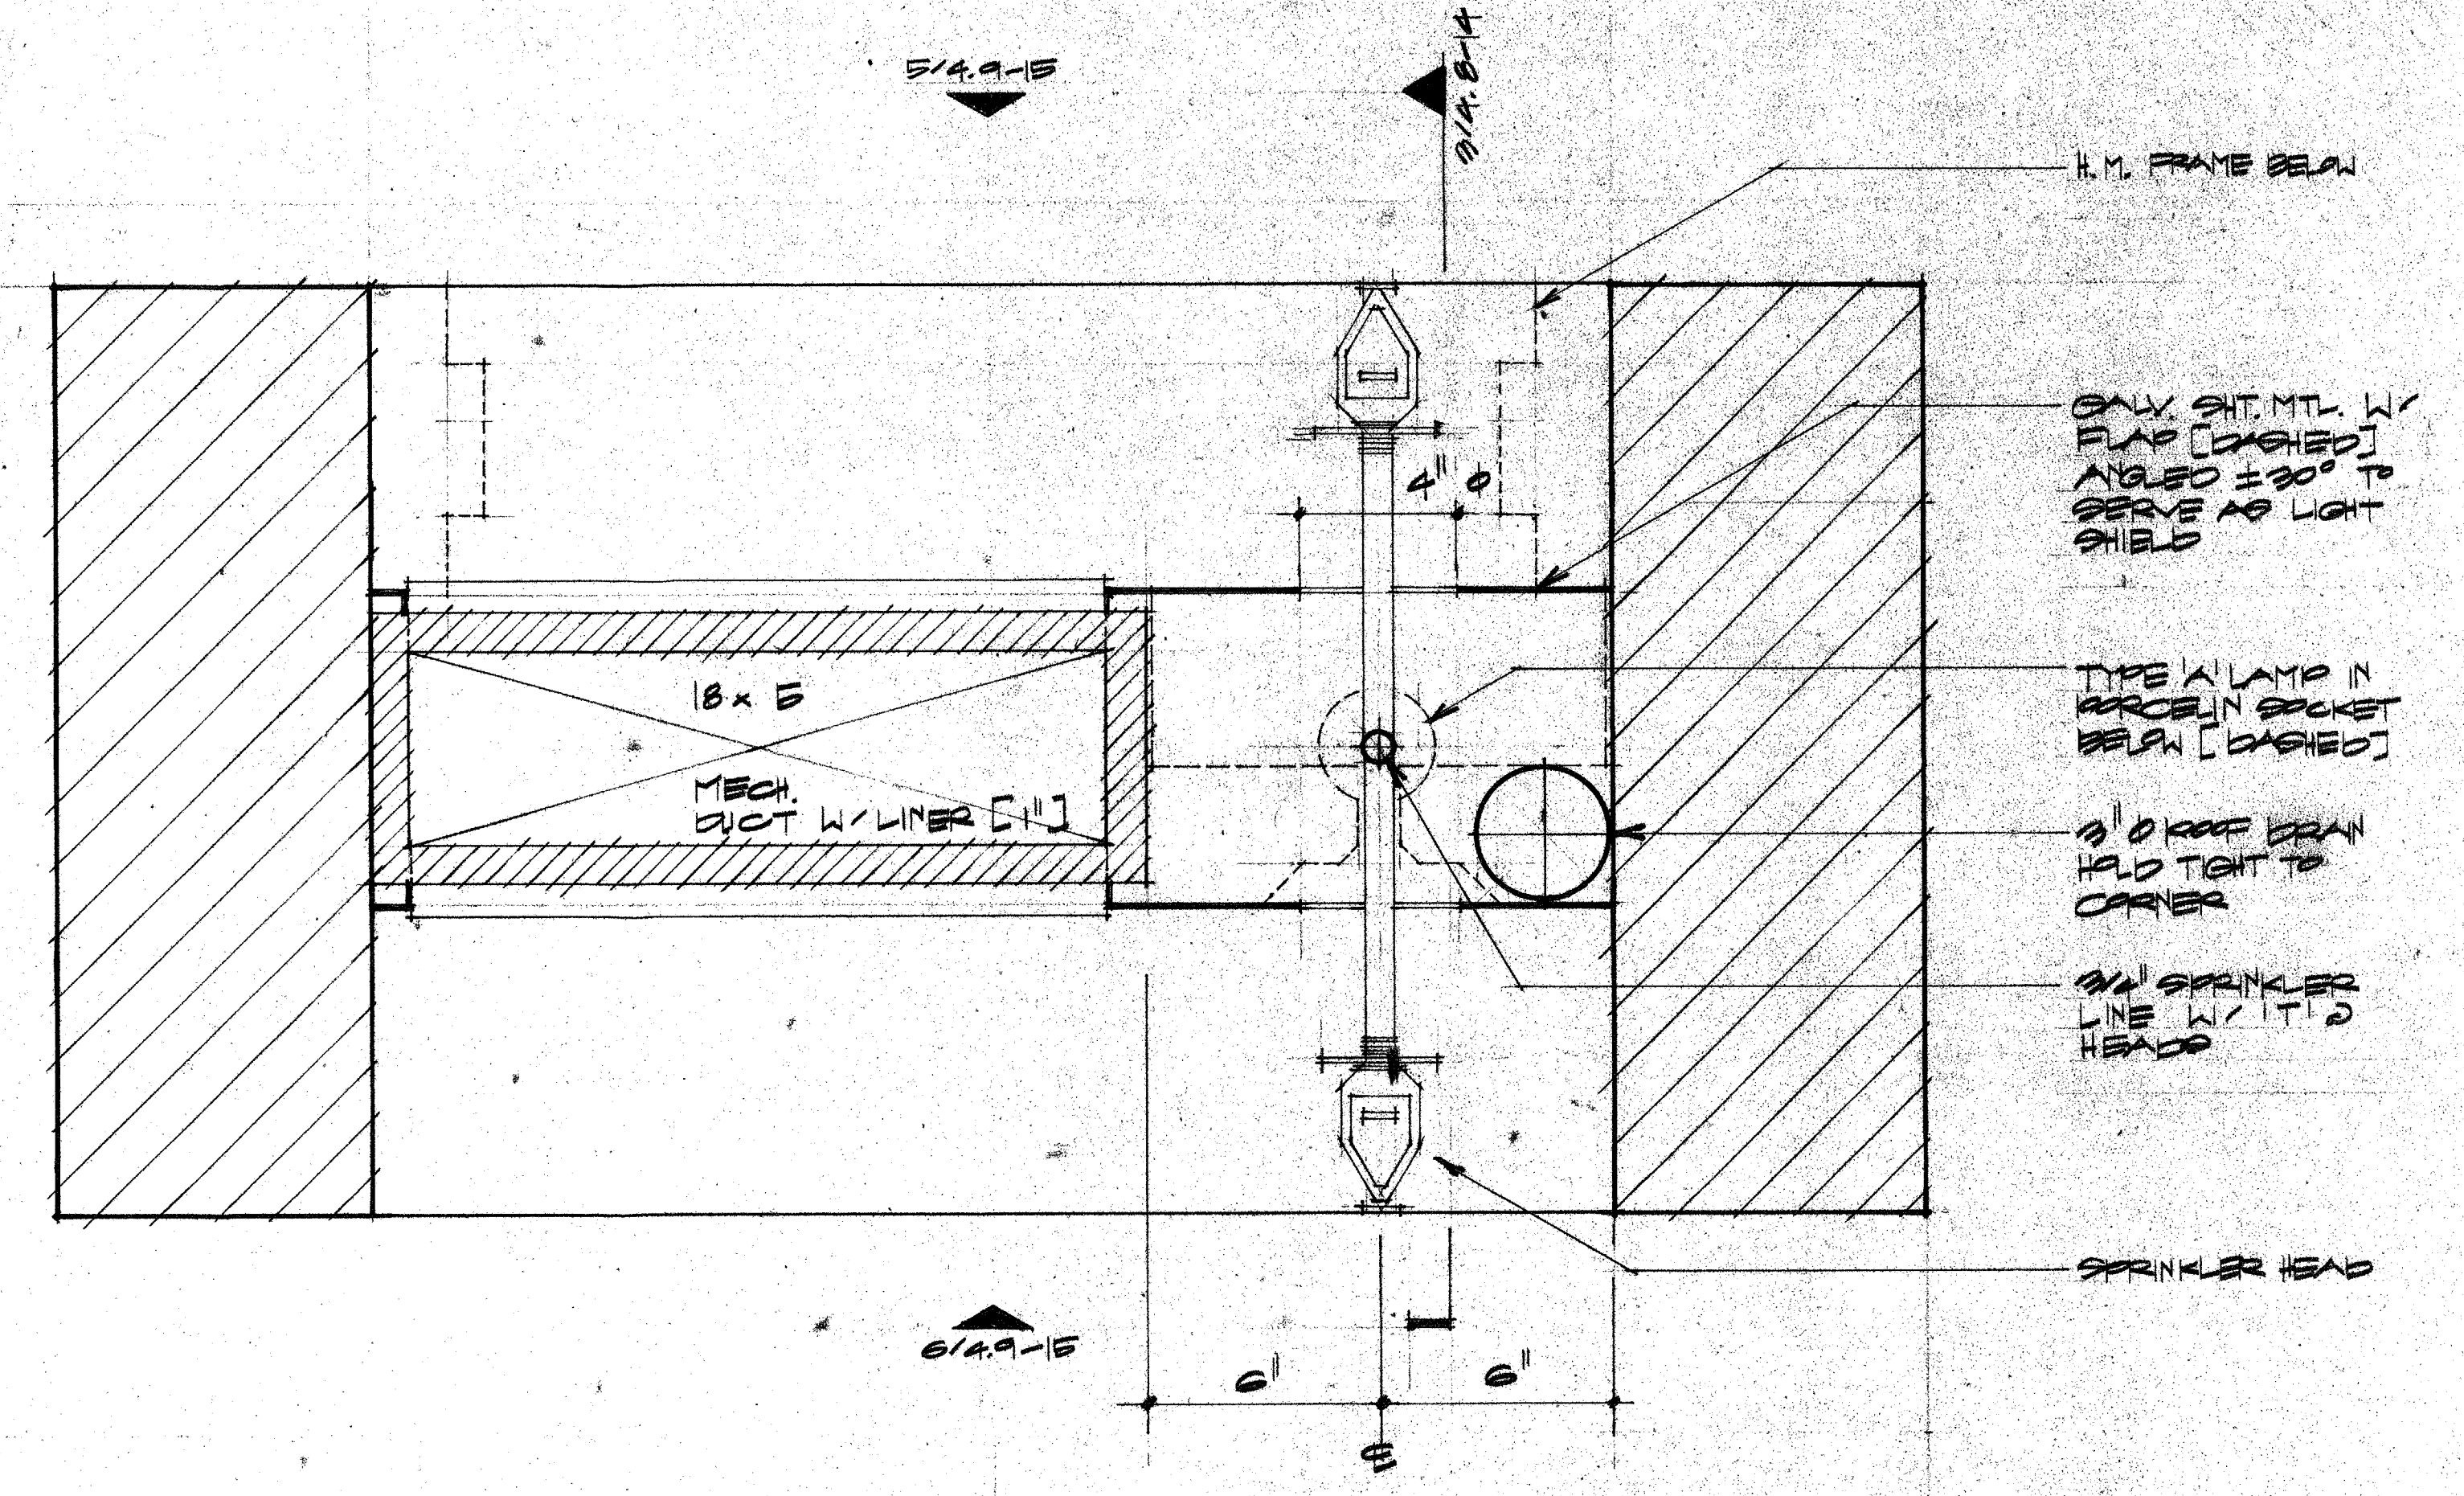


④ PLAN DETAIL
1" = 1'-0"

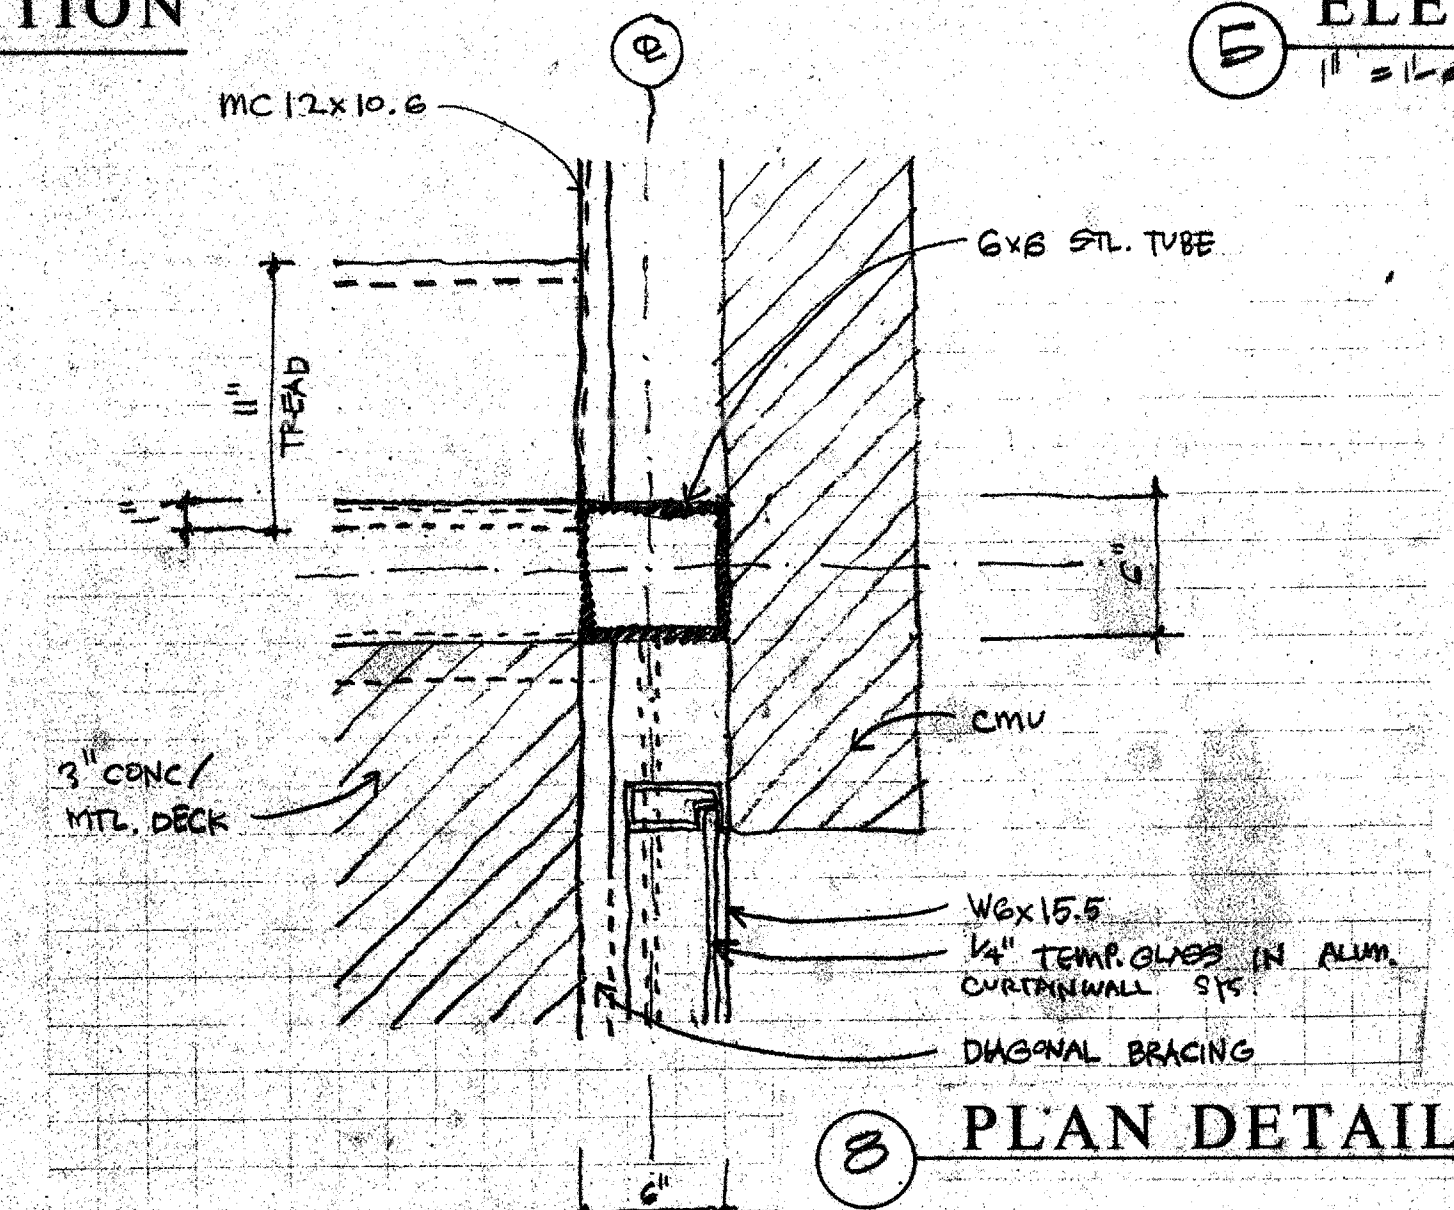


③ PLAN DETAIL

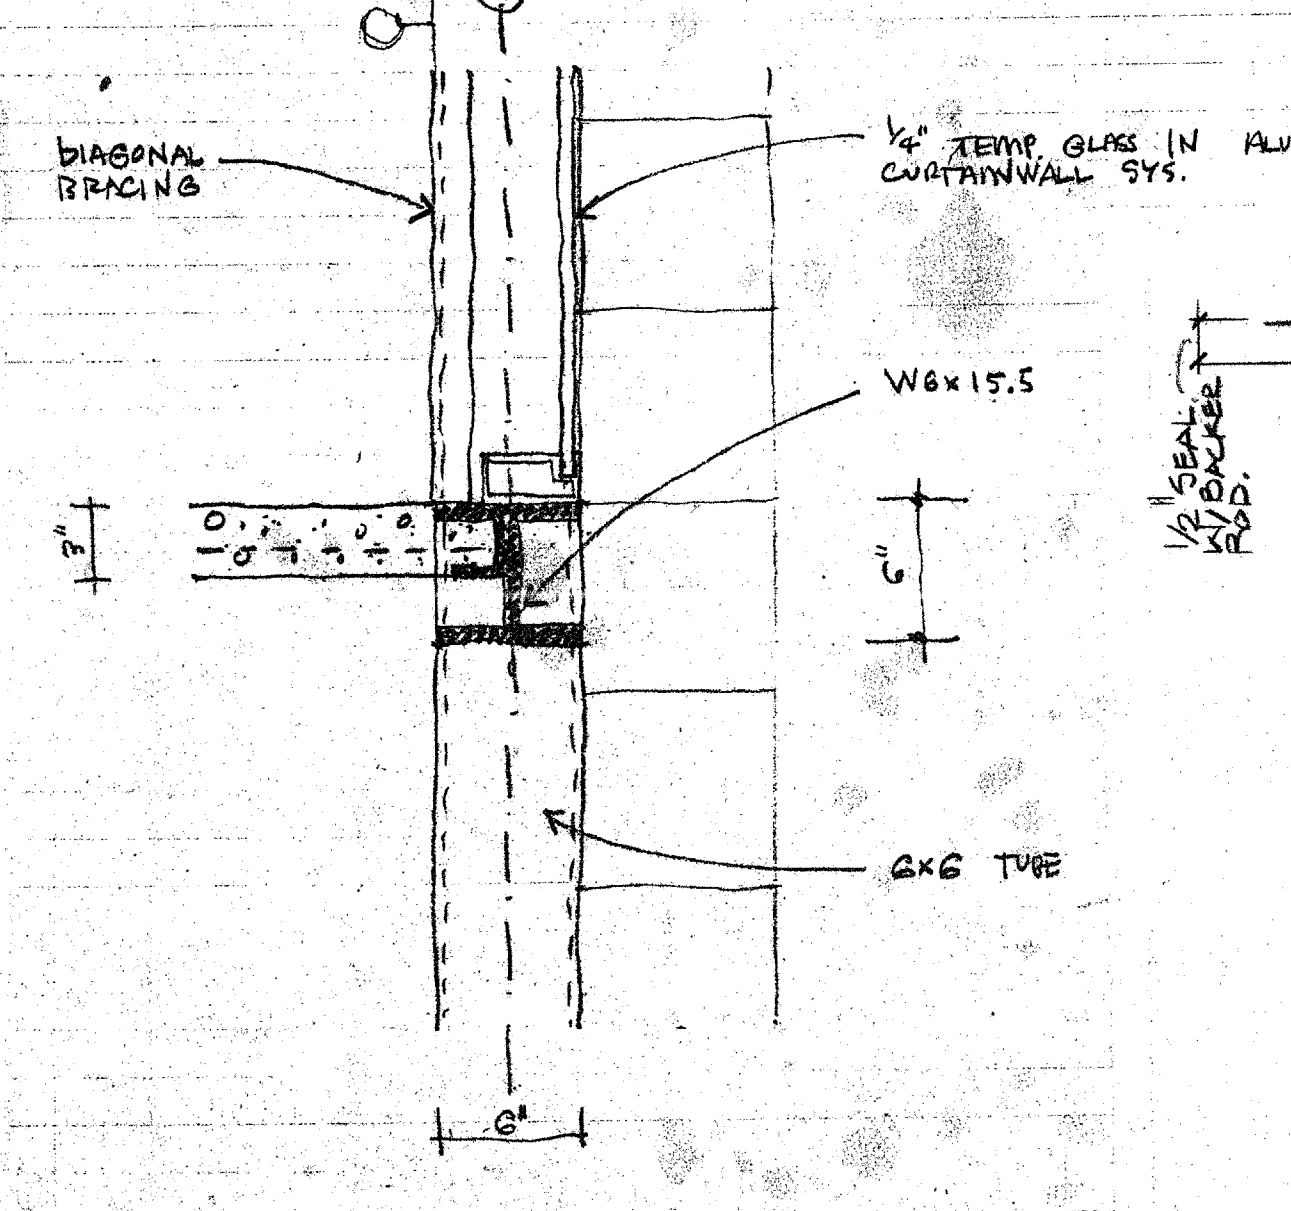


⑦ SECTION @ INTERIOR LANDING

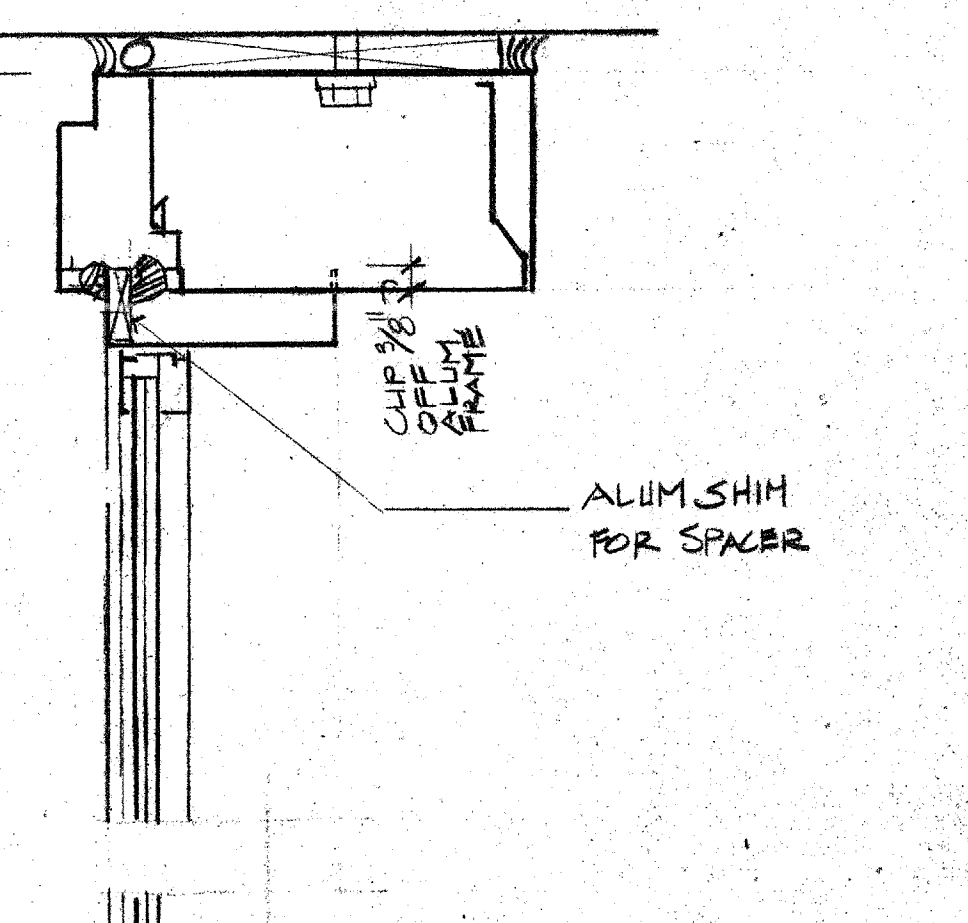


② DETAIL
HALF SCALE

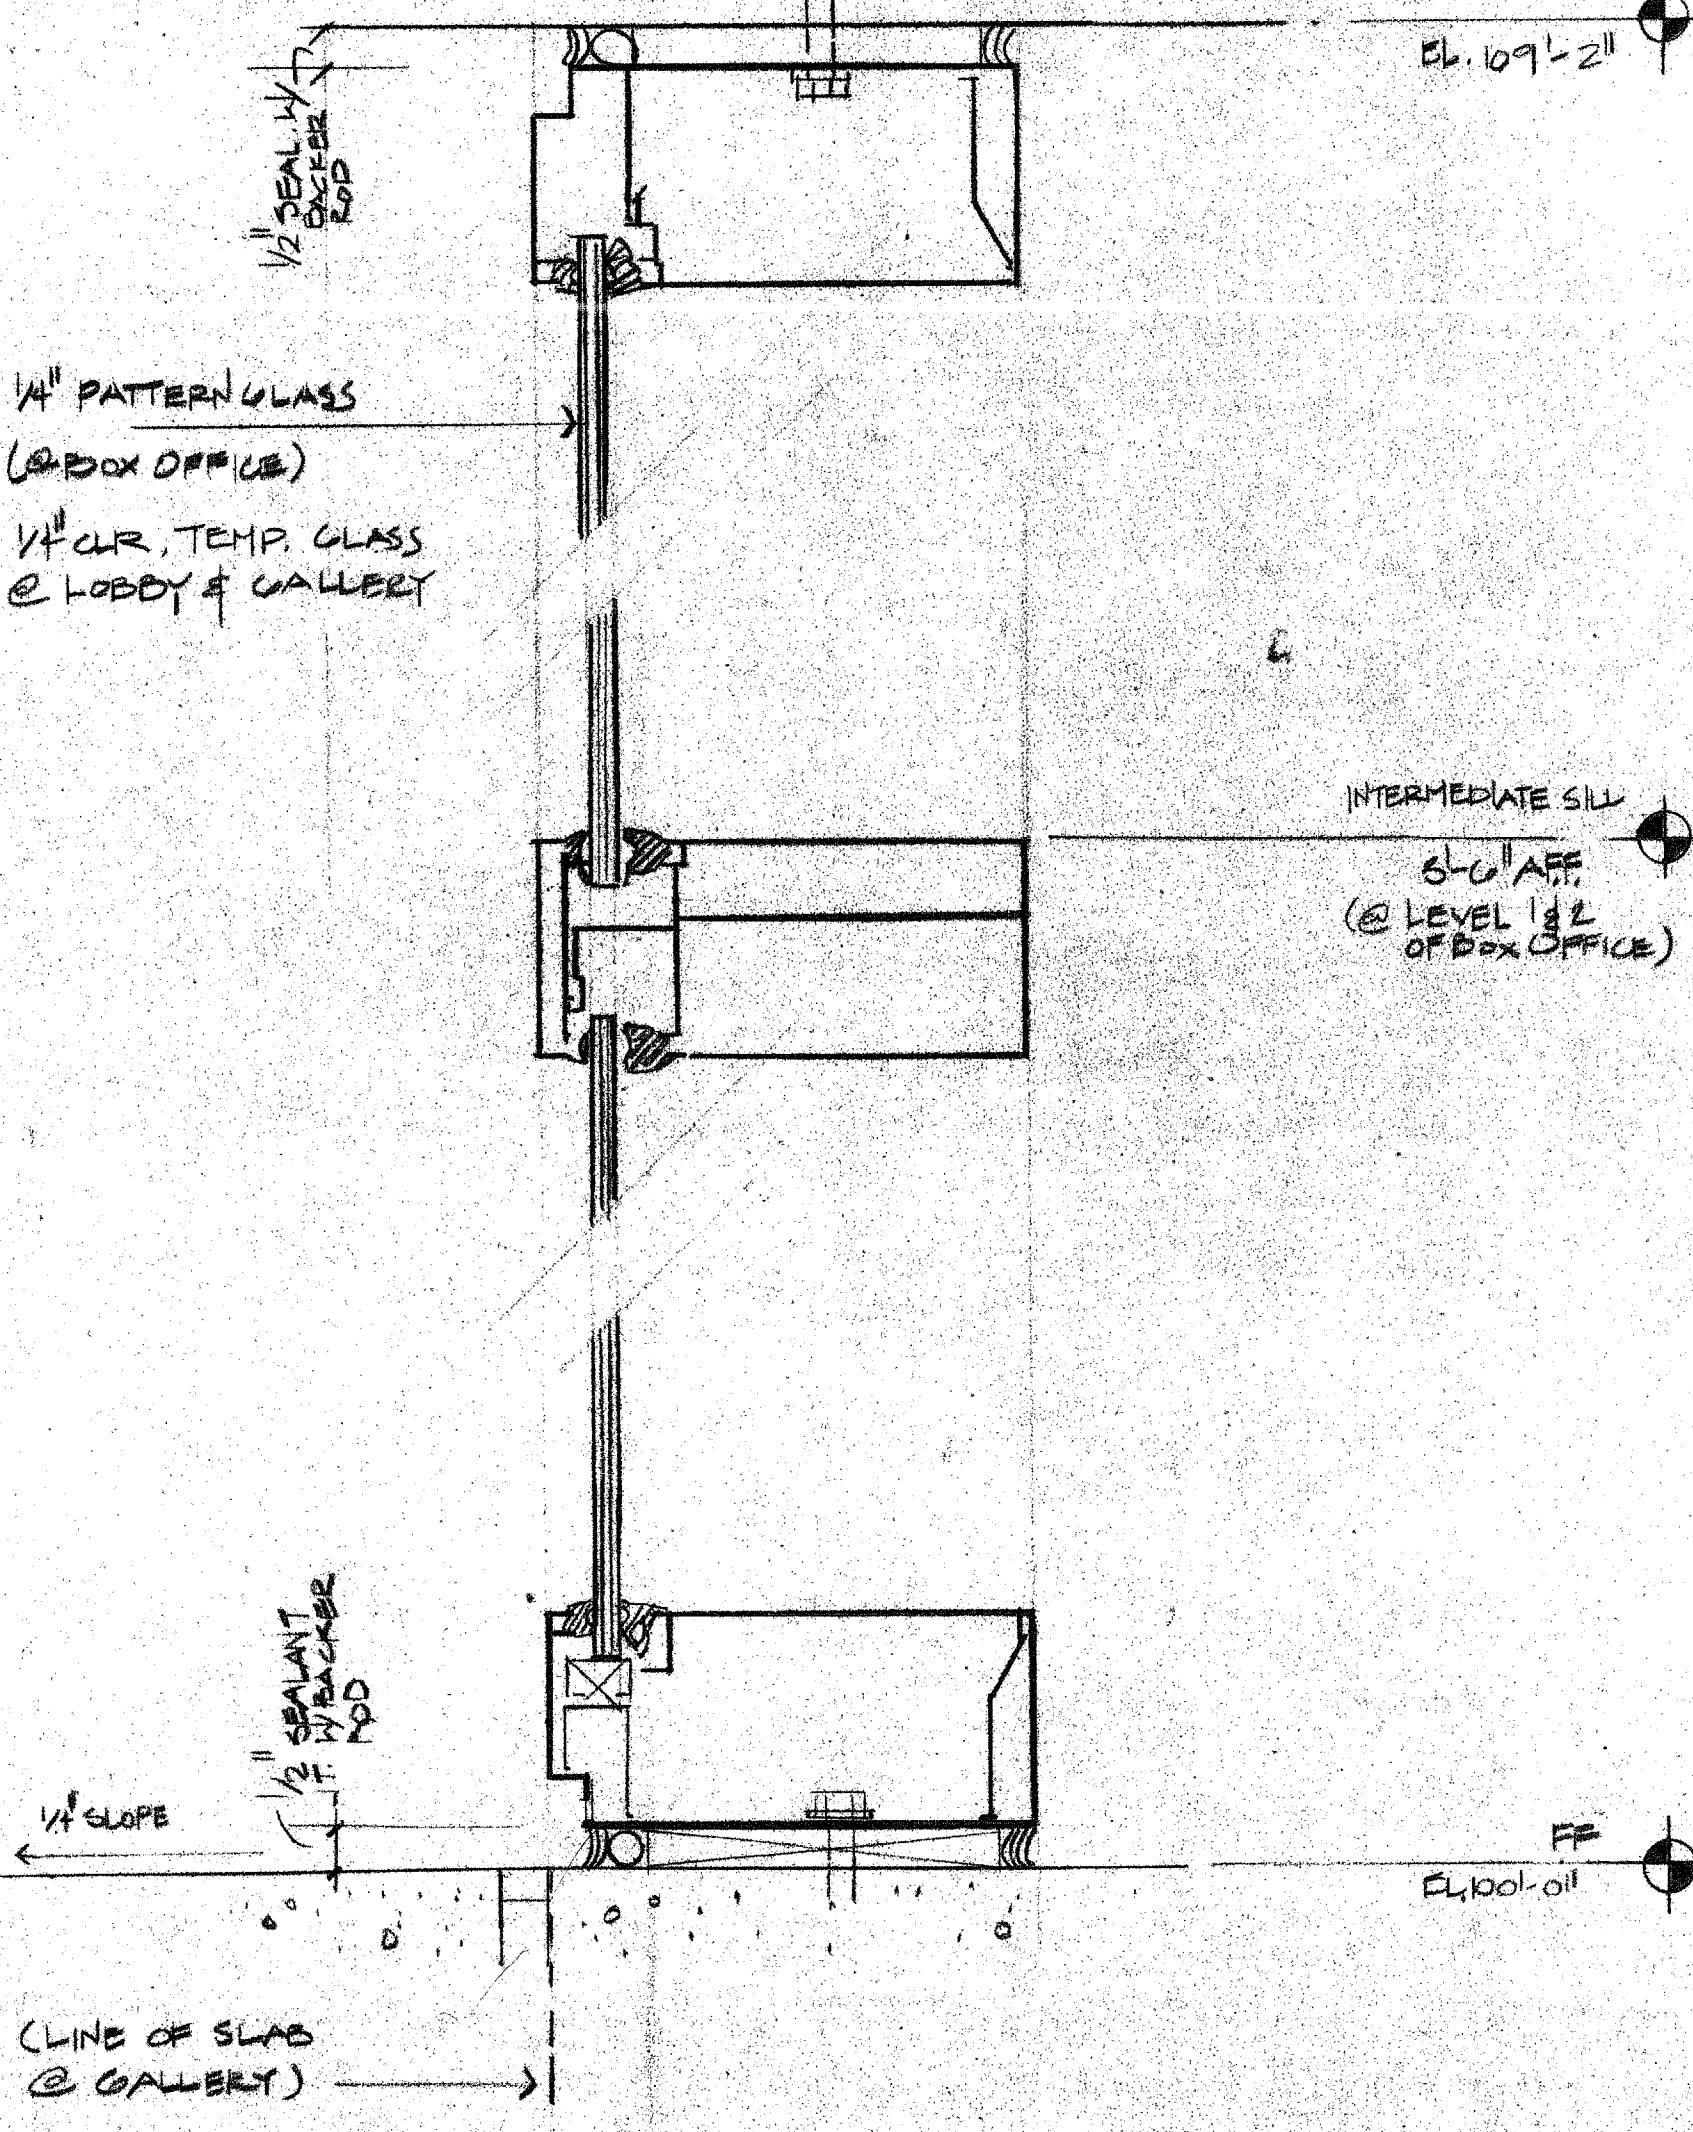


① DETAIL
HALF SCALE

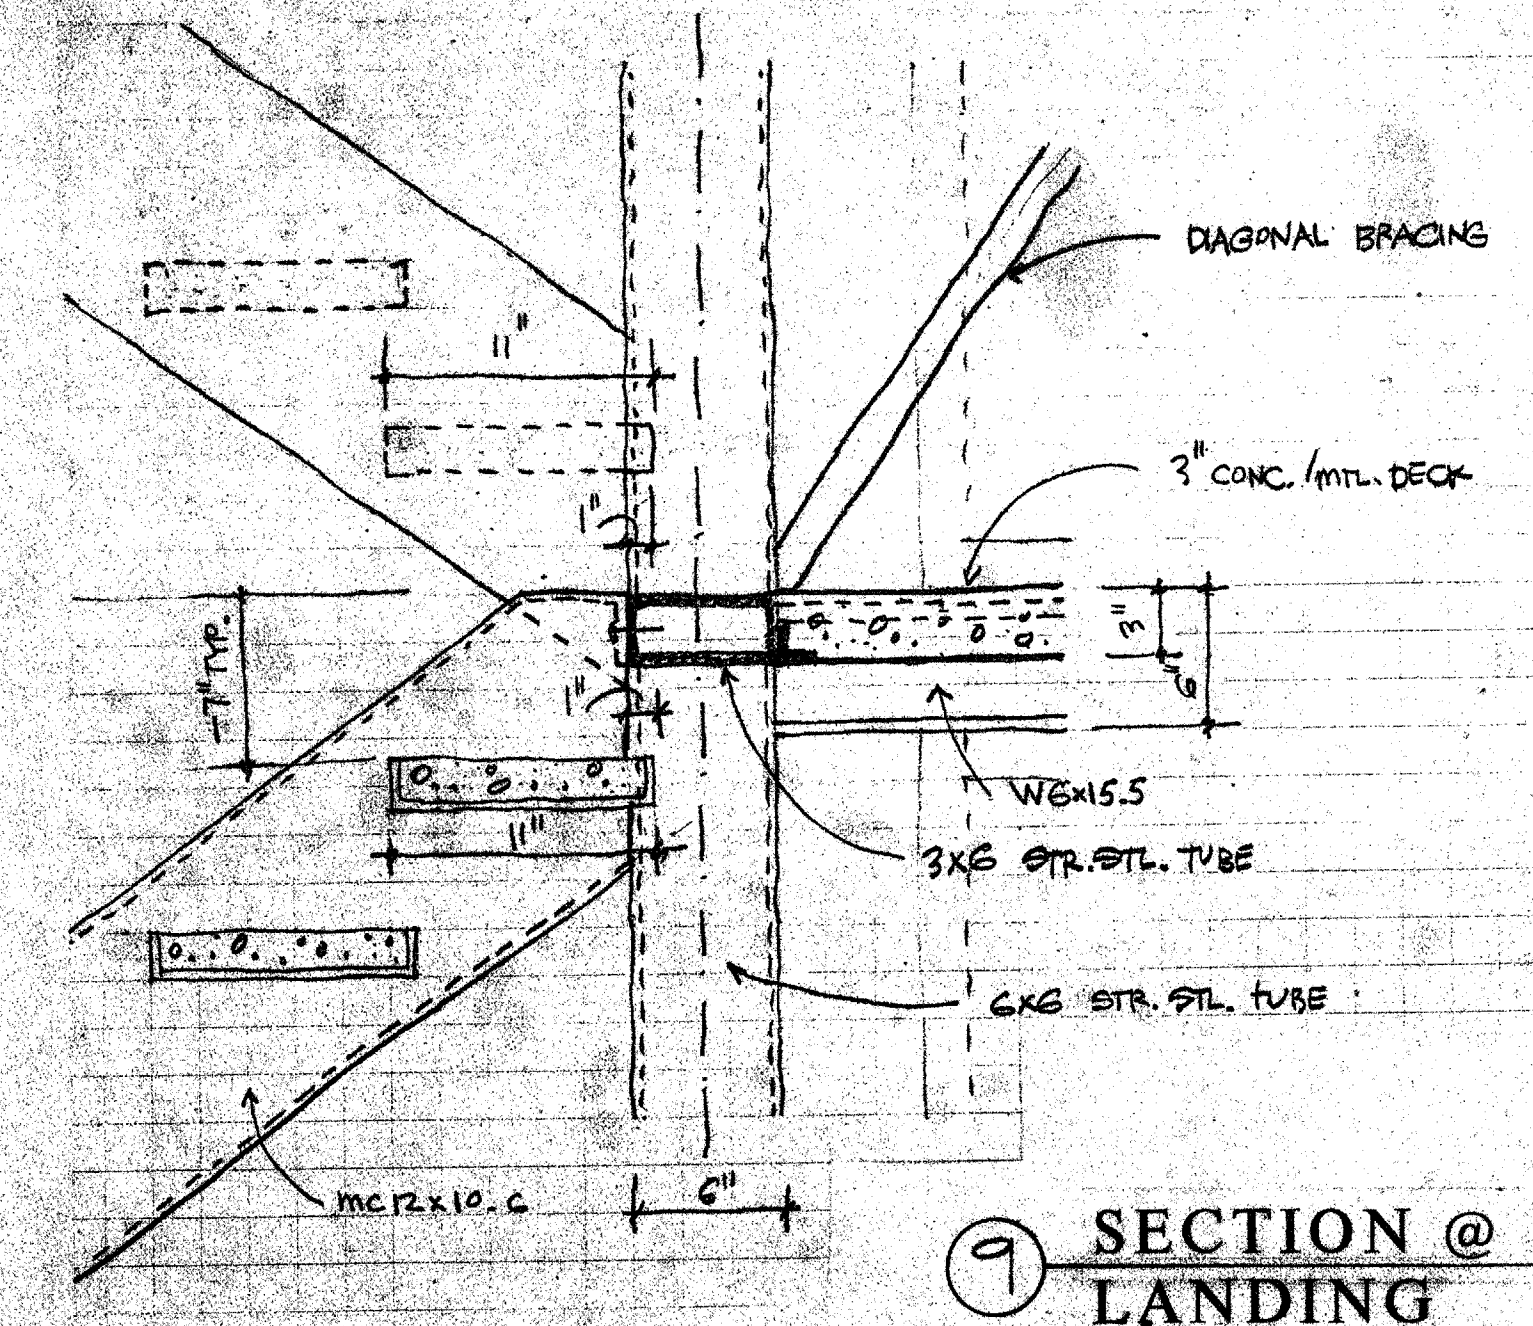

⑧ SECTION @ INTERIOR LANDING

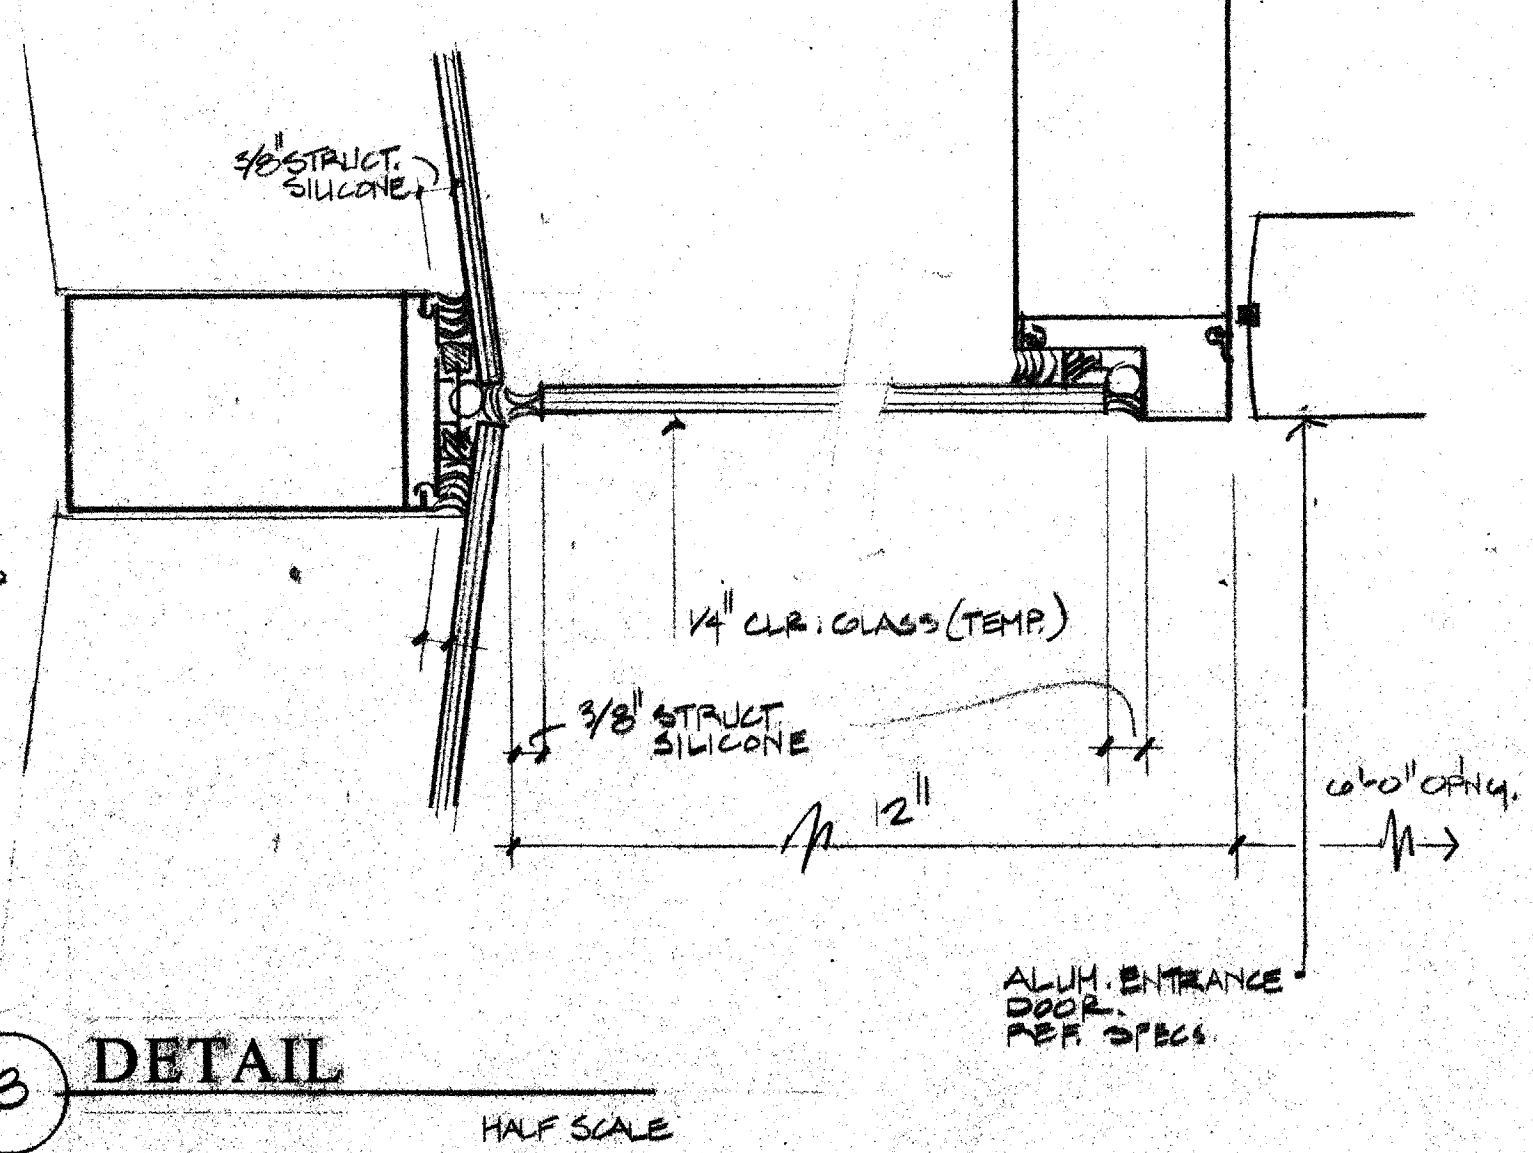

③ DETAIL
HALF SCALE

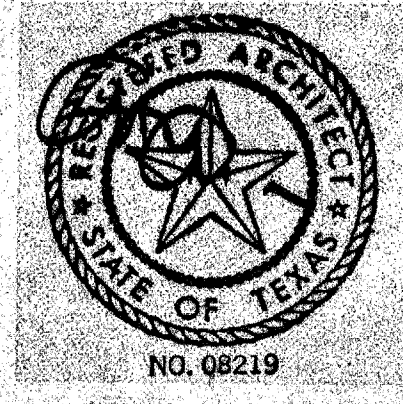

ACC ADDISON ACT

OWNER Town of Addison	LANDSCAPE The Kellams Group 507.76.197	STRUCTURAL Eller Torrey 214.387.8393	HISTORIAN Alan Mason 214.659.7182
ARCHITECT Cunningham Architects 2700 Fairmont Dallas, Texas 75201 214.655.5272	THEATRE CONSULTANT Theatre Projects 203.431.3949	M.E.P. MEP Systems 214.764.4741	LIGHTING Pamella Hull Wilson 214.823.6542
INTERIORS CRSS 710.552.2000		CIVIL Kurt & Associates 214.90.3322	GRAPHICS Notified Design 214.254.8178

Issue	Category	Subcategory	Sheet
ISSUE FOR BID. B-17-80	4	9	15