

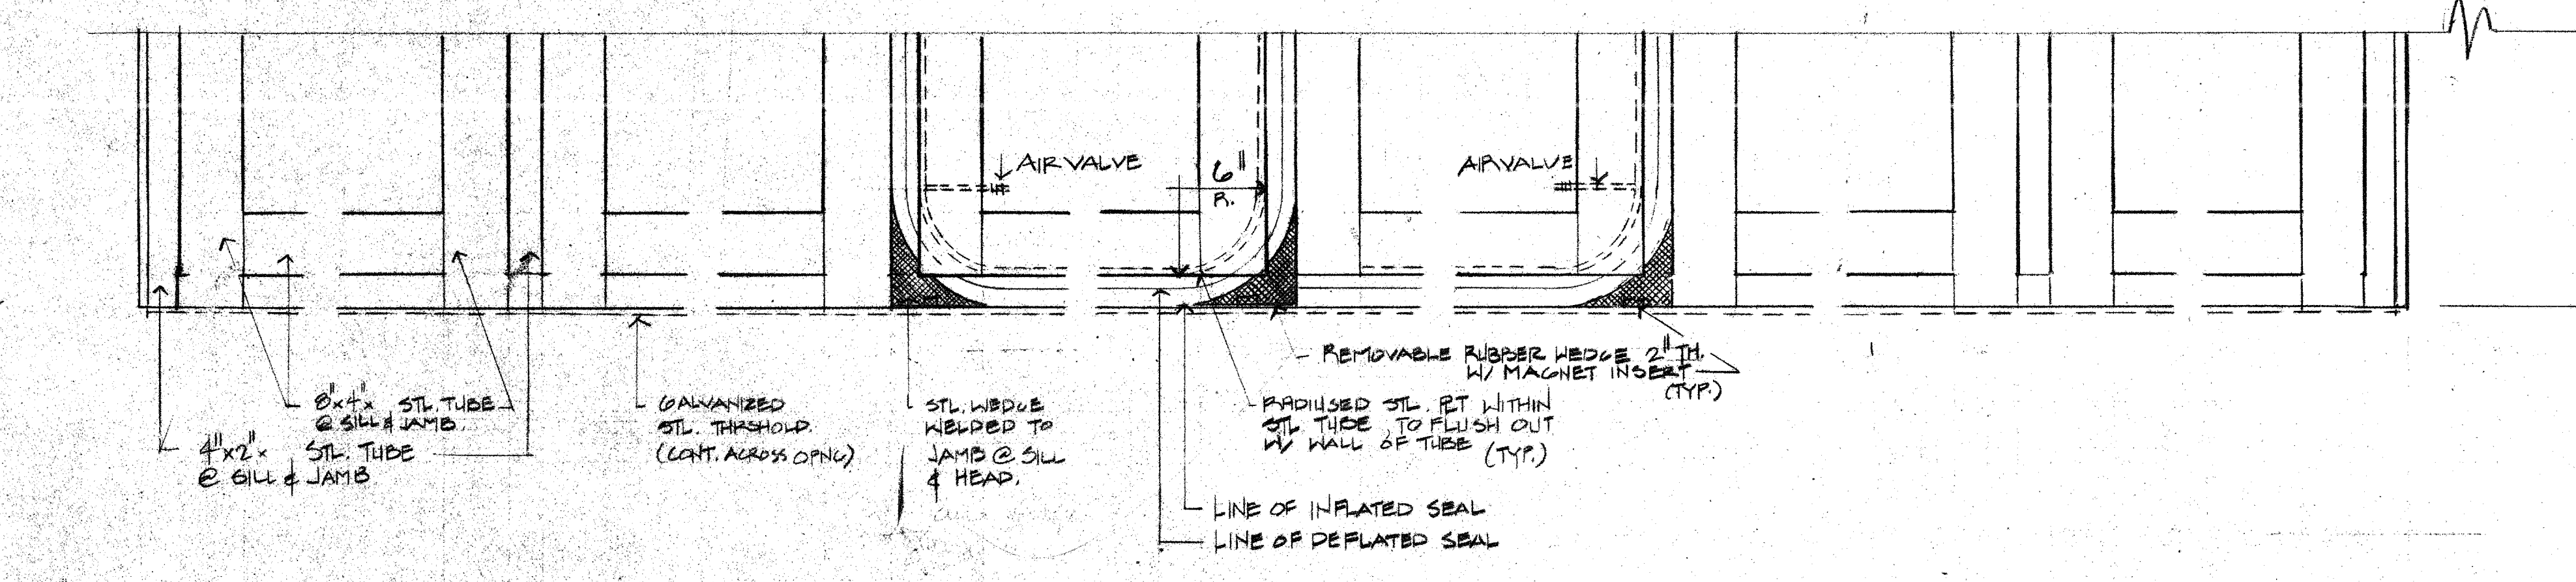



5 DETAIL 1/2" = 1'-0"

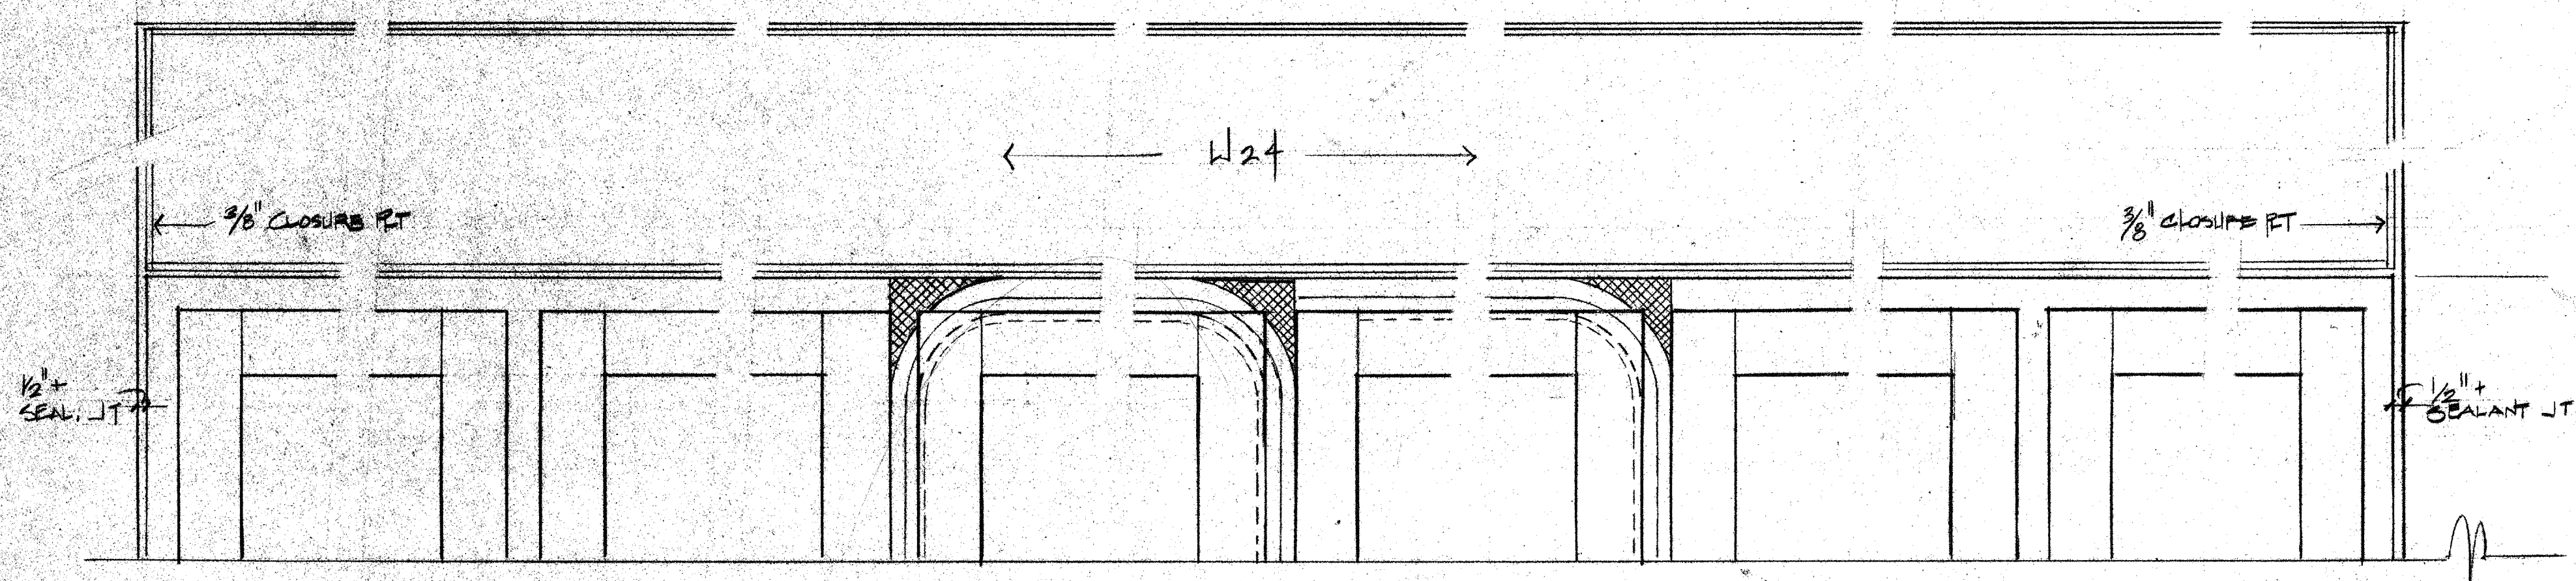


4 DETAIL 1/2" = 1'-0"

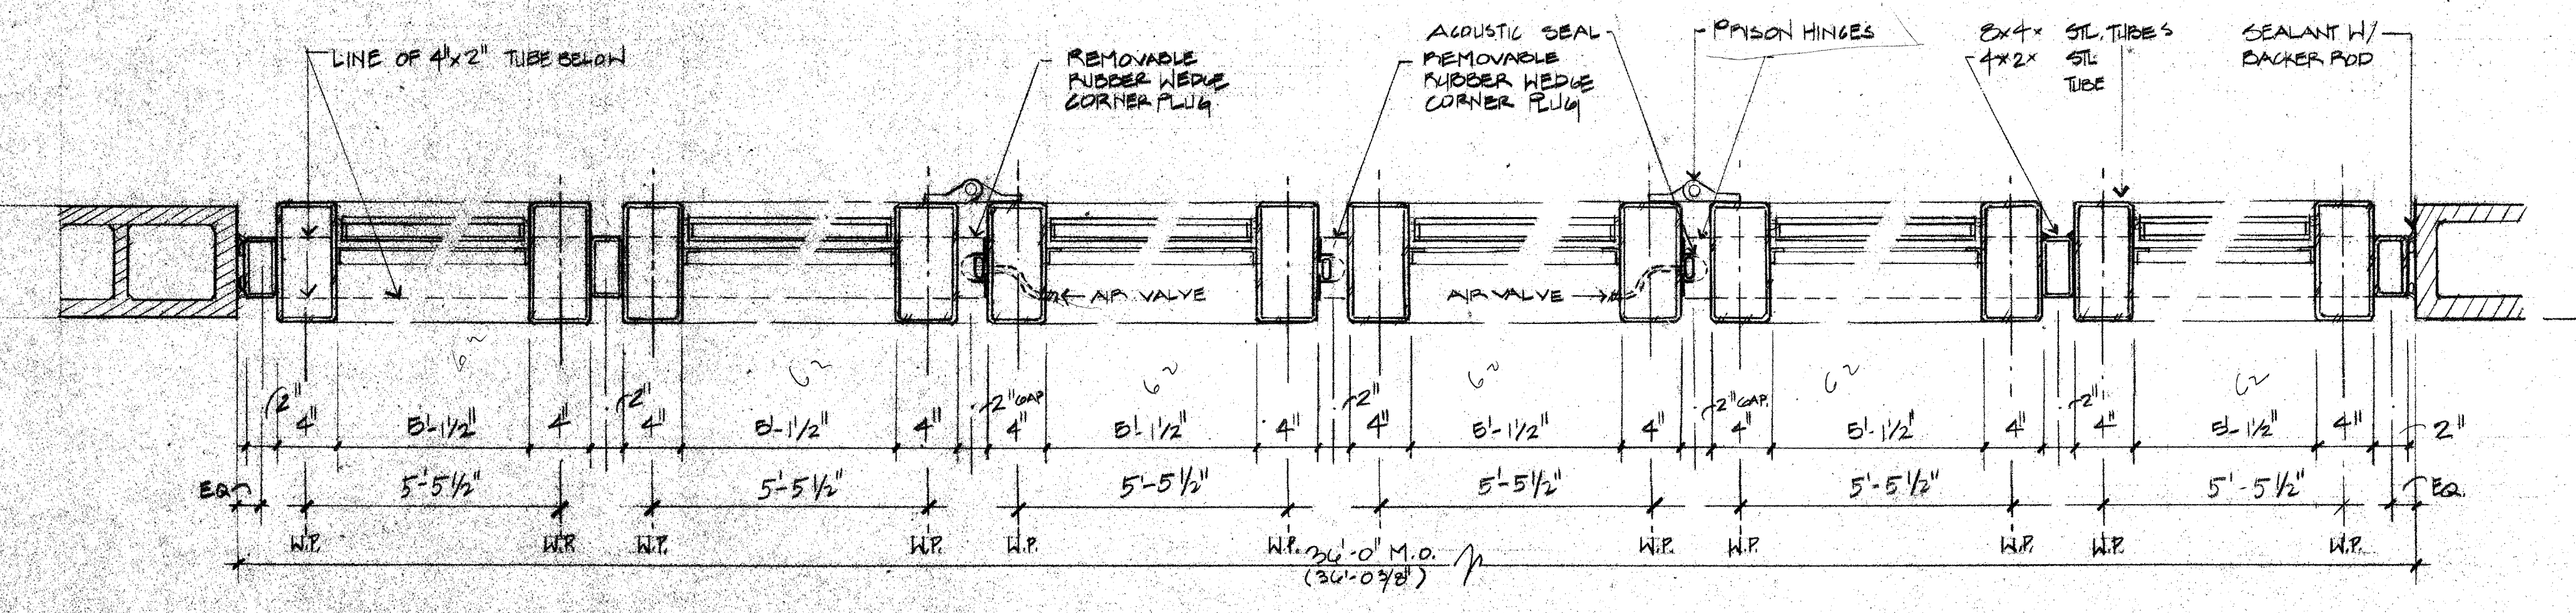


3 DETAIL 1/2" = 1'-0"

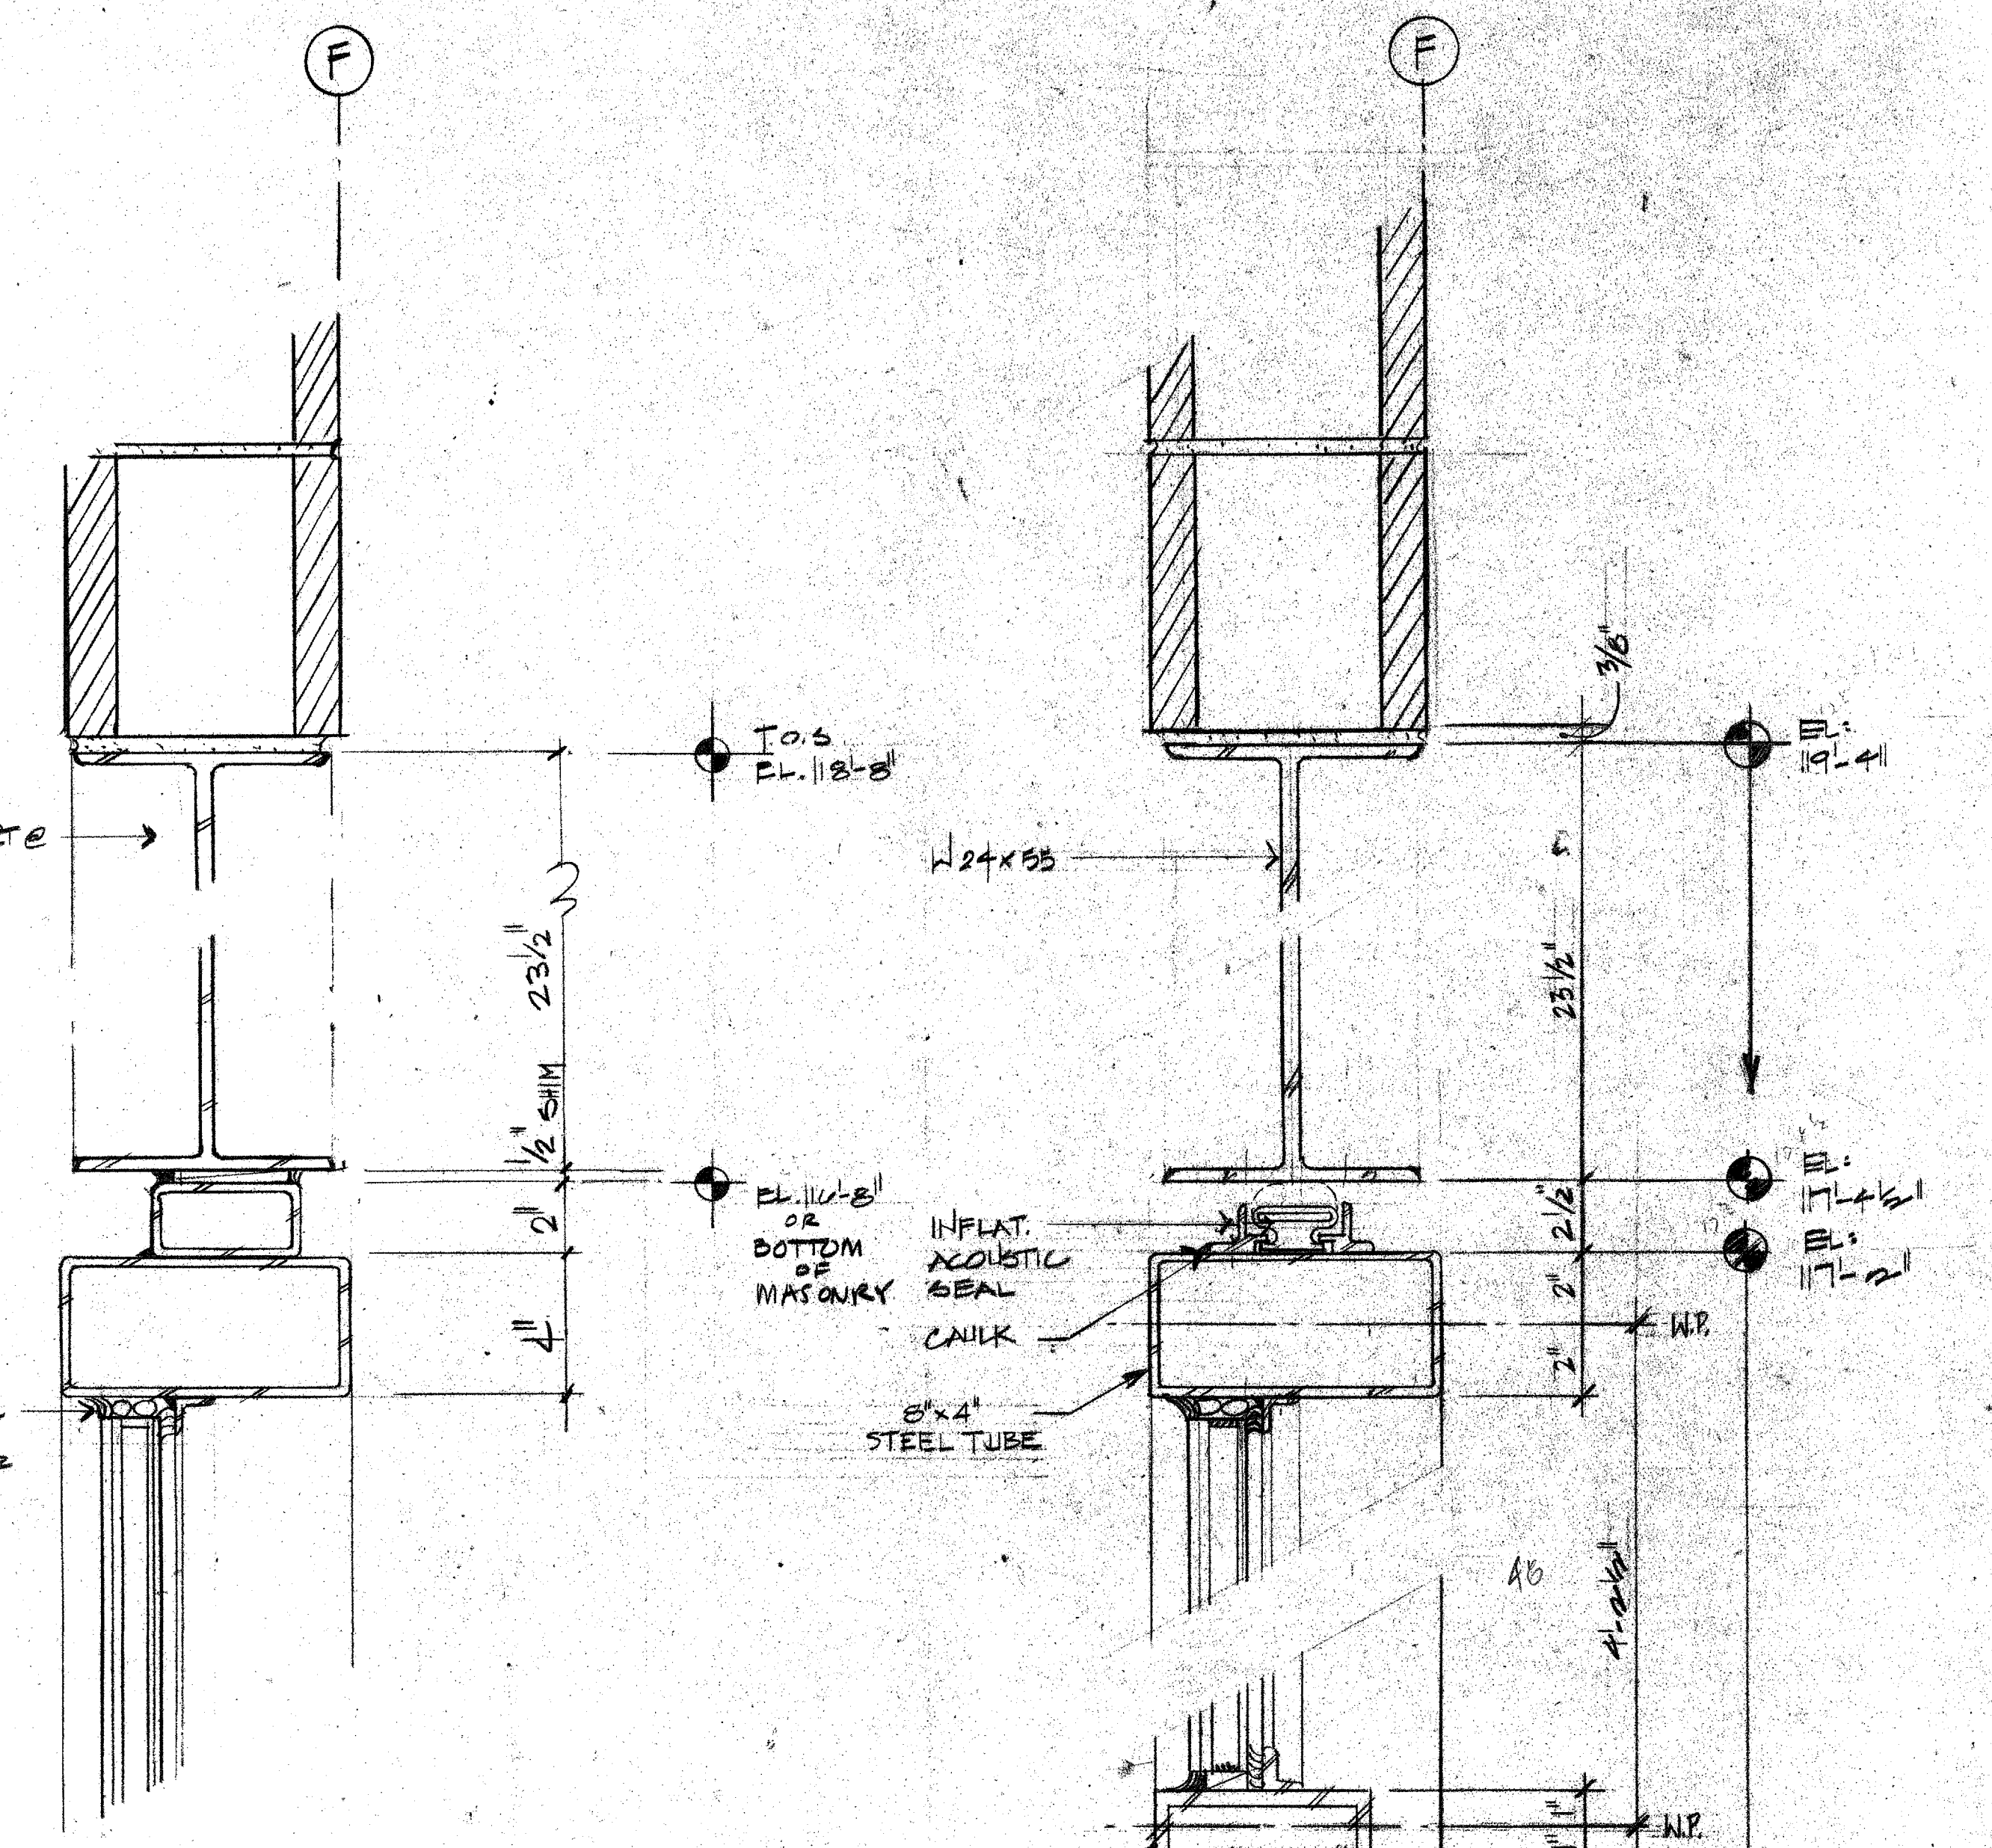

NOTE: REFER TO STRUCTURAL DRAWINGS FOR DETAILS OF MISC. MTL. TO BLDG STRUCTURE,

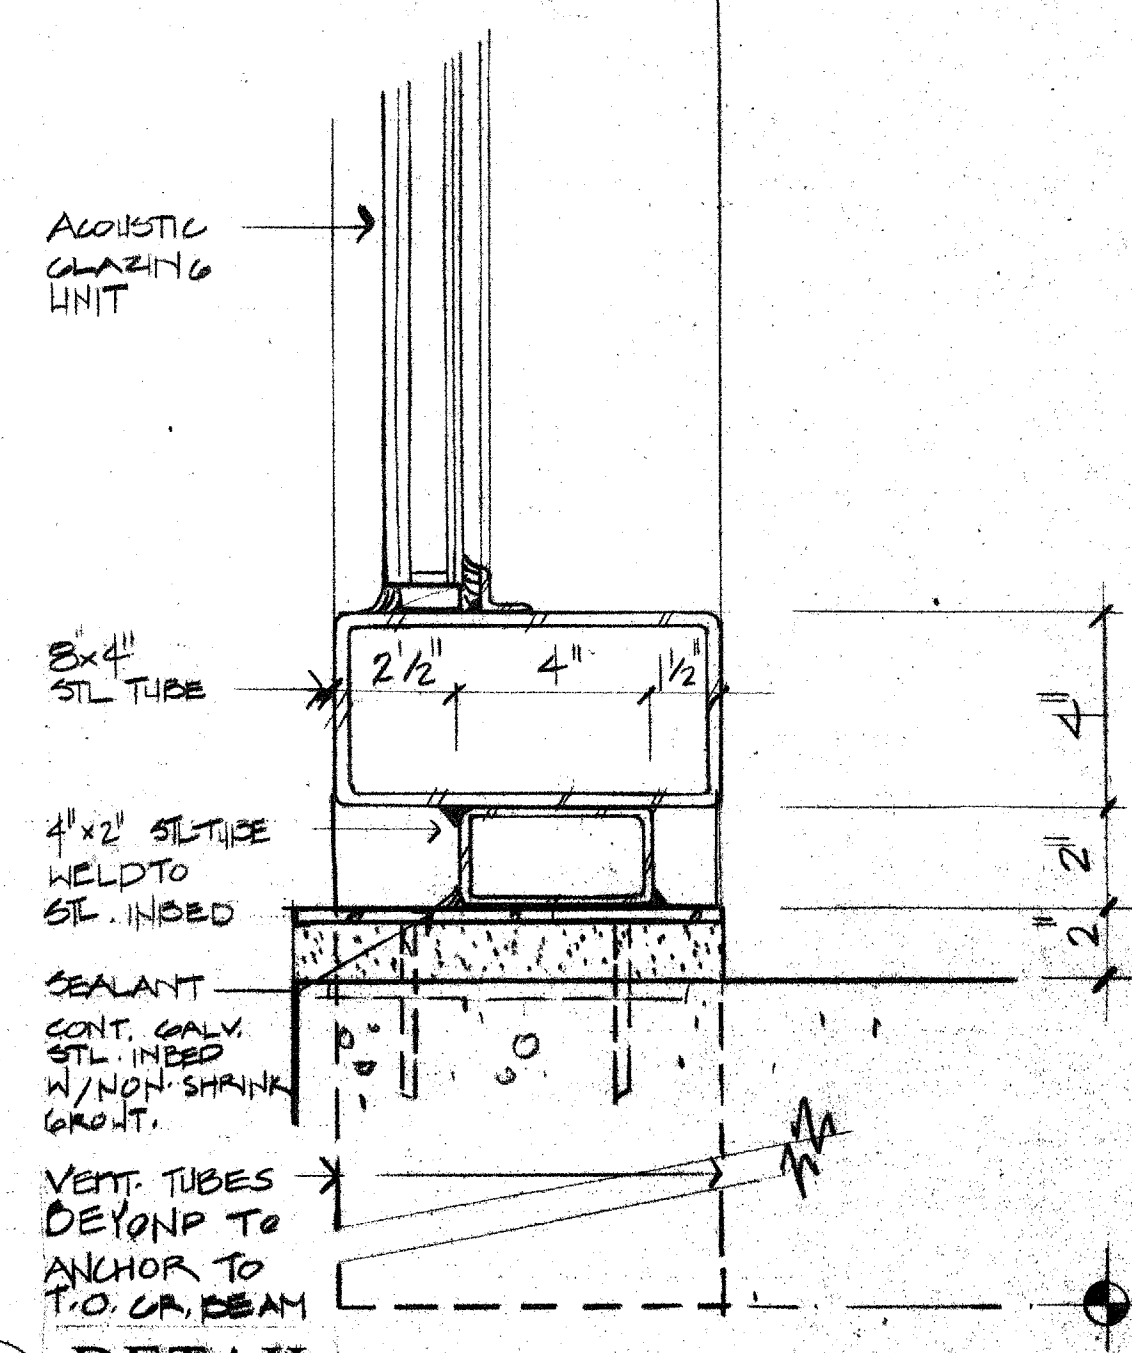

2 DETAIL 1/2" = 1'-0"

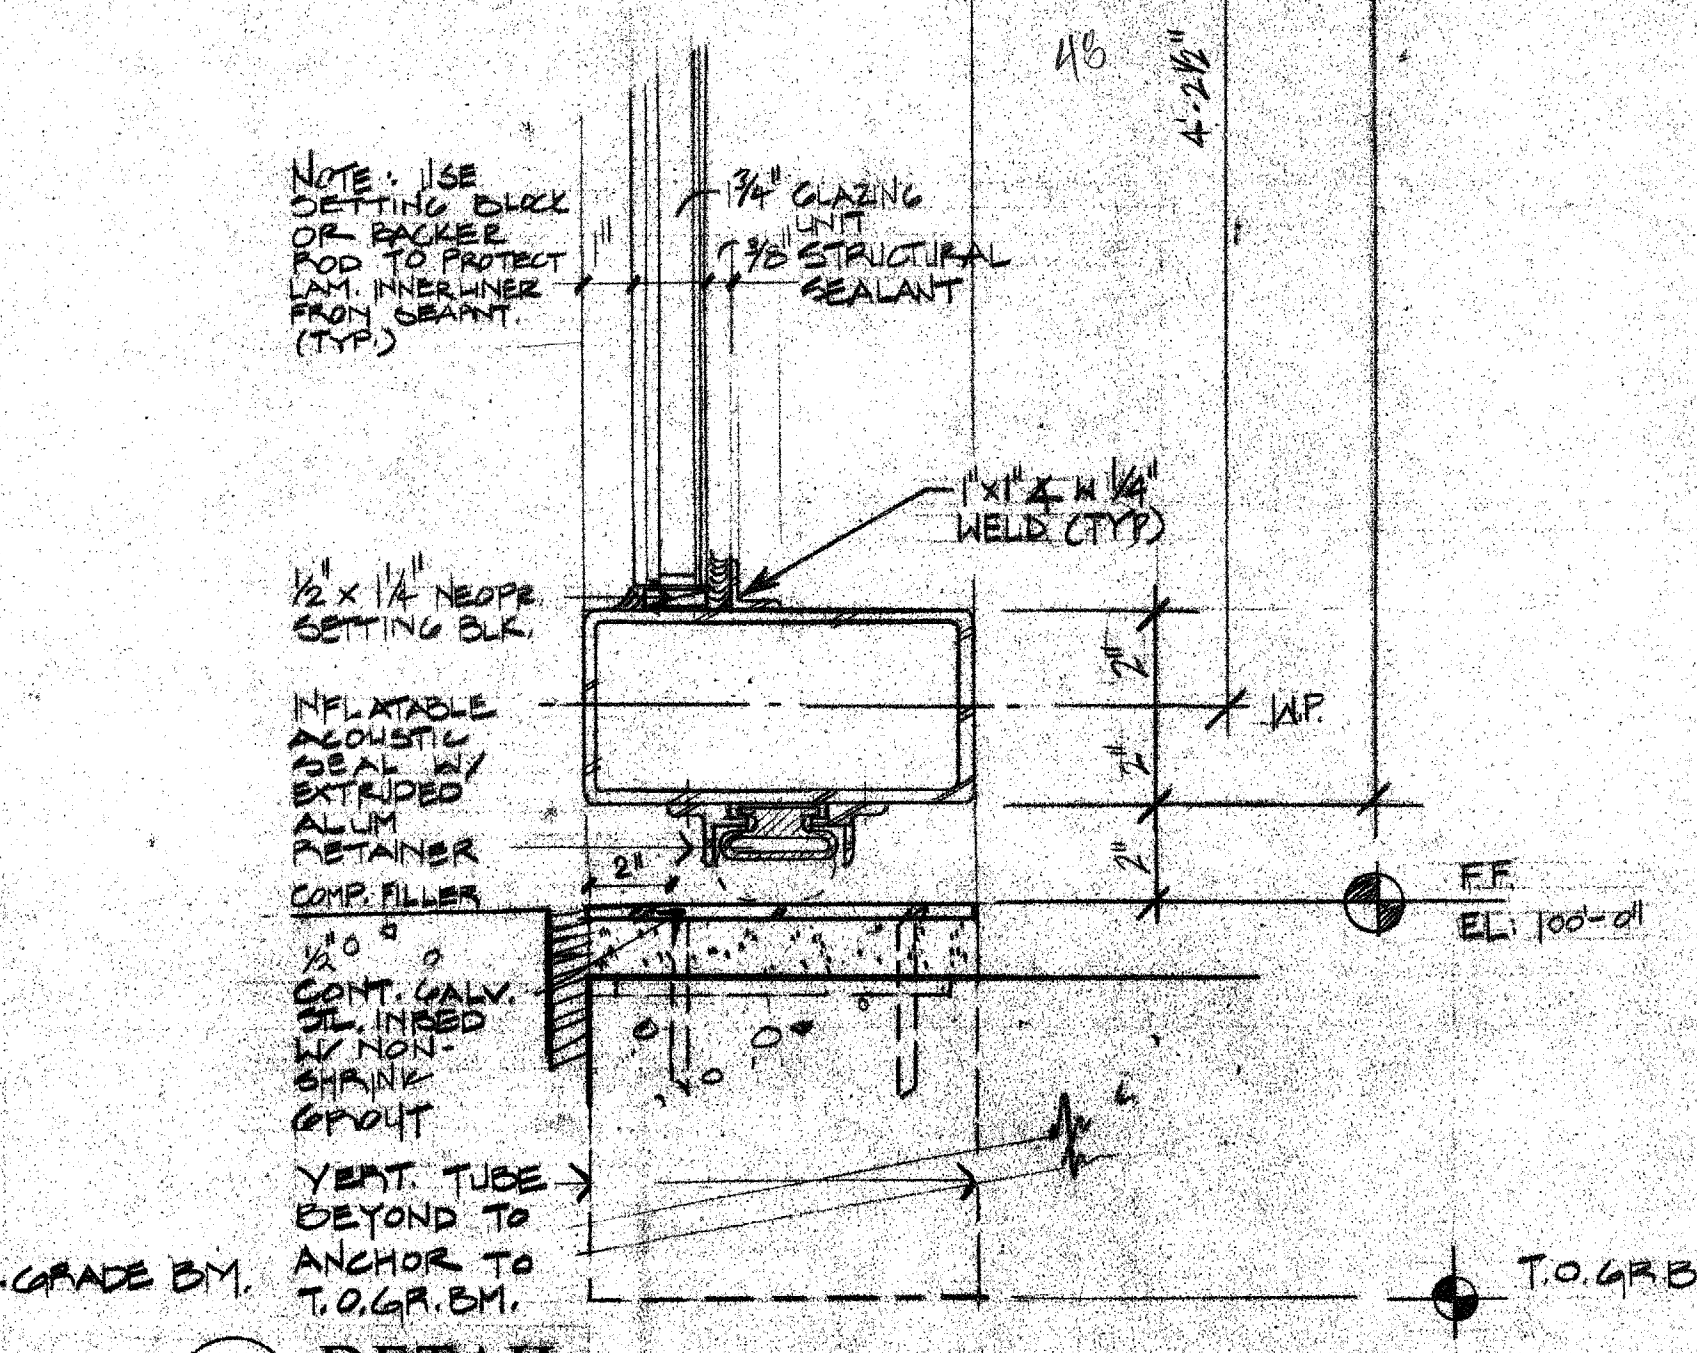

1 DETAIL 1/2" = 1'-0"



ACC ACT  
ADDISON

OWNER Town of Addison ARCHITECT Dunlap Architects 2700 Fairmont Dallas, Texas 75201 214-658-5272	LANDSCAPE The Kollens Group 307-76-4411 THEATRE CONSULTANT Theatre Projects 203-431-8949 INTERIOR CRSS 710-552-2000	STRUCTURAL Eller Turner 214-387-8393 MEP MEP Systems 214-754-4781 CIVIL Kurtz & Associates 214-650-3822	HISTORIAN Alan Mason 214-659-7382 LIGHTING Panella Hill Wilson 214-823-6542 GRAPHICS Motestral Design 214-954-8179
--	---	---	--

Issue	Category	Subcategory	Sheet
ISSUE FOR BID 8-17-00	4	9	14