




DETAIL

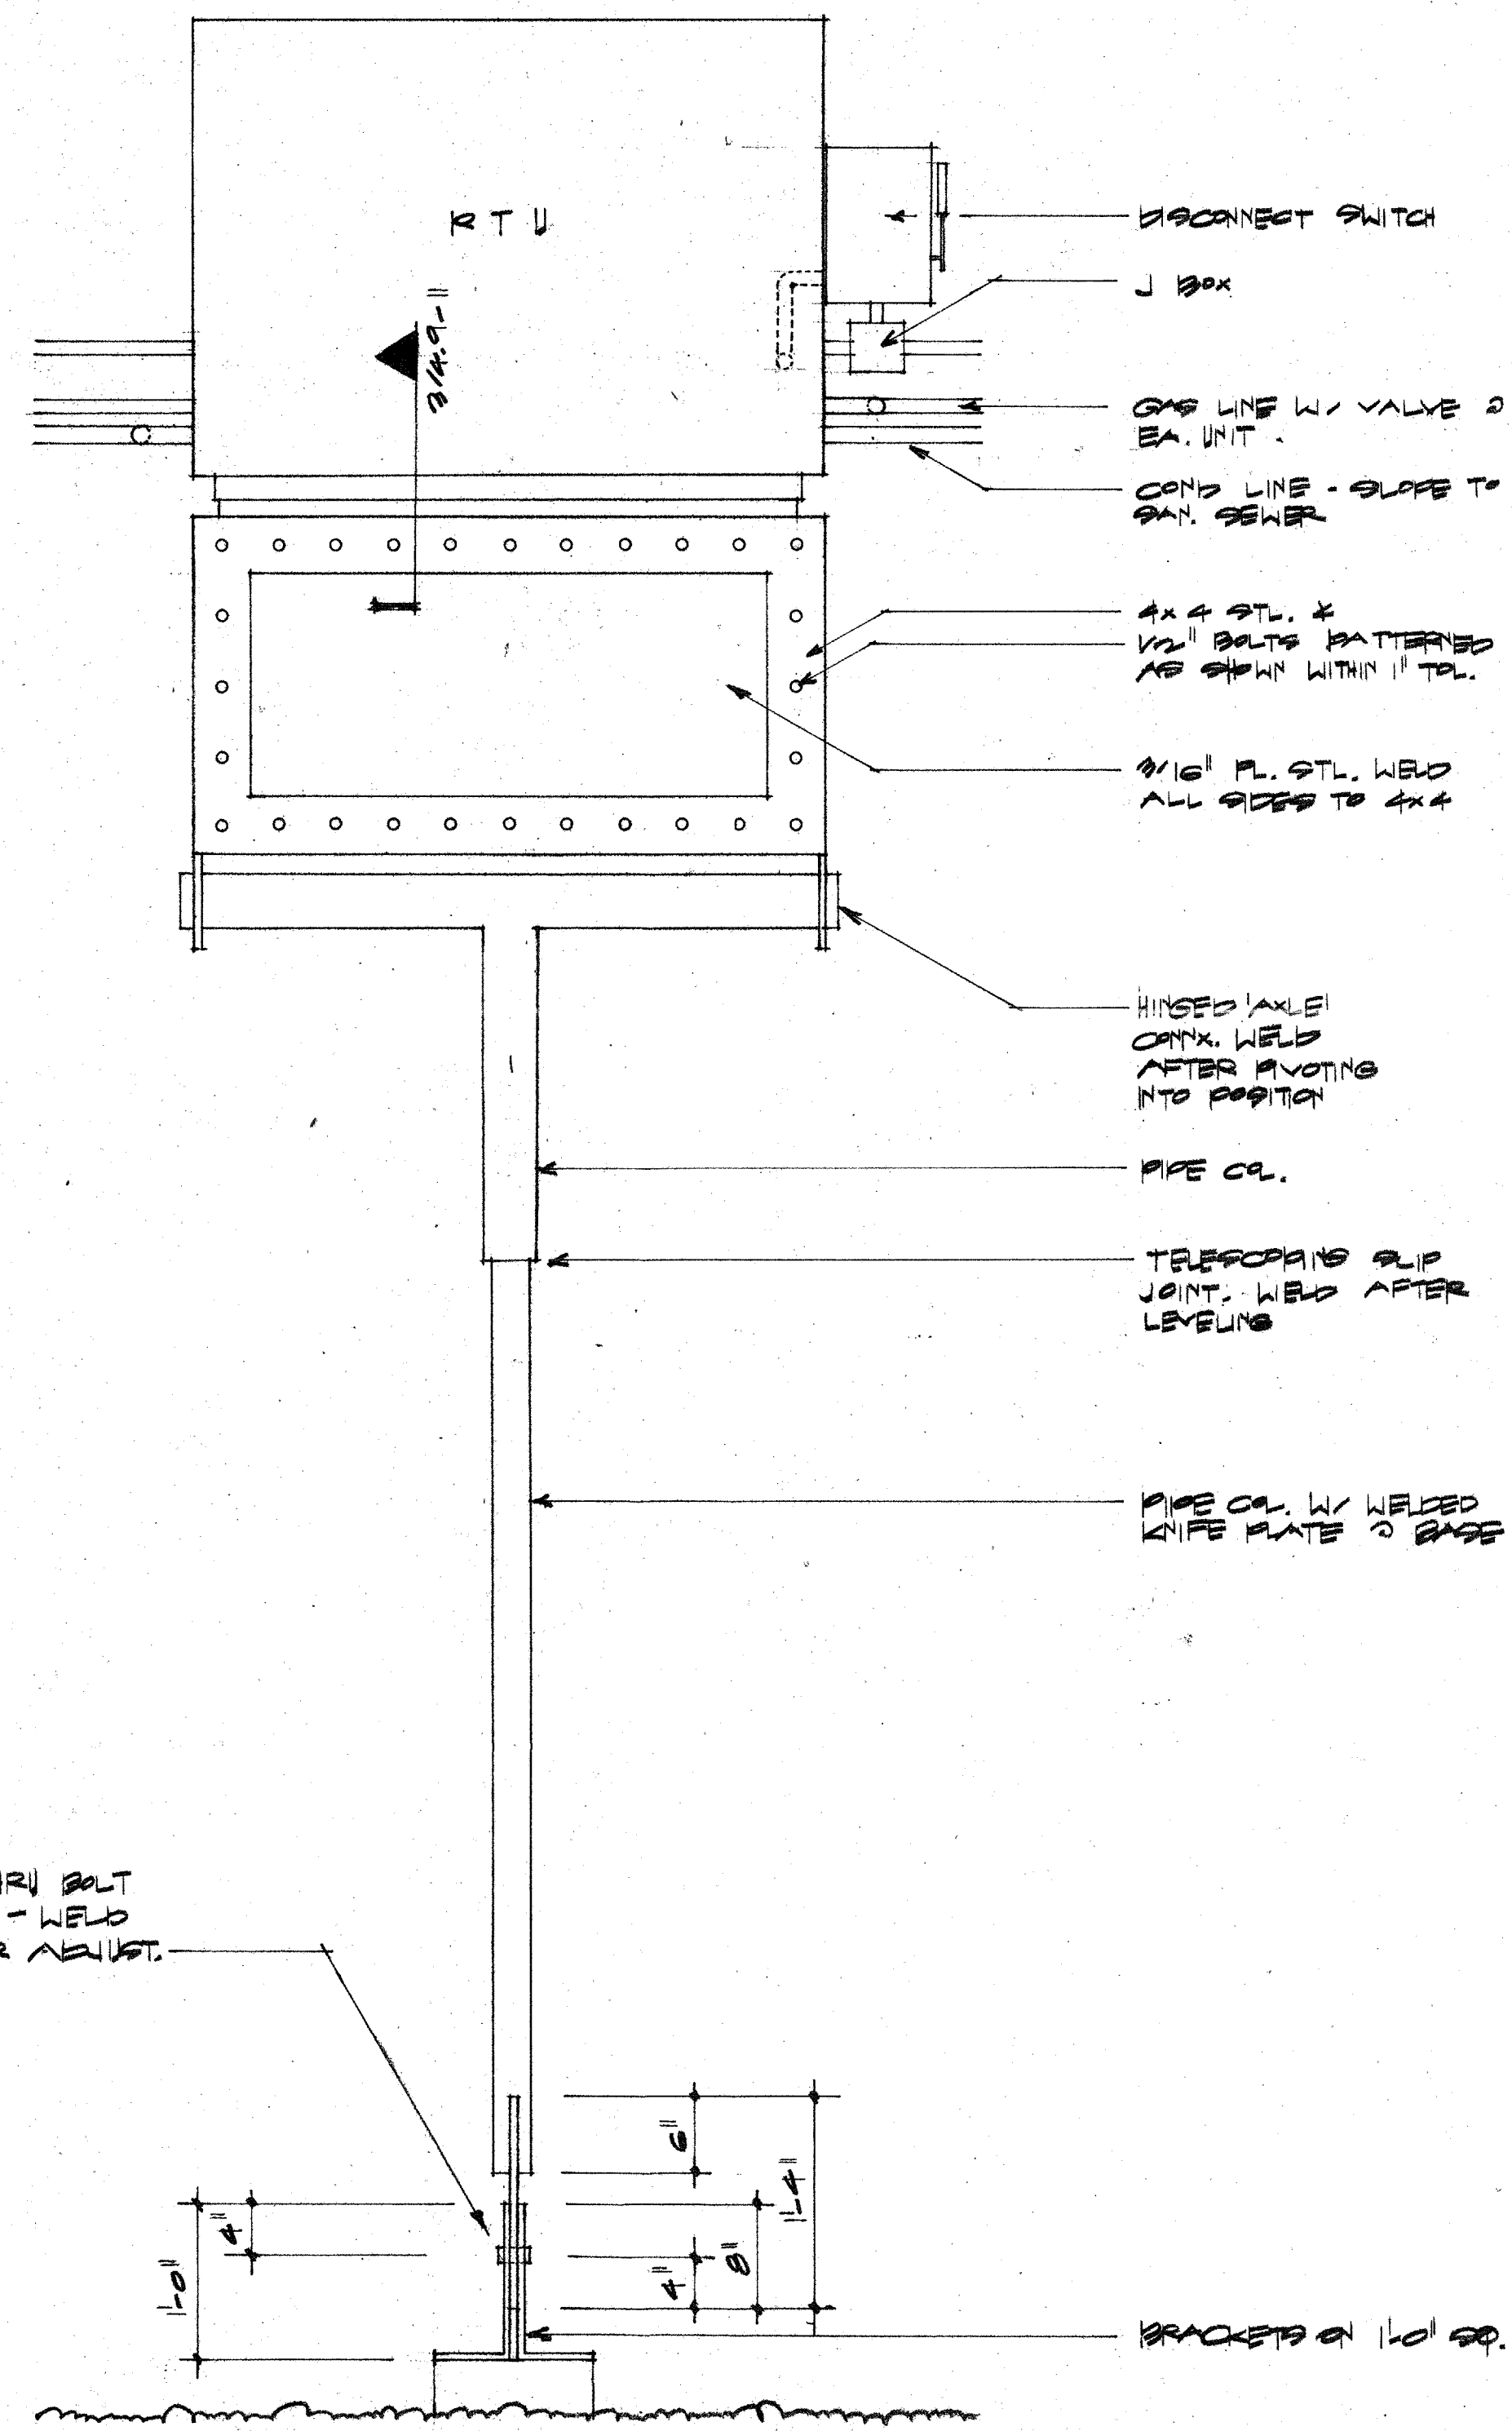

ELEVATION  
1" = 1/2"

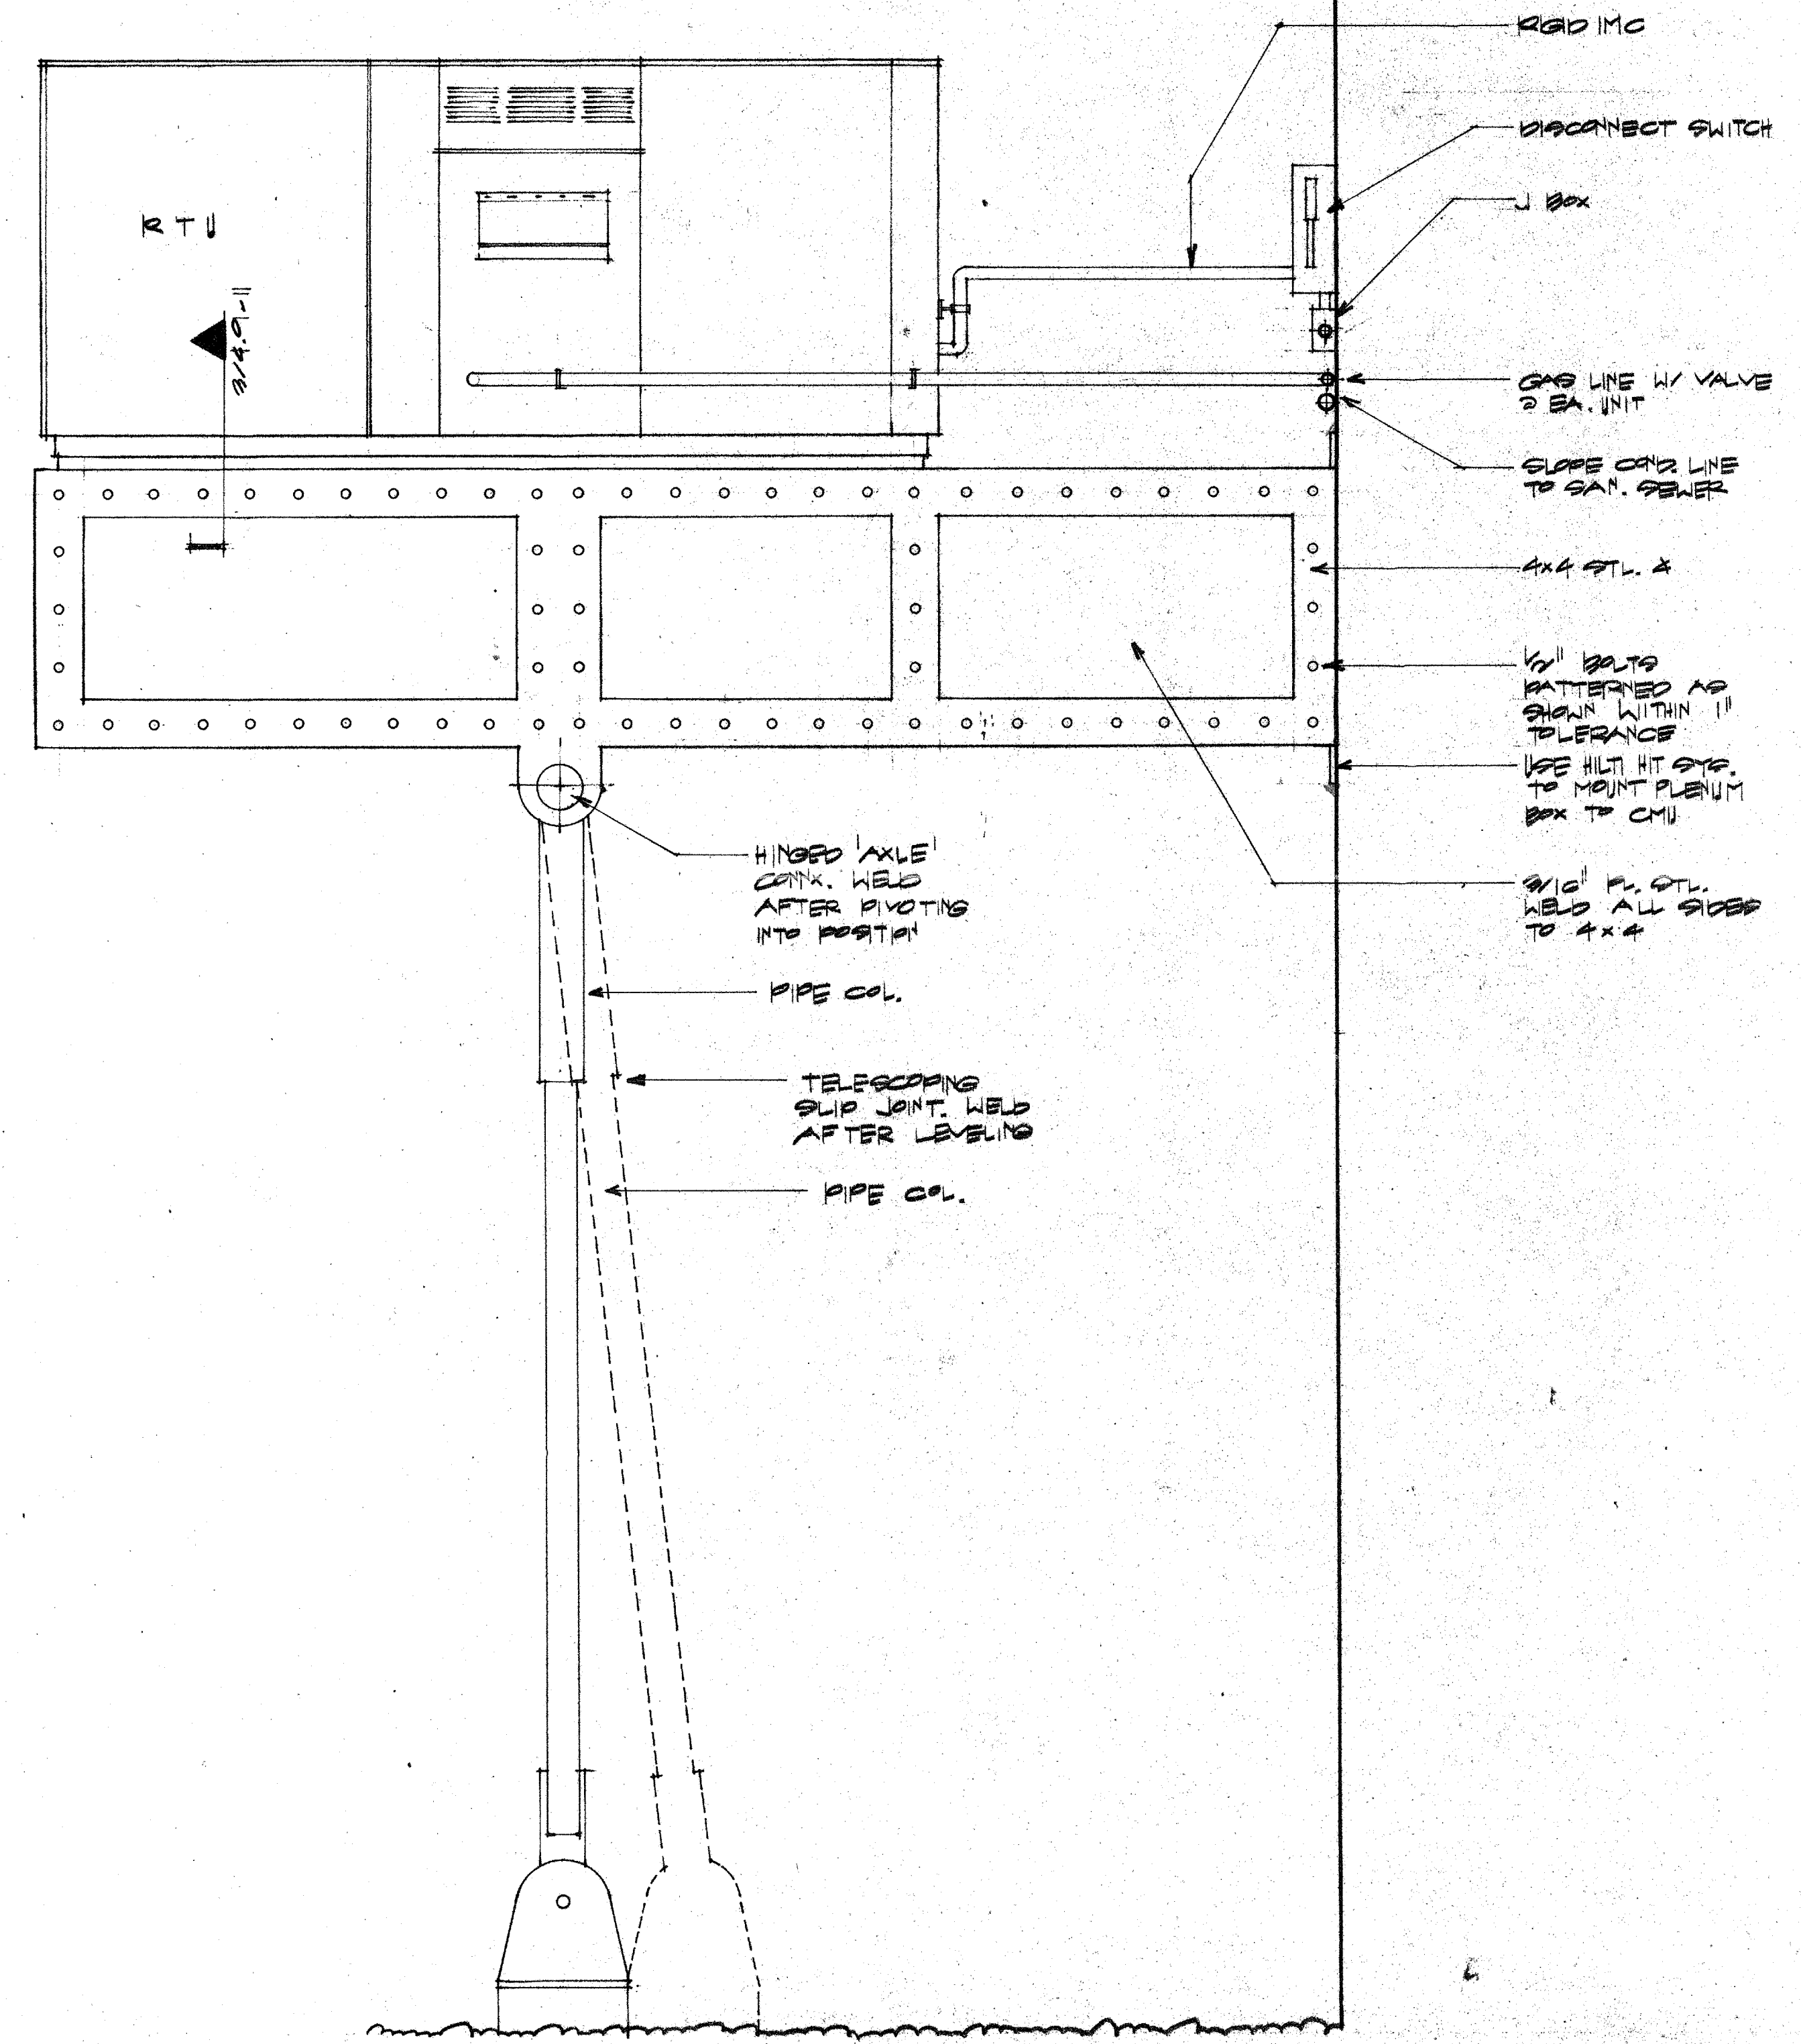

ELEVATION  
1/2" = 1/2"

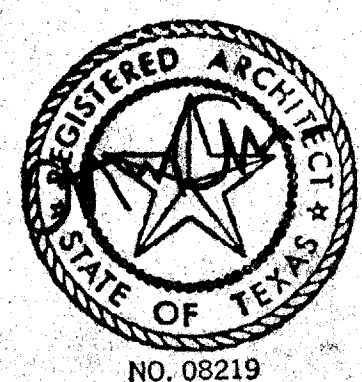

ACC ADDISON ACT

OWNER	LANDSCAPE	STRUCTURAL	HISTORIAN	Issue	Cate_ory	Subcategory	Sheet
Town of Addison	The Kellams Group 317-776-1417	Ellisor Tanner 214-387-8393	Alan Mason 214-891-782	ISSUE FOR BID 8-17-90	4	9	11
ARCHITECT	MEP CONSULTANT	M.E.P.	LIGHTING				
Cannighan Architects 2700 Fairmount Dallas, Texas 75201 214-855-5272	Theatre Projects 203-431-3949 214-855-5272	Theatre Systems 214-754-4741	Panela Hull Wilson 214-823-6542				
	INTERIORS	CIVIL	GRAPHICS				
	CRSS 713-552-2000	Kurtz & Associates 214-680-3322	Notestad Design 214-954-9779				