




4 DETAIL 3/8"=1'-0"

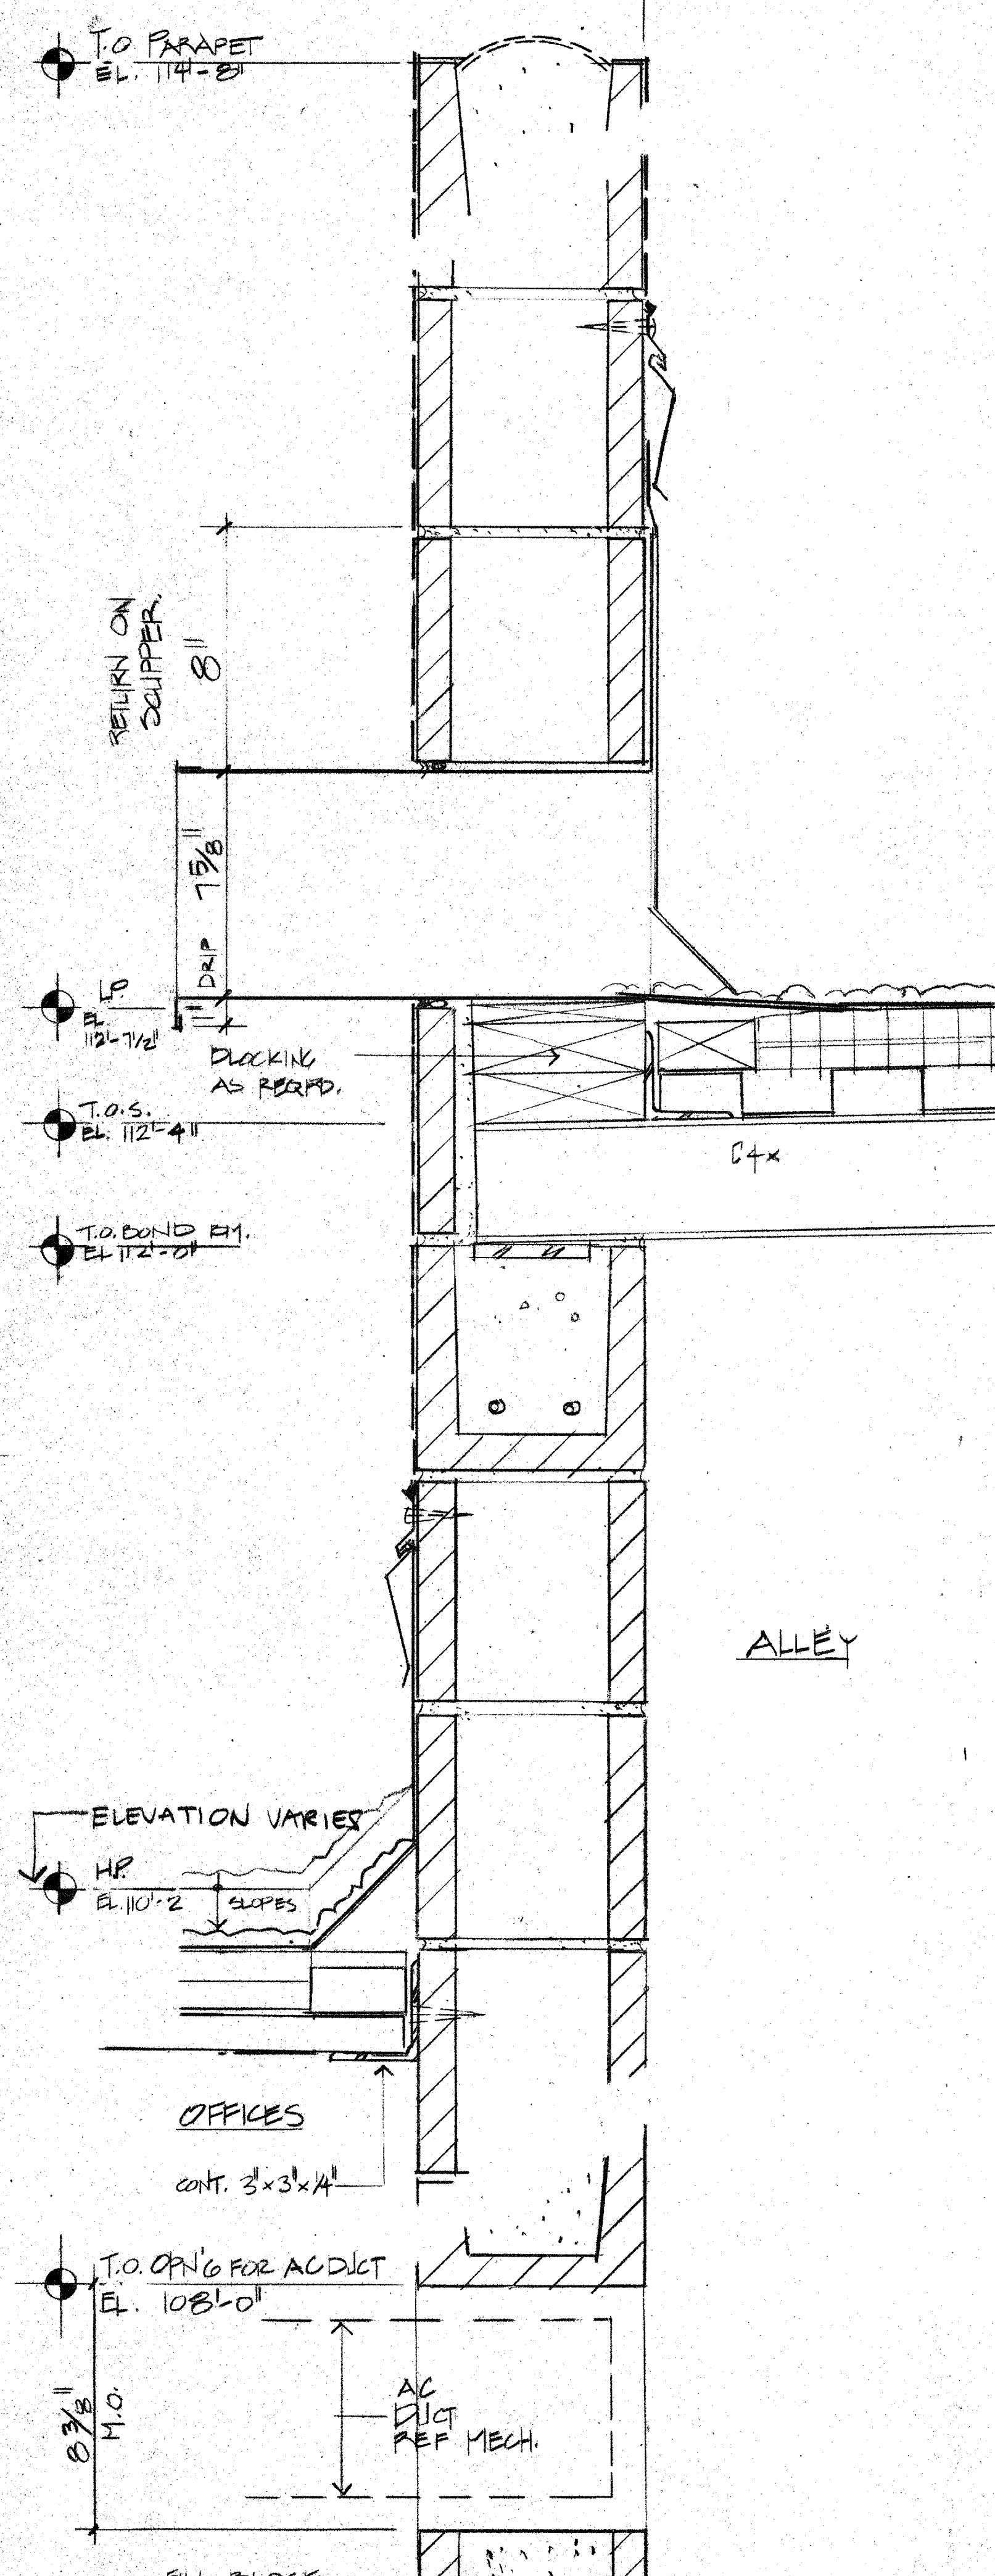


3 DETAIL 3/8"=1'-0"

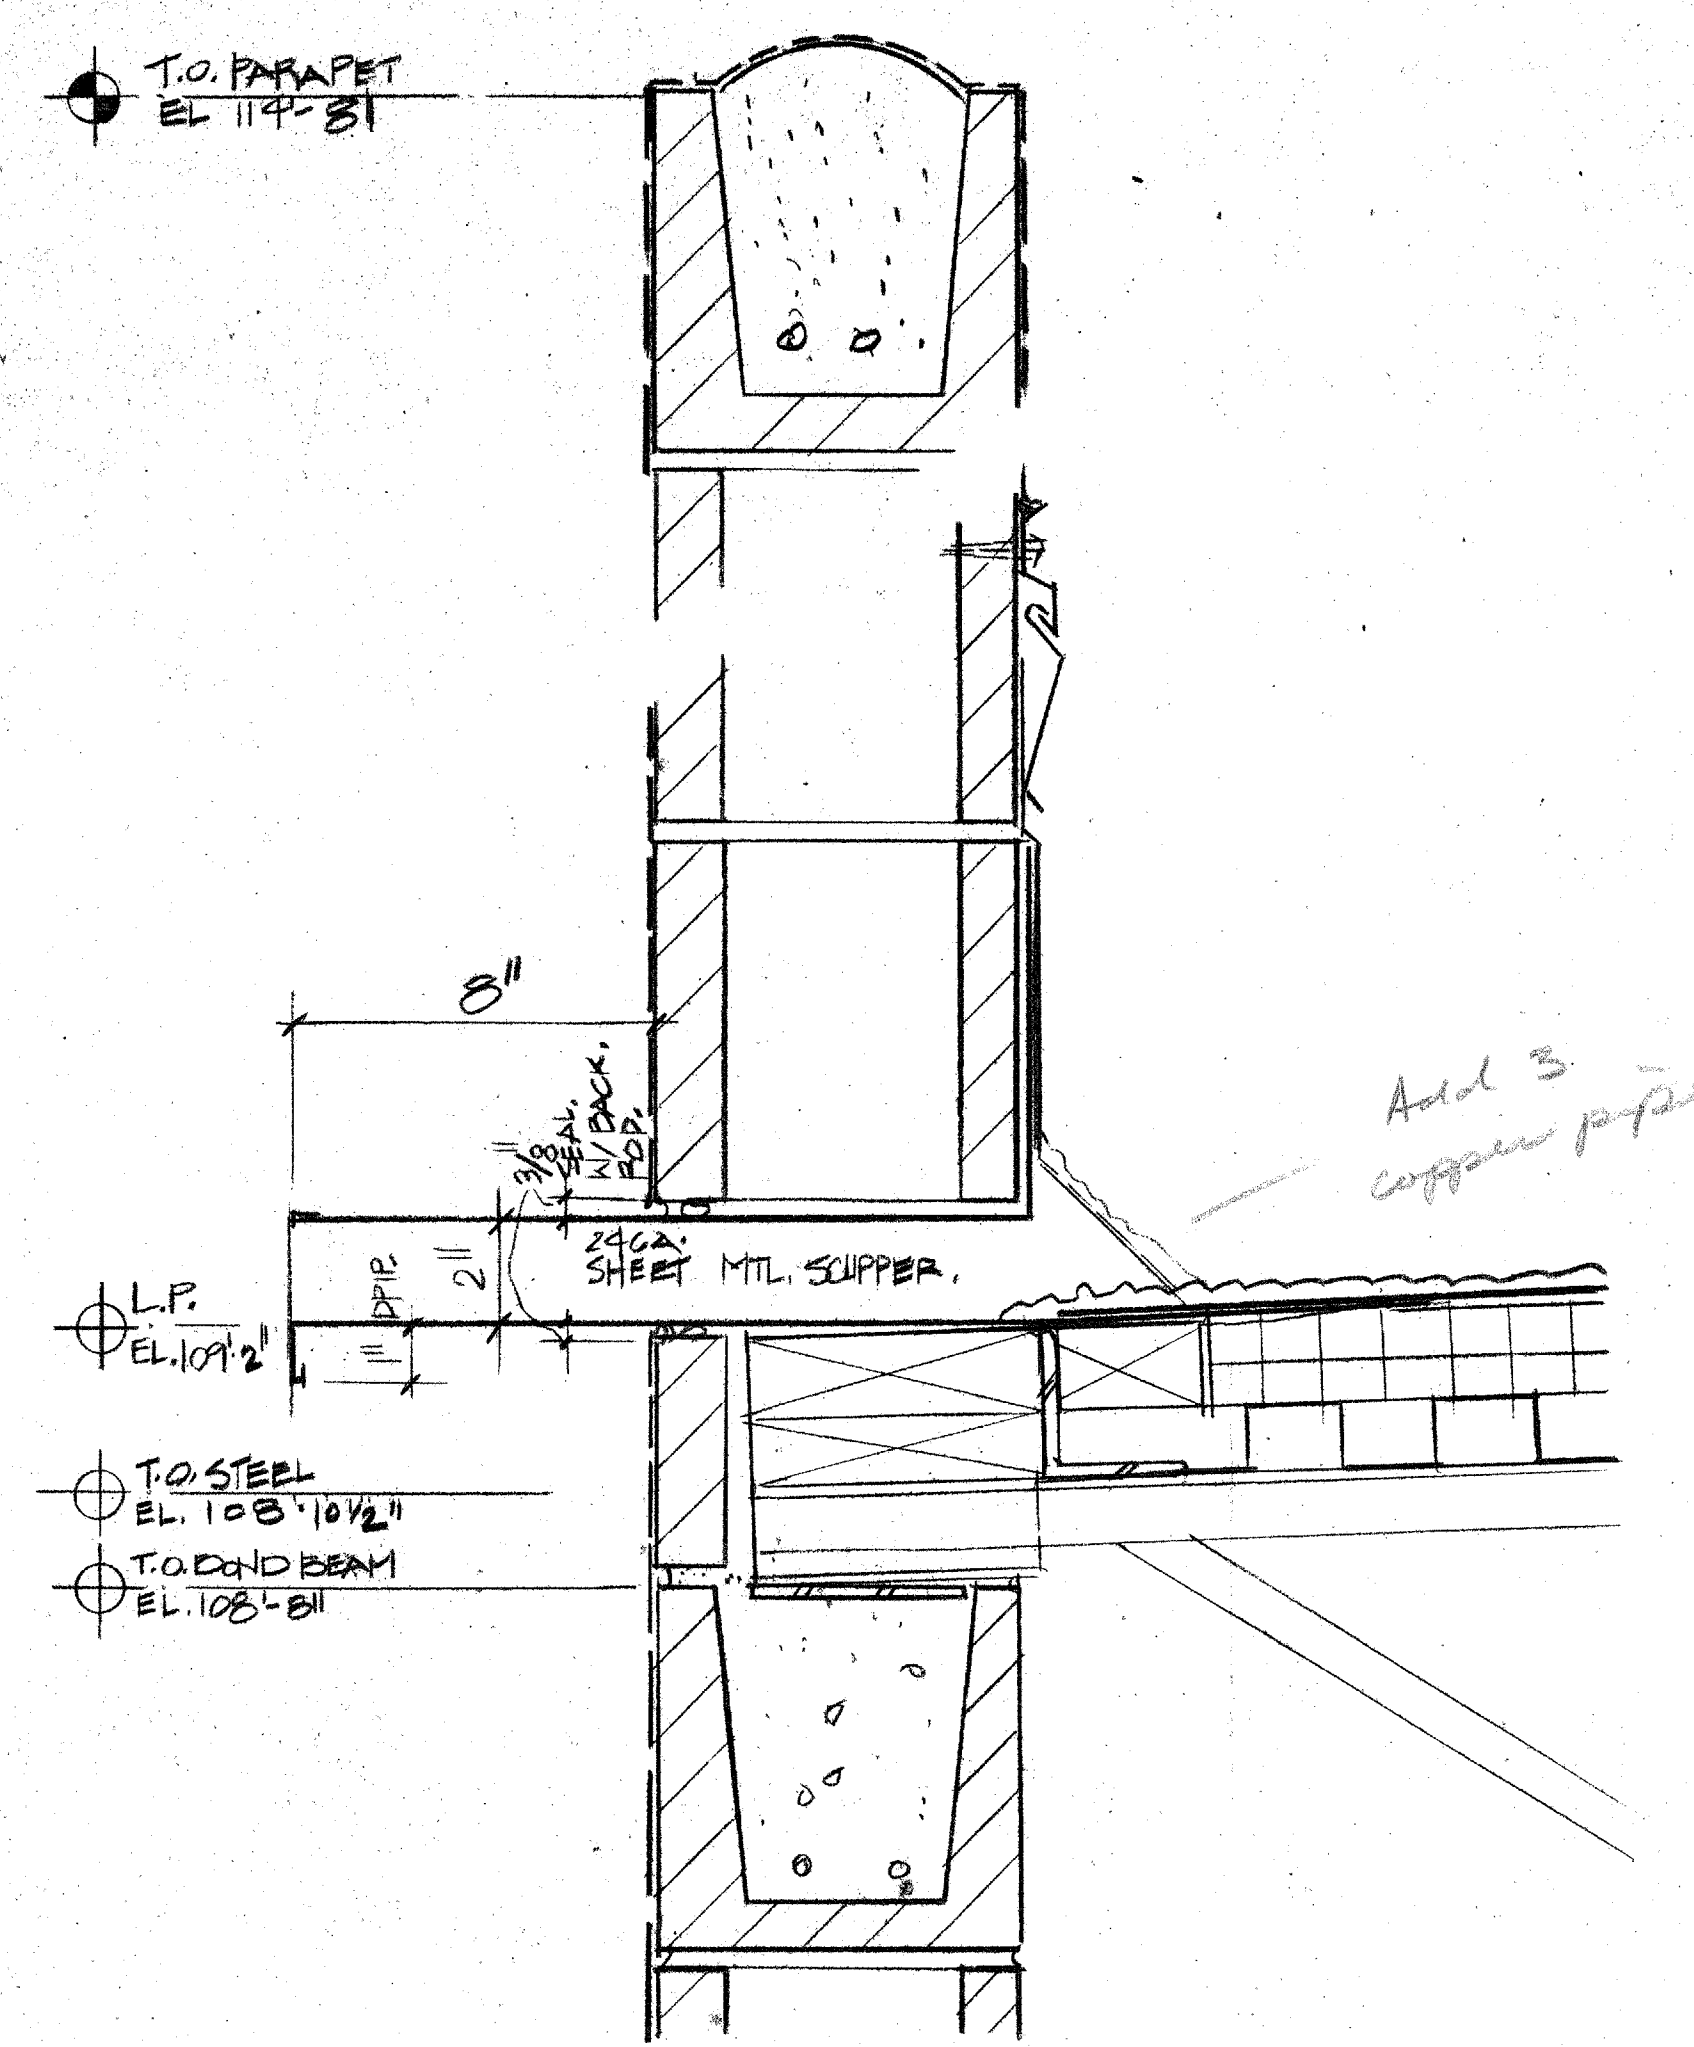


6 DETAIL 3/8"=1'-0"

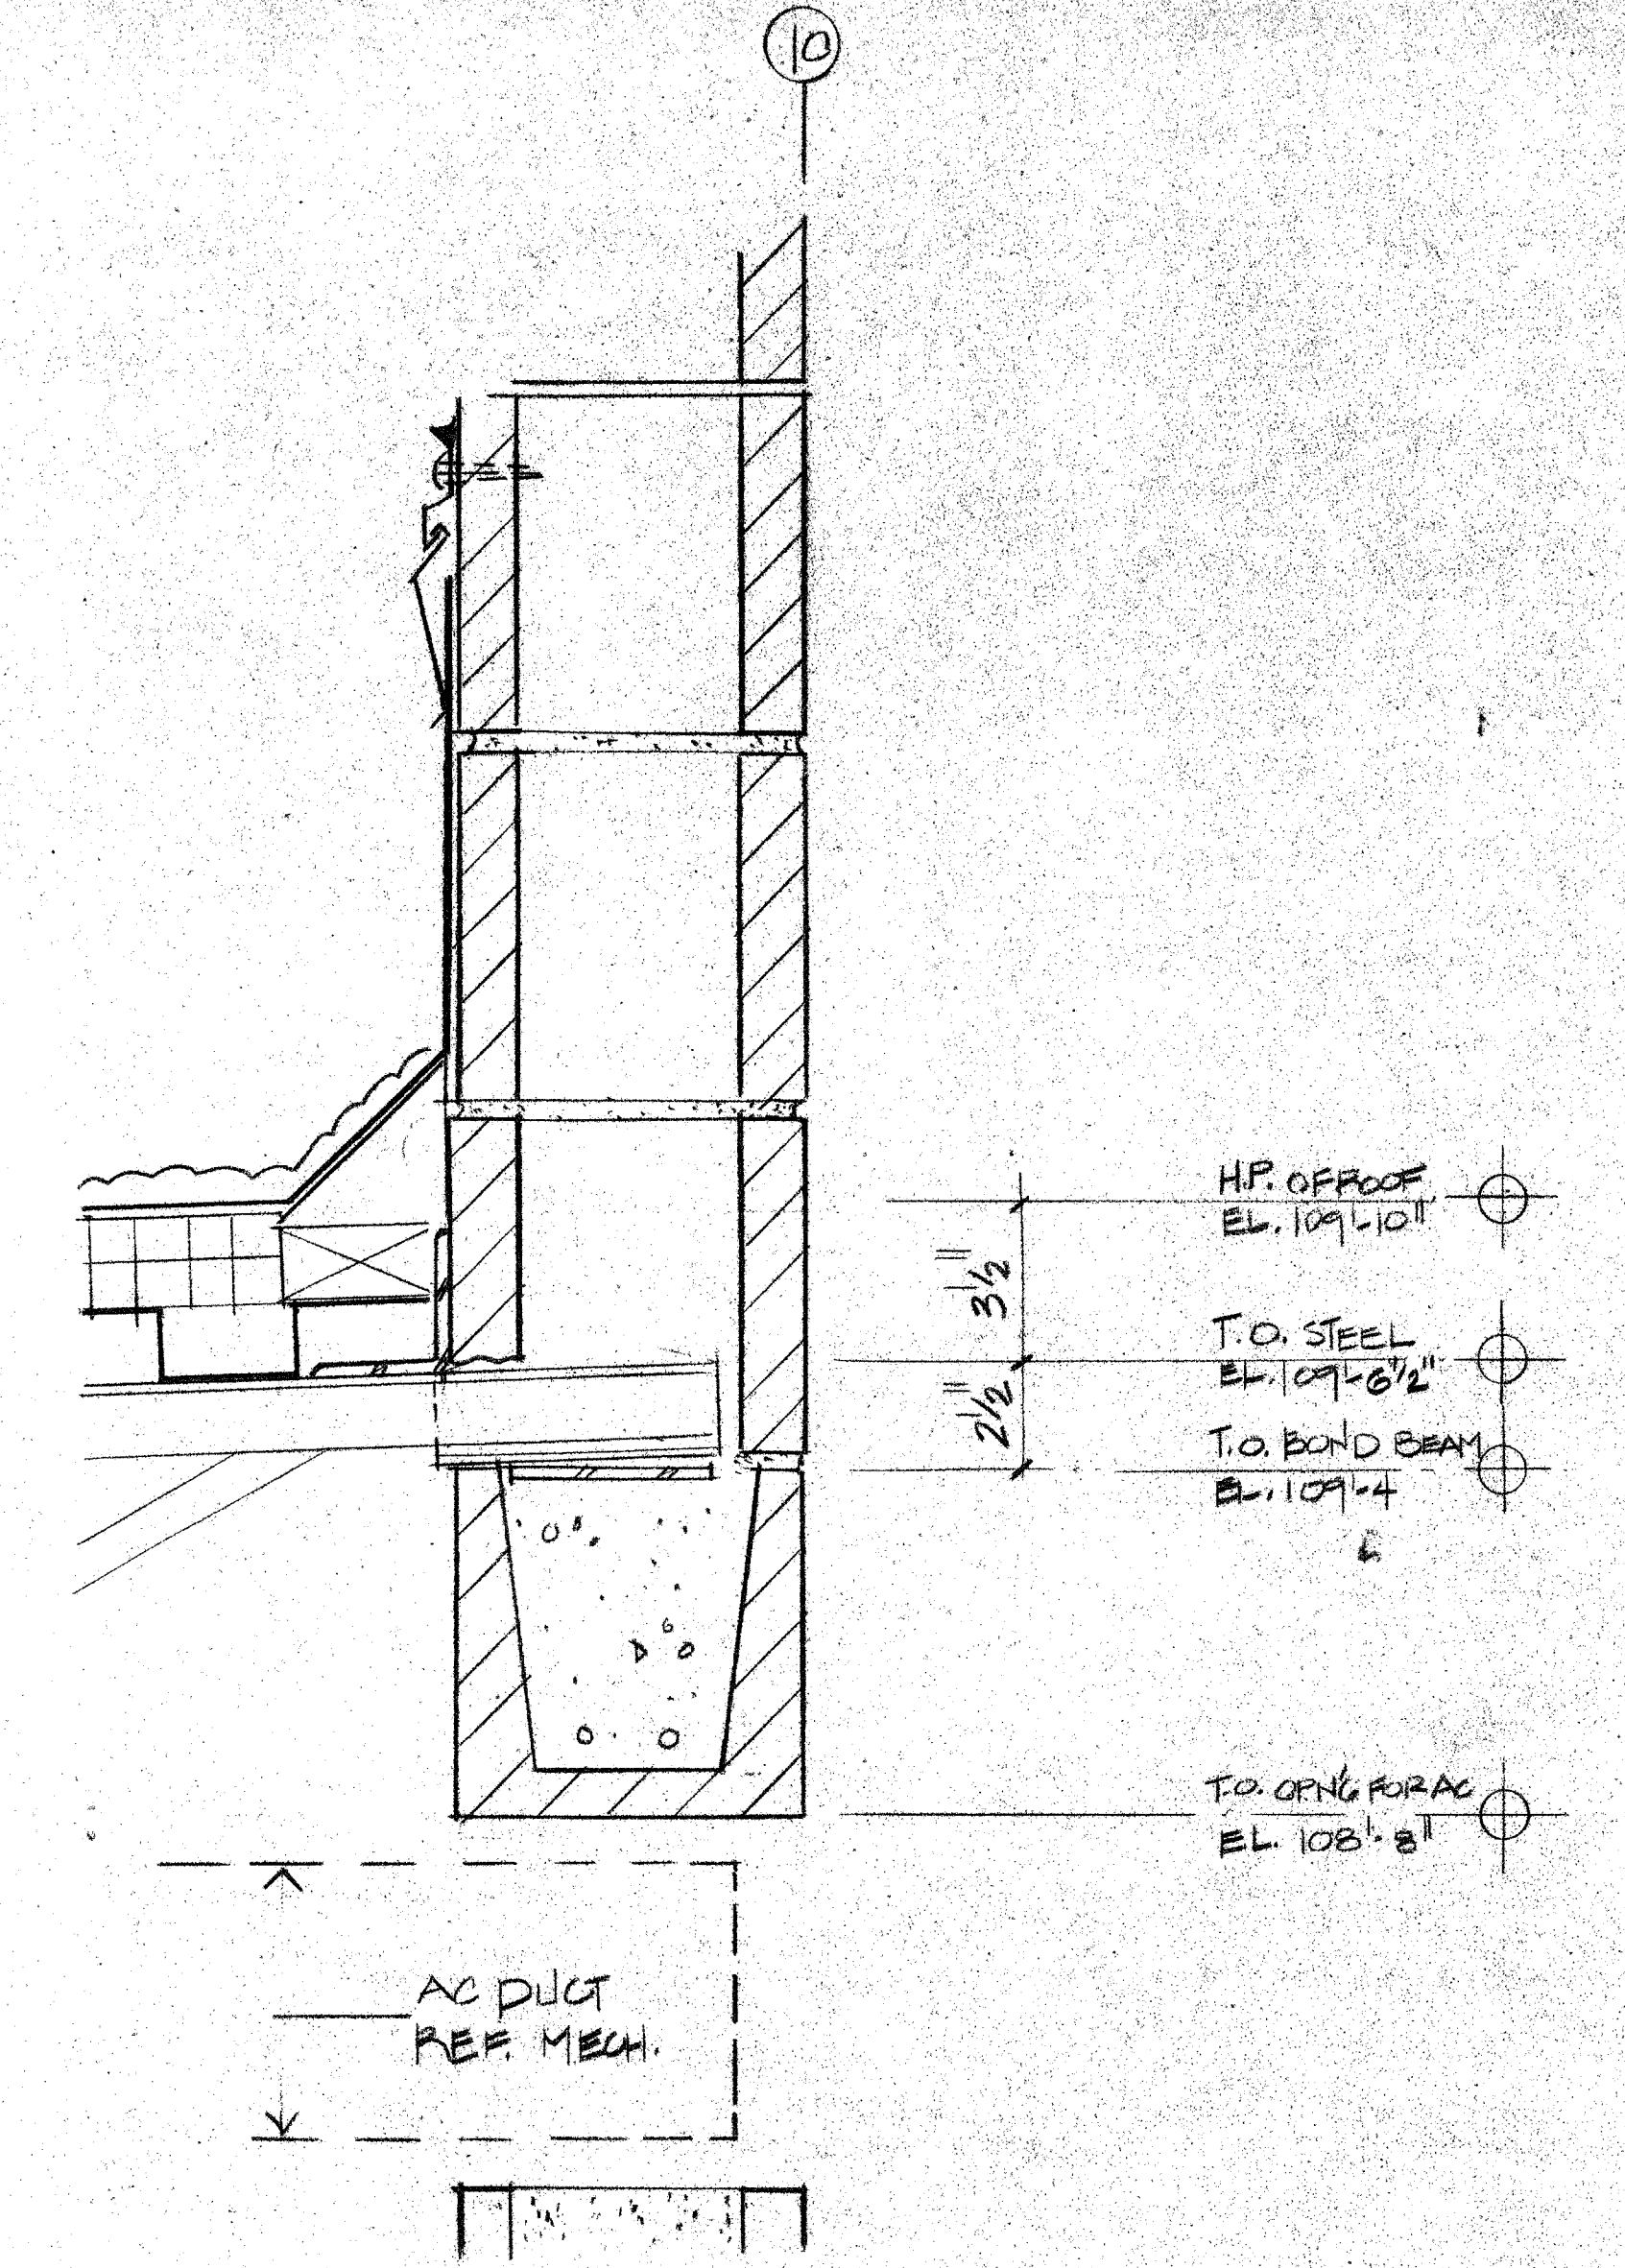

5 DETAIL 3/8"=1'-0"

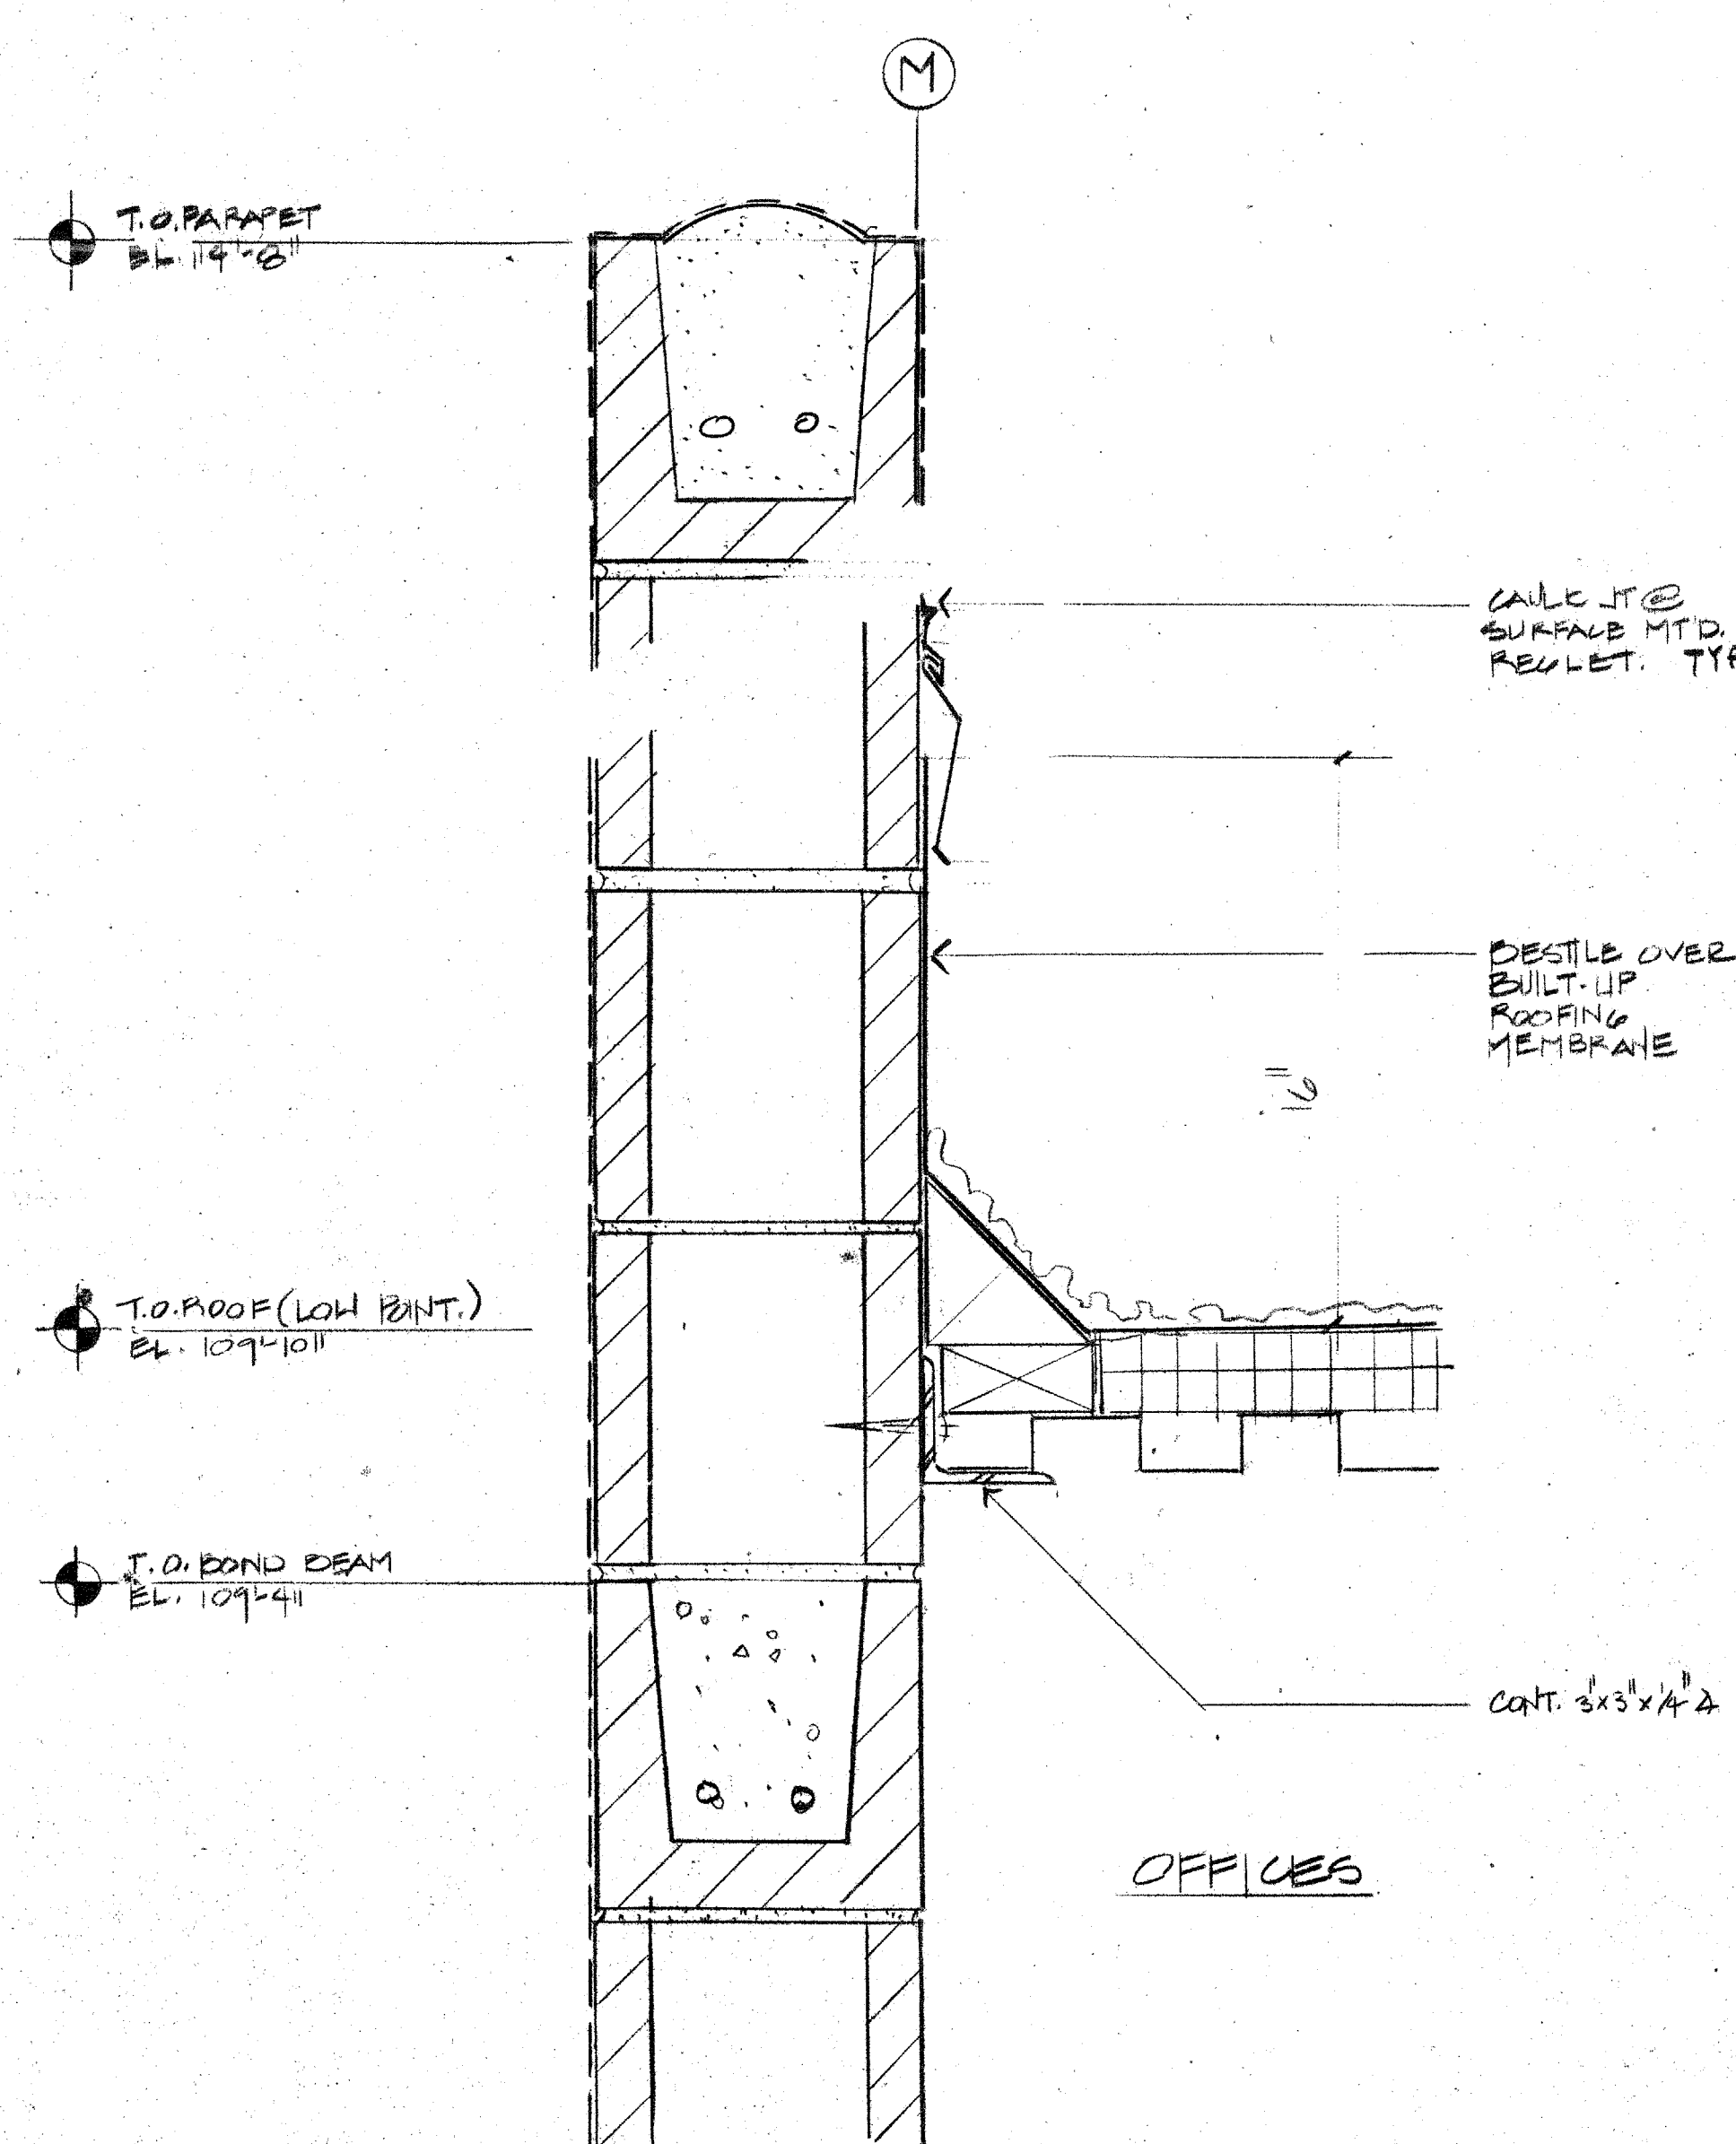

2 DETAIL 3/8"=1'-0"

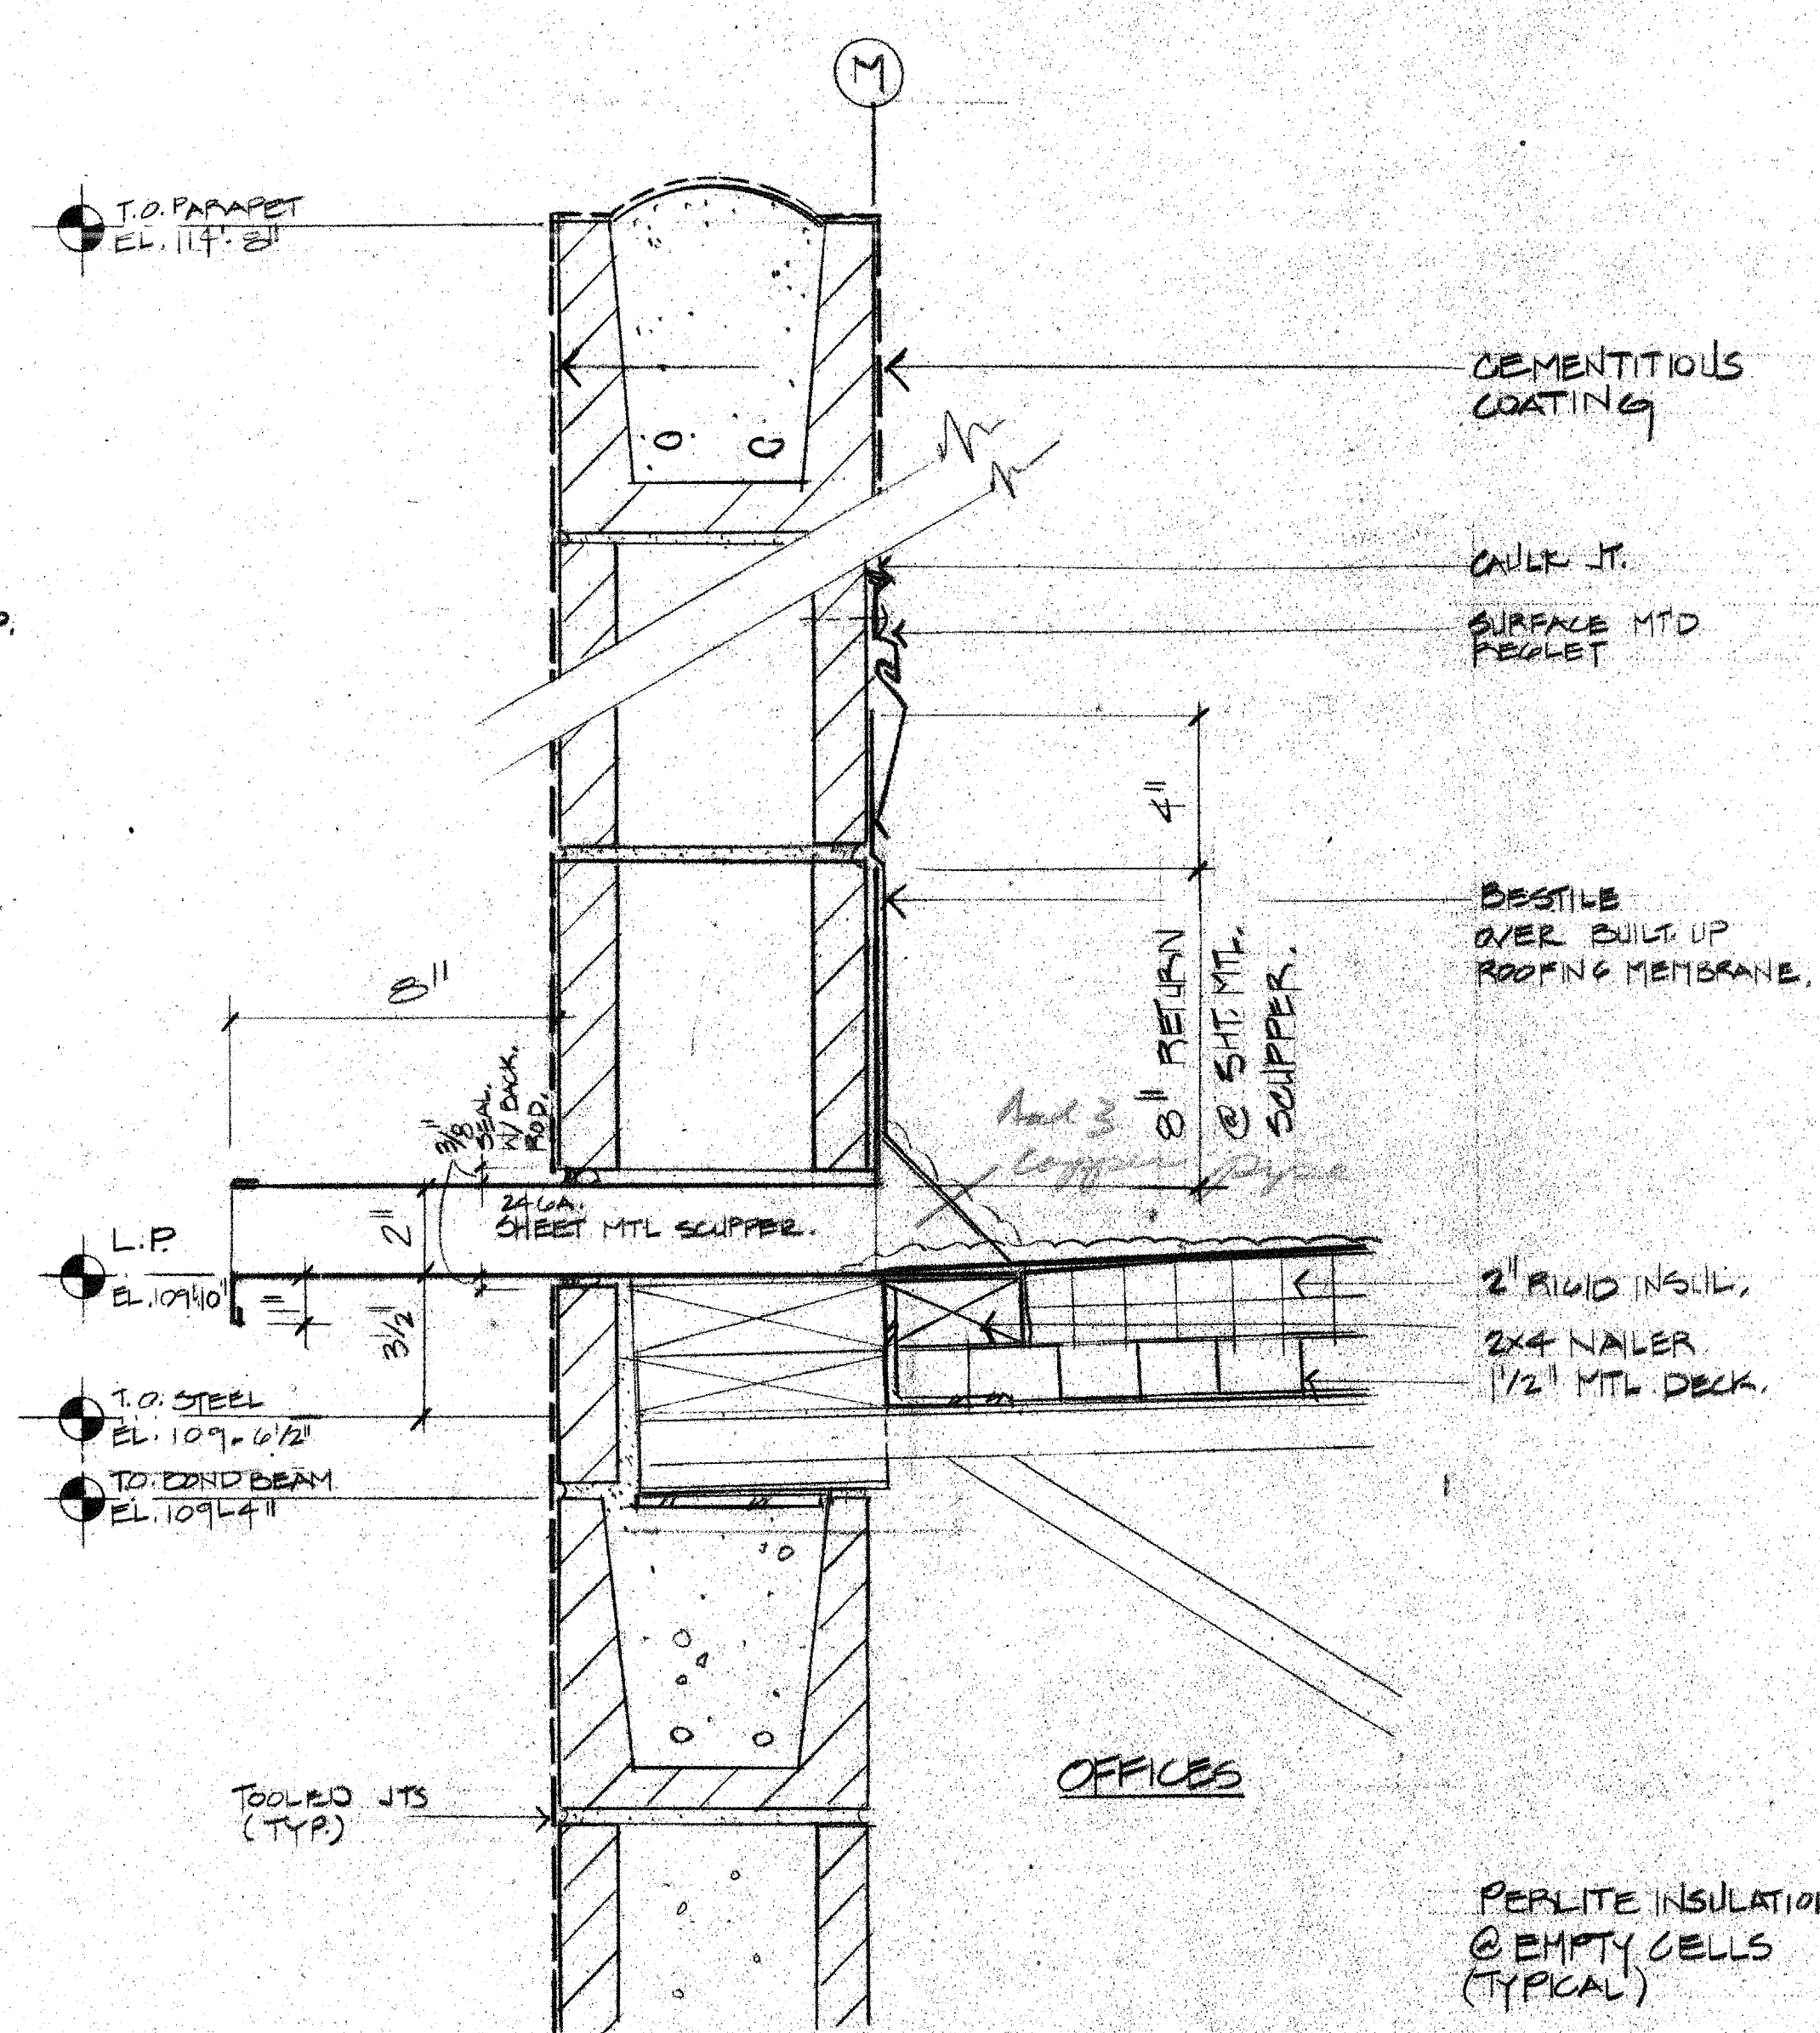

1 DETAIL 3/8"=1'-0"



ACC ACT
ADDISON

OWNER	LANDSCAPE	STRUCTURAL	HISTORIAN	Issue	Category	Subcategory	Sheet
The Kallans Group 312-778-1417	Alan Mason 24-887-8353	Alan Mason 24-887-8353	Alan Mason 24-887-8353	ISSUE FOR BID 8-17-90			4
ARCHITECT Connelligan Architects 2700 Fairmount Dallas, Texas 75201 214-855-5272	THEATRE CONSULTANT Theatre Projects 203-431-8949	M.E.P. MEP Systems 241-754-4741	LIGHTING Pamela Hall Wilson 241-823-8542				9
INTERIORS CRS 75-582-2000	CIVIL Kurtz & Associates 241-880-3322	GRAPHICS Northstar Design 241-854-9578					10