




1 DETAIL

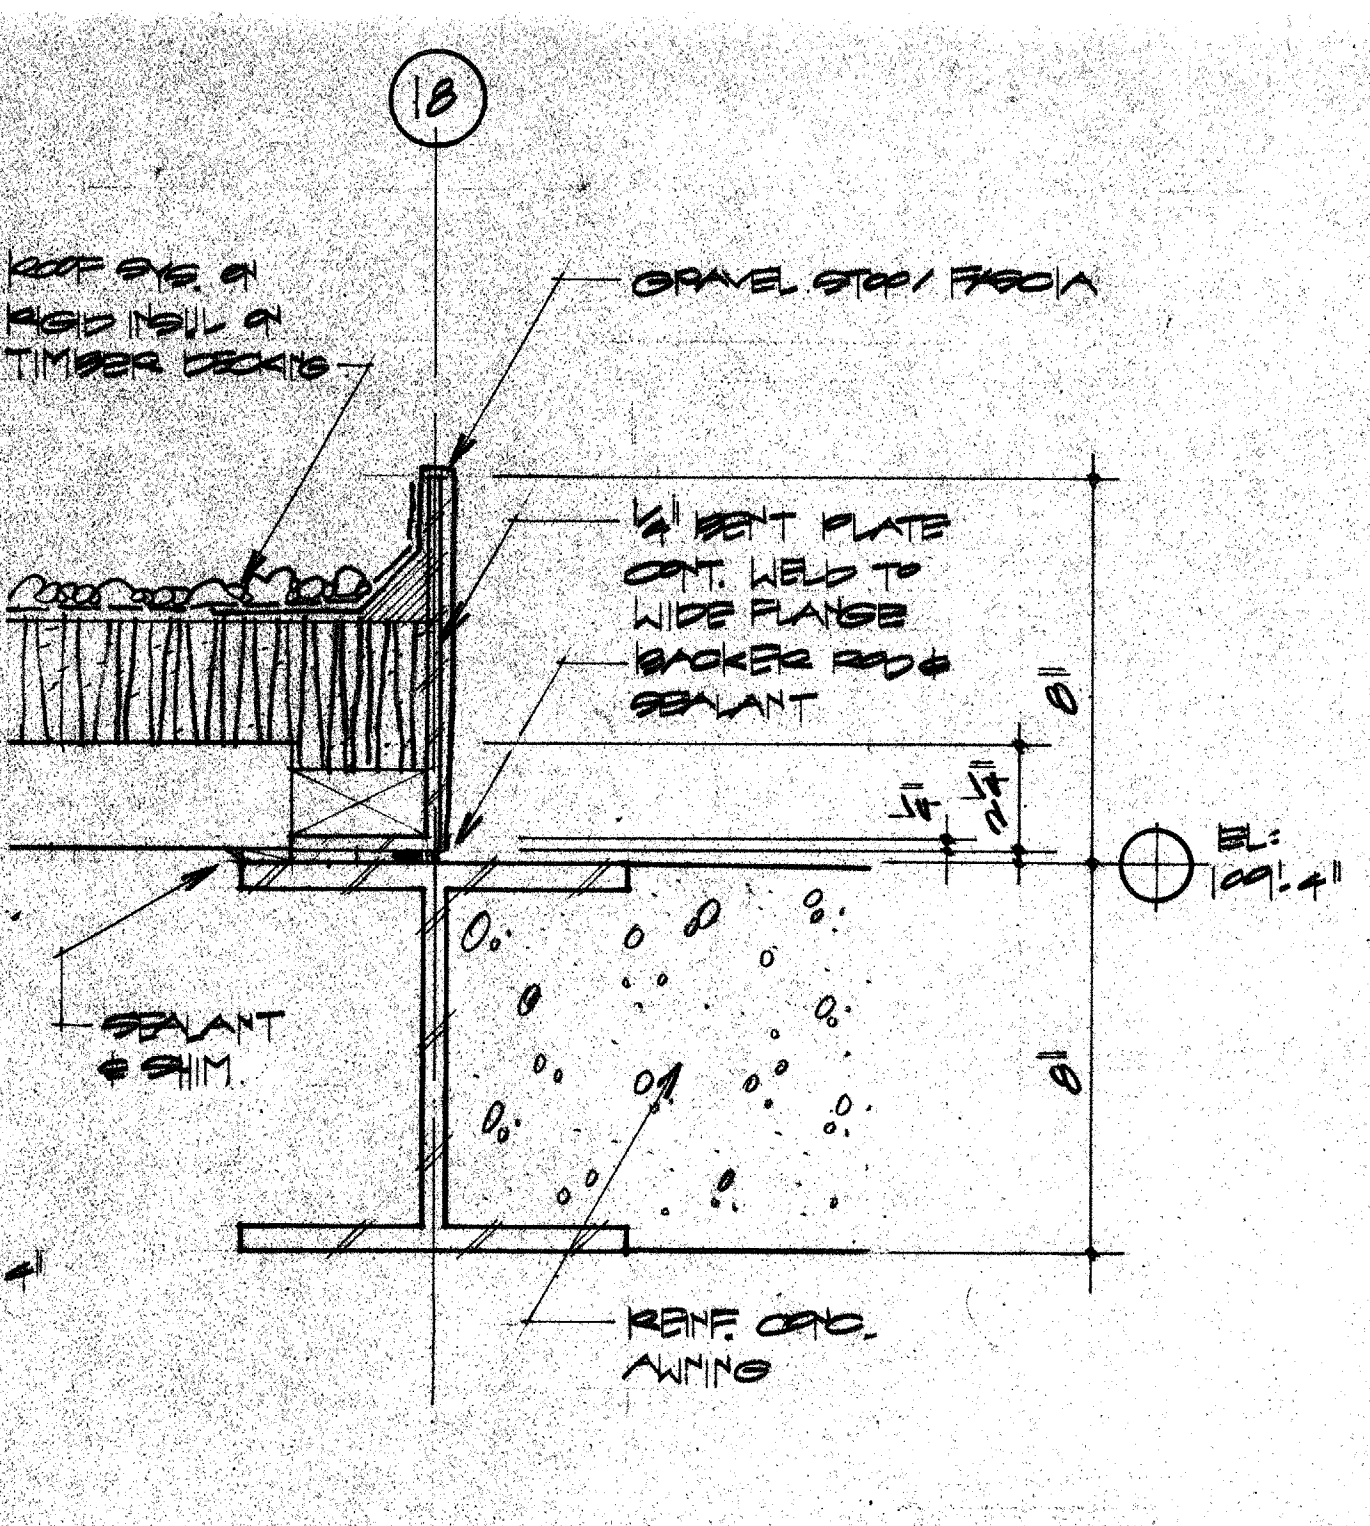


2 DETAIL

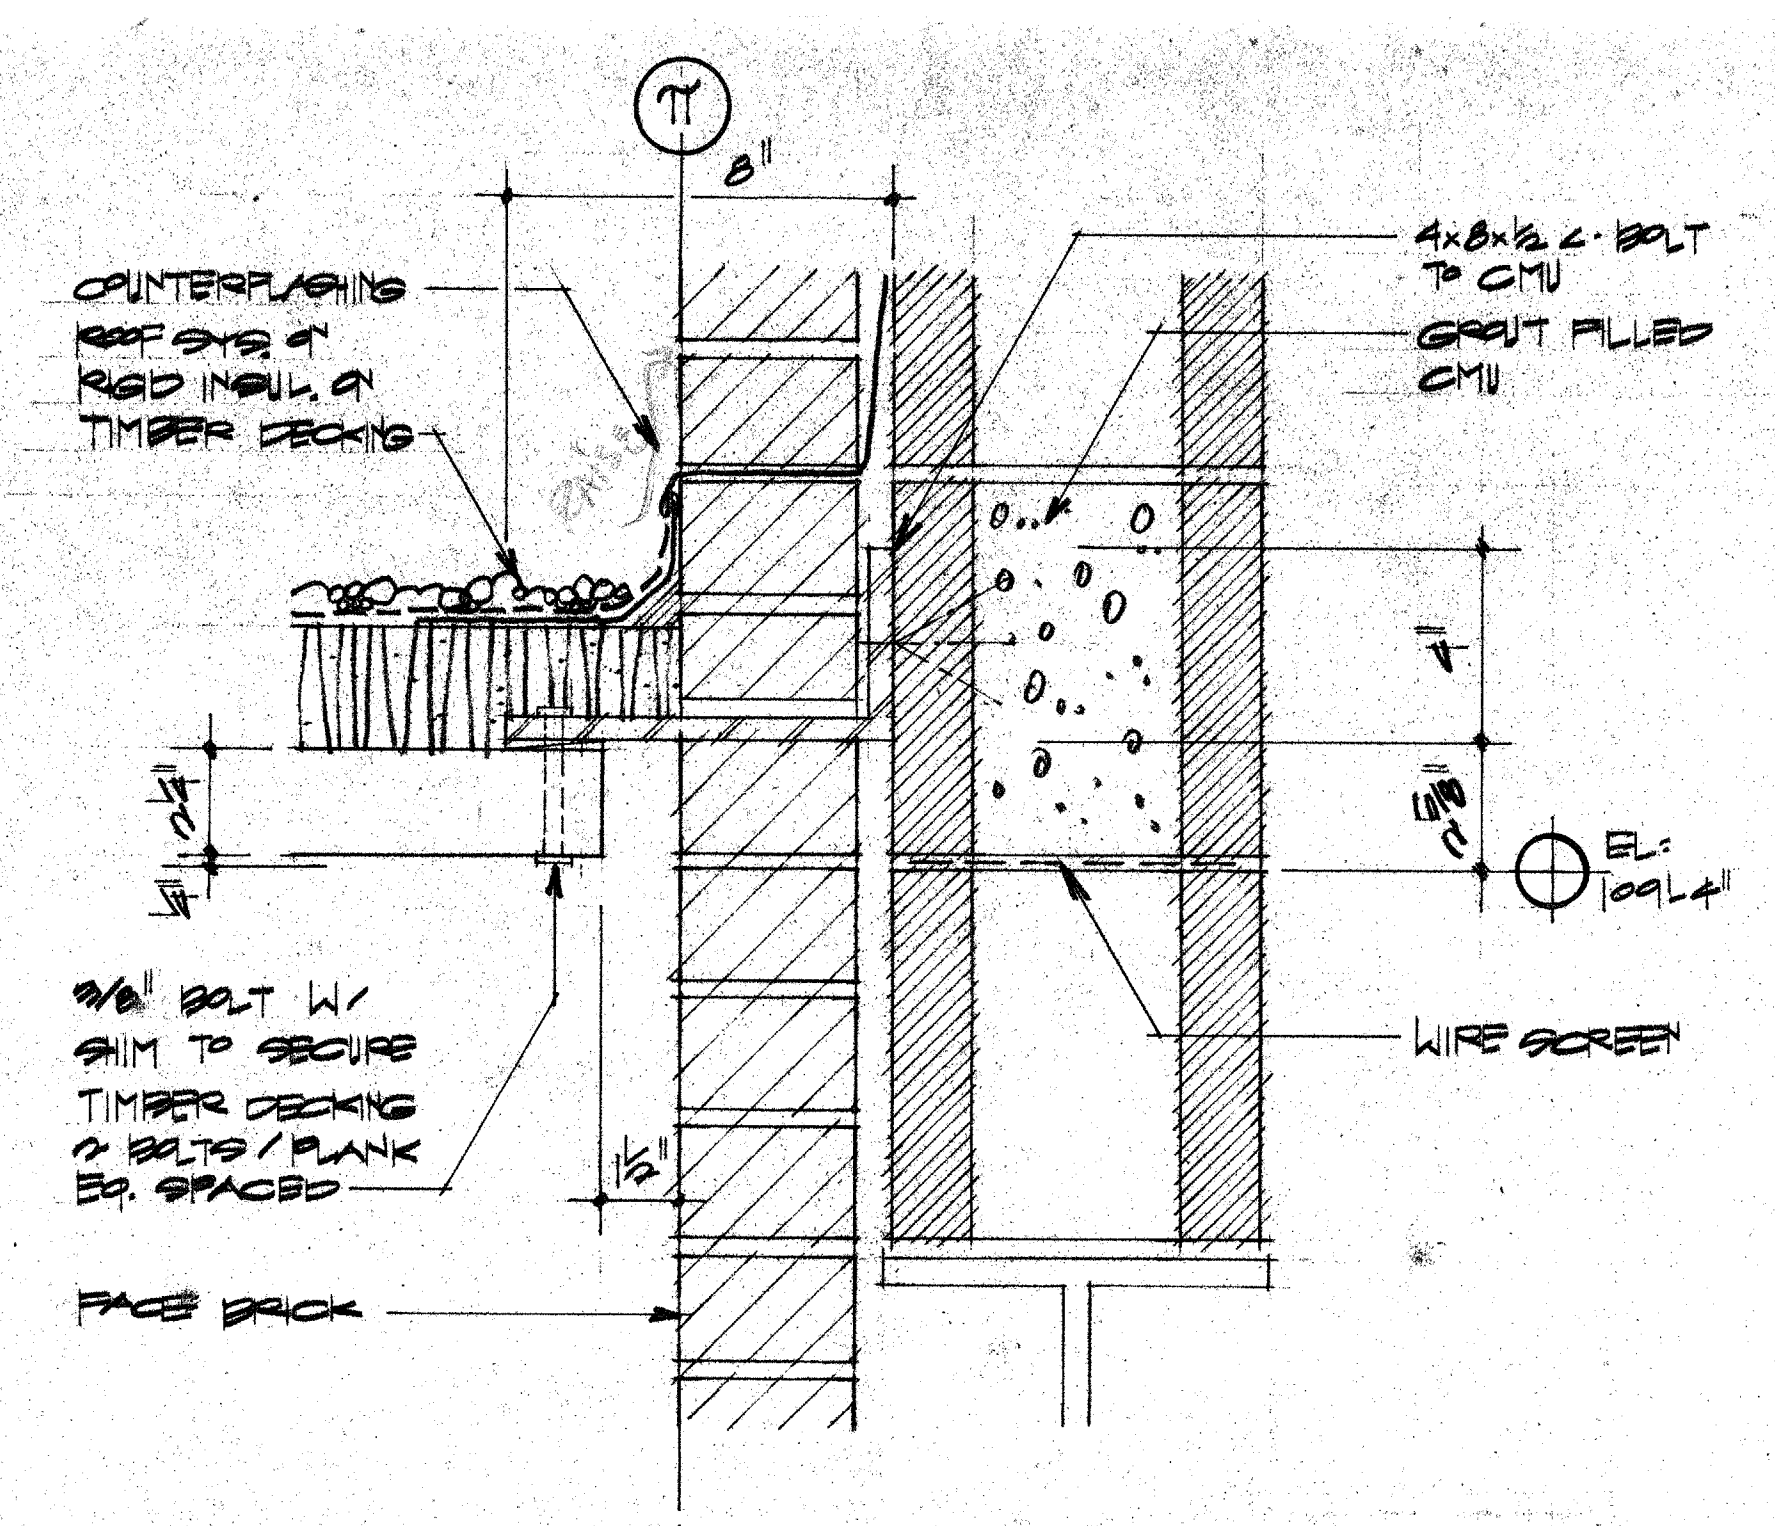


3 DETAIL

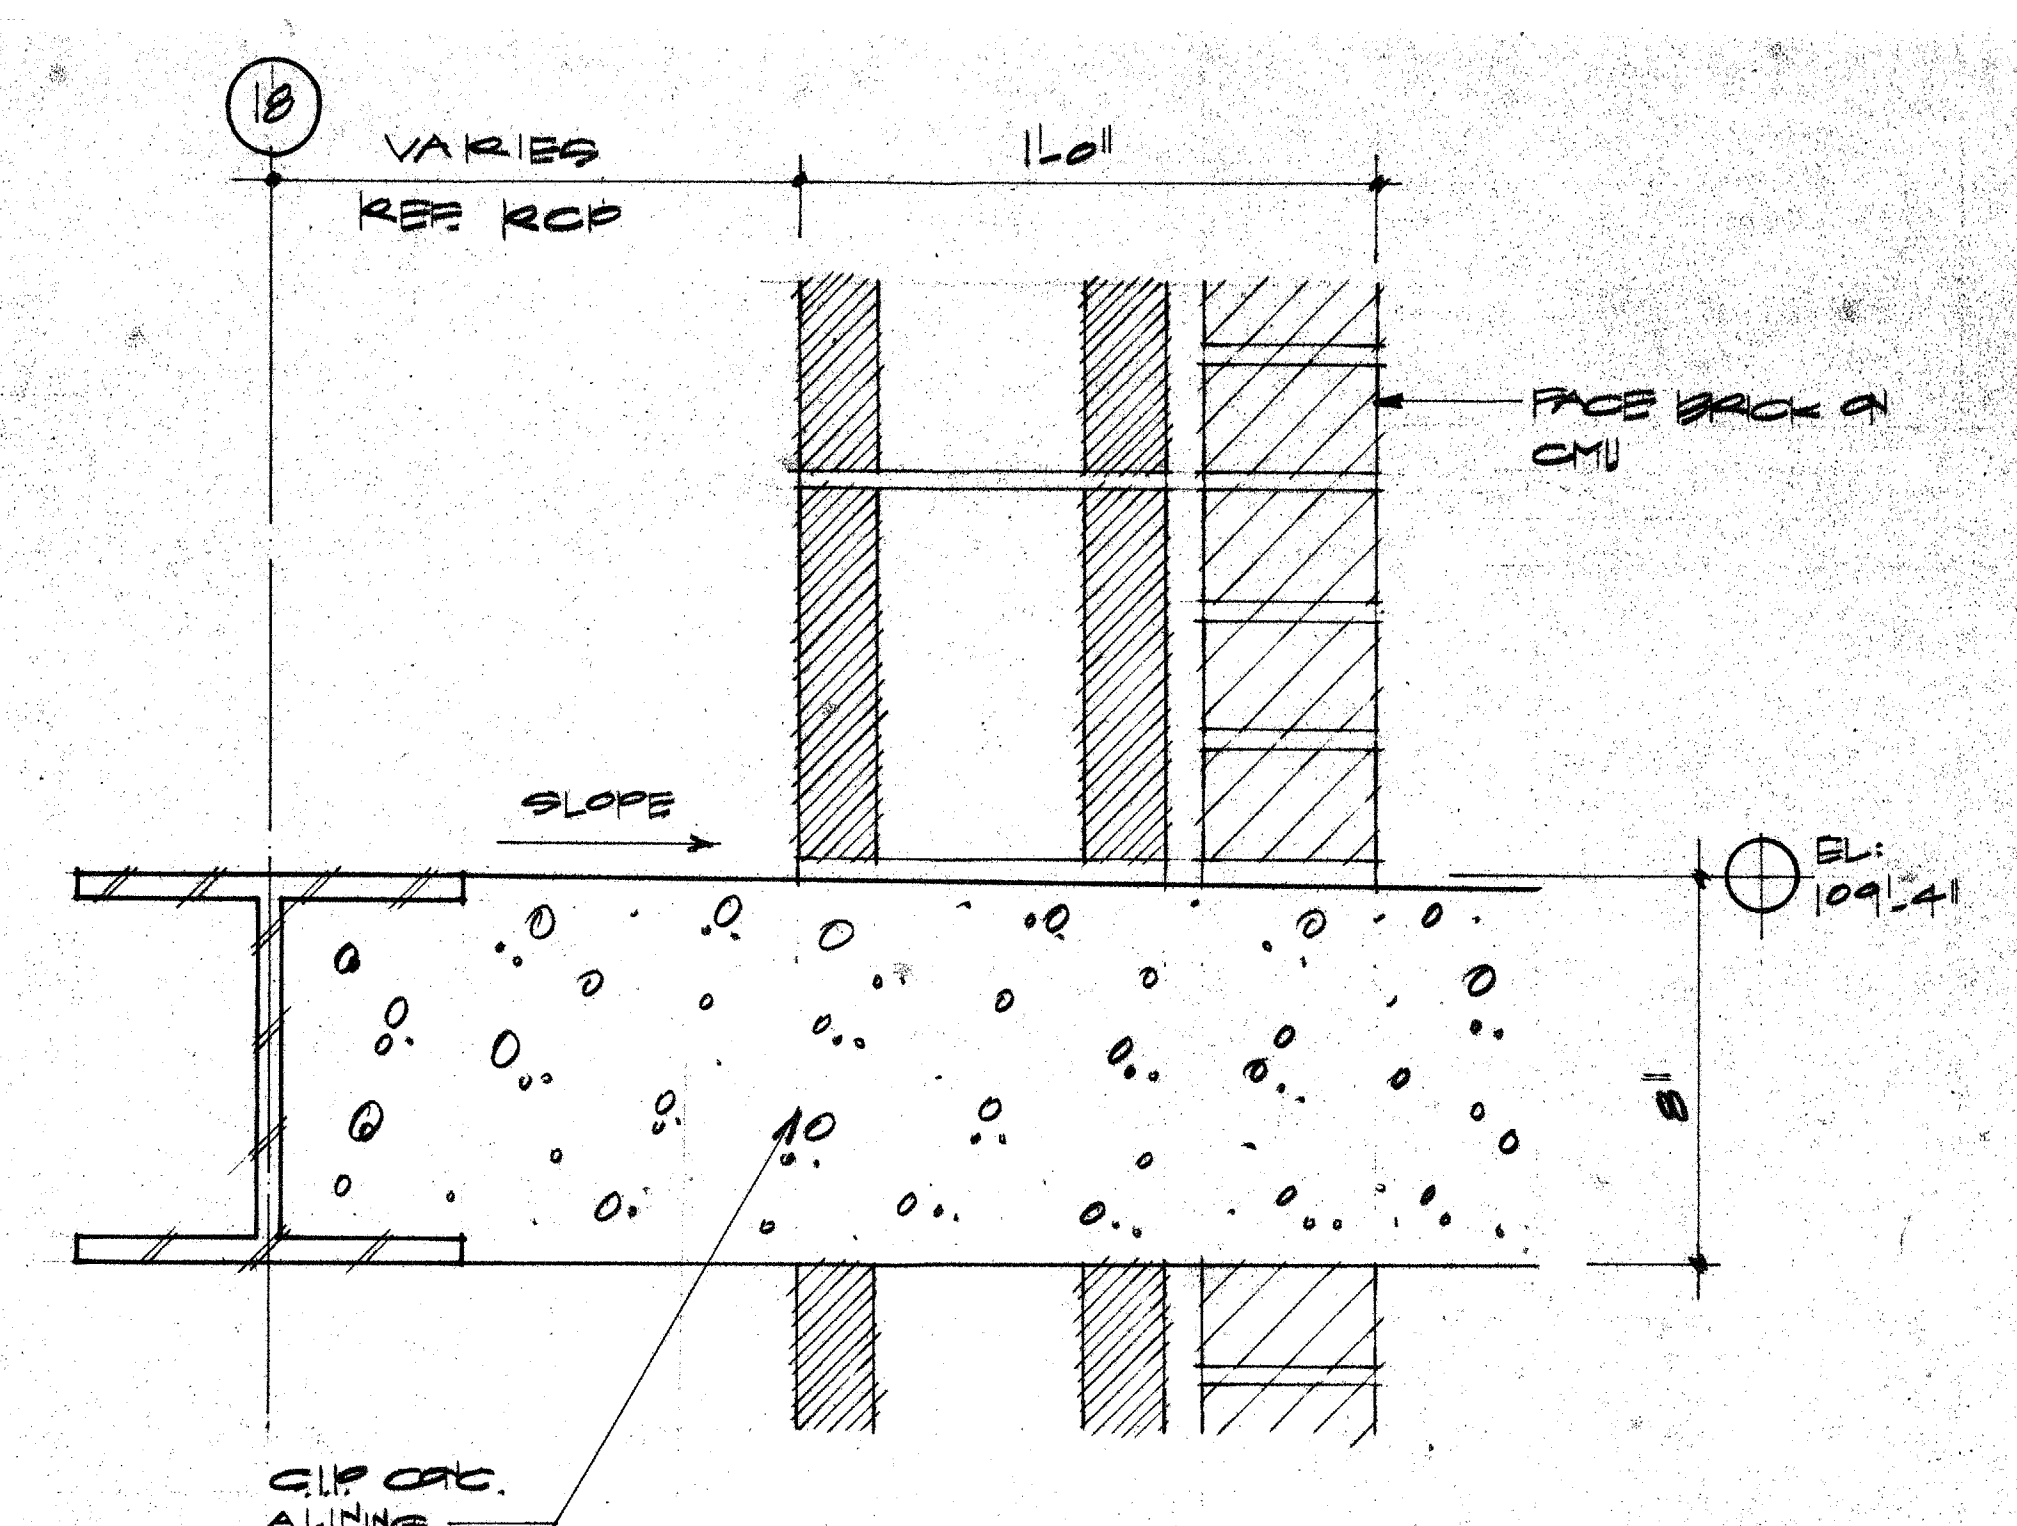


4 DETAIL

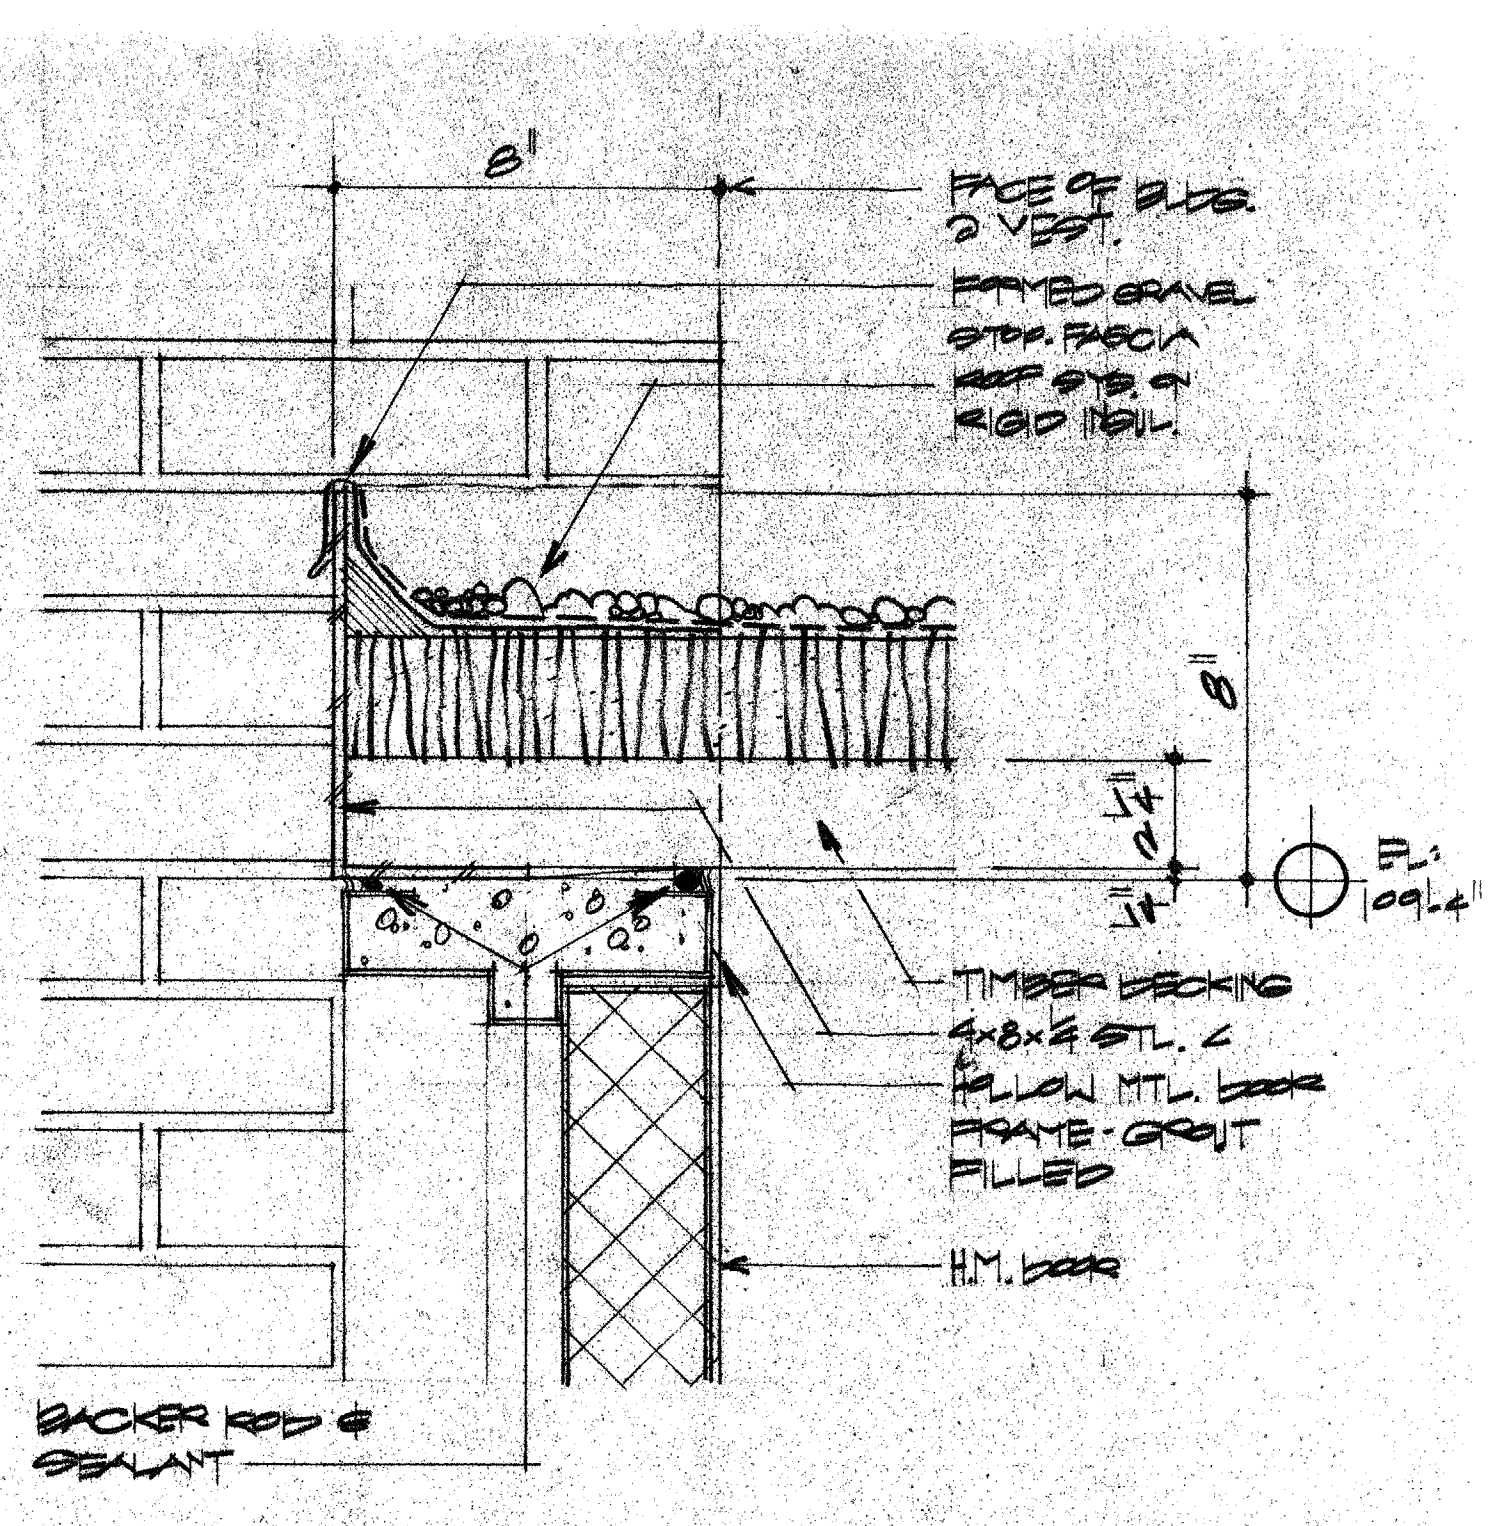


5 DETAIL

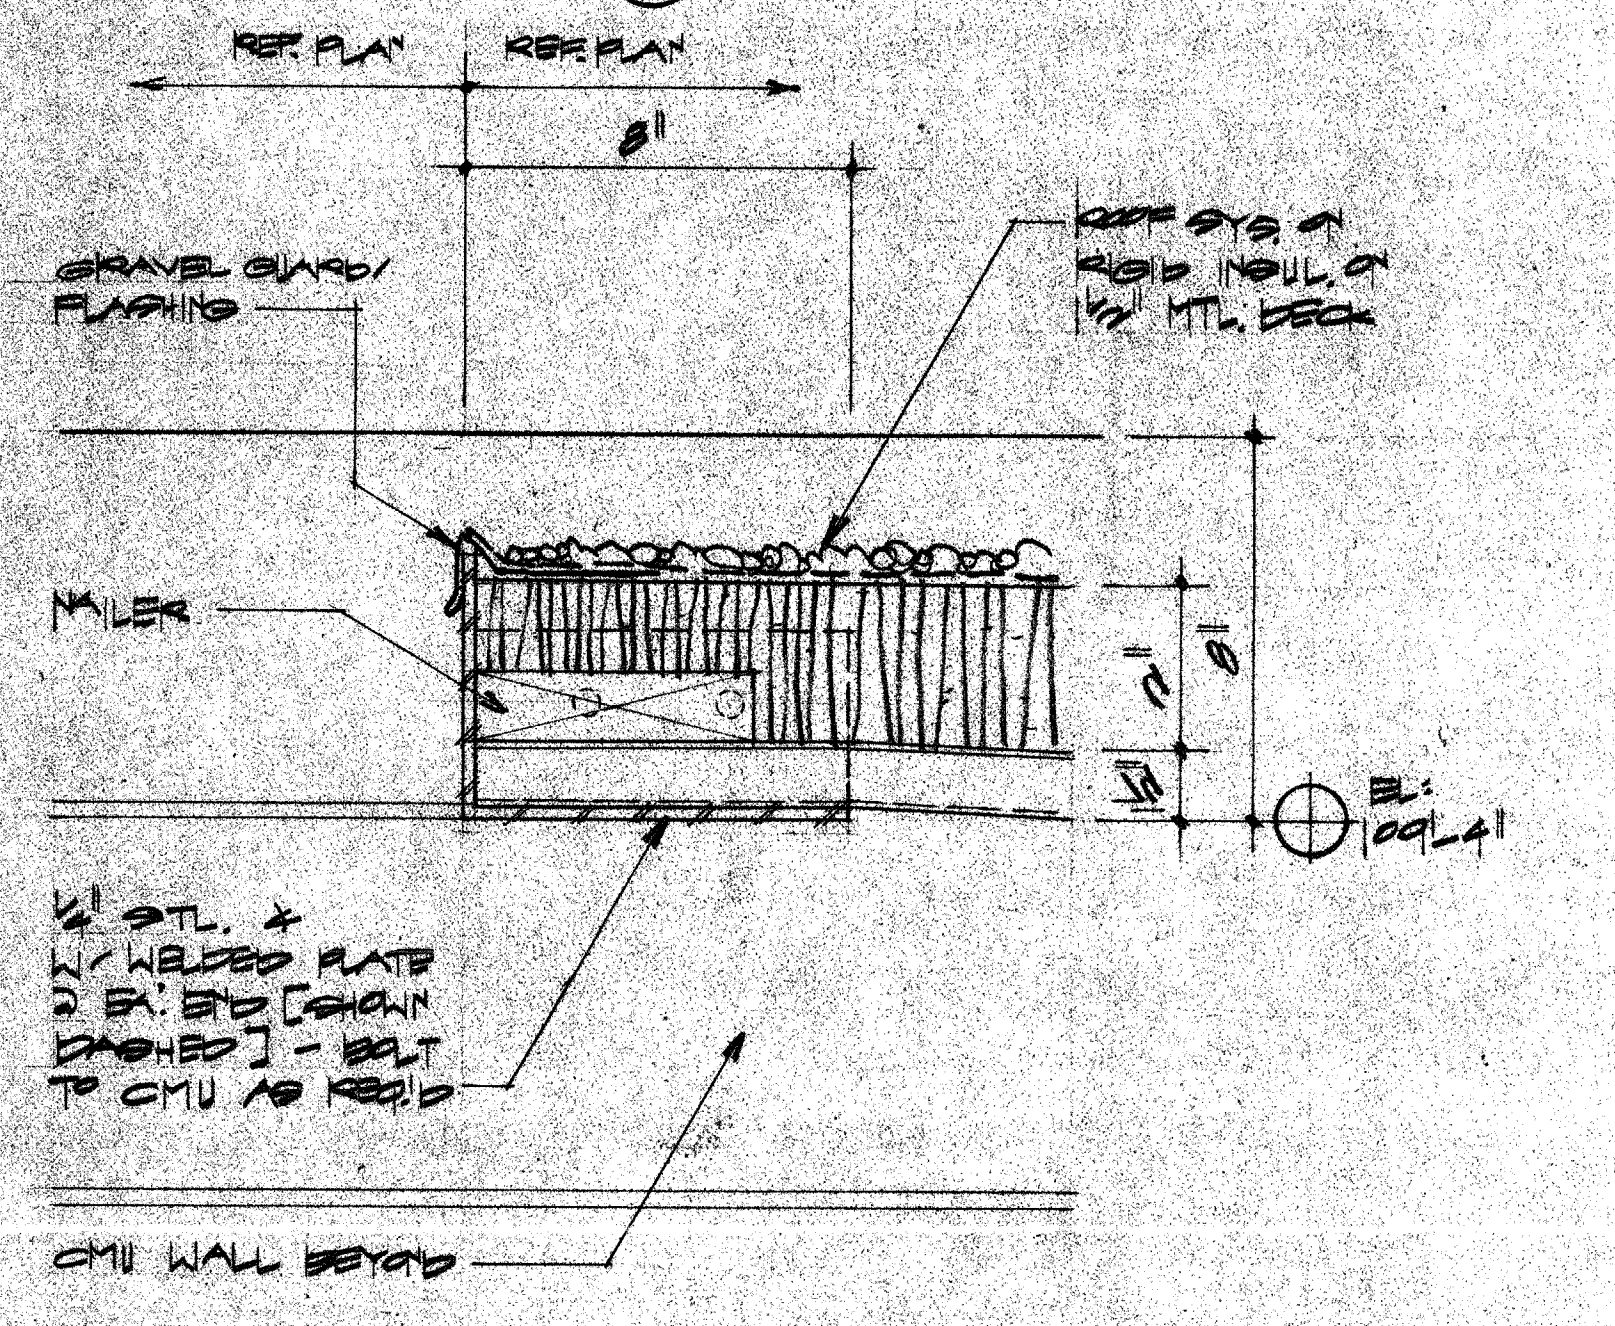


6 DETAIL

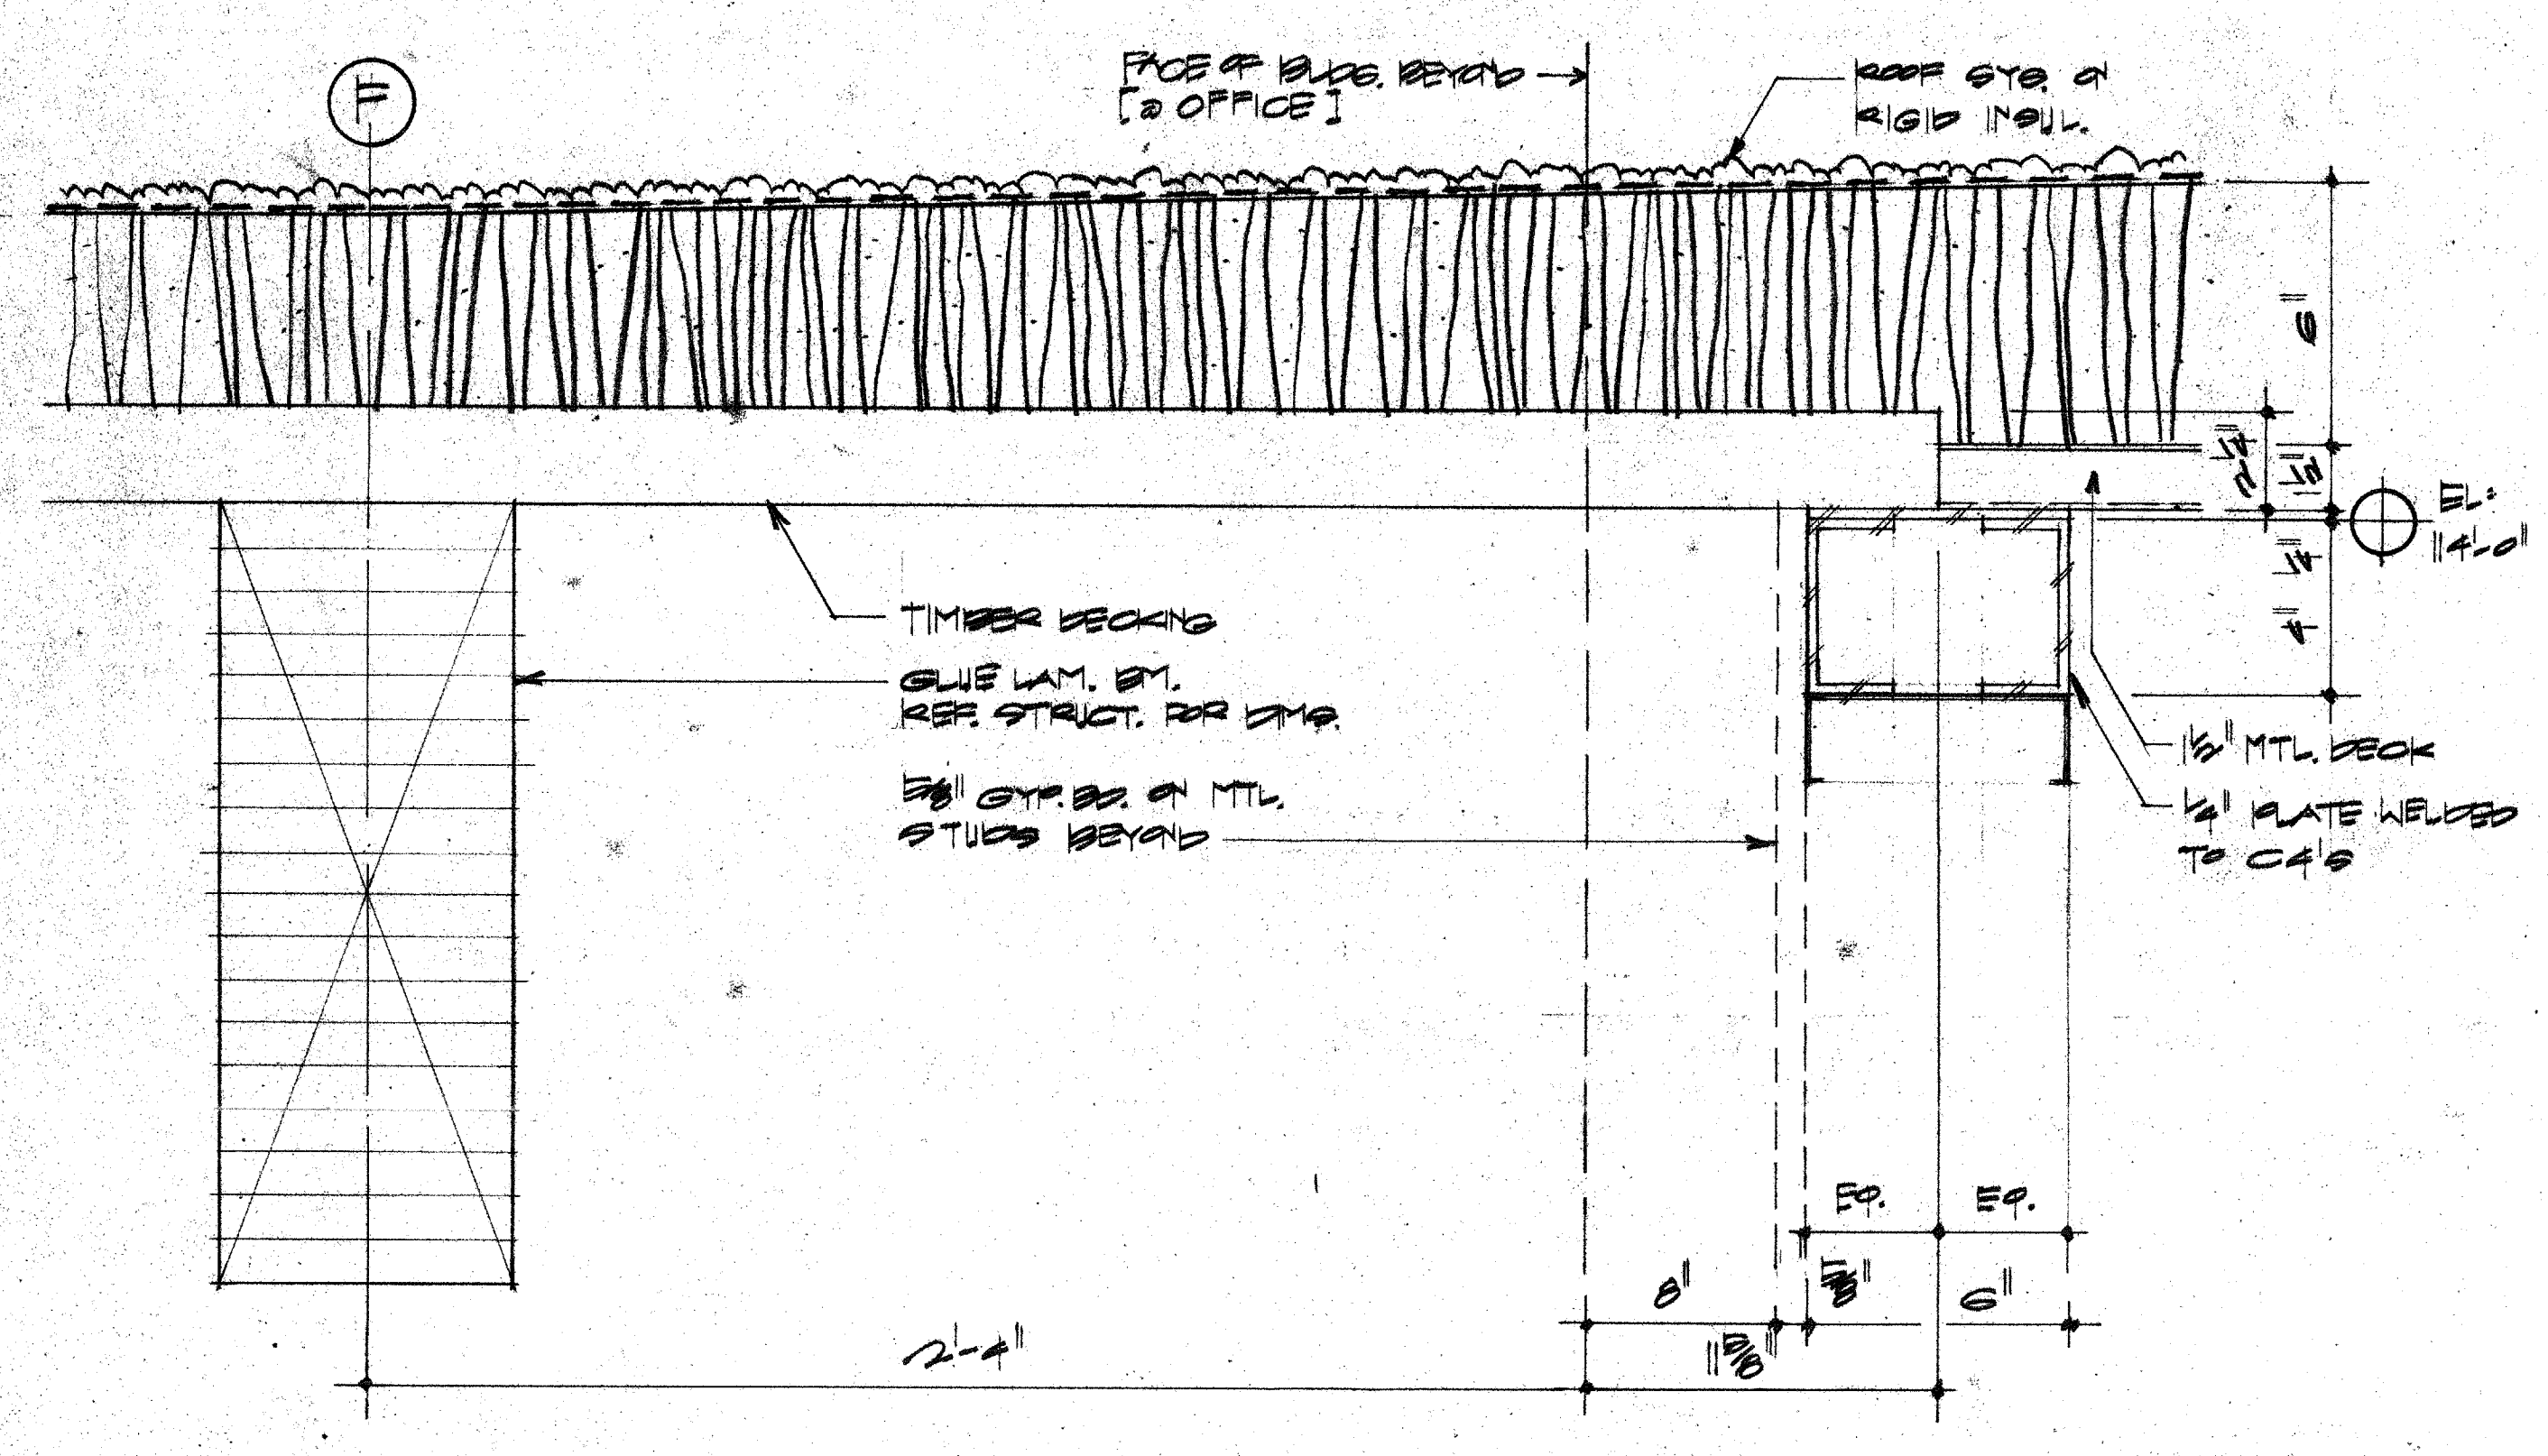


7 DETAIL

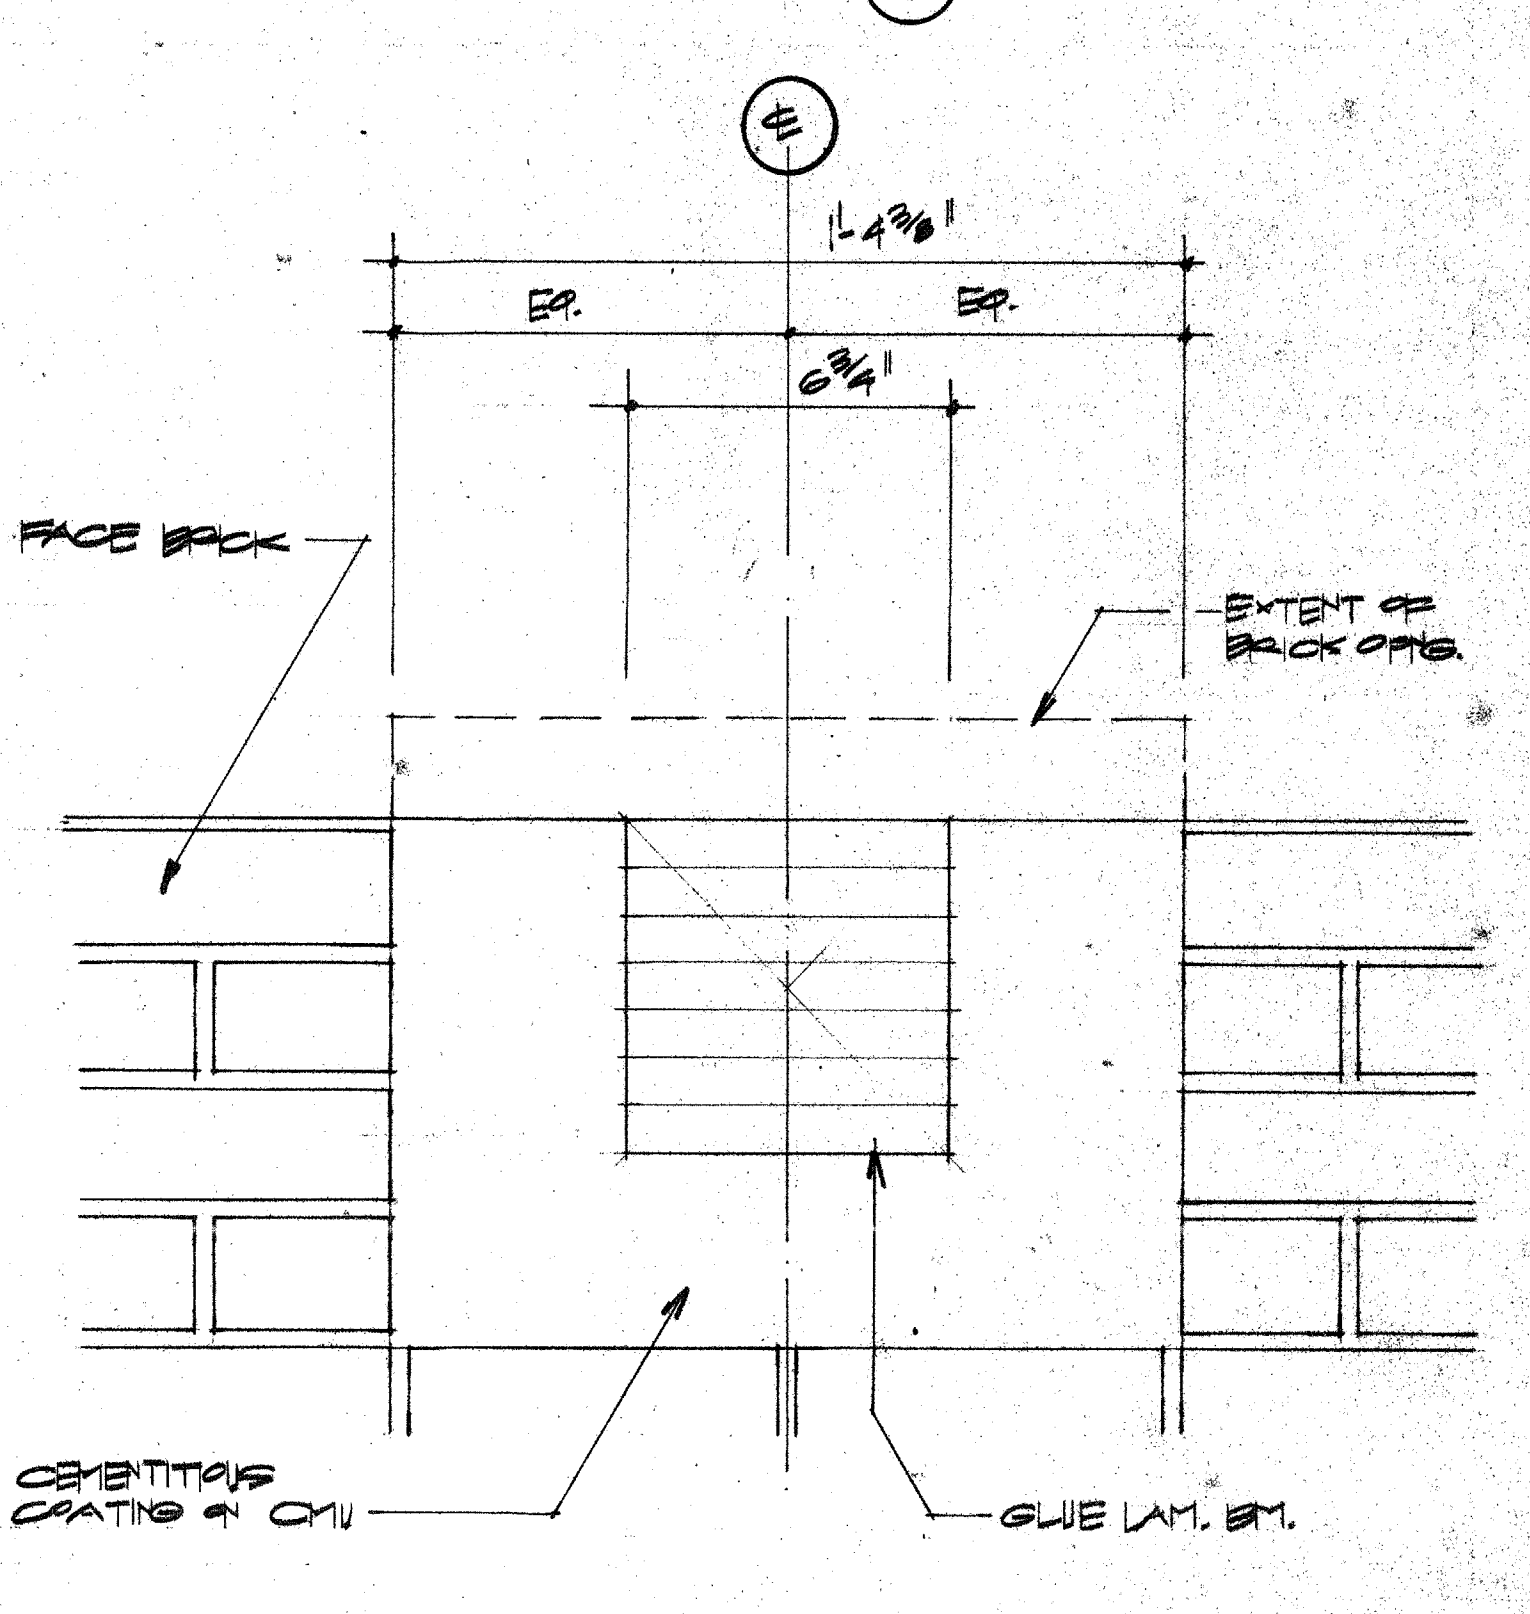


8 DETAIL

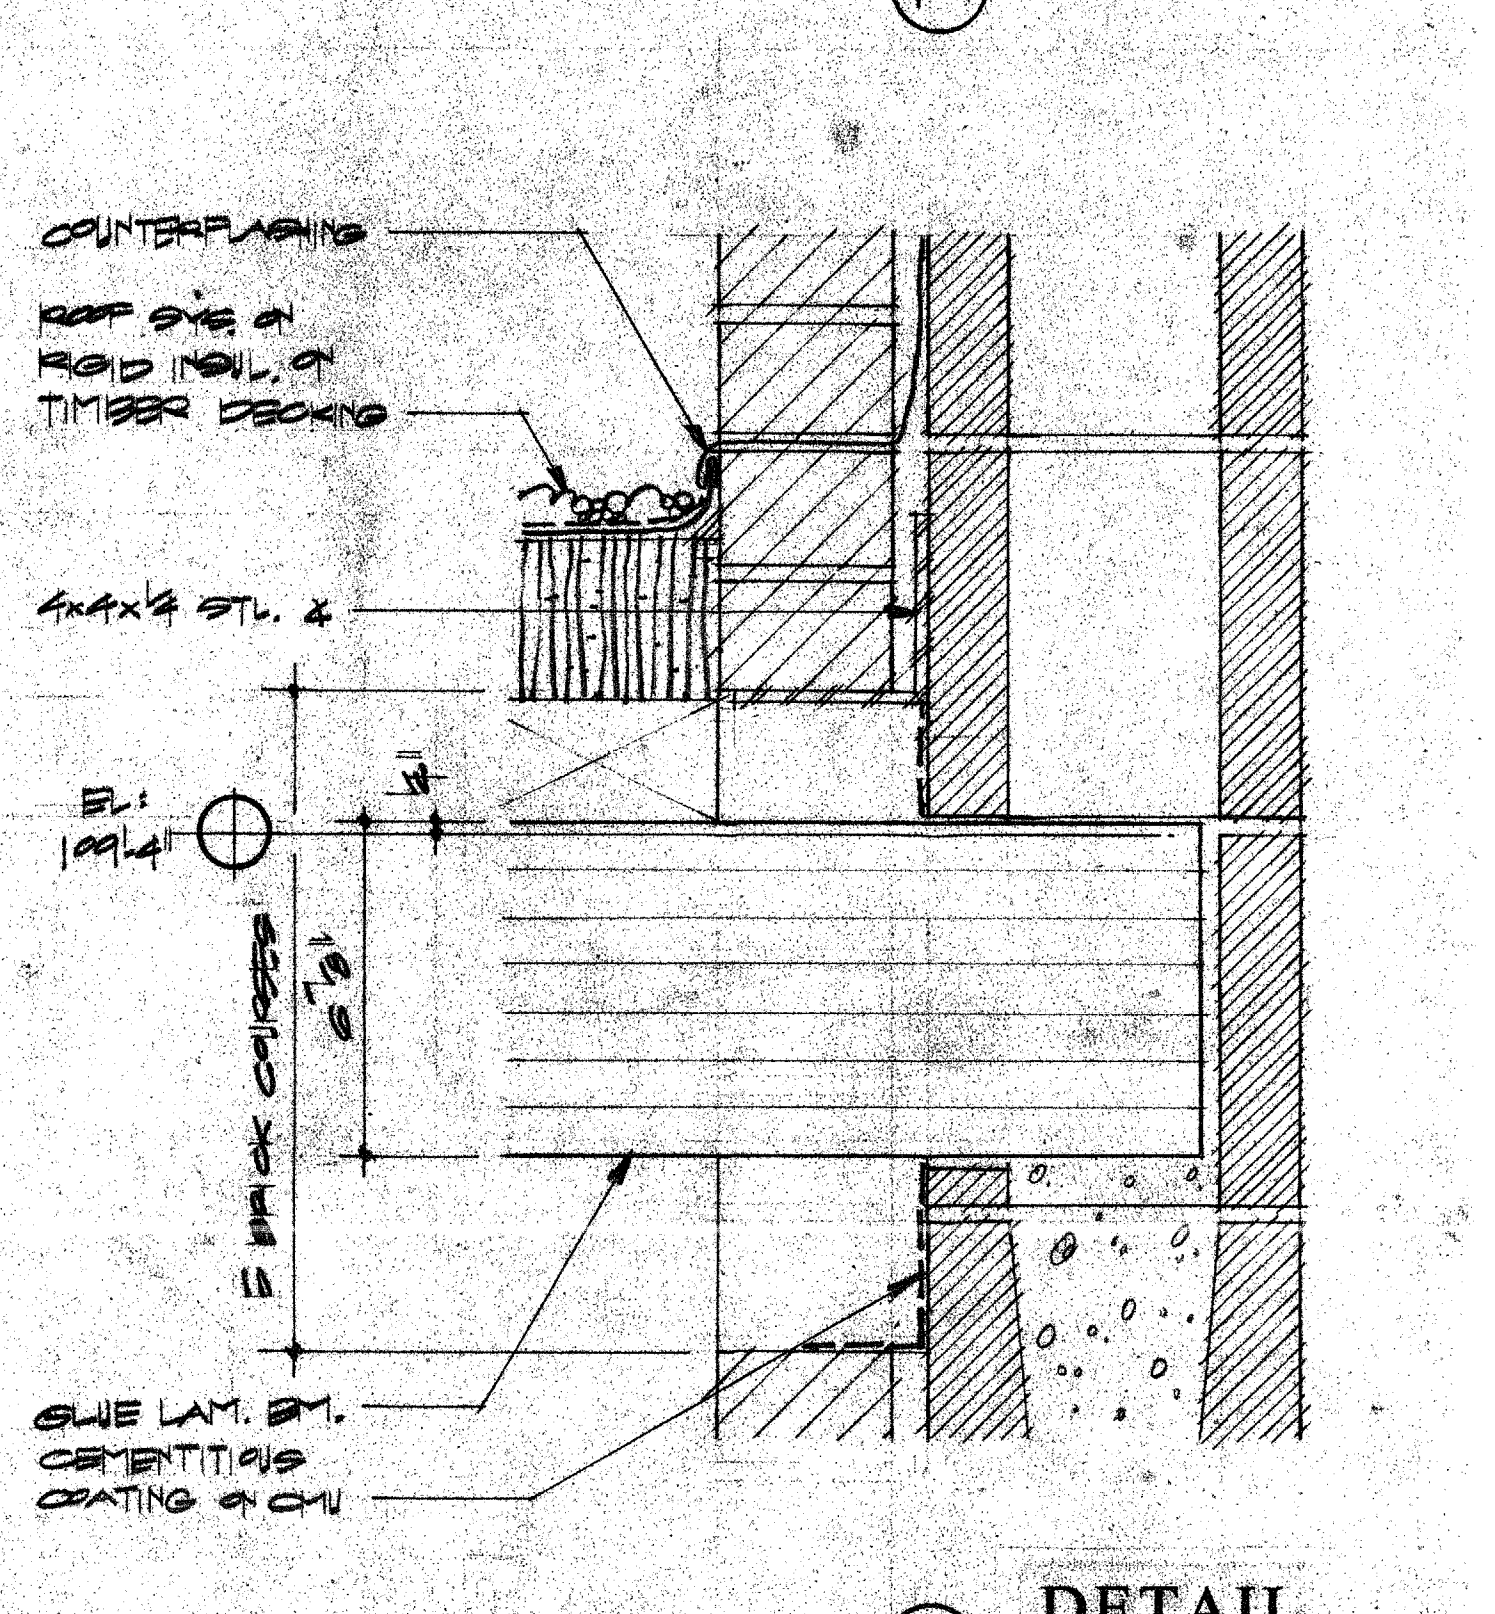


9 DETAIL

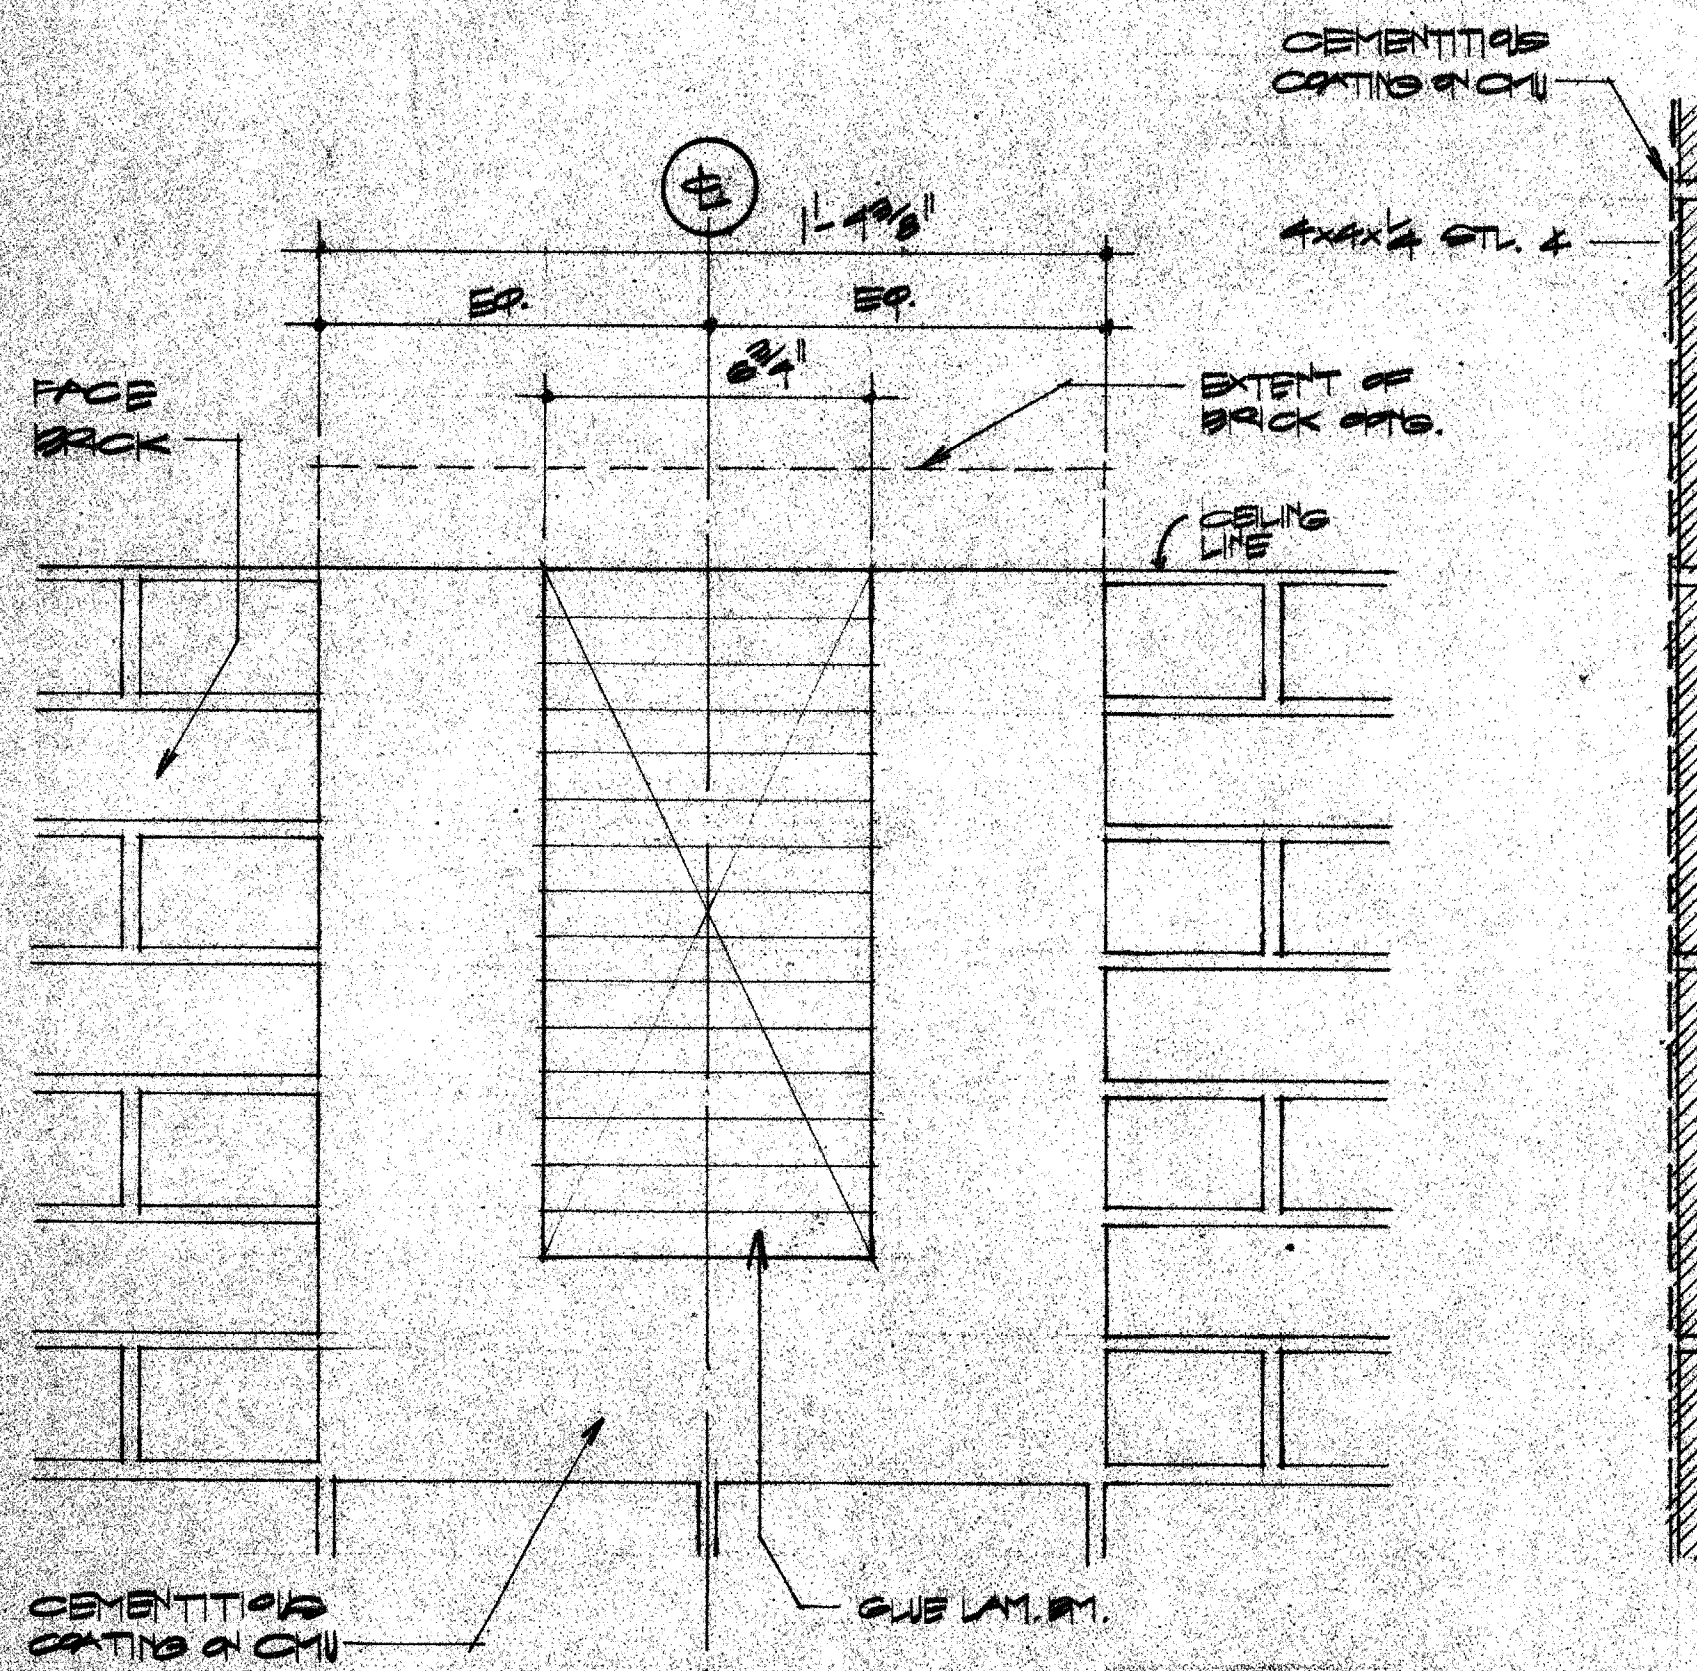


10 DETAIL

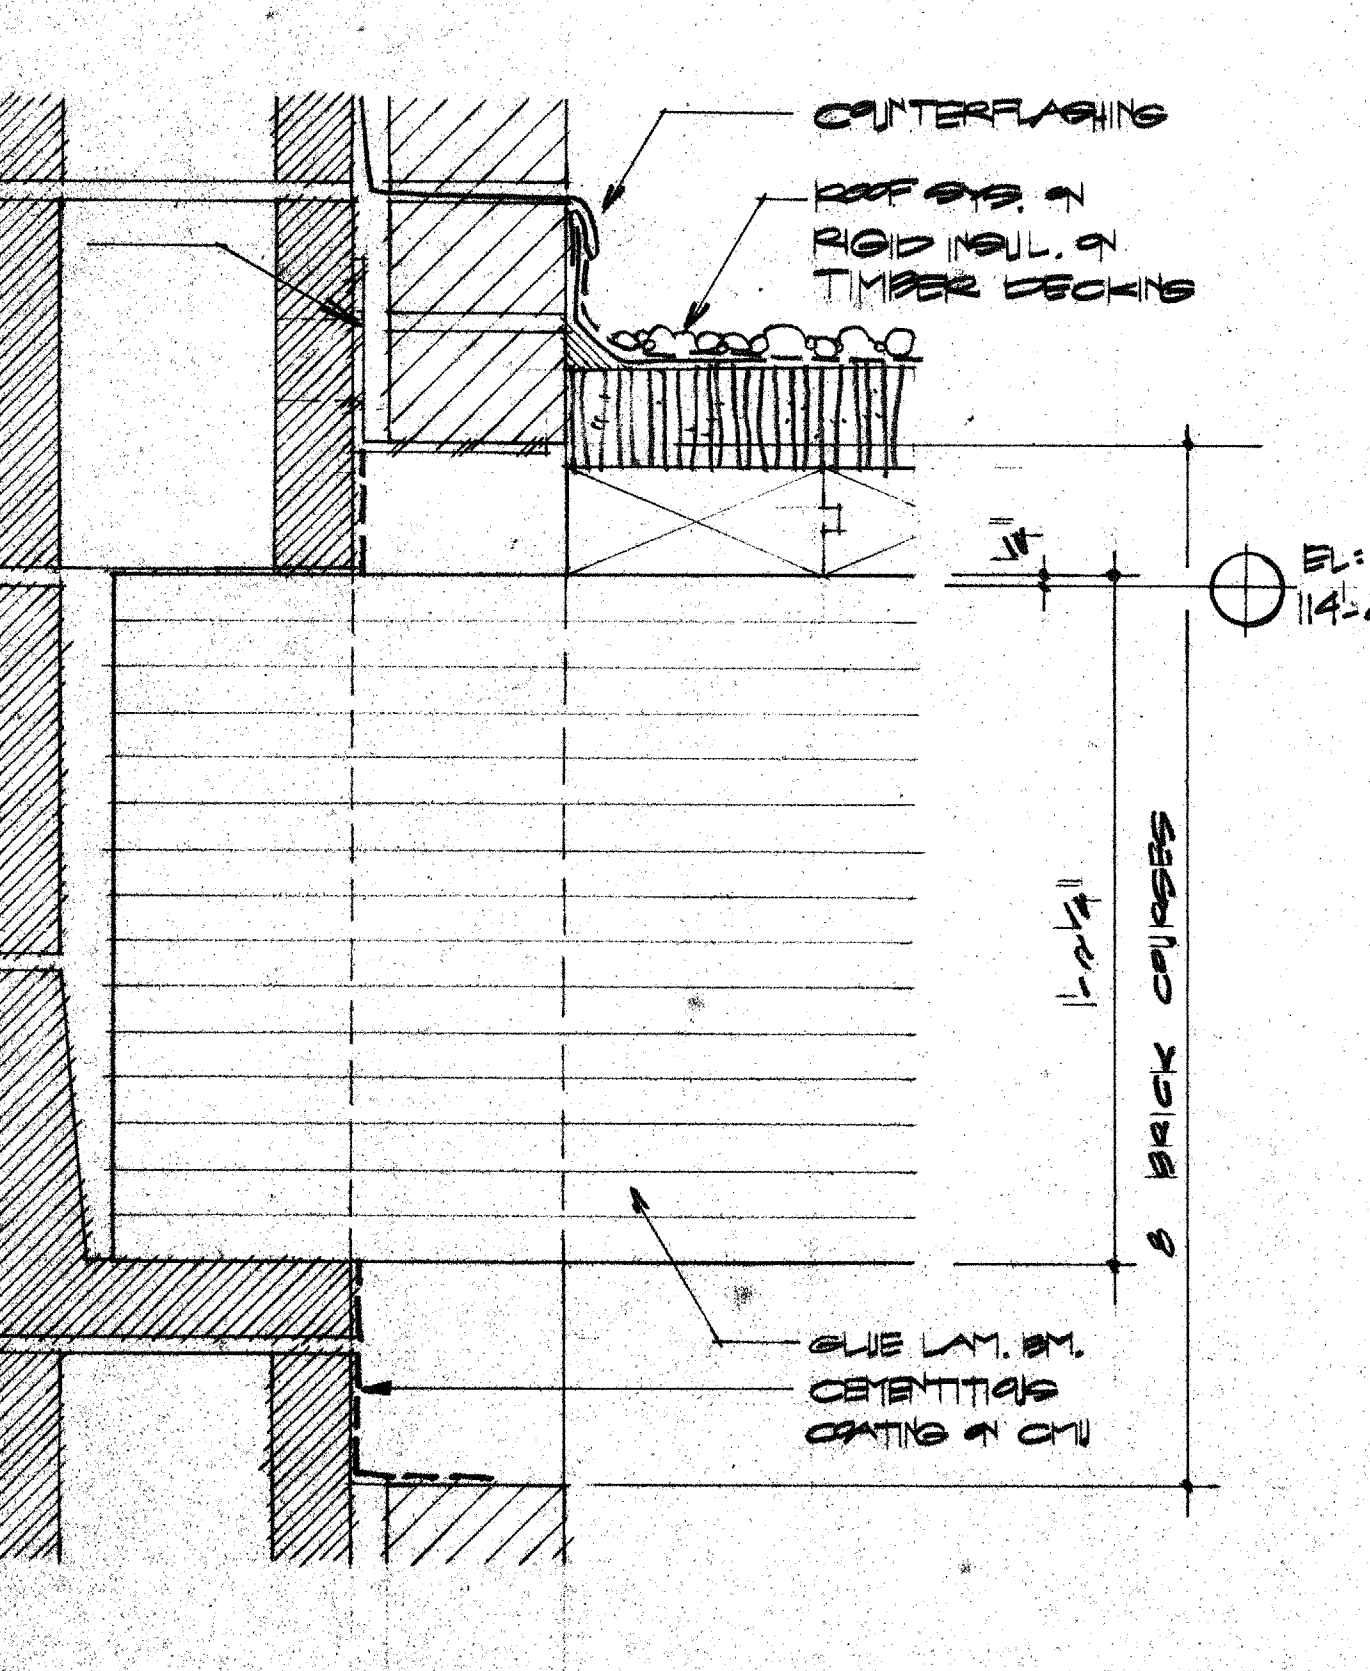


11 DETAIL

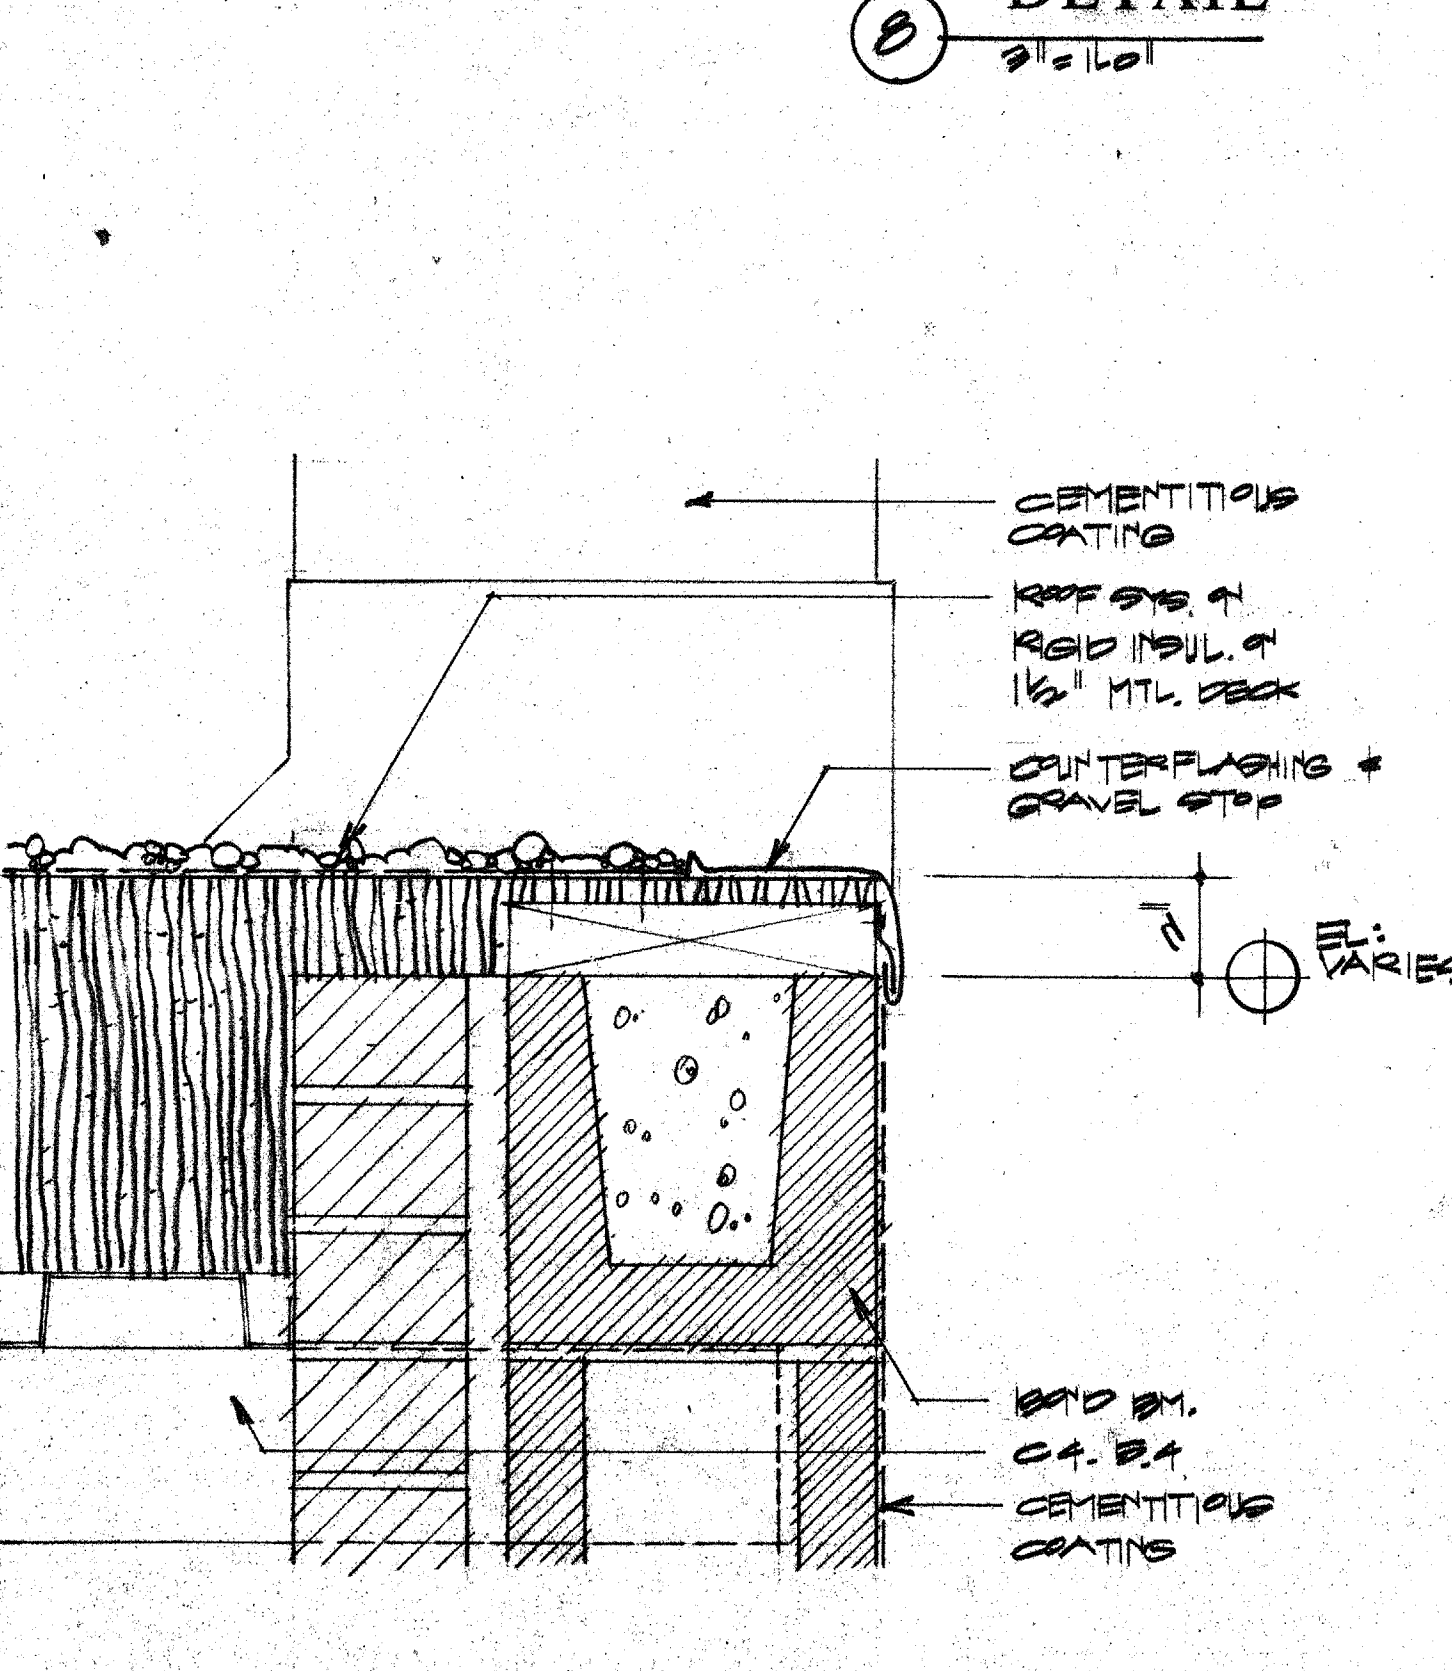

12 DETAIL

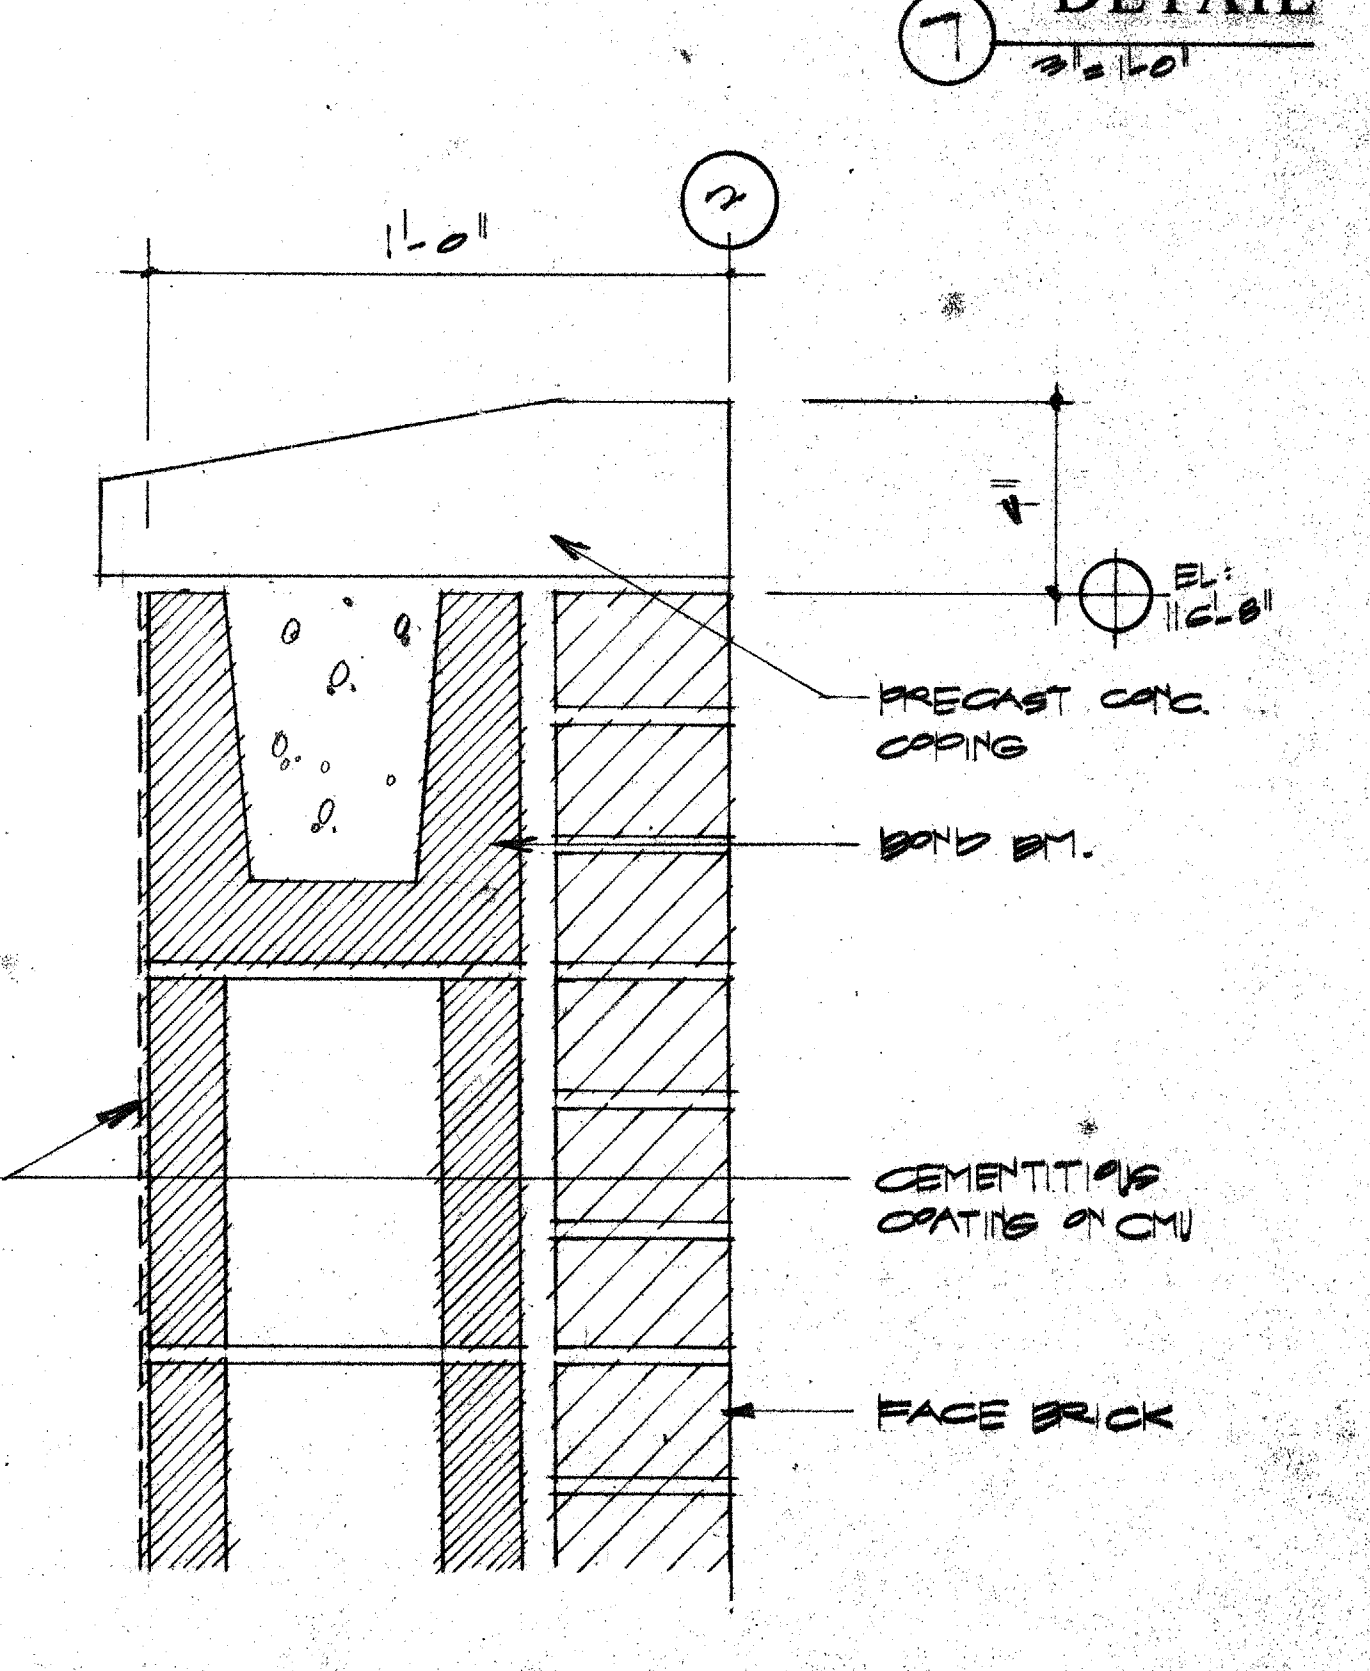

13 DETAIL

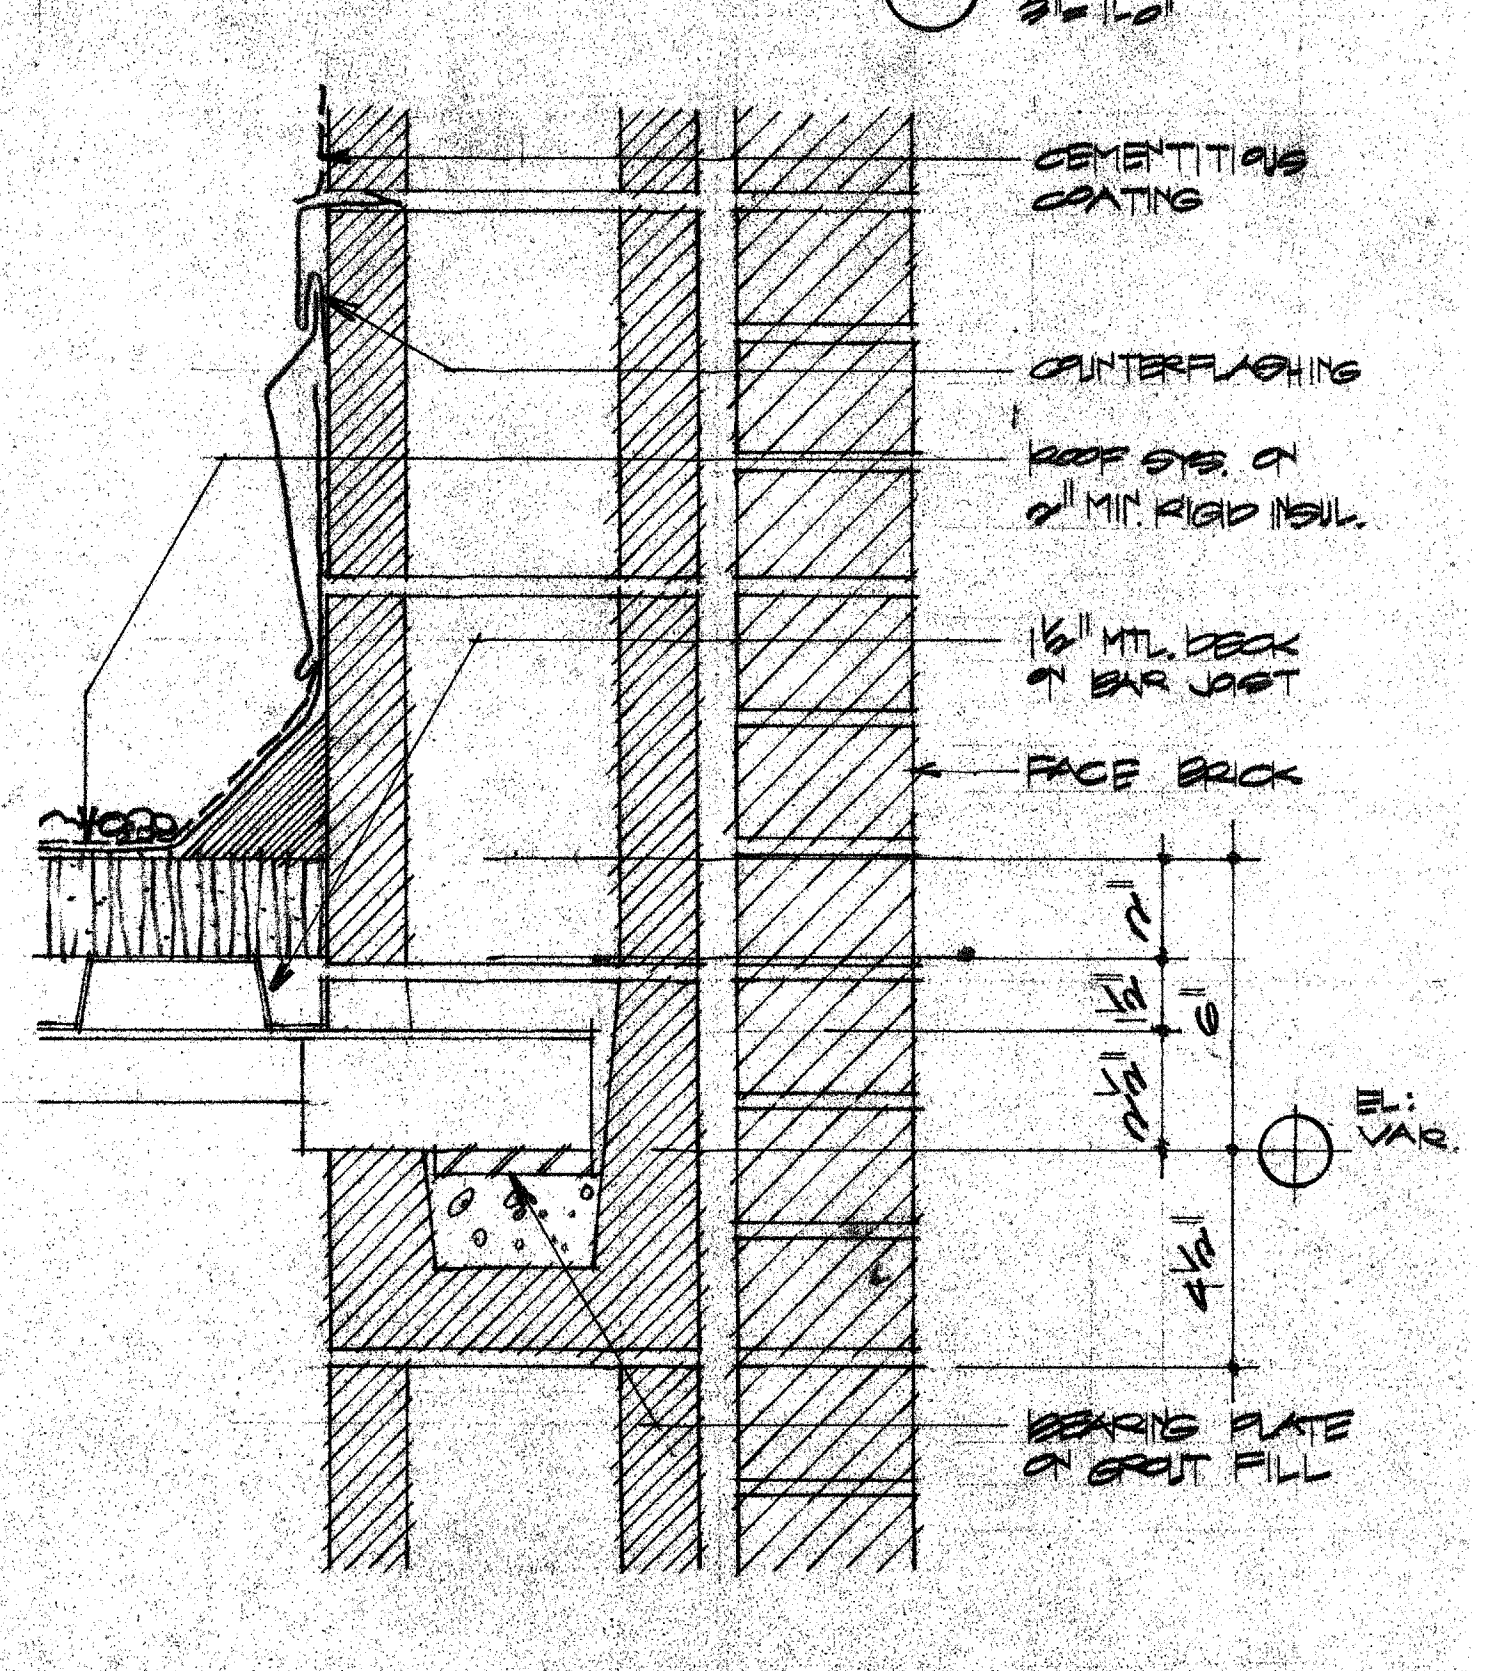

14 DETAIL



ACC ACT
ADDISON

OWNER Town of Addison 2700 Fairmount Dallas, Texas 75208 214-655-5272	LANDSCAPE The Kellums Group 317-716-4427	STRUCTURAL Ellis & Jansen 214-651-6393	HISTORIAN Alan Mason 214-651-7162
ARCHITECT Cousins & Associates 2700 Fairmount Dallas, Texas 75208 214-655-5272	THEATRE CONSULTANT Theatre Projects 202-431-3948	M.E.P. MEP Systems 214-754-4741	LIGHTING Parsons Hill Wilson 214-651-6542
INTERIORS CRSS 214-652-2000	CIVIL Kurtz & Associates 214-651-3222	GRAPHICS Northward Design 214-651-9276	

Issue	Category	Subcategory	Sheet
ISSUE FOR BID 8-17-80	4	9	2