




15 DETAIL

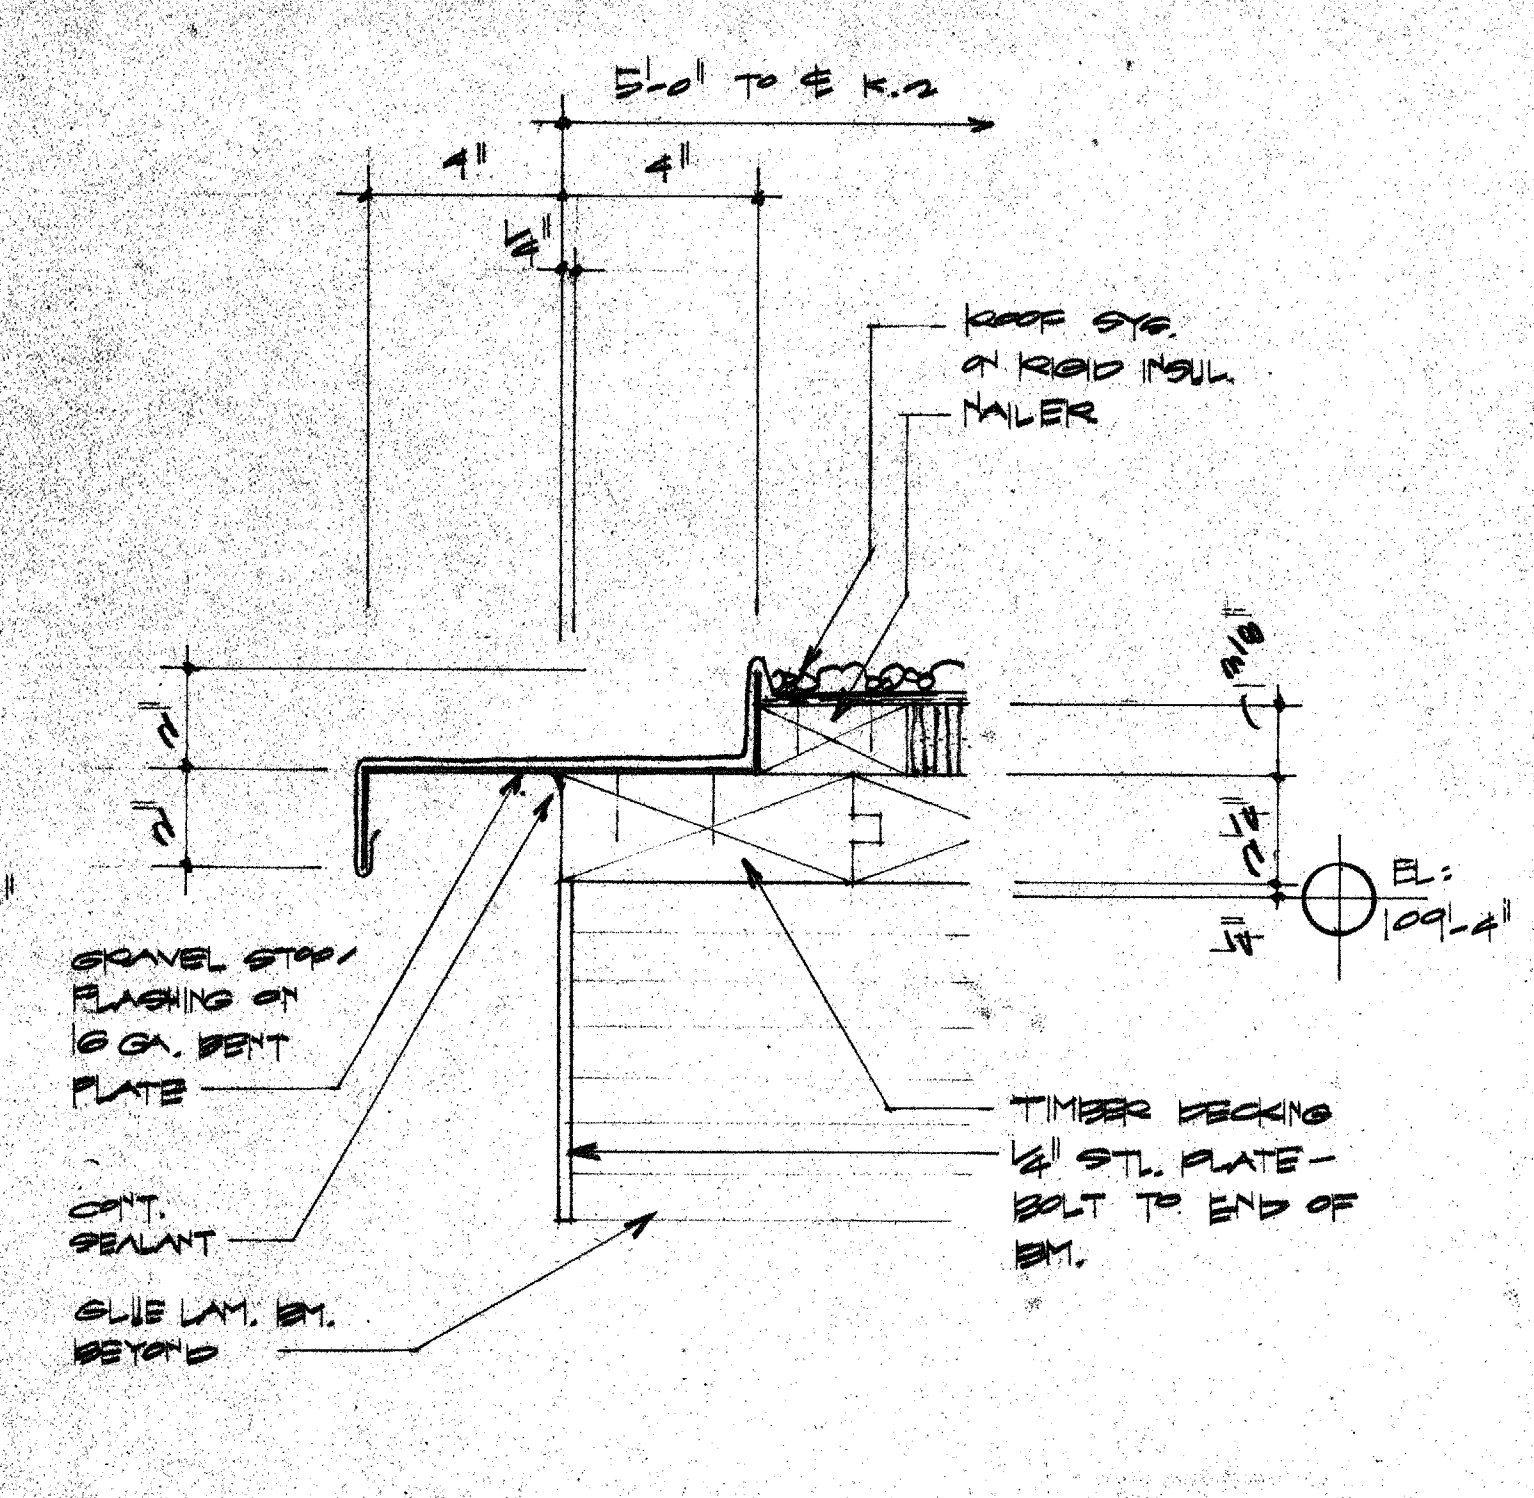


14 DETAIL

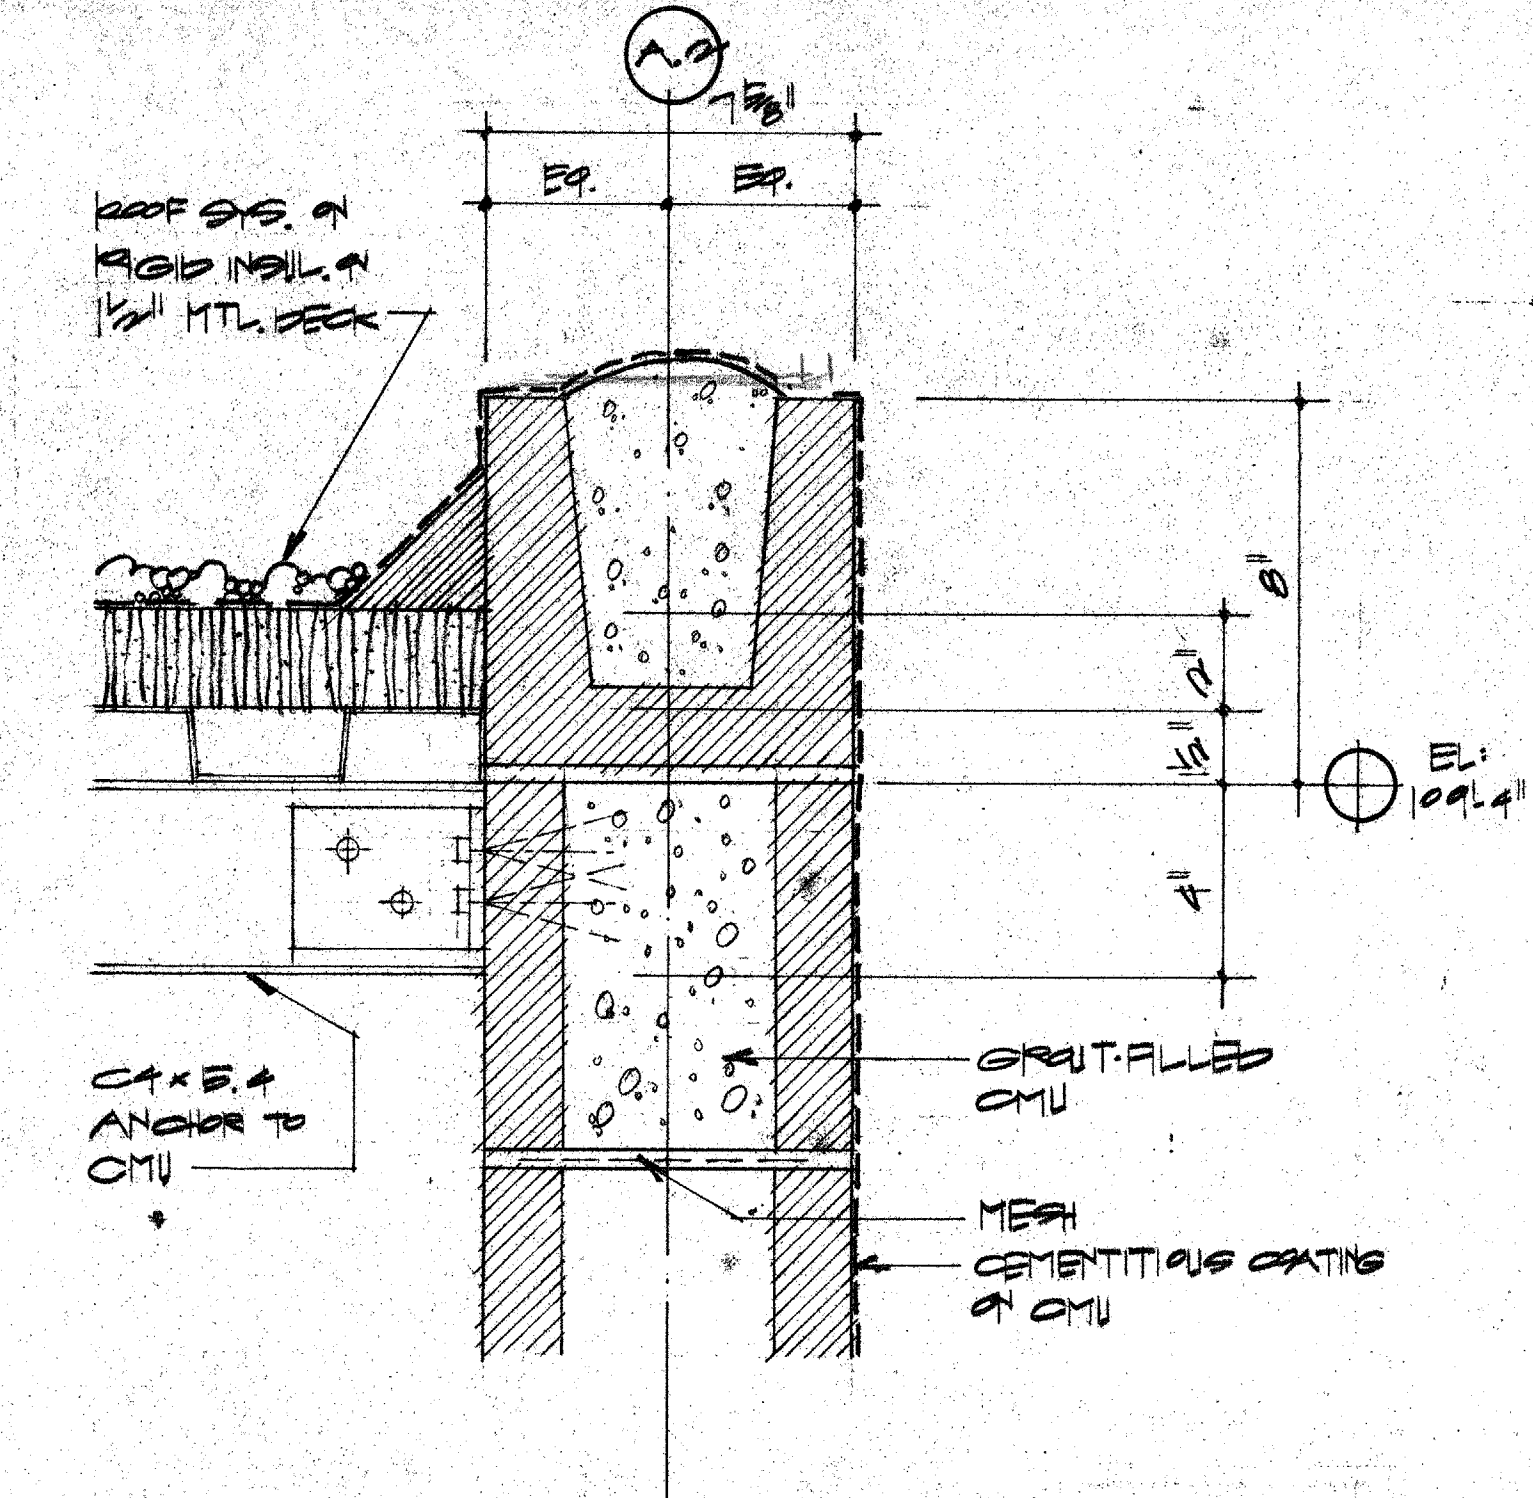


13 DETAIL

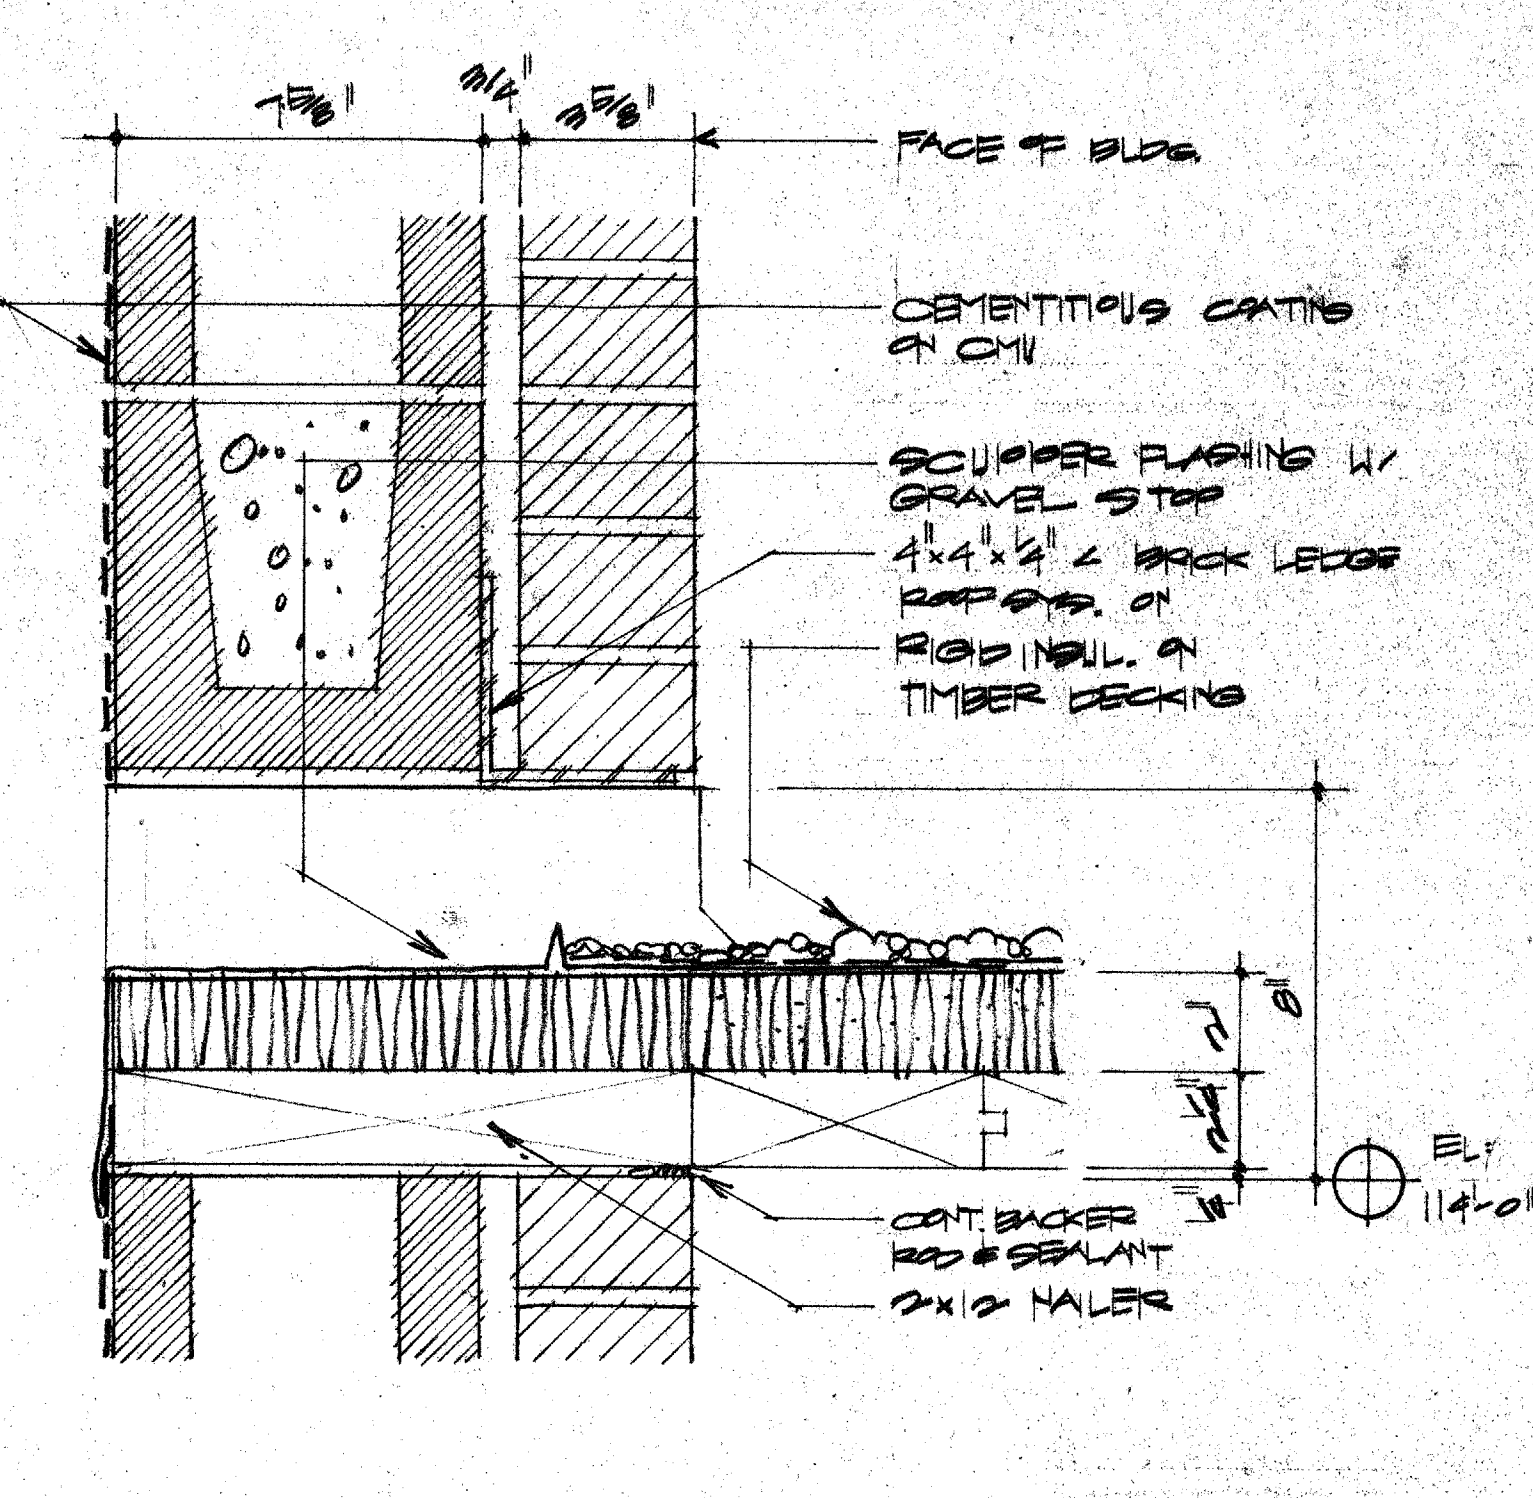


12 DETAIL

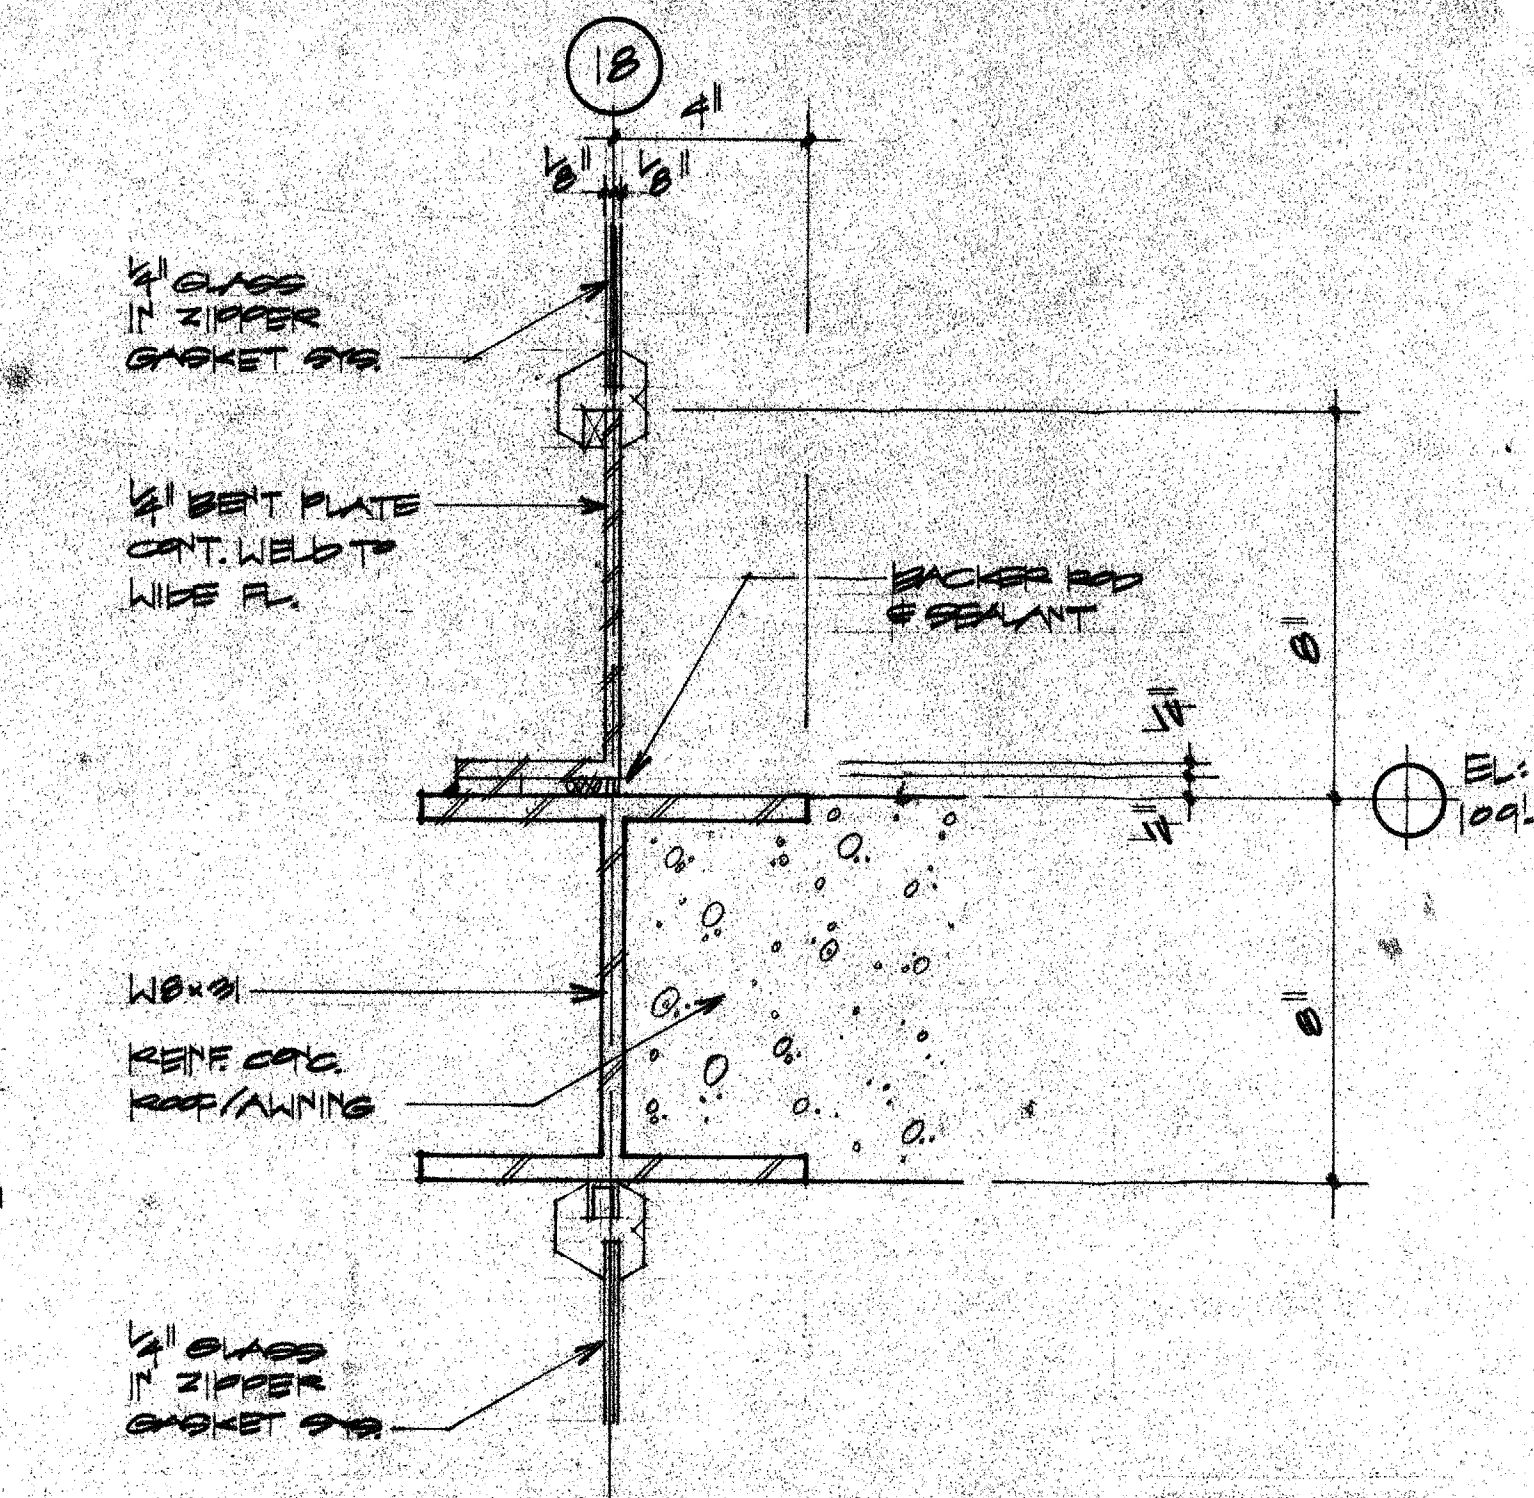


11 DETAIL

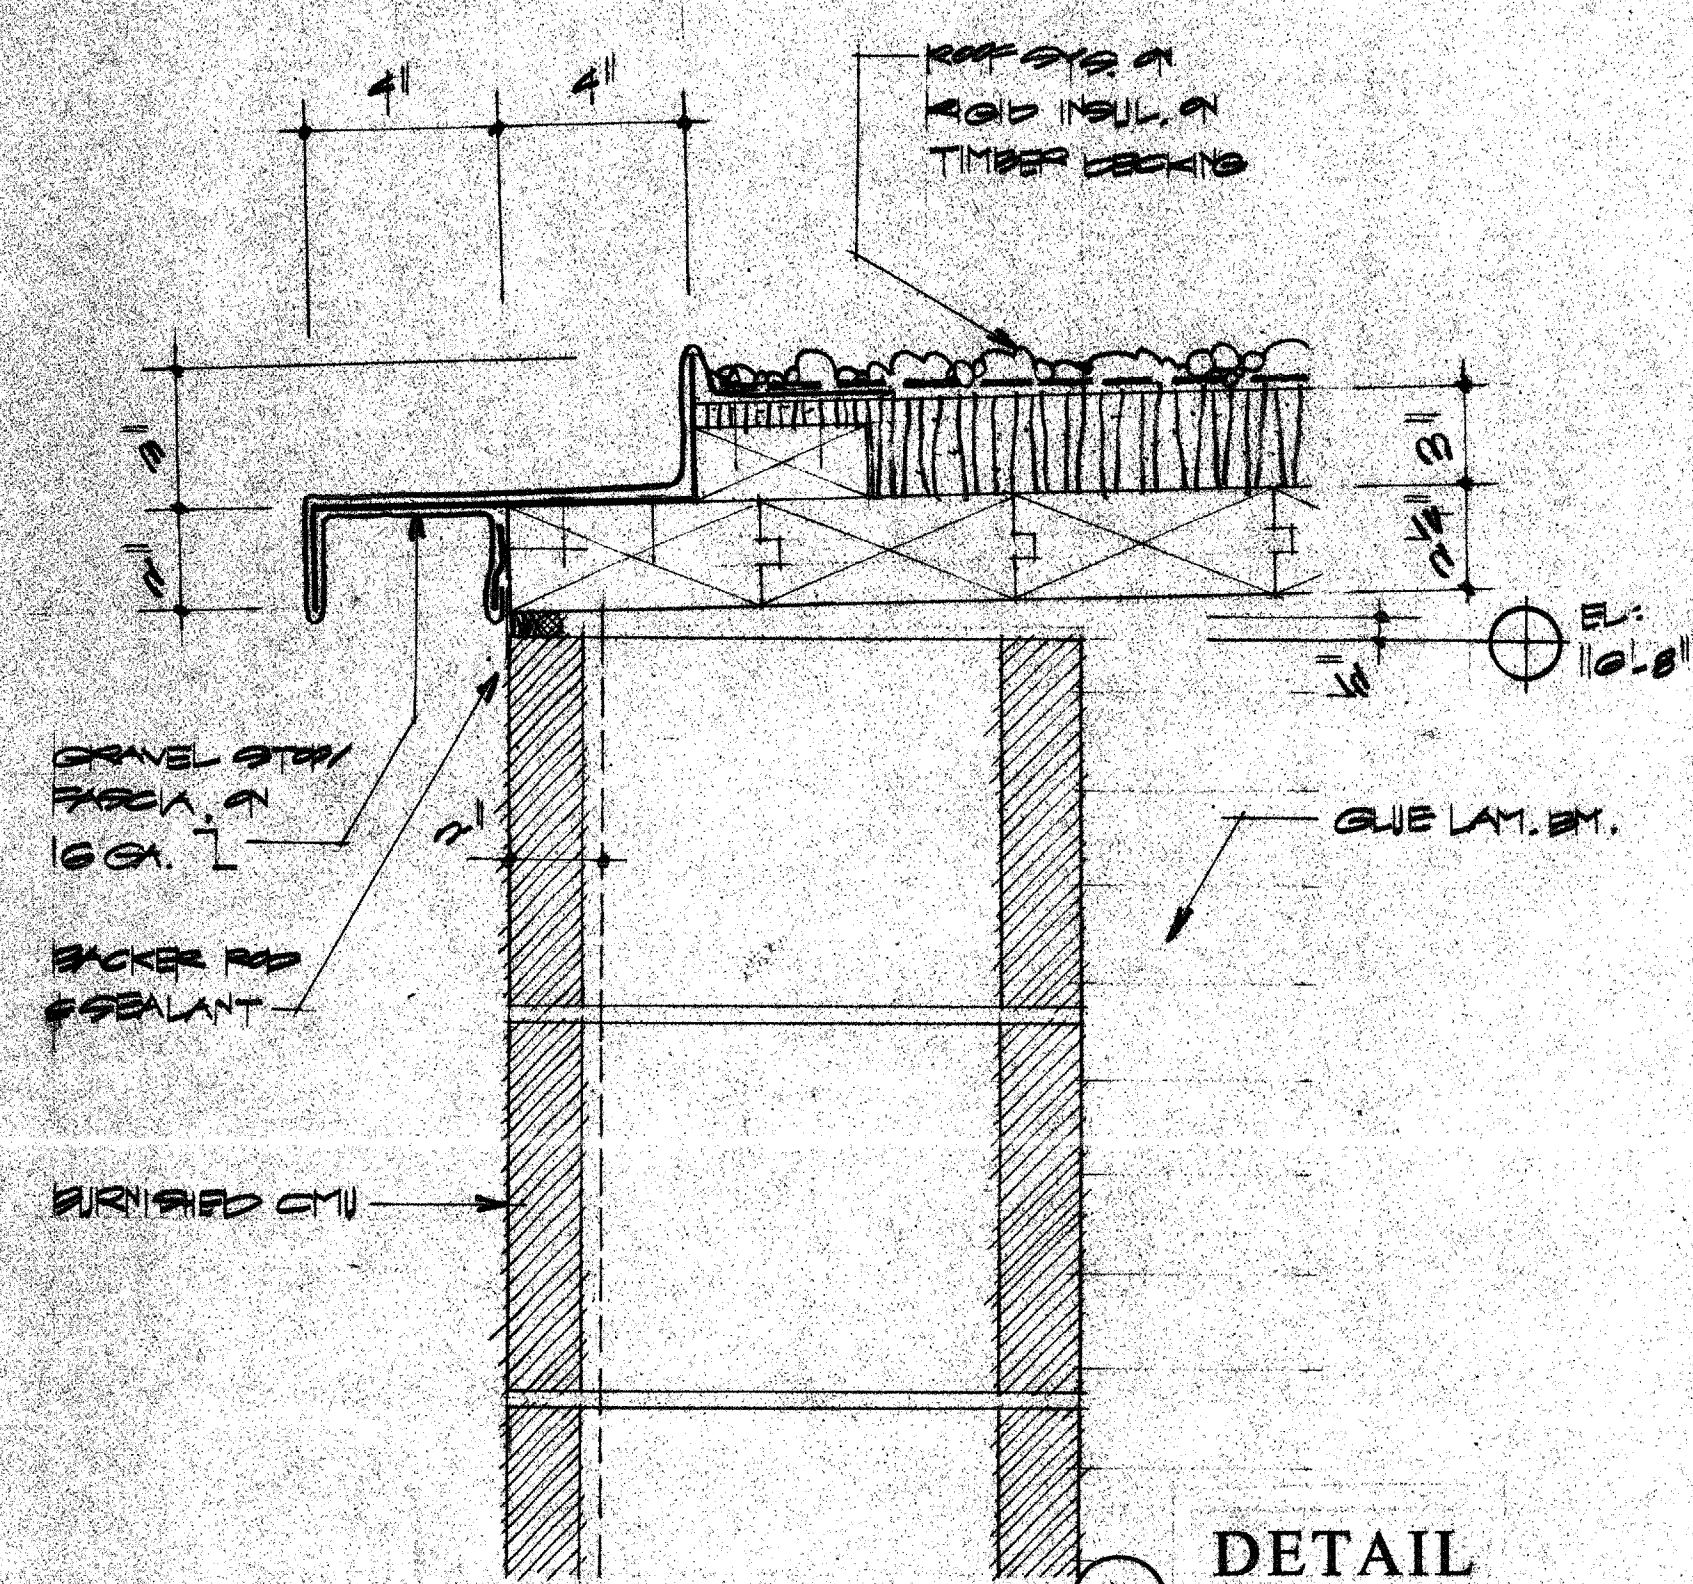


10 DETAIL

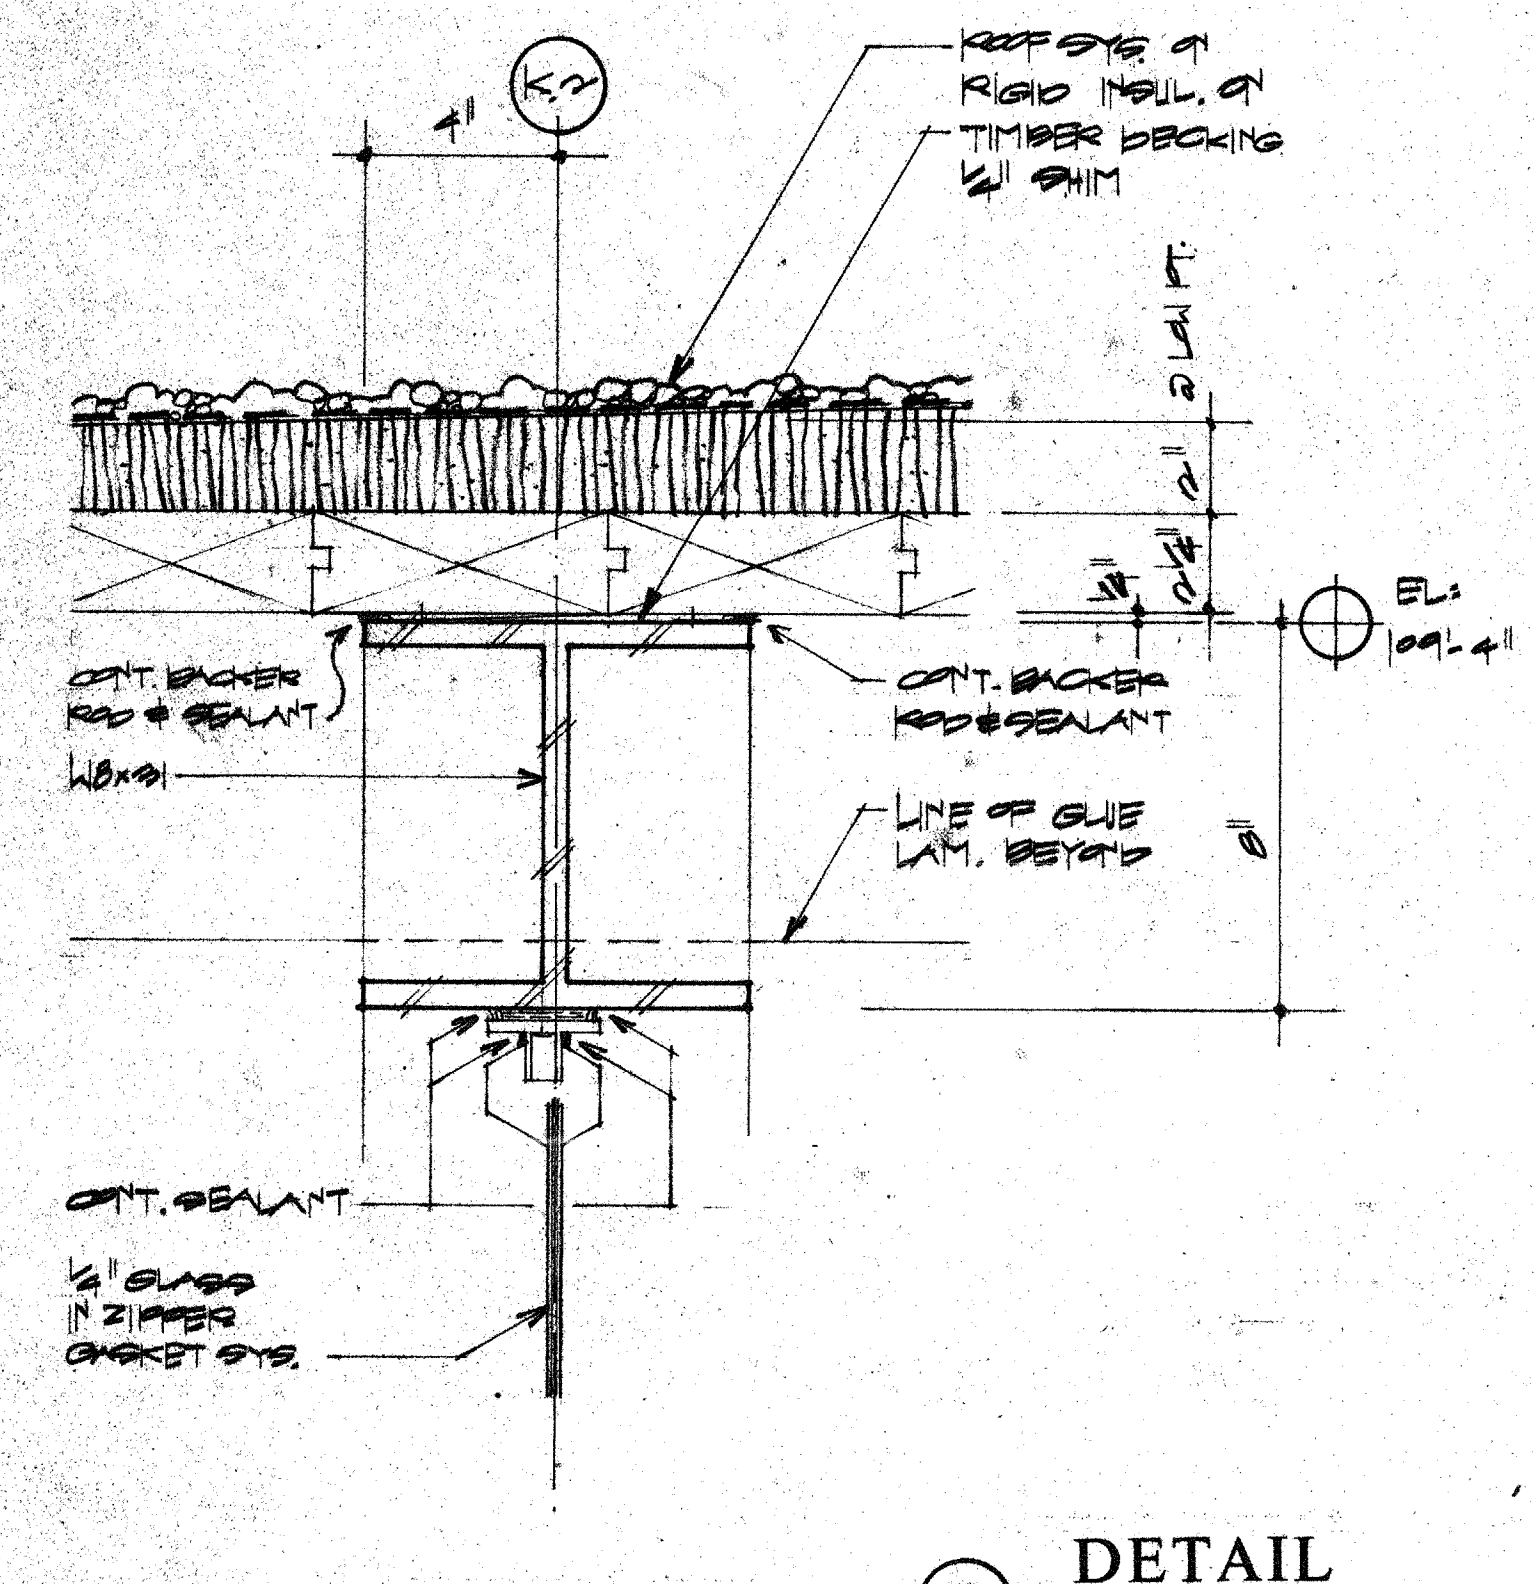


9 DETAIL

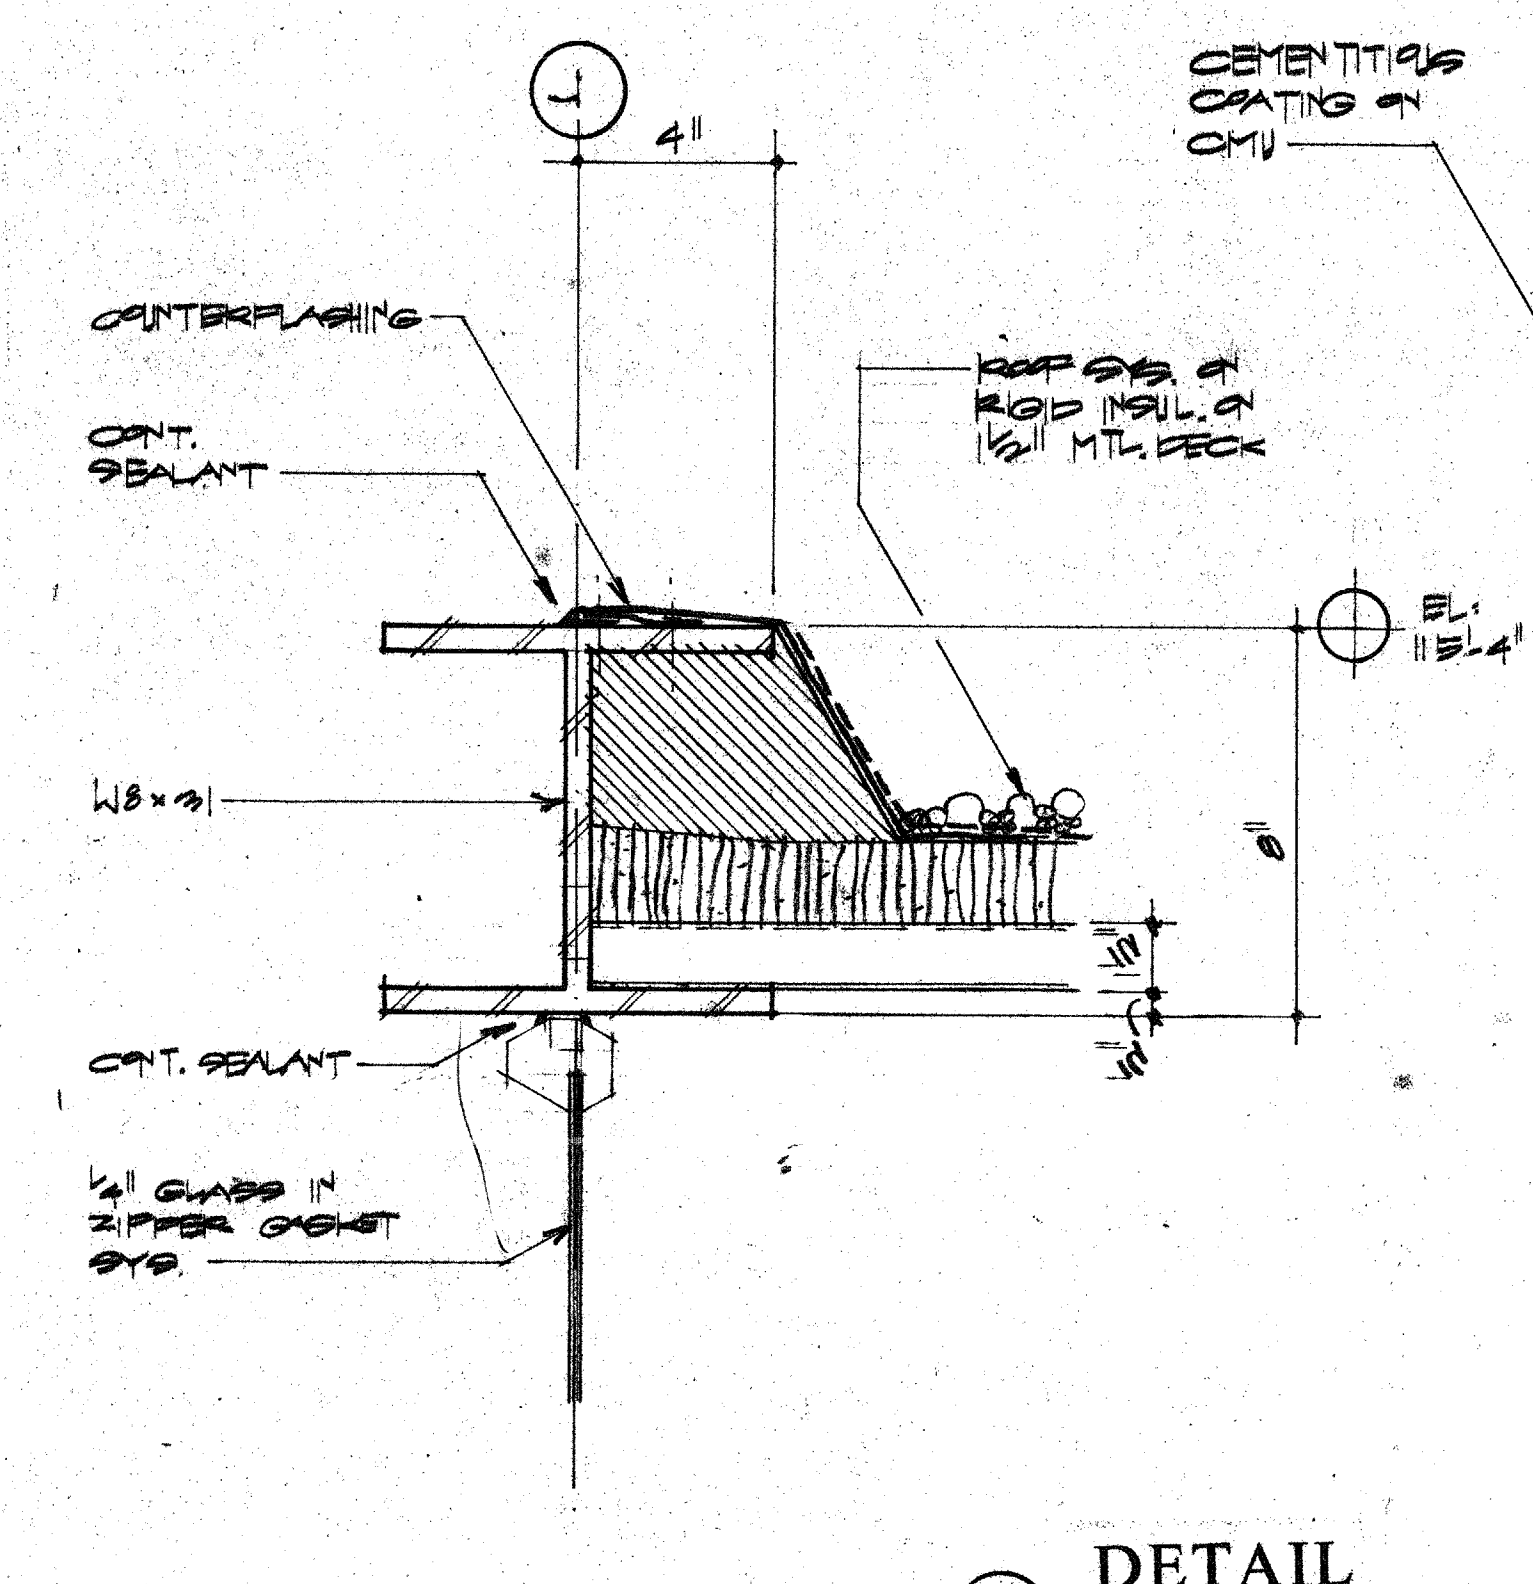


8 DETAIL

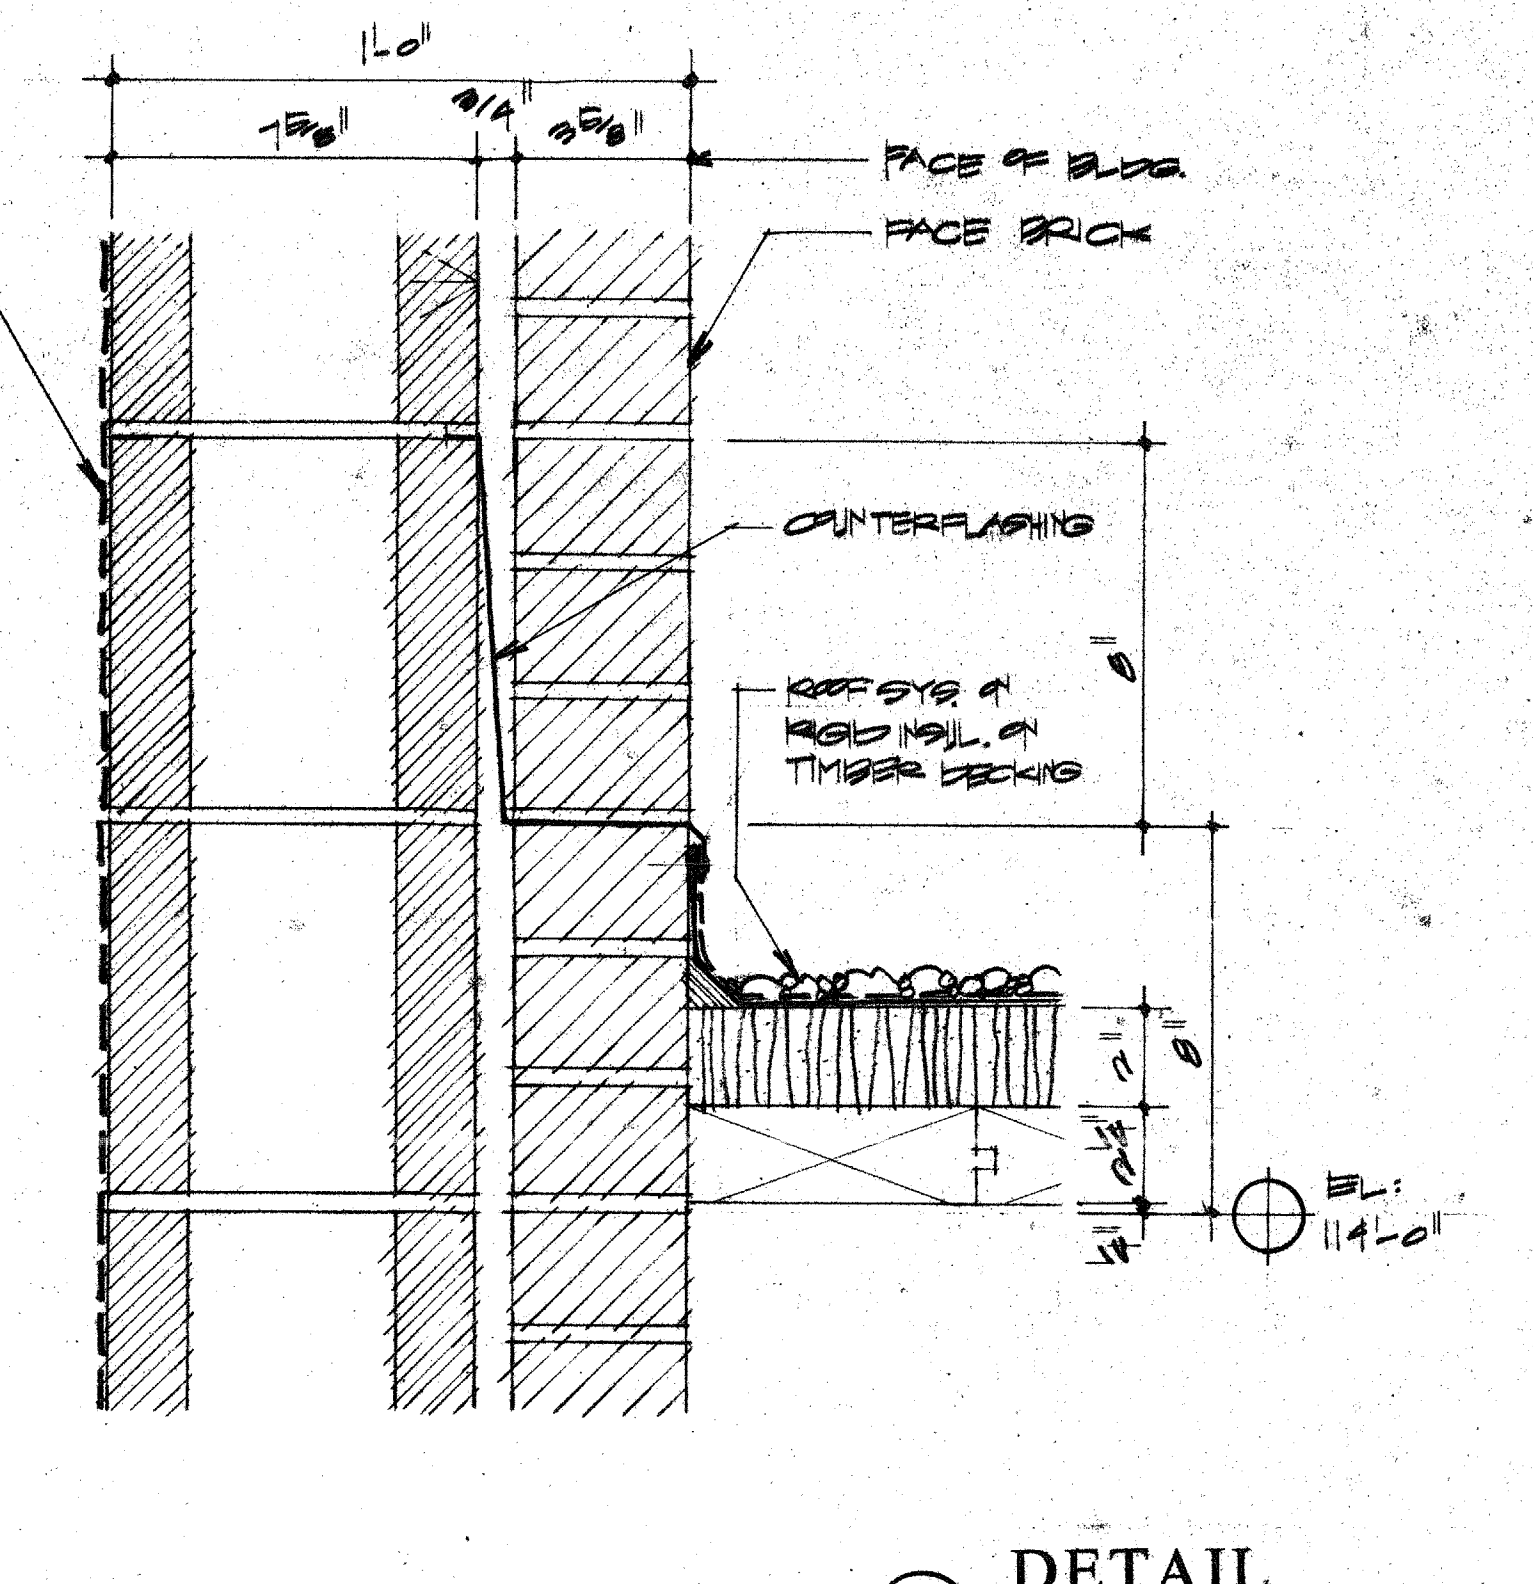


7 DETAIL

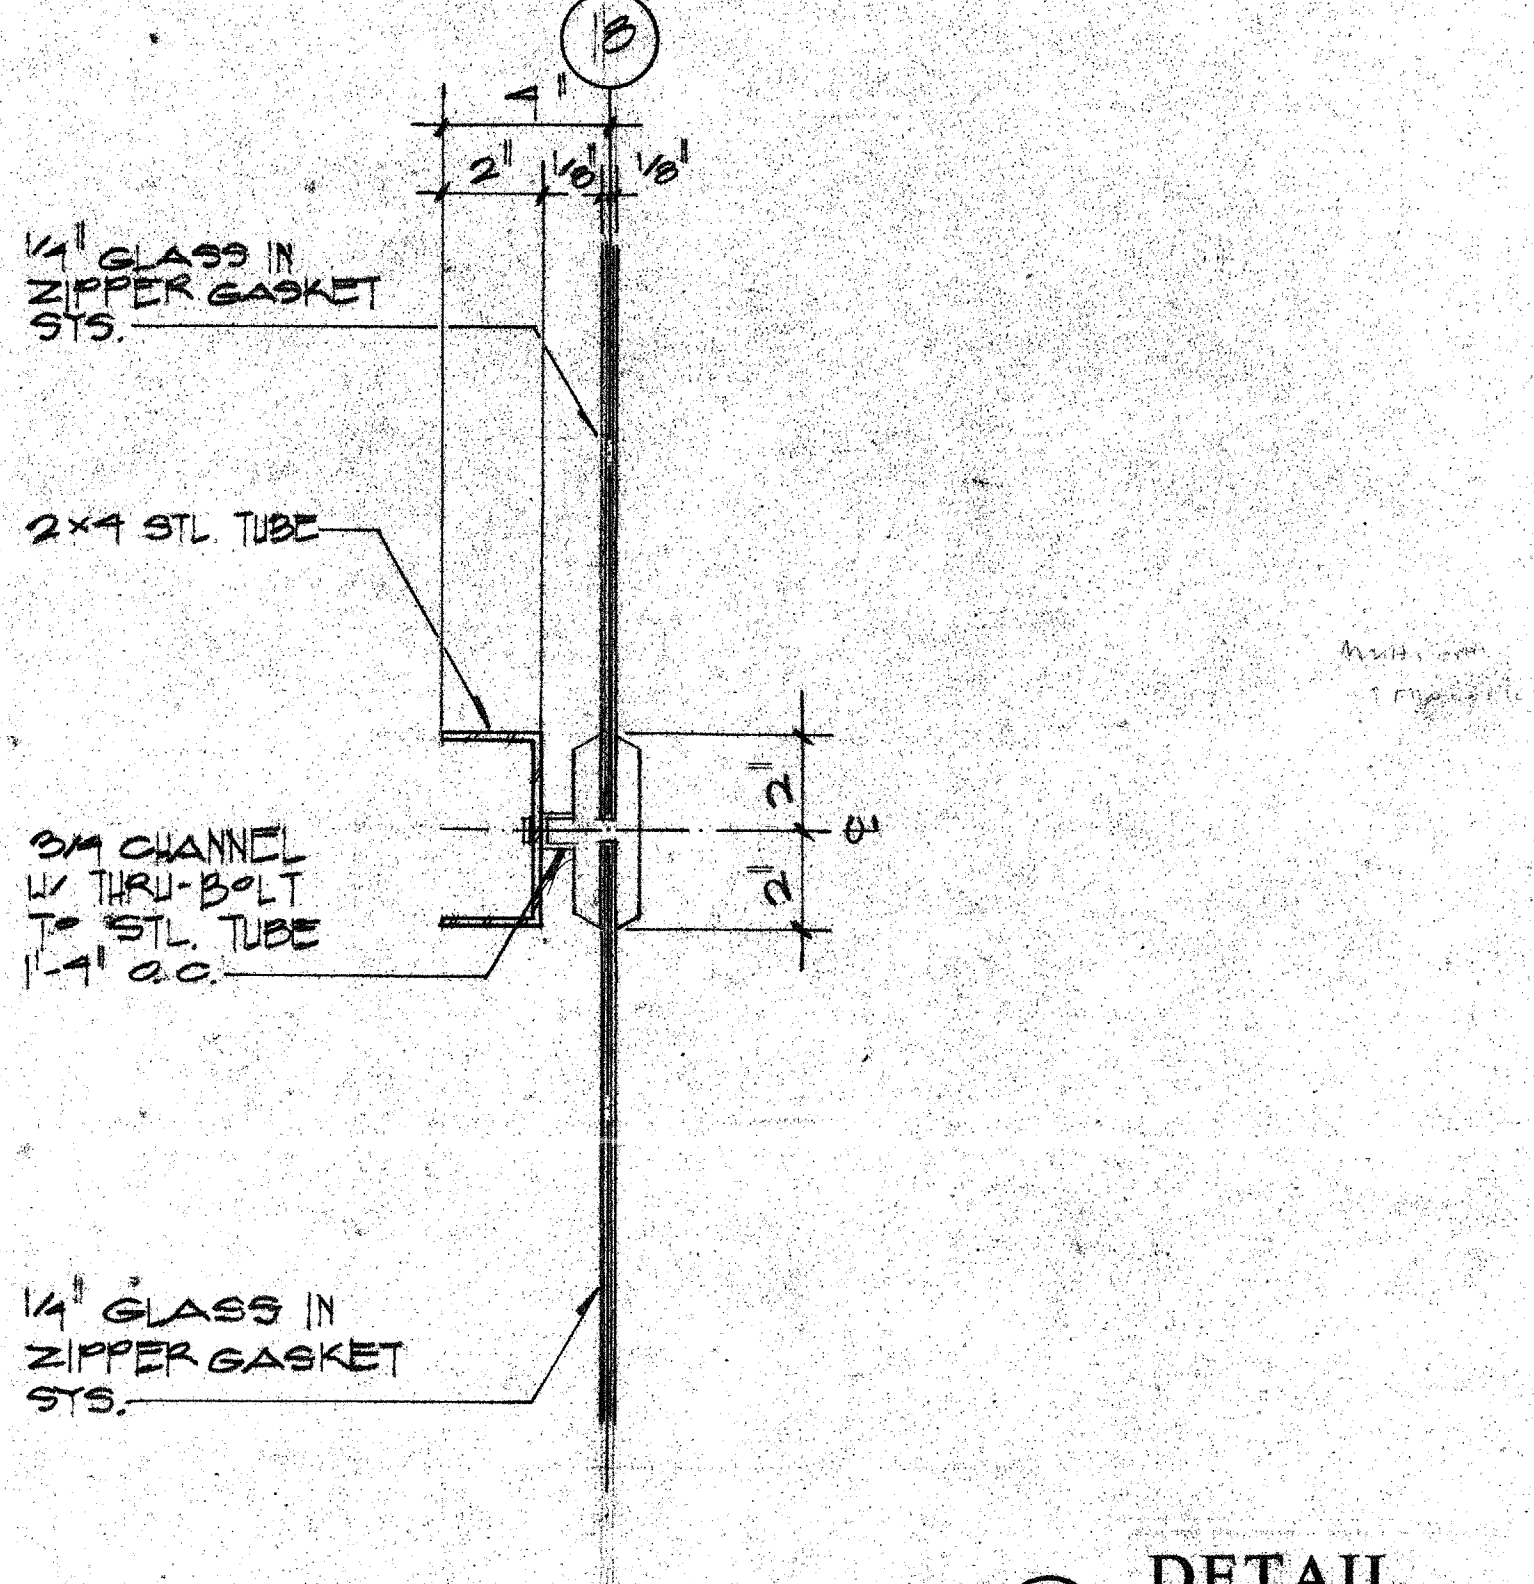


6 DETAIL

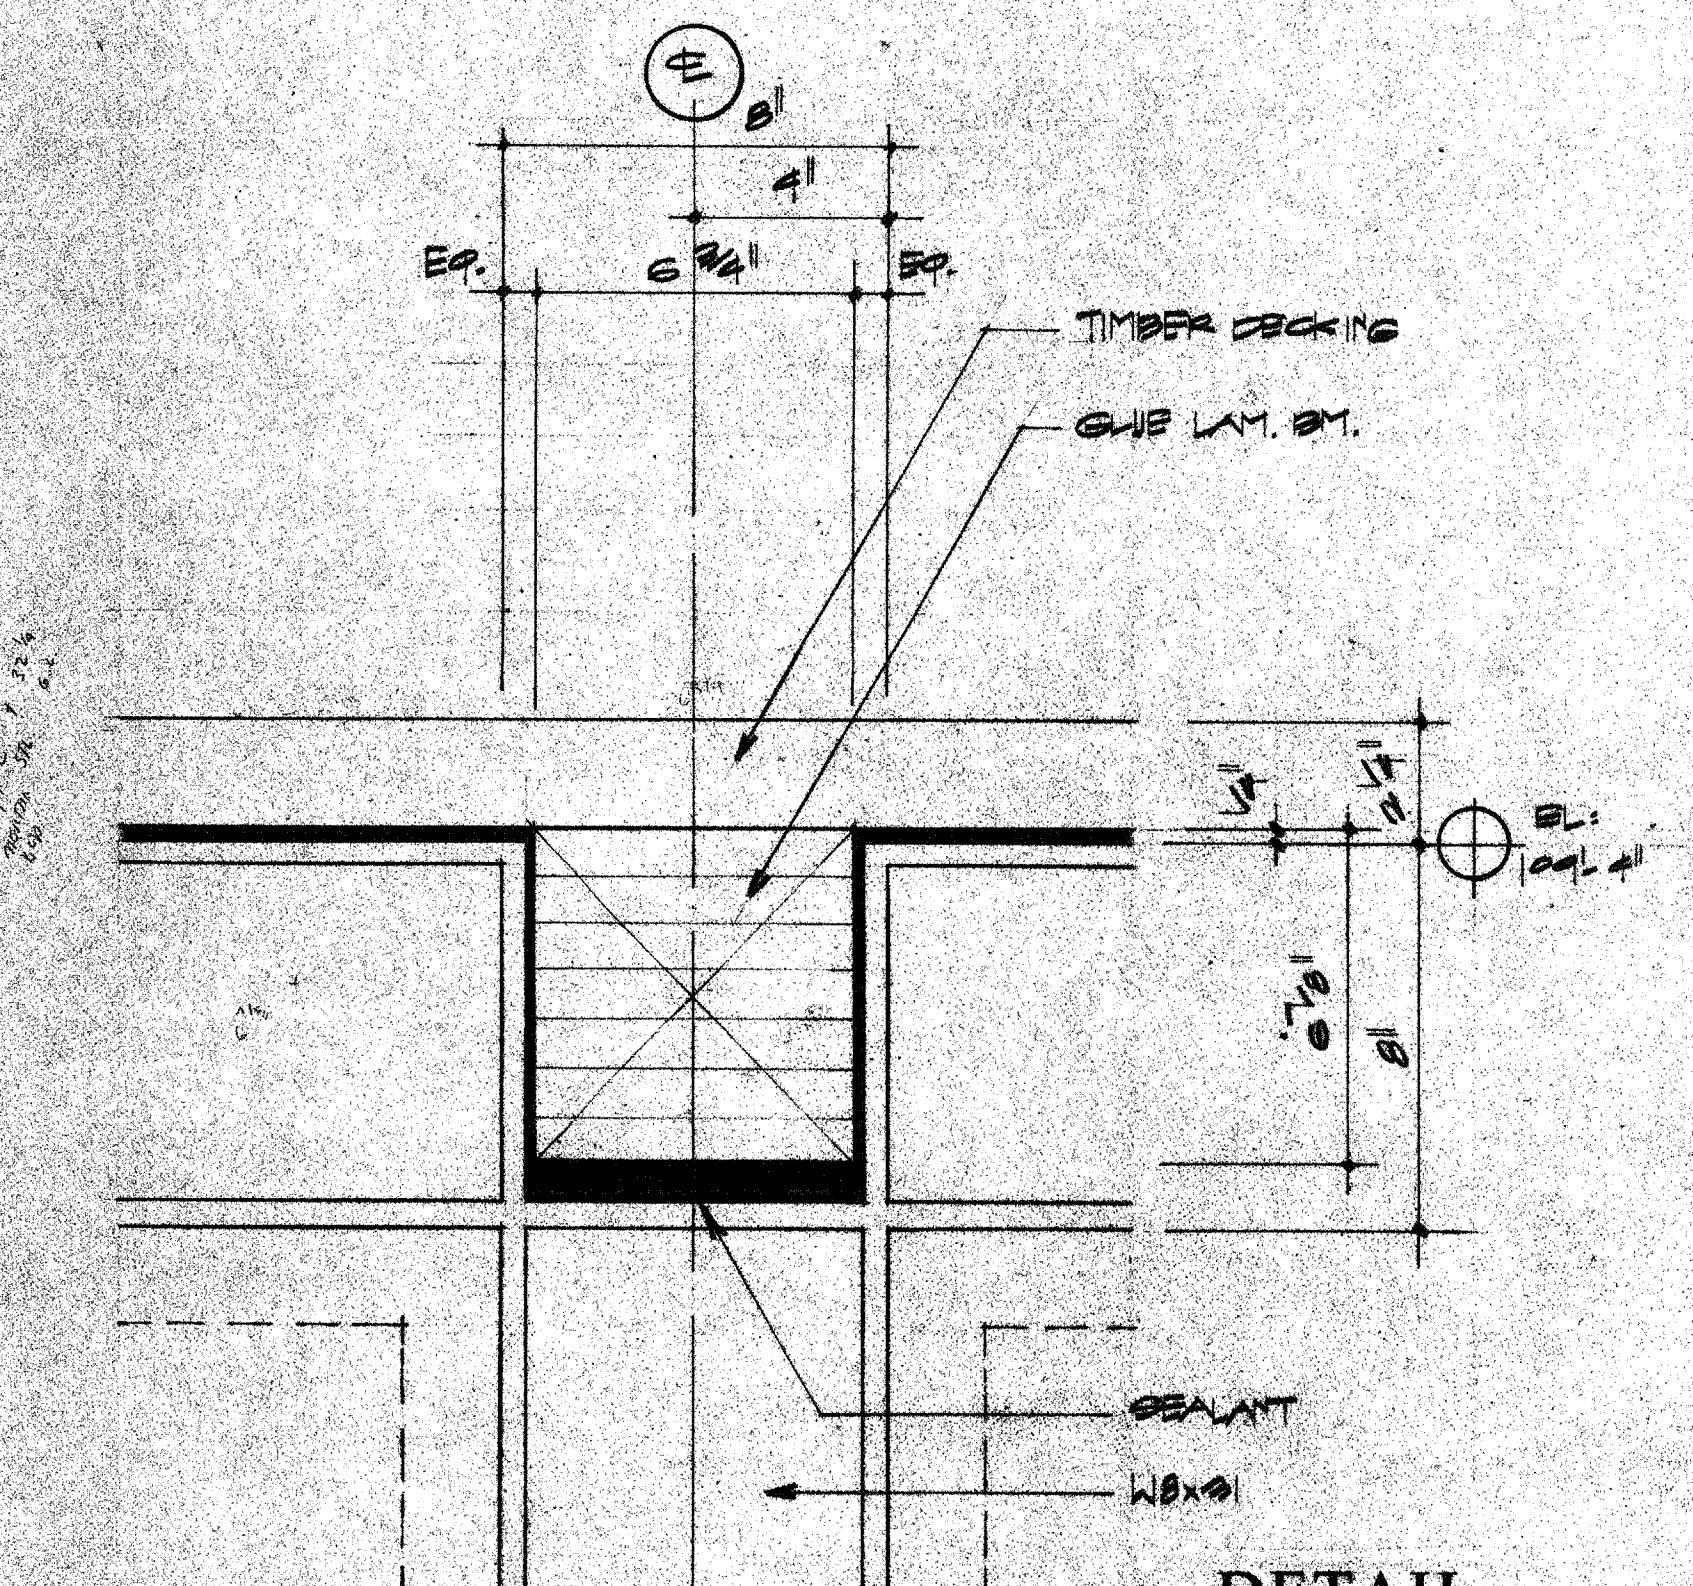


5 DETAIL

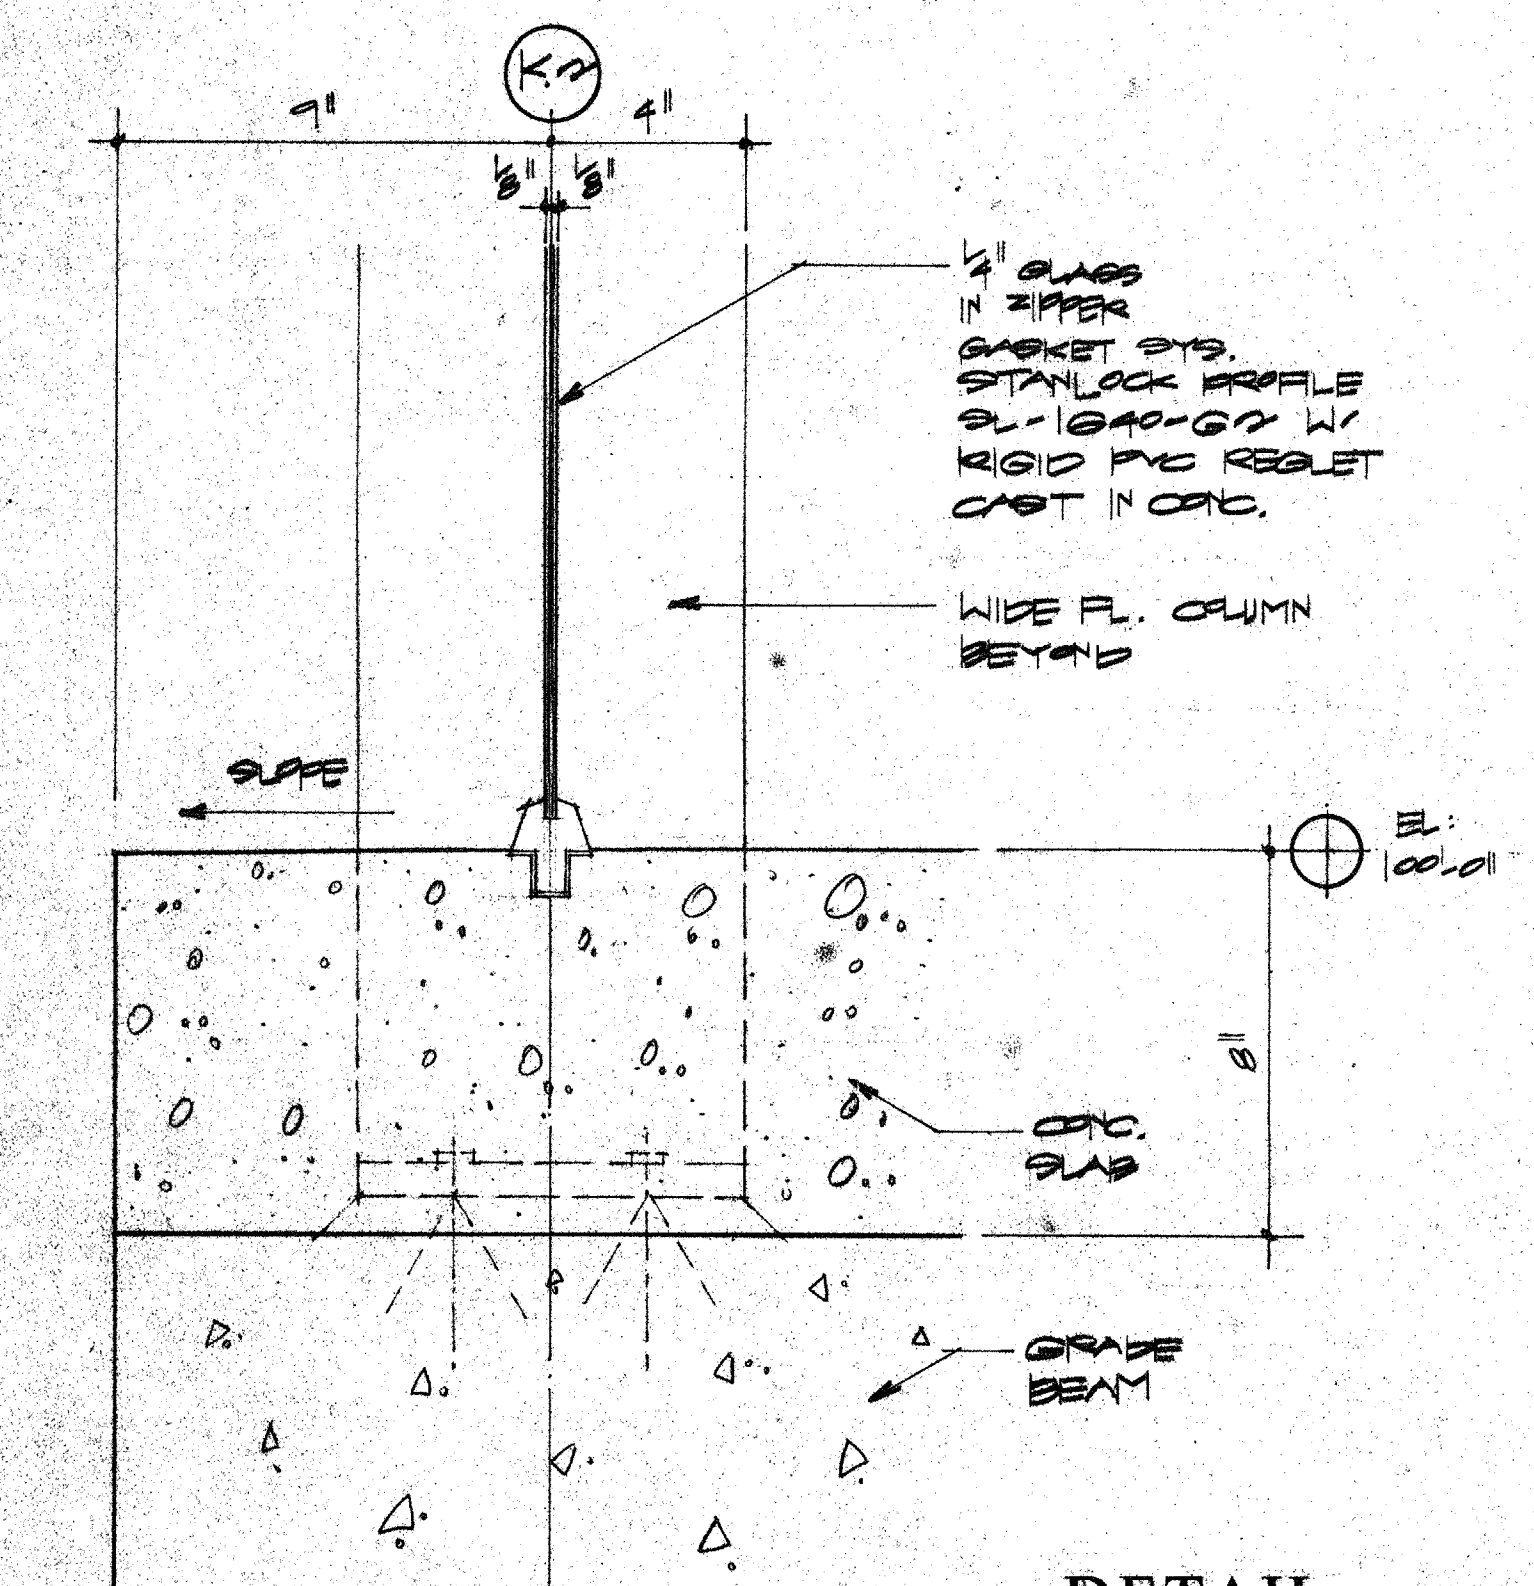


4 DETAIL

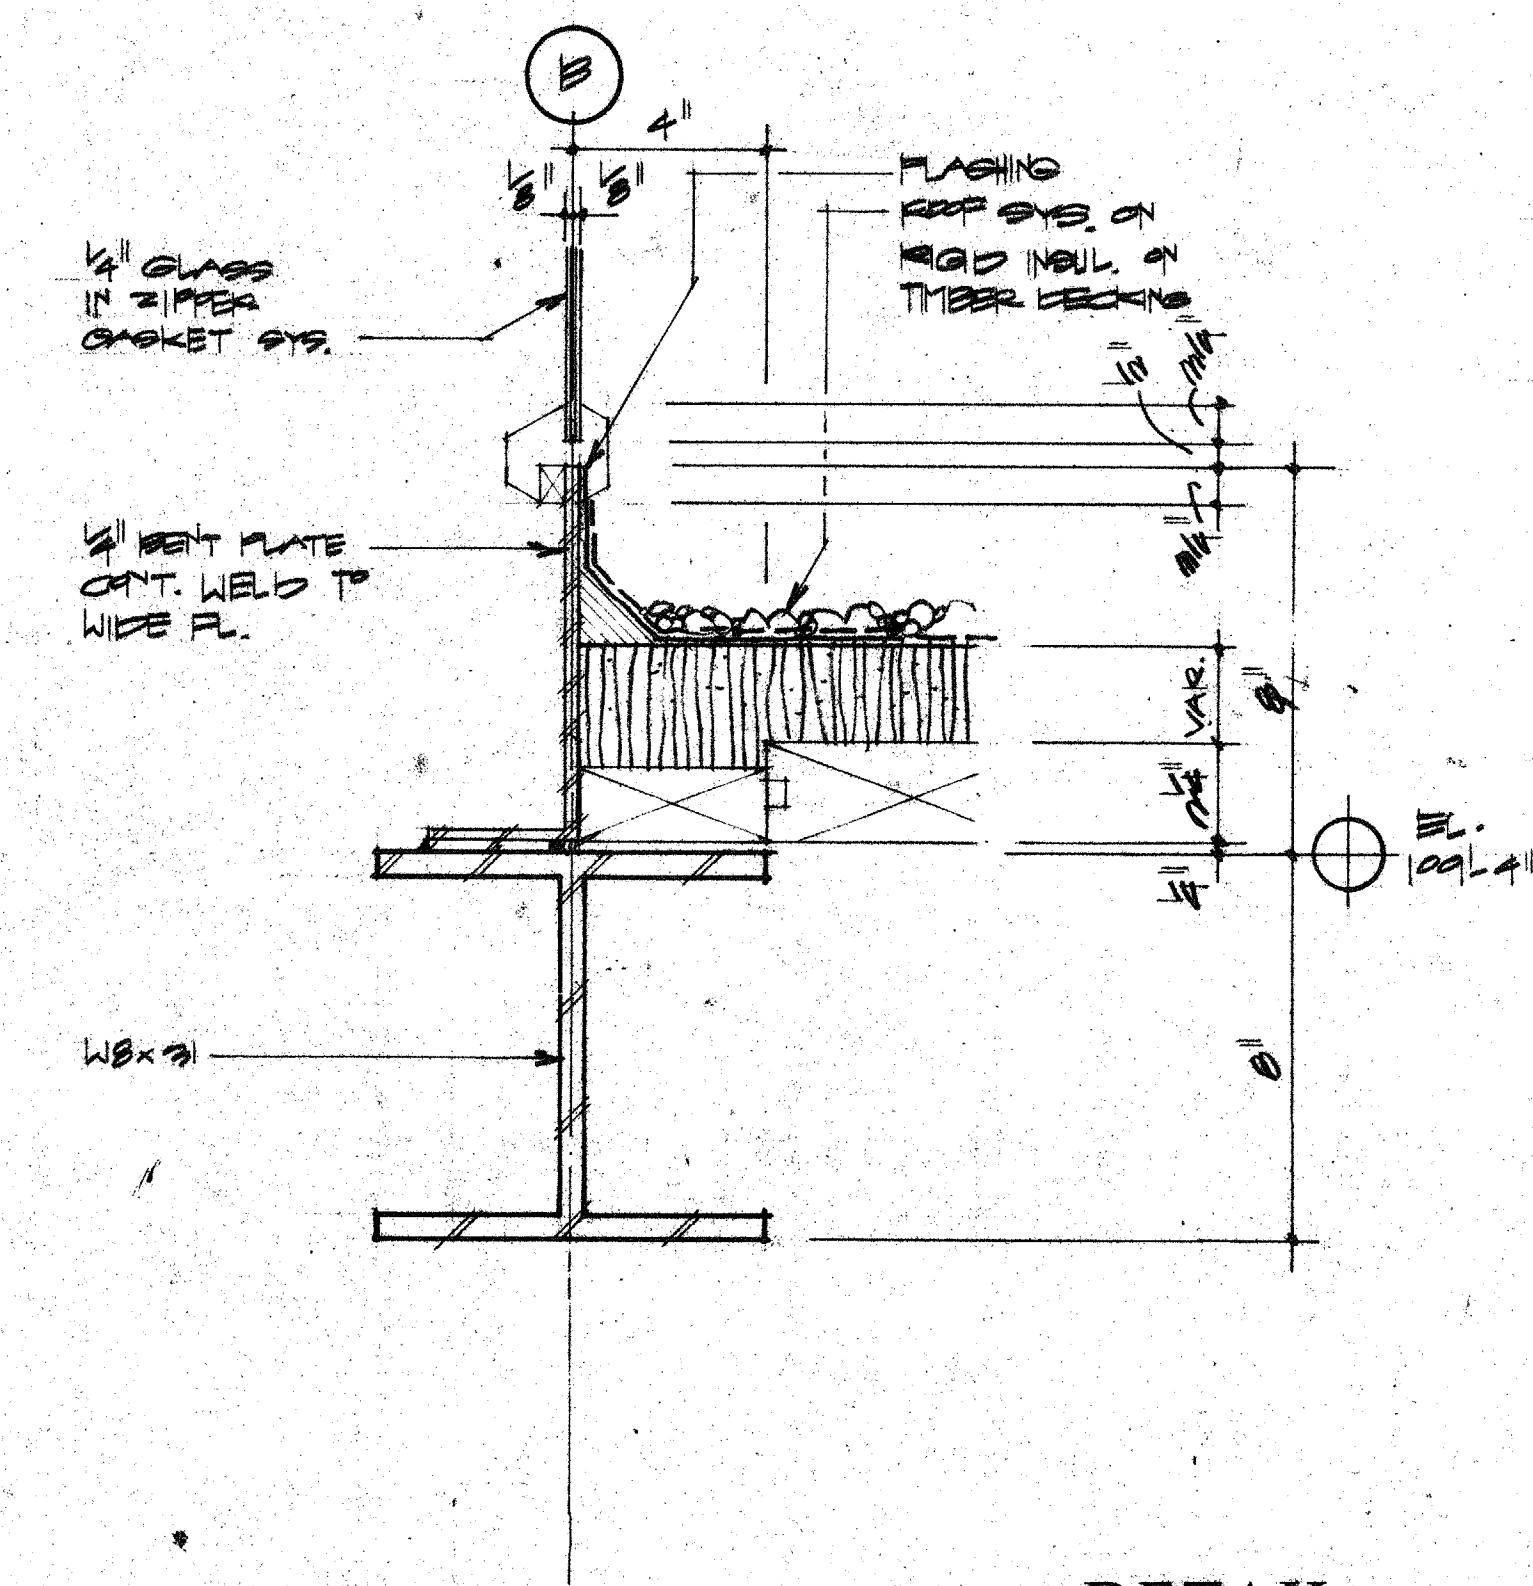

3 DETAIL

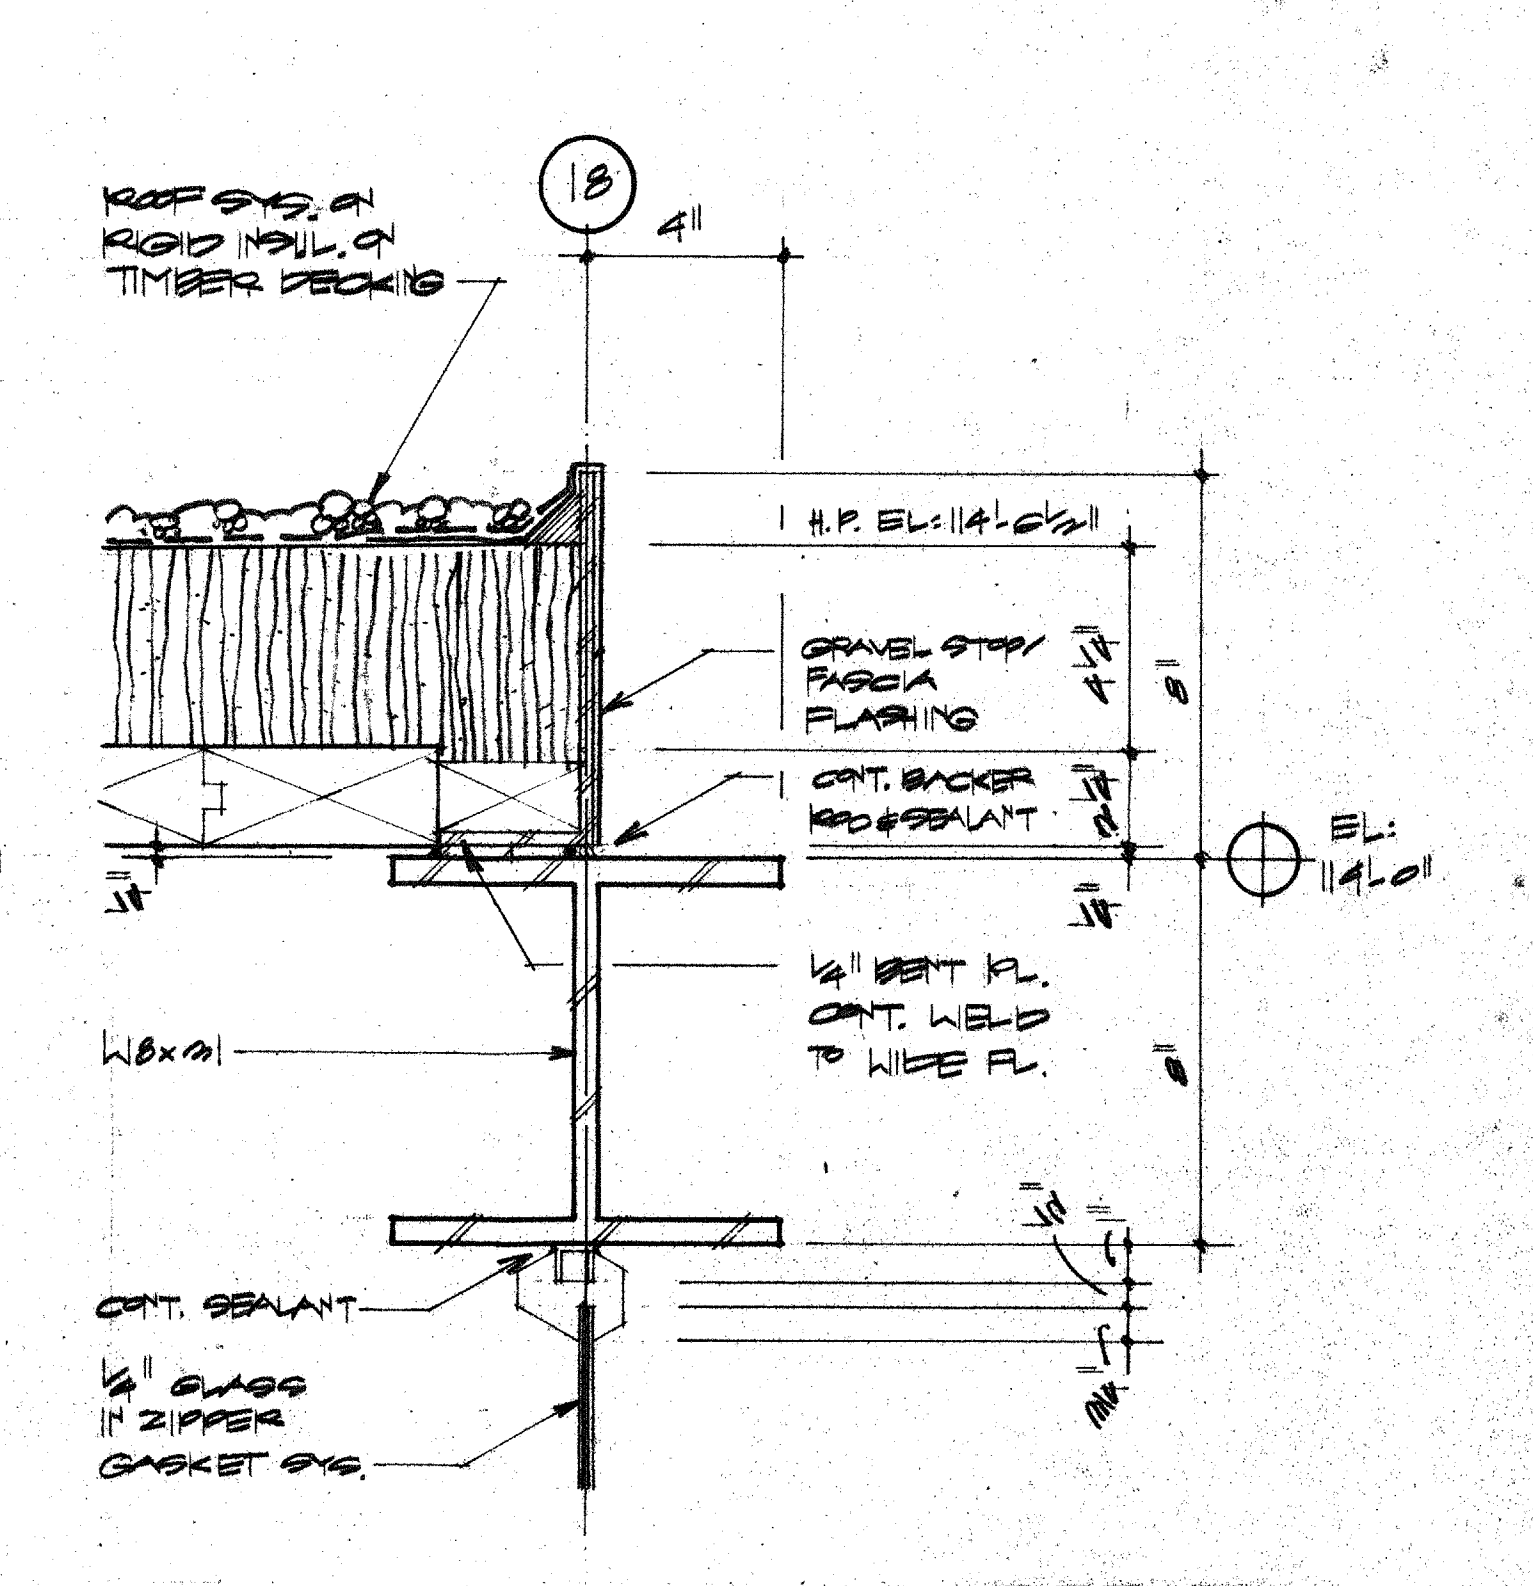

2 DETAIL

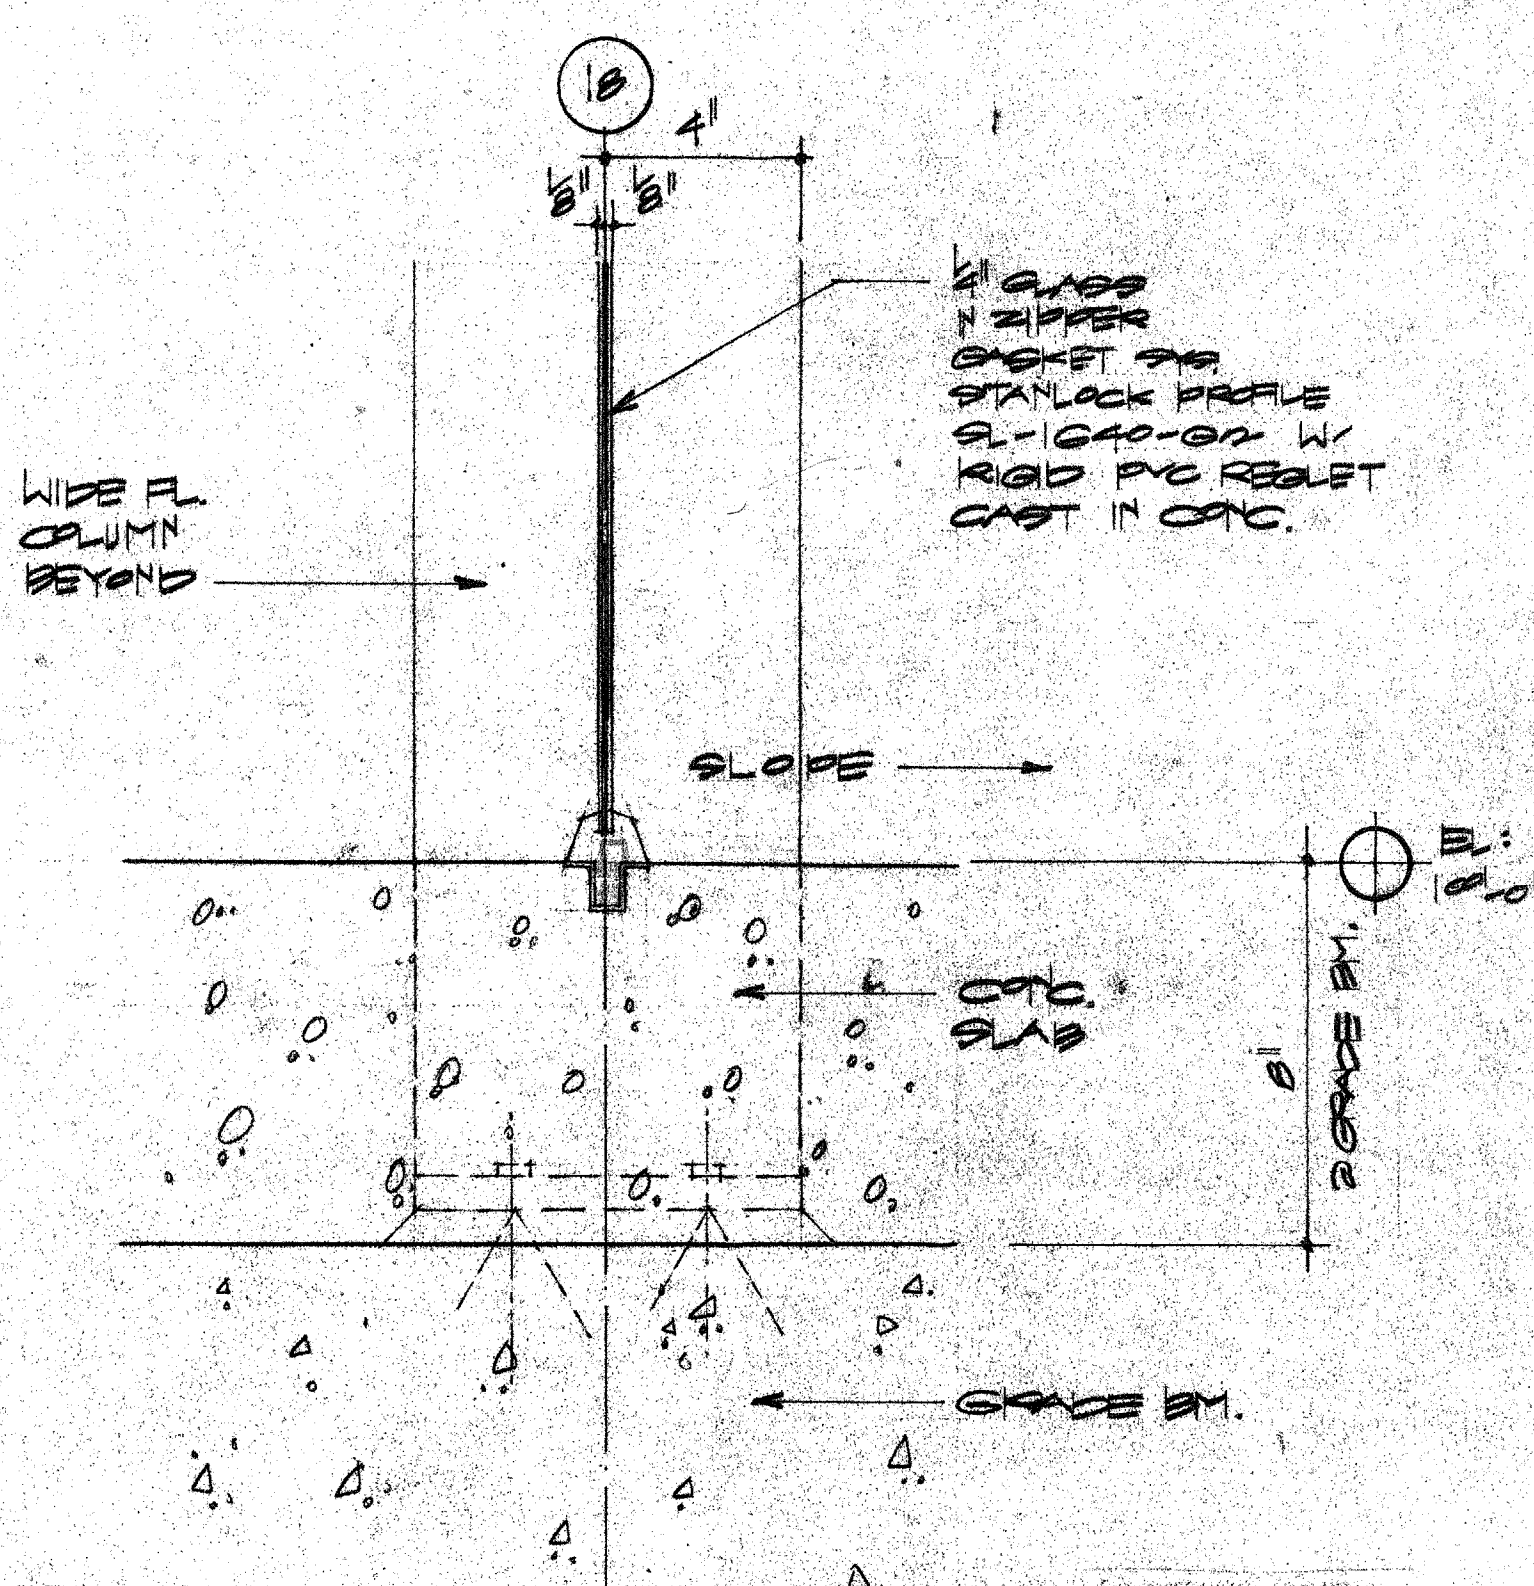

1 DETAIL



ACC ACT

OWNER
Town of Addison
The Kellars Group
331-776-9417

ARCHITECT
Cunningham Architects
2700 Fairmount
Dallas, Texas 75201
214-851-5272

LANDSCAPE
The Kellars Group
331-776-9417

THEATRE CONSULTANT
Theatre Projects
203-431-5845

INTERIORS
CRSS
710-582-2000

STRUCTURAL
Ellis Tanner
214-397-9393

M.E.P.
MEP Systems
214-754-4741

CIVIL
Kurtz & Associates
214-693-3322

HISTORIAN
Alan Mason
214-687-7162

LIGHTING
Planalyt Hill Wilson
214-628-6542

GRAPHICS
Notated Design
214-854-8976

Issue	Category	Subcategory	Sheet
ISSUE FOR BID 8-17-80	4	9	1