




5 Roof Section
1/2" = 1'-0"

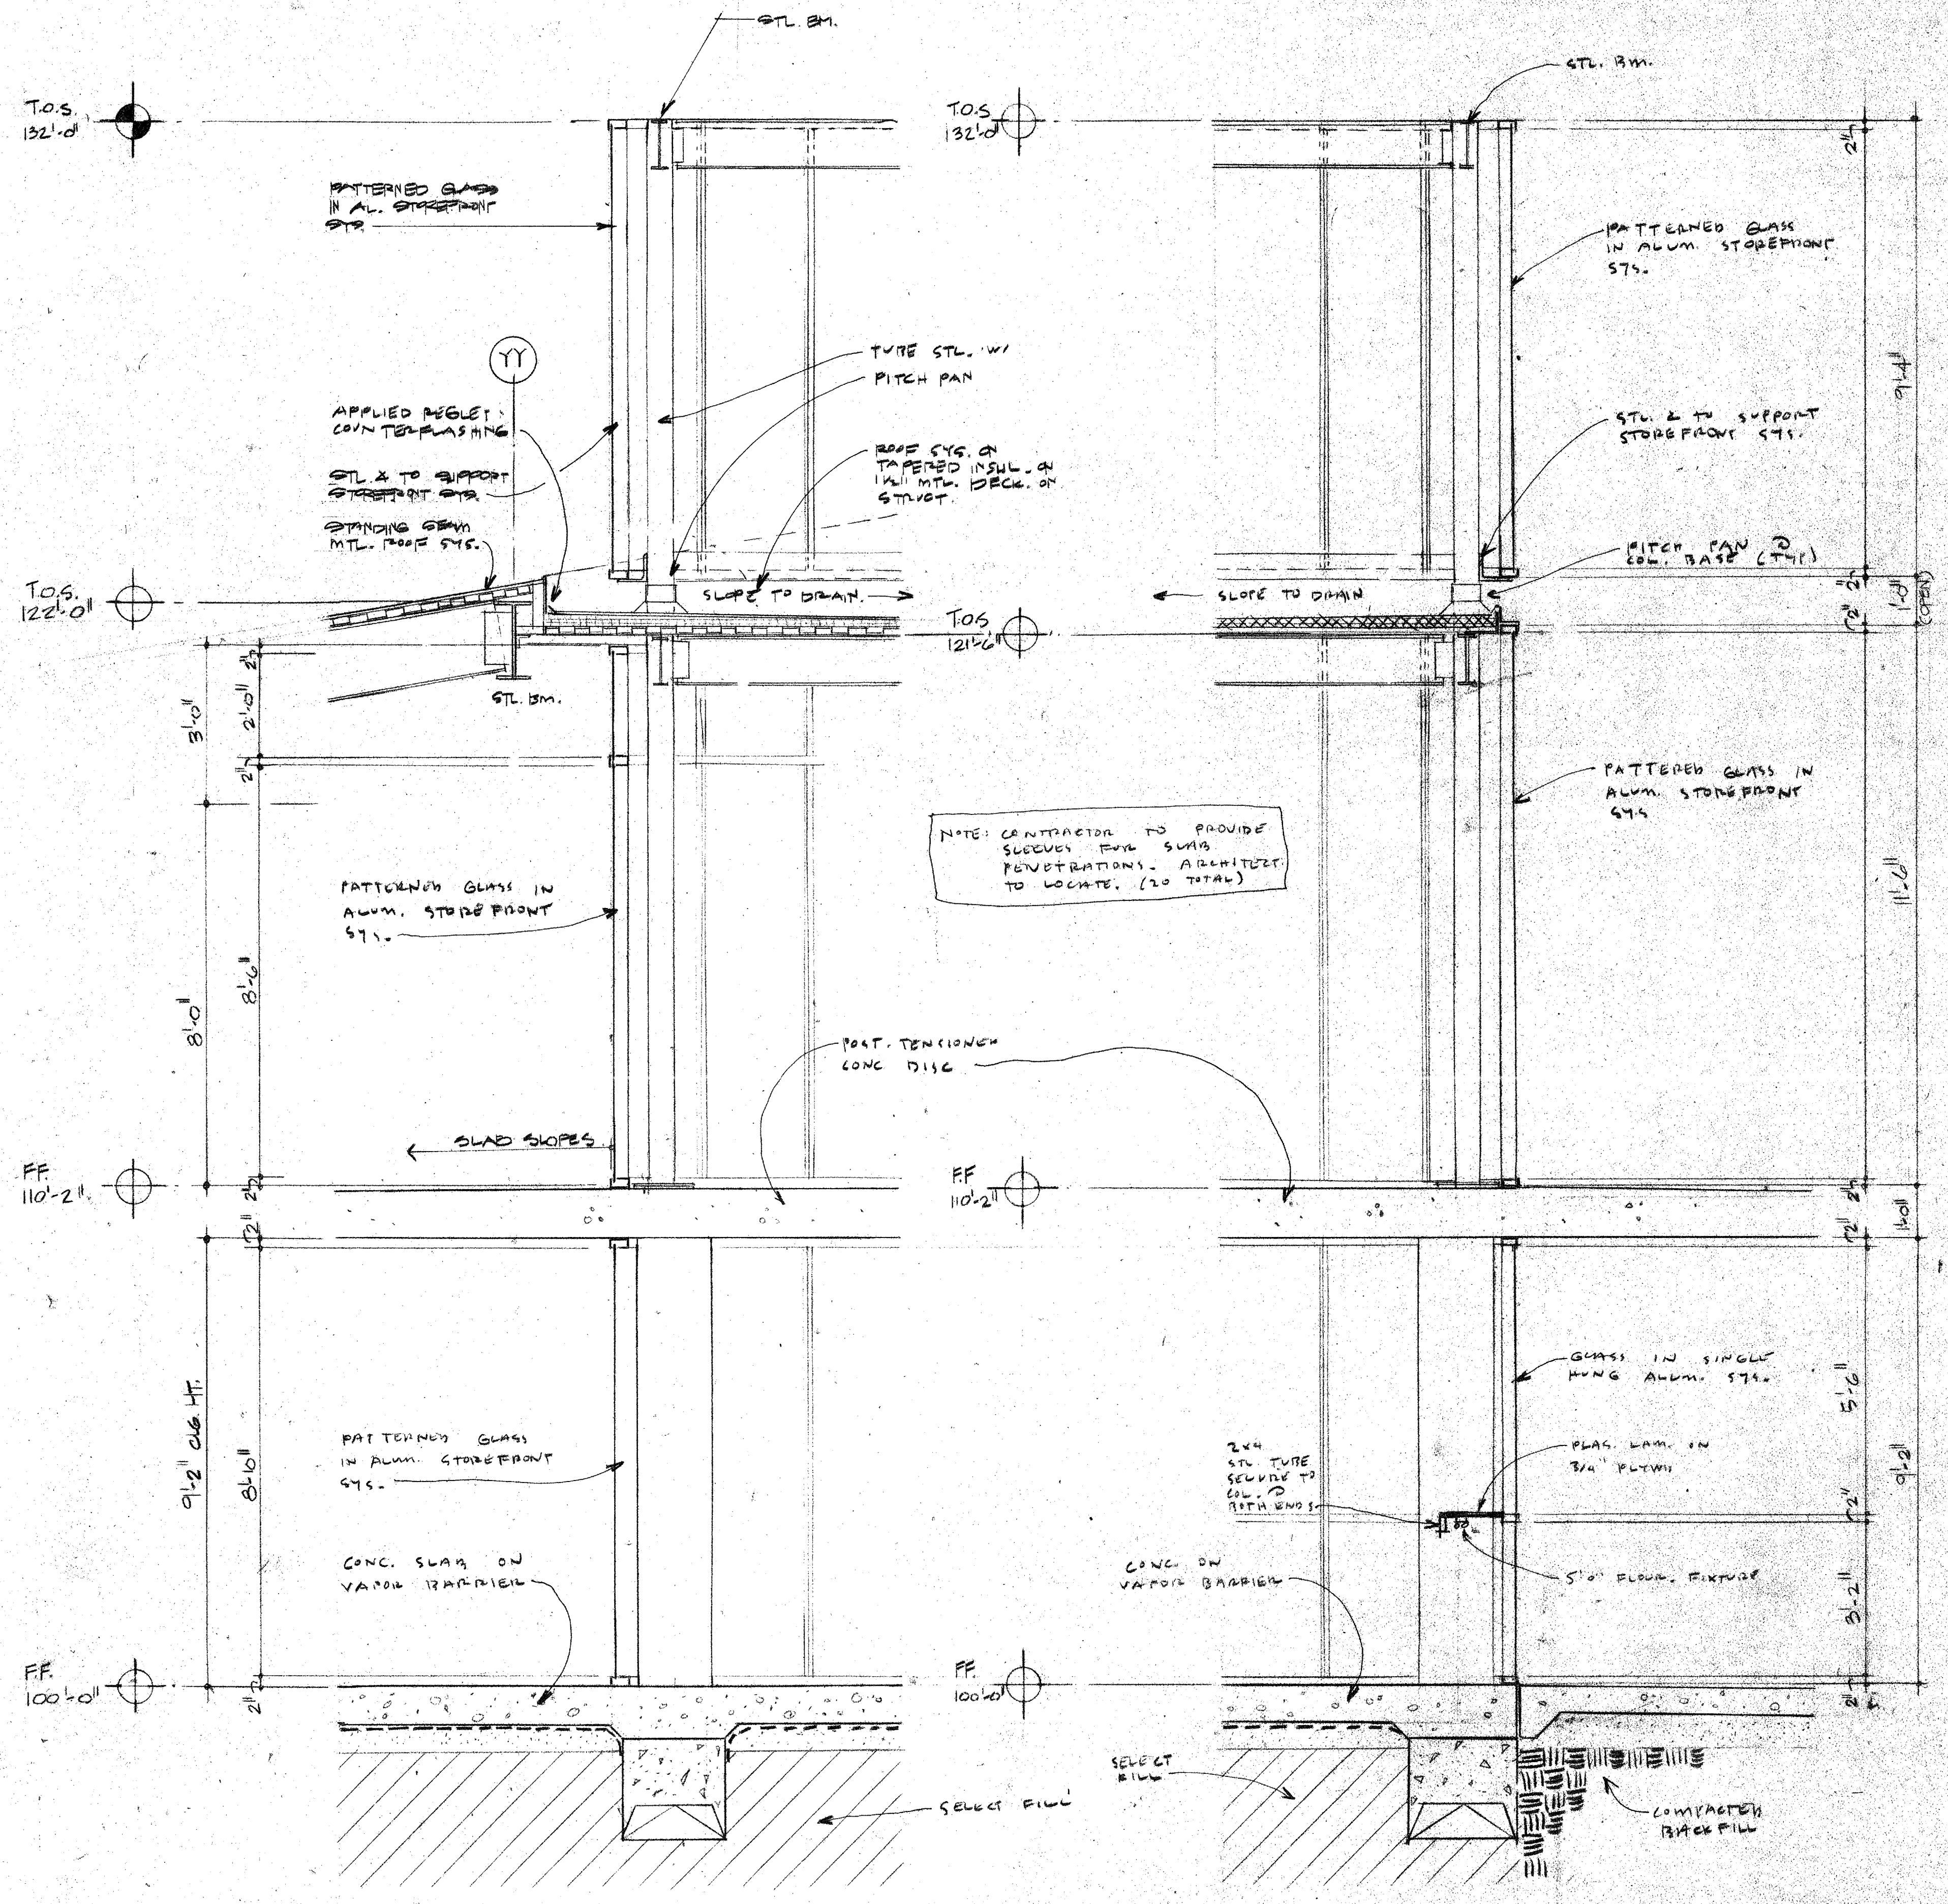


2 Wall Section
1/2" = 1'-0"

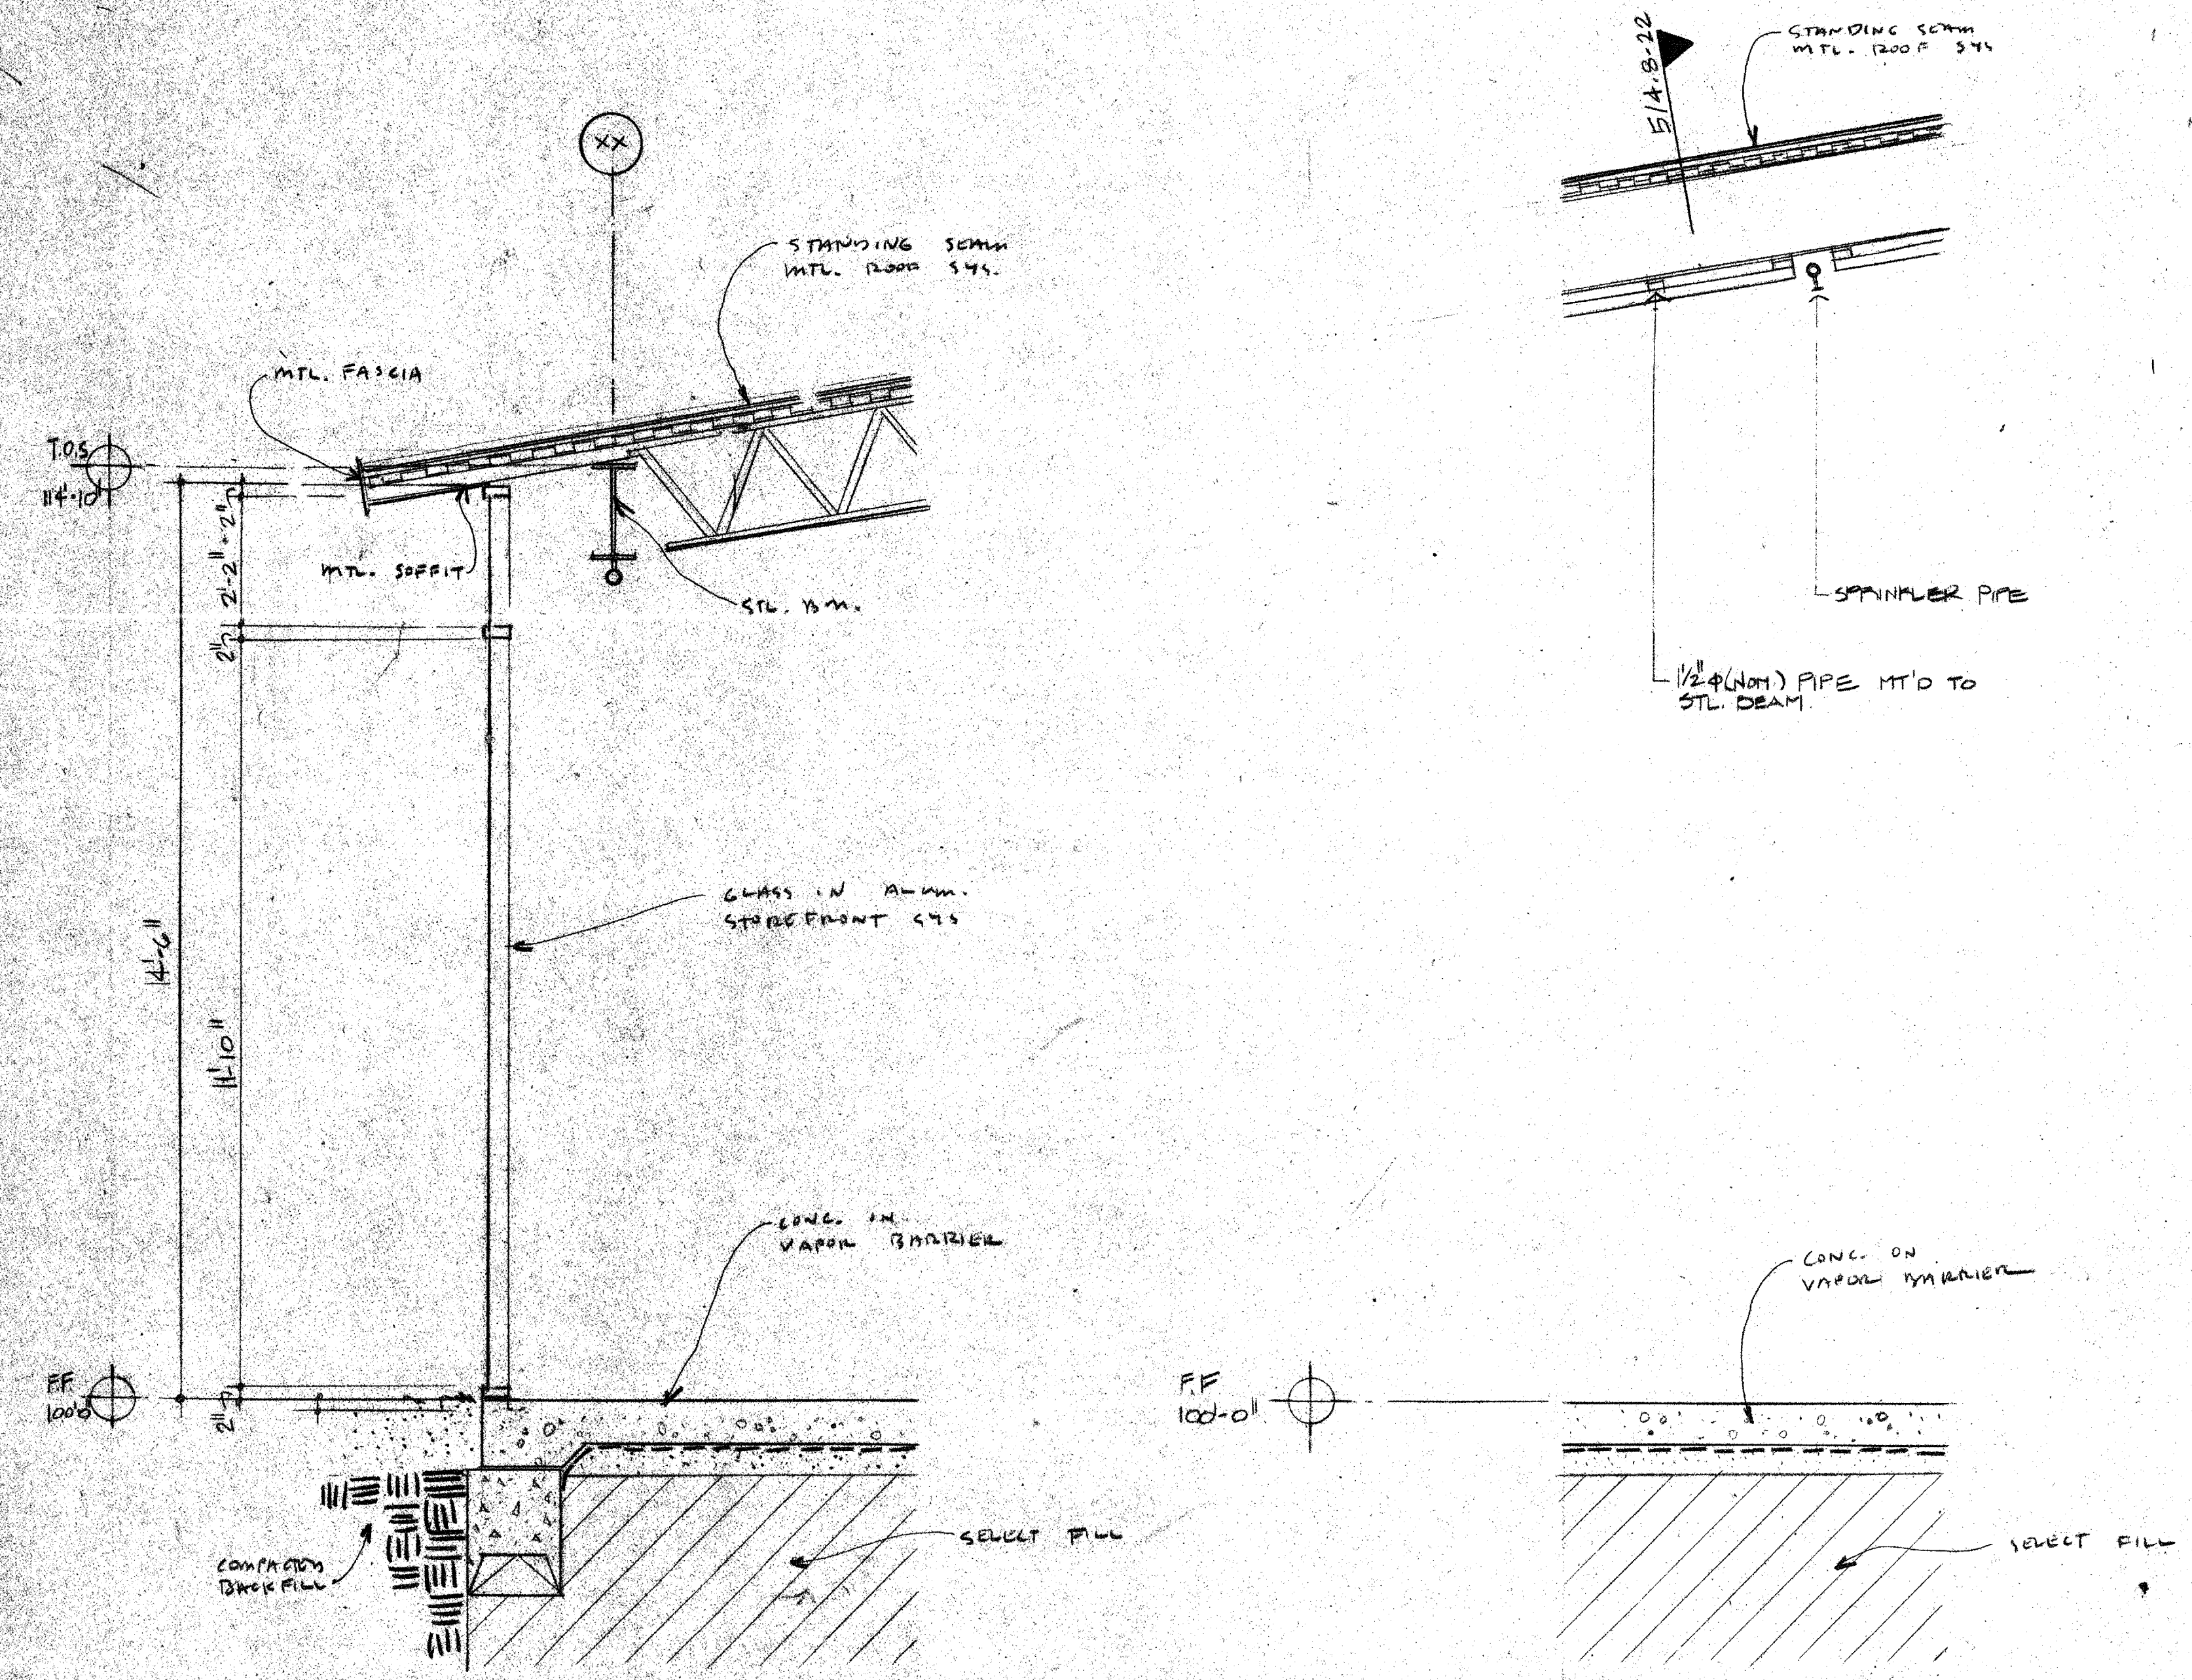

4 Wall Section
1/2" = 1'-0"

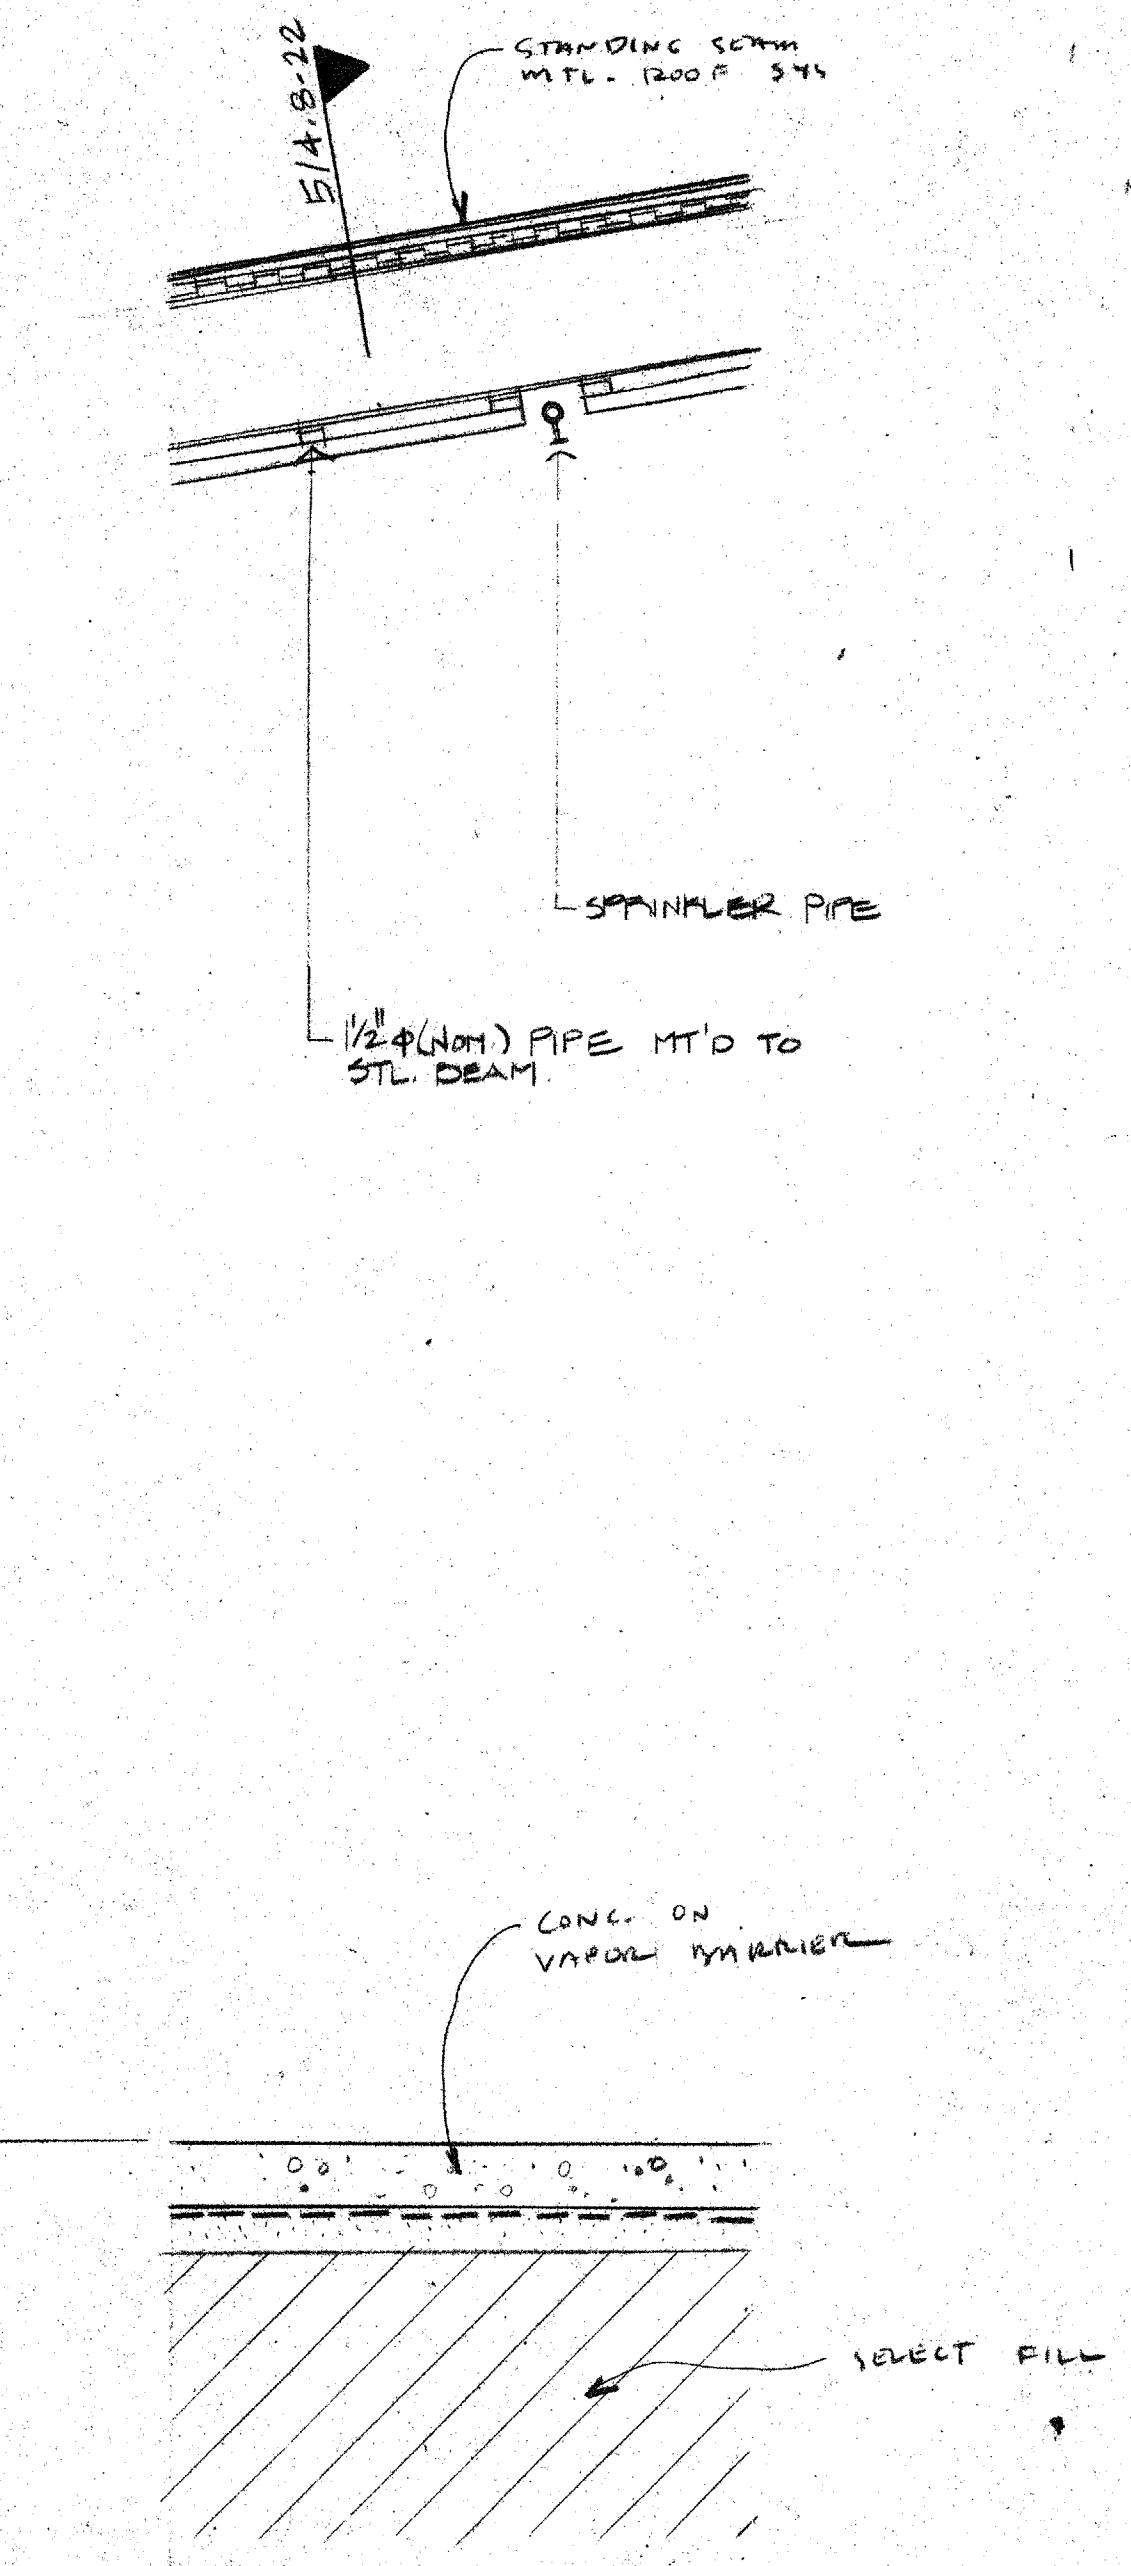

3 Wall Section
1/2" = 1'-0"

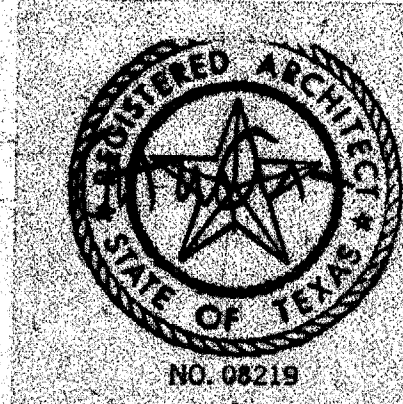

ACC ADDISON ACT

OWNER: The Sabers Group
 ARCHITECT: Cunningham Architects
 LANDSCAPE: The Sabers Group
 STRUCTURAL: Elmer Turner
 MECHANICAL/ELECTRICAL/PLUMBING (MEP): MEP Systems
 INTERIORS: Kure & Associates
 HISTORIC: Alan Mason
 LIGHTING: Pamela Hill Wilson
 GRAPHICS: Northstar Design

| Issue | Category | Subcategory | Sheet |
|-----------------------|----------|-------------|-------|
| ISSUE FOR BID 8-17-90 | 4 | 8 | 22 |