



3 WALL SECTION  
1"=1'-0"

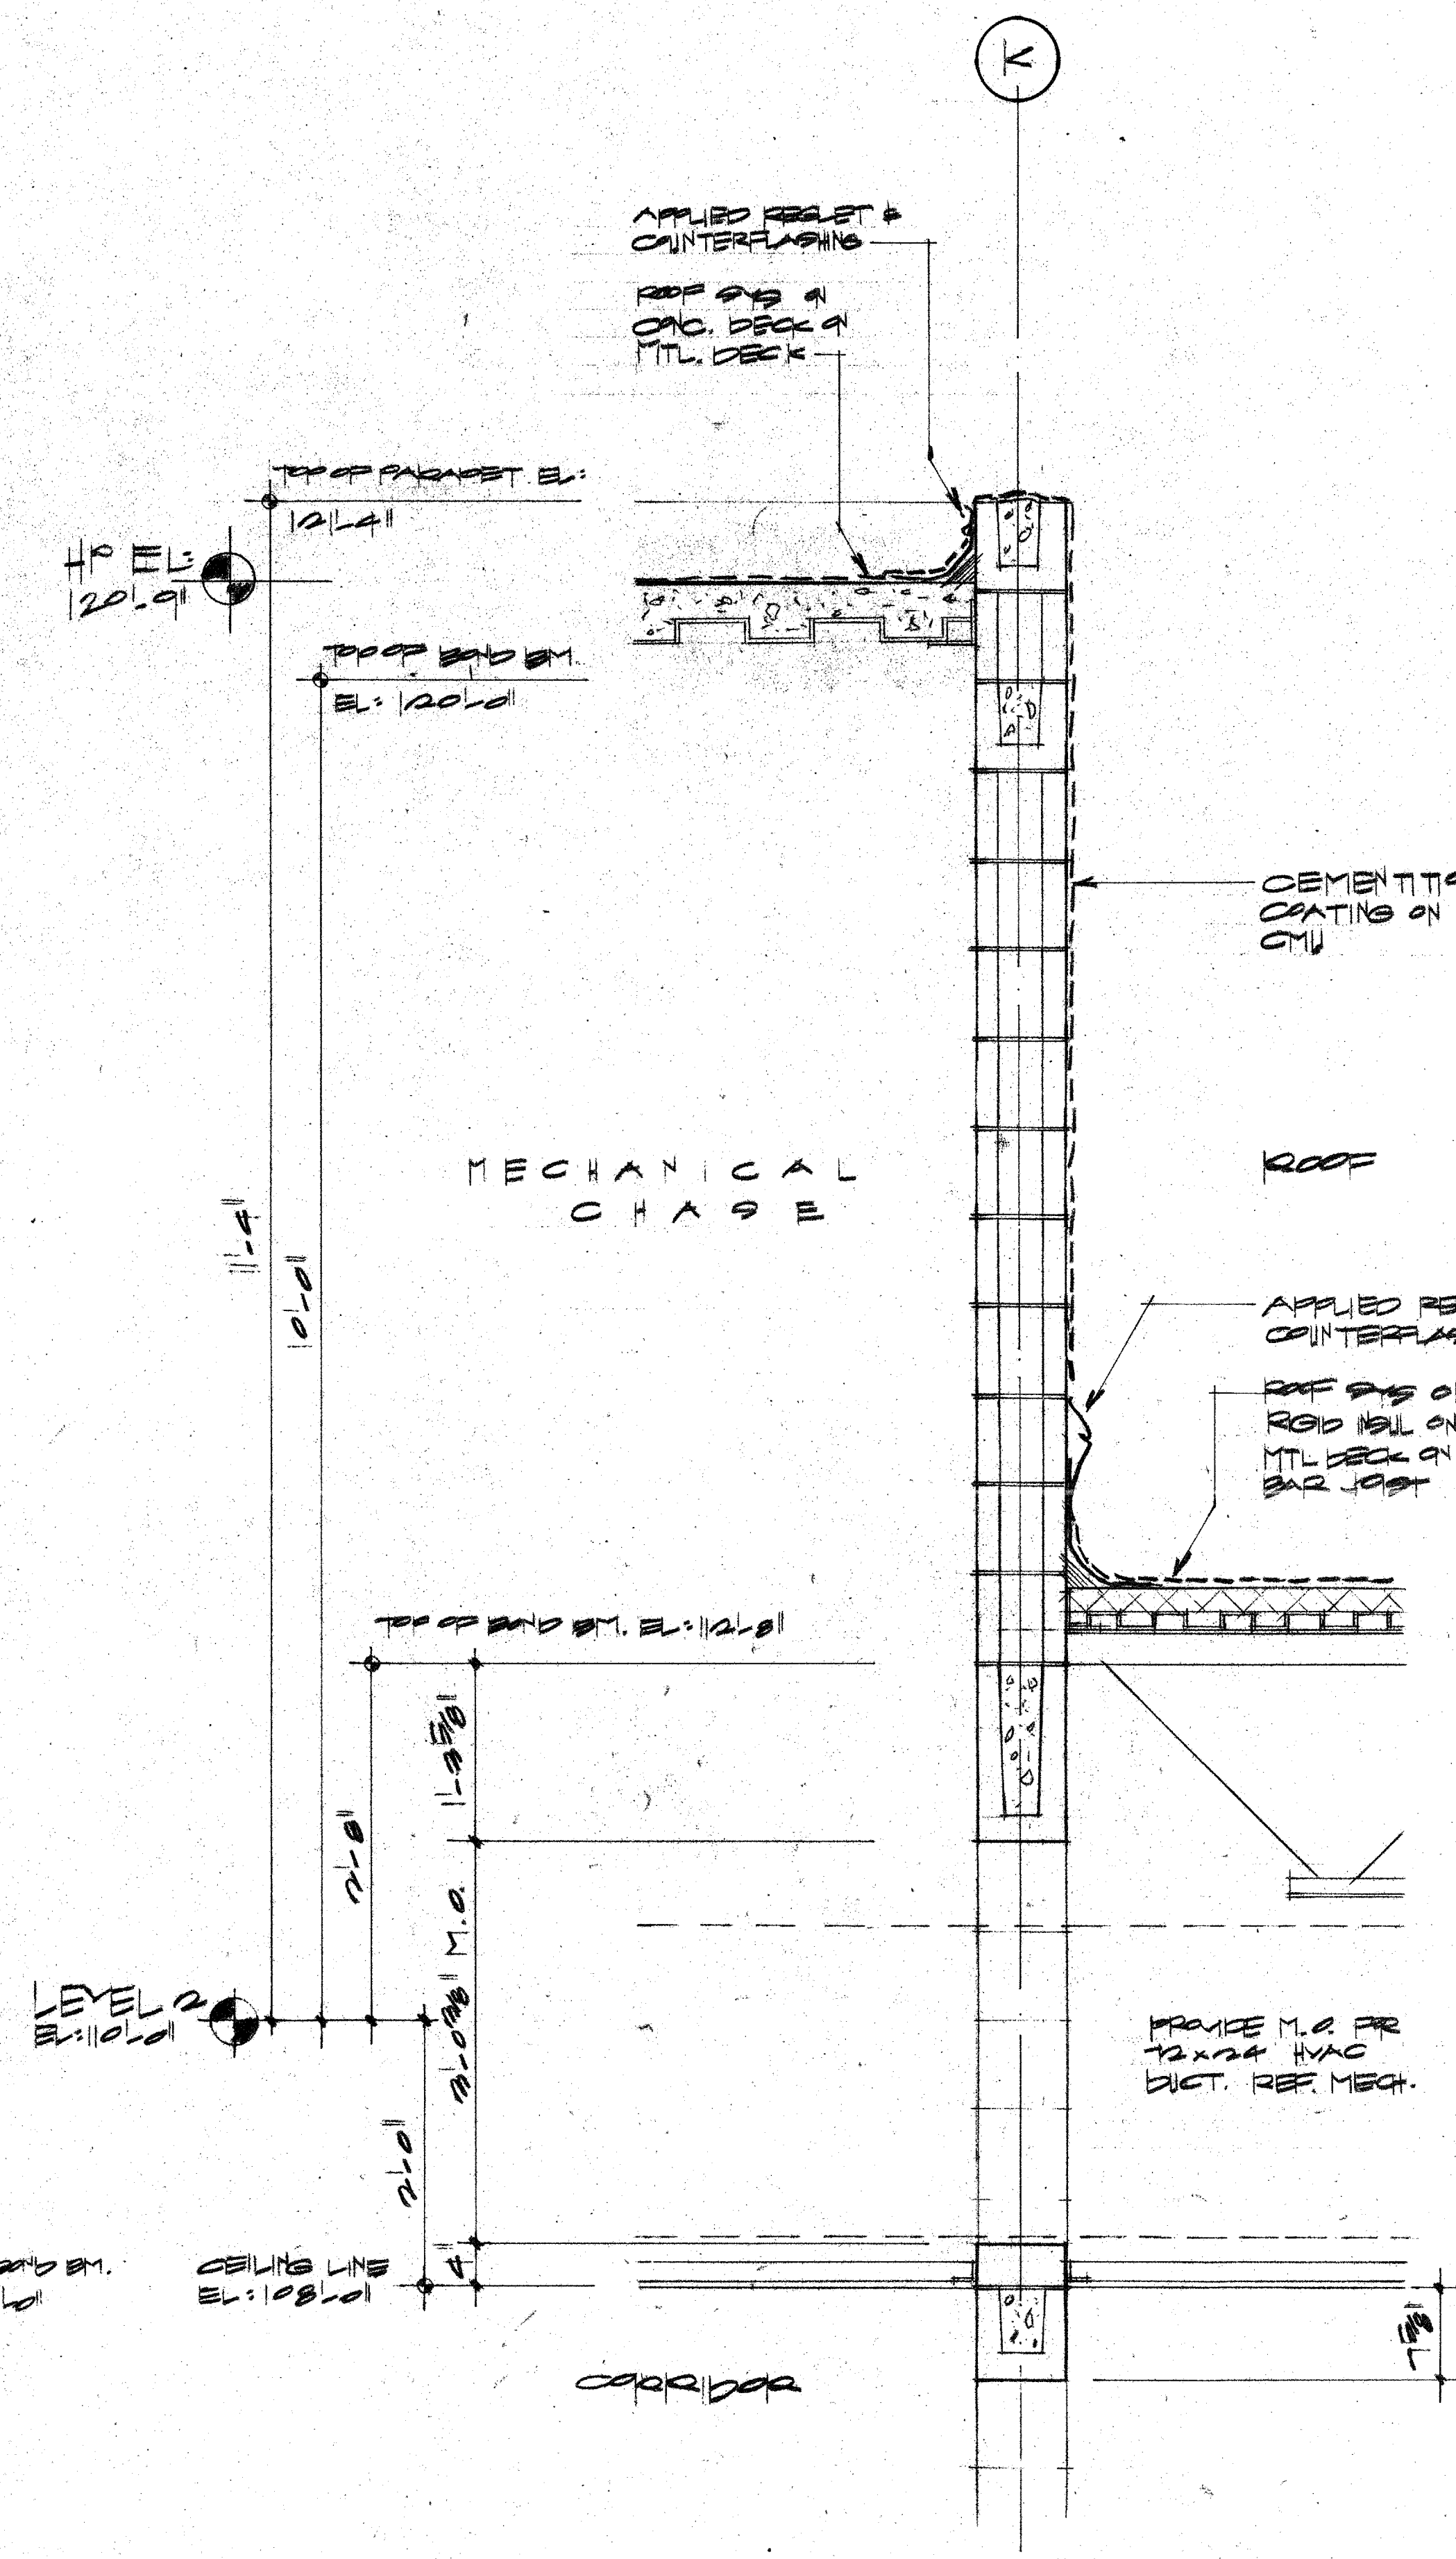

2 WALL SECTION  
1"=1'-0"

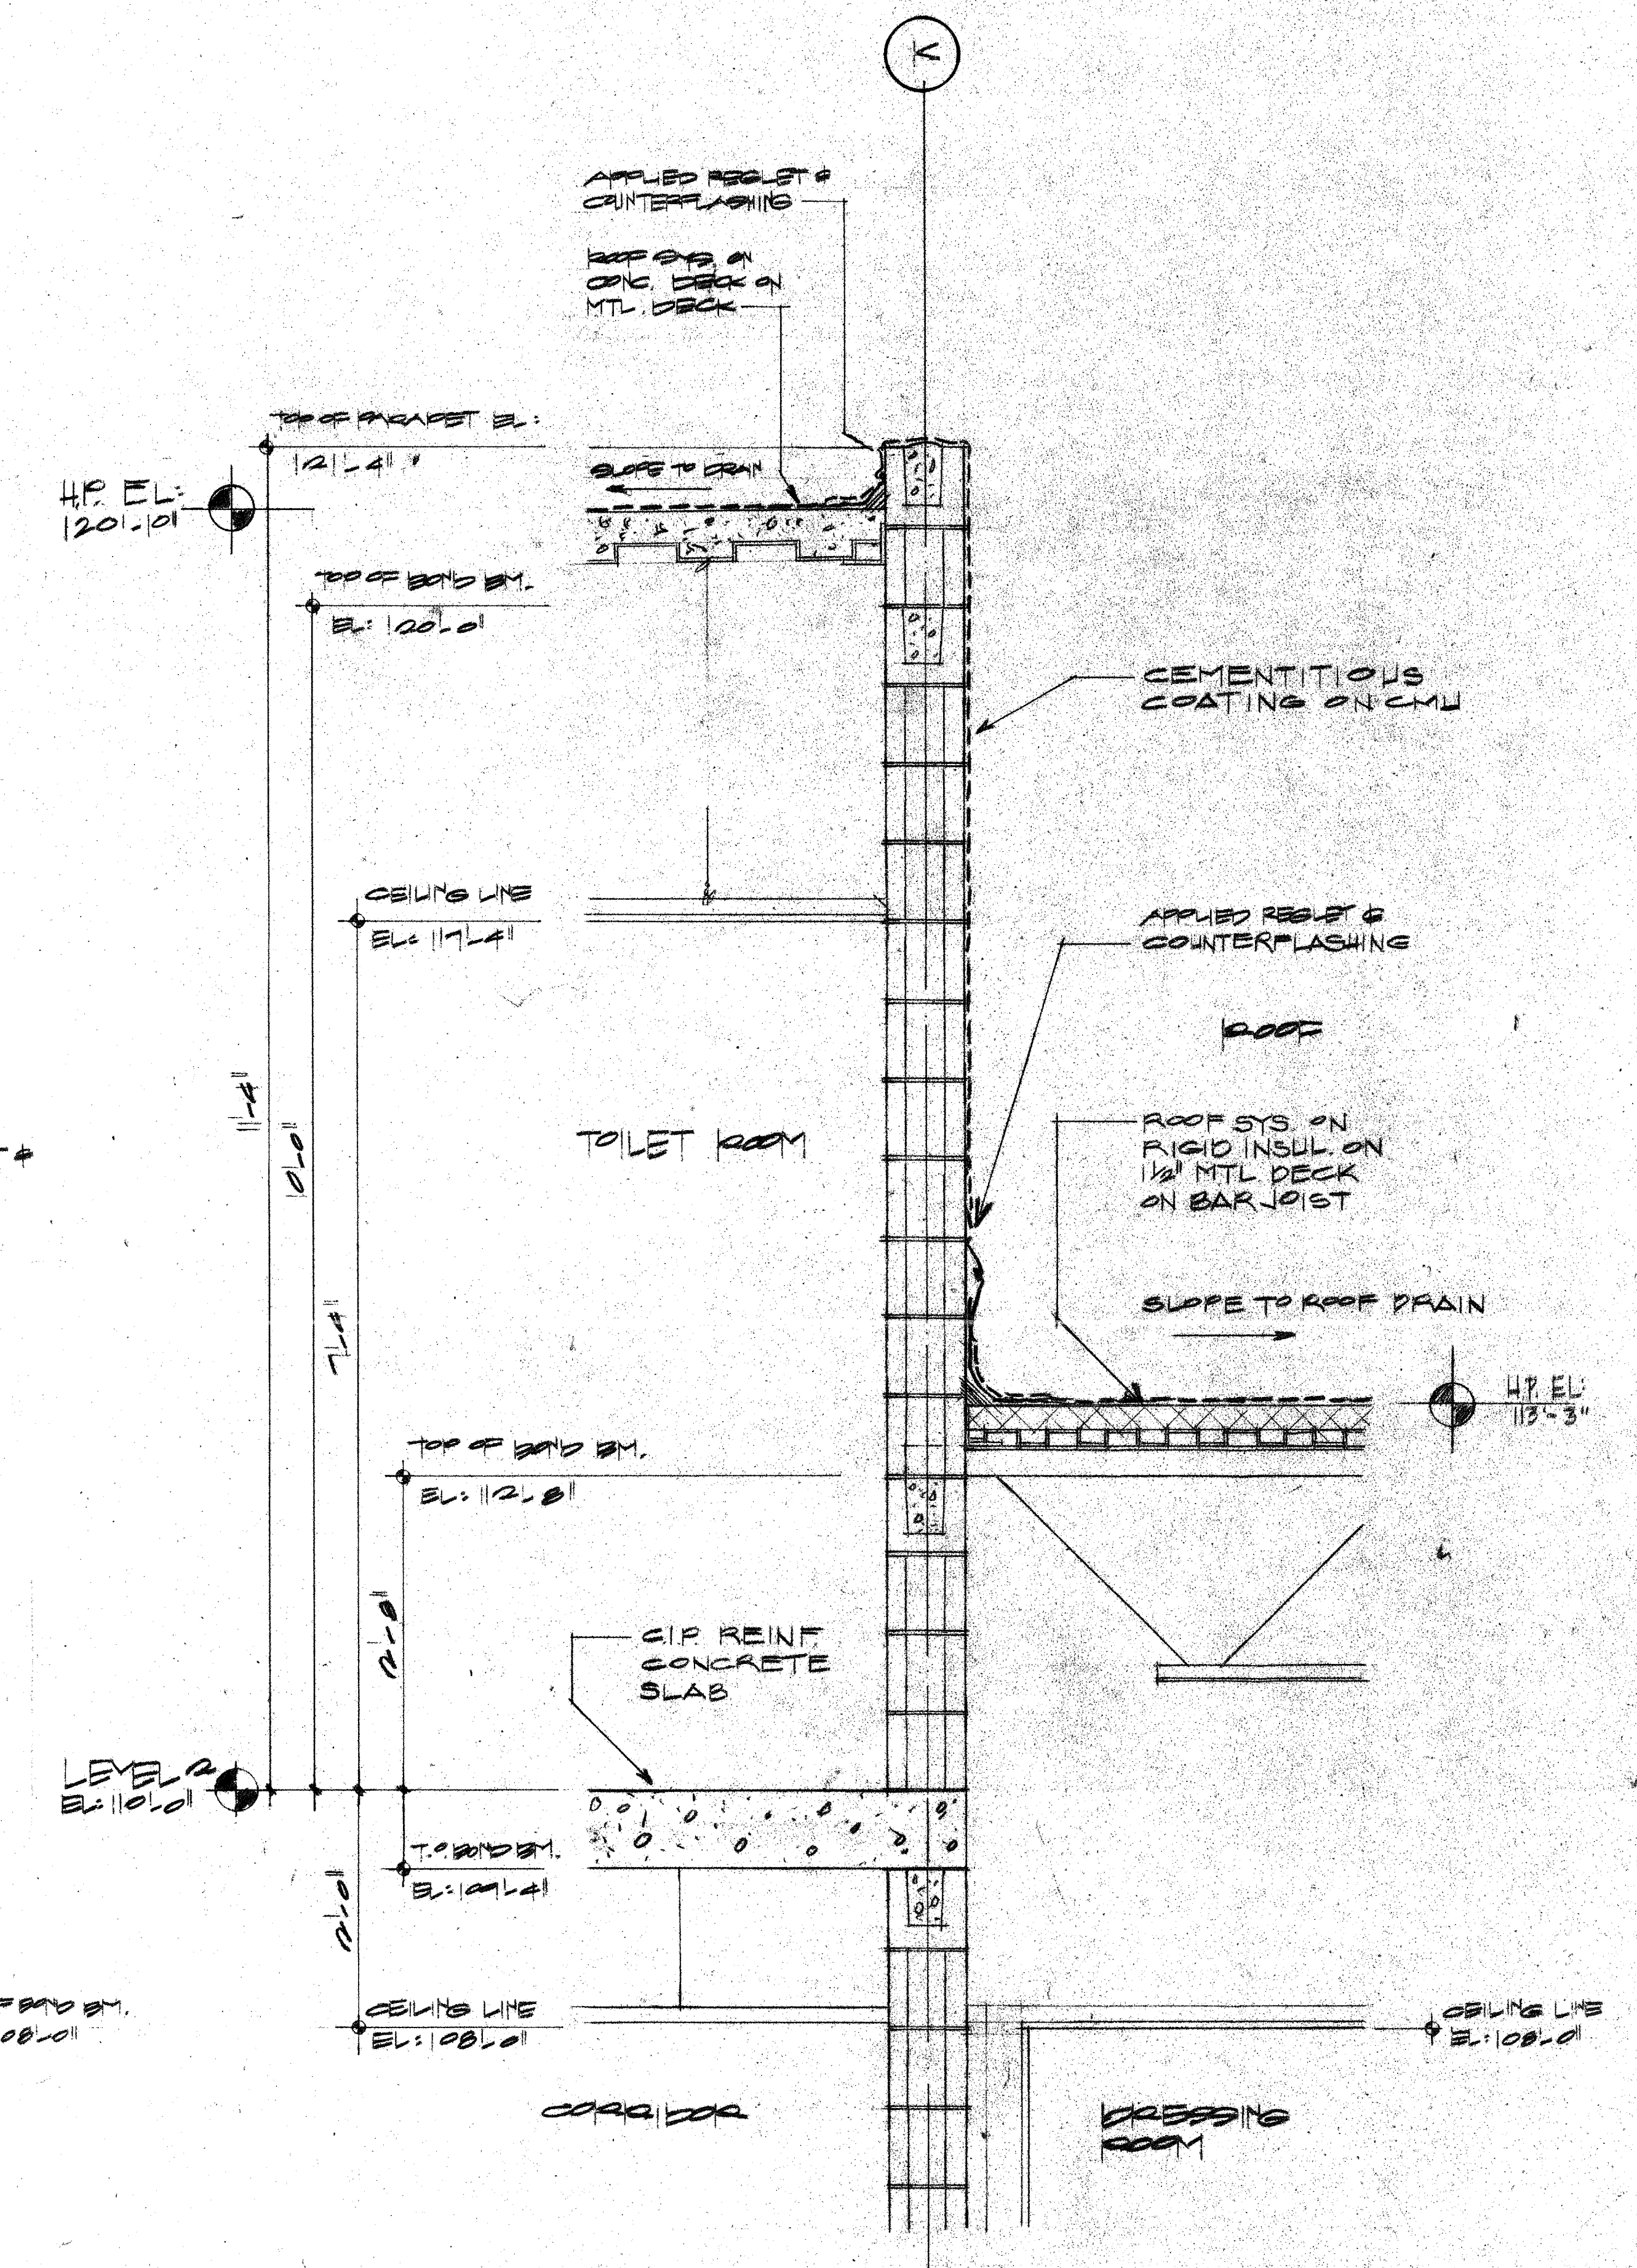

1 WALL SECTION  
1"=1'-0"



ACC ADDISON ACT

OWNER  
Dove of Addison  
The Williams Group  
3177547

ARCHITECT  
Cunningham Architects  
2700 Fairmount  
Dallas, Texas 75201  
214-855-5272

THEATRE CONSULTANT  
Theatre Projects  
203-431-5245  
214-855-5272

INTERIORS  
GROSS  
713-552-2000

LANDSCAPE  
The Williams Group  
214-391-8993

MEP SYSTEMS  
MEP Systems  
214-794-4341

STRUCTURAL  
Eldred Bremer  
214-391-8993

CIVIL  
Katz & Associates  
214-690-3322

HISTORIAN  
Alan Meyer  
214-508-1100

LIGHTING  
Pamela Hull-Wilson  
714-922-8542

GRAPHICS  
Hollister Design  
214-854-9708

Issue	Category	Subcategory	Sheet
ISSUE FOR BID 8-37-90	4	8	20