



1 WALL SECTION
1/4" = 1'-0"

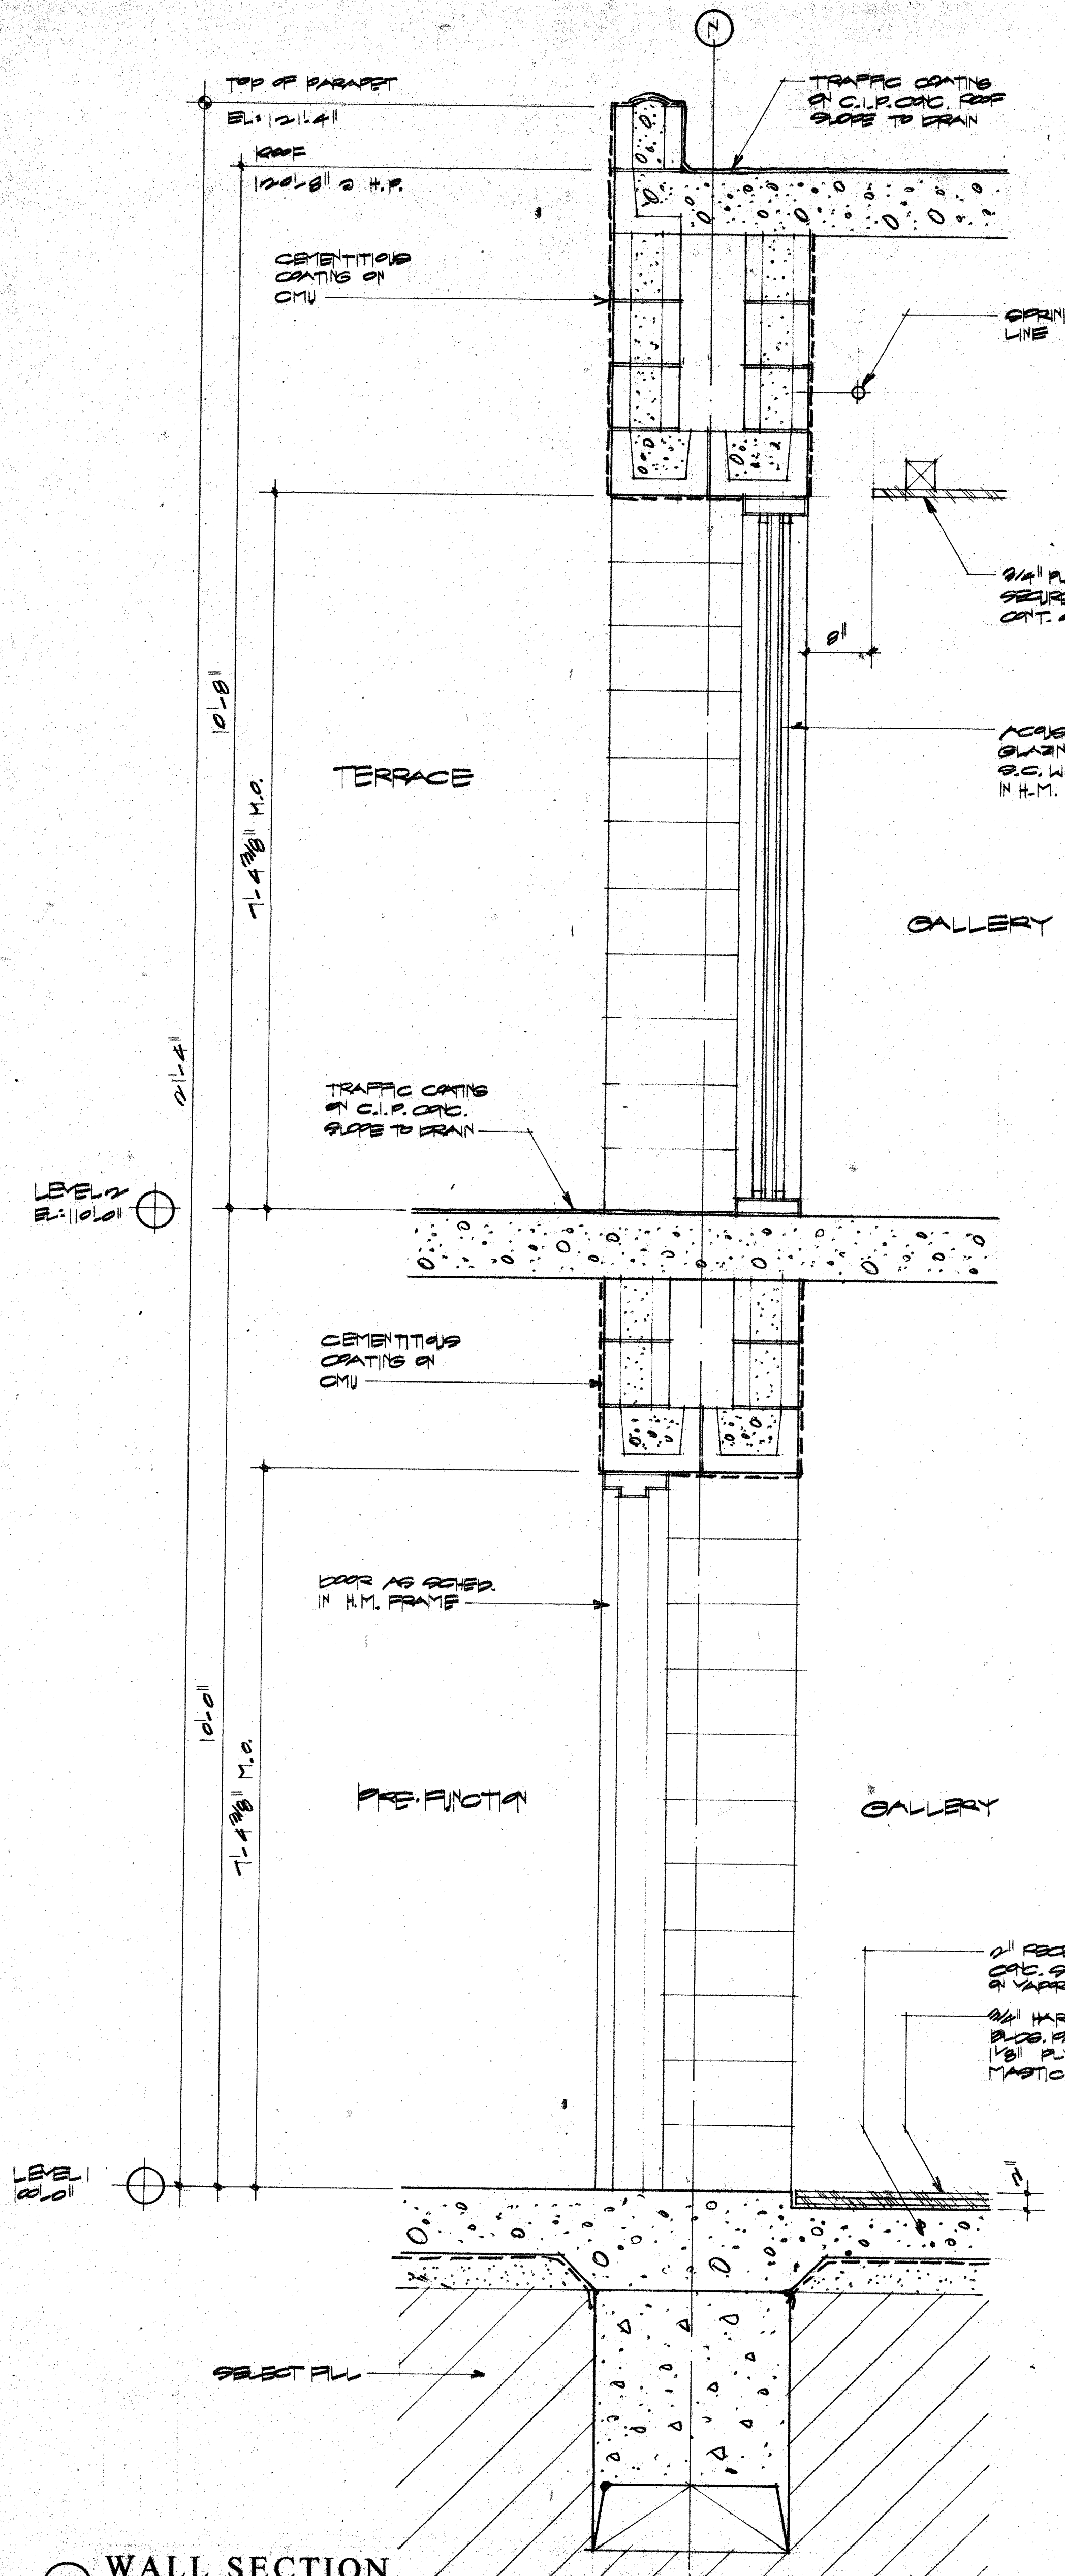

2 WALL SECTION
1/4" = 1'-0"

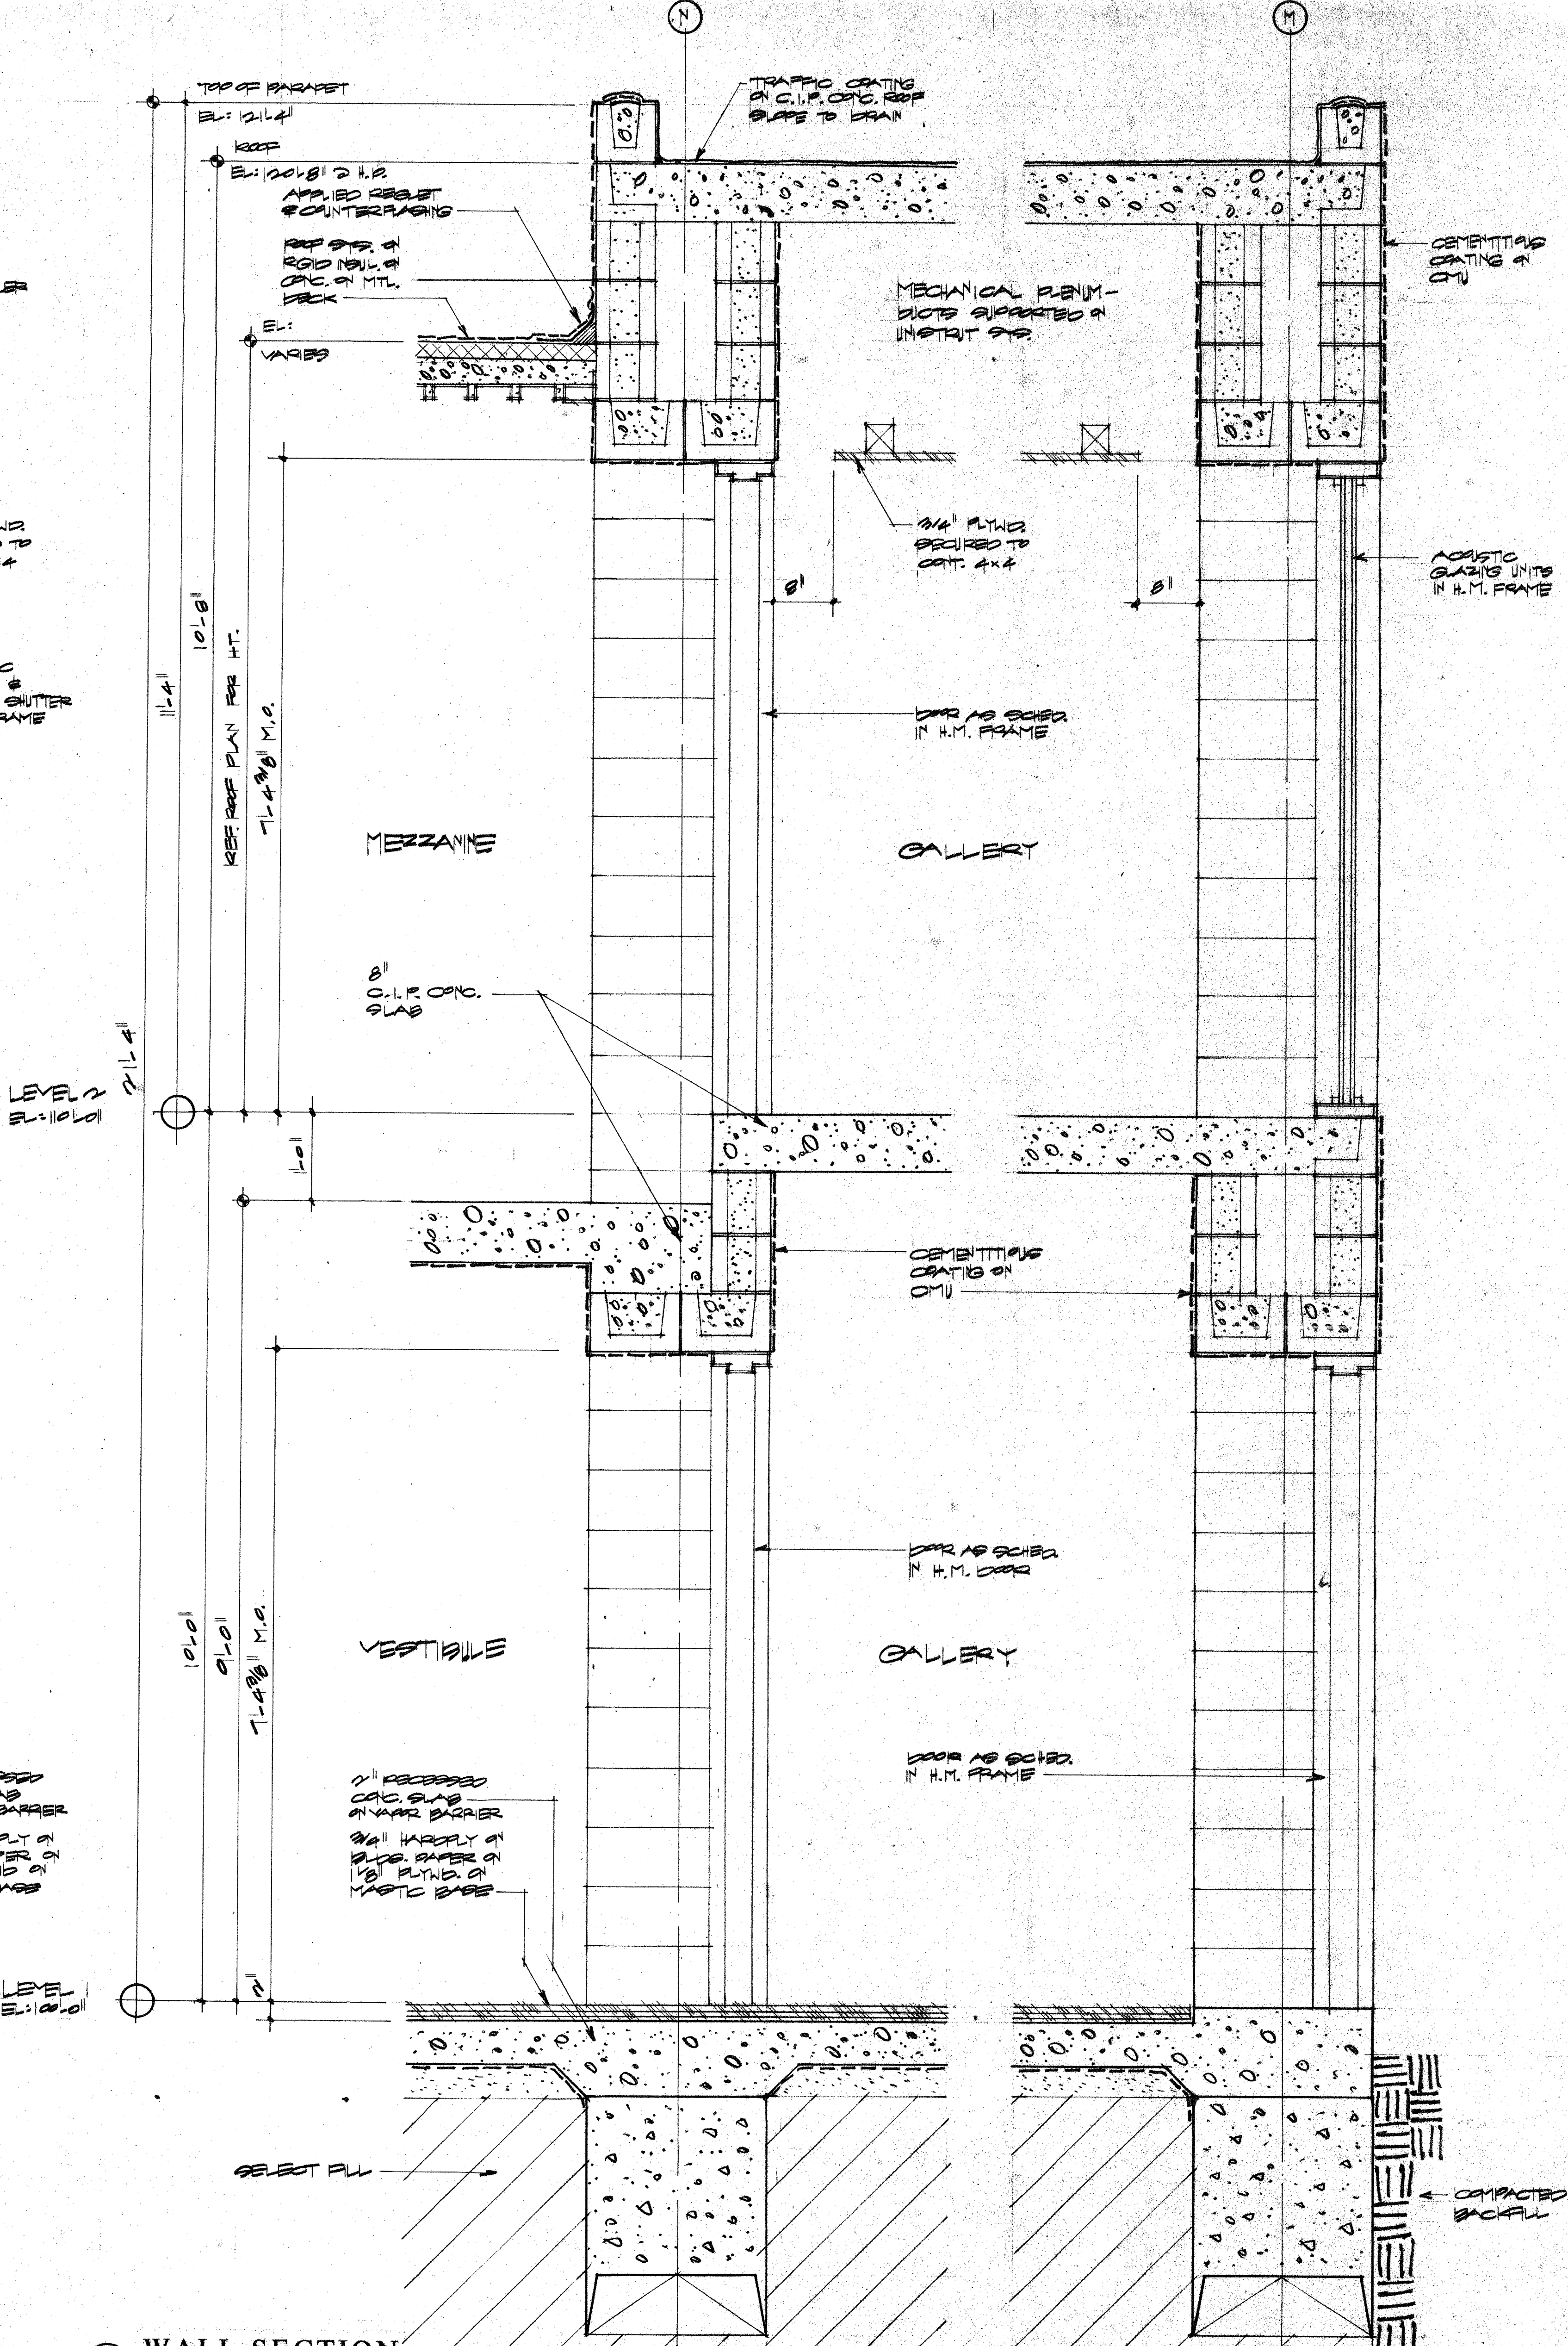

3 WALL SECTION
1/4" = 1'-0"