



1 WALL SECTION
121.41

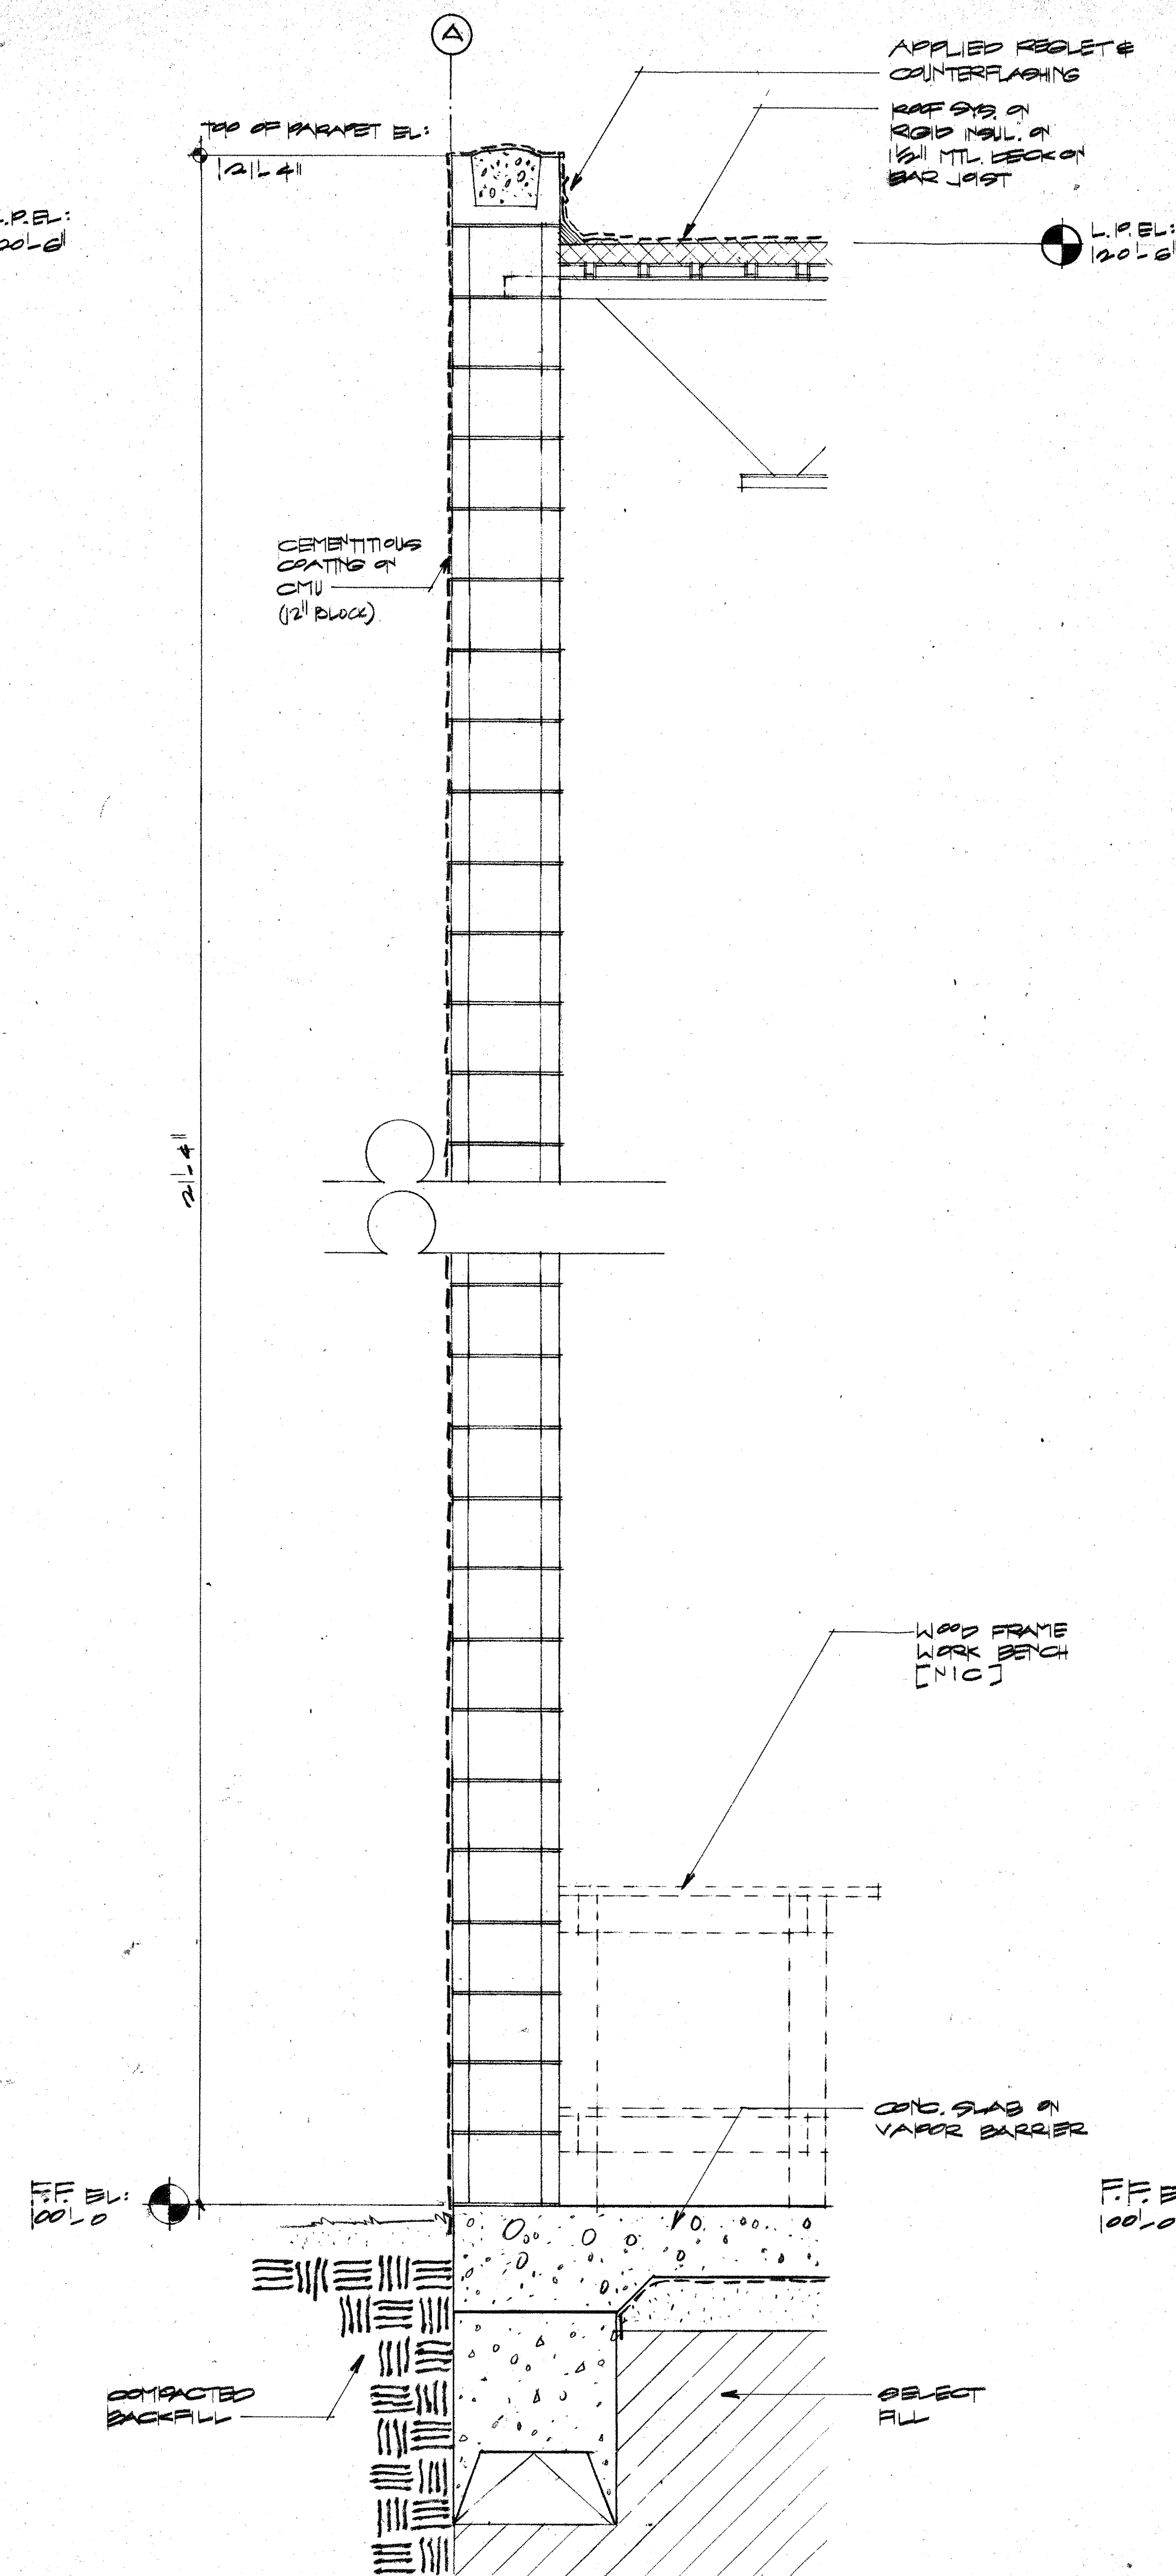

2 WALL SECTION
121.41

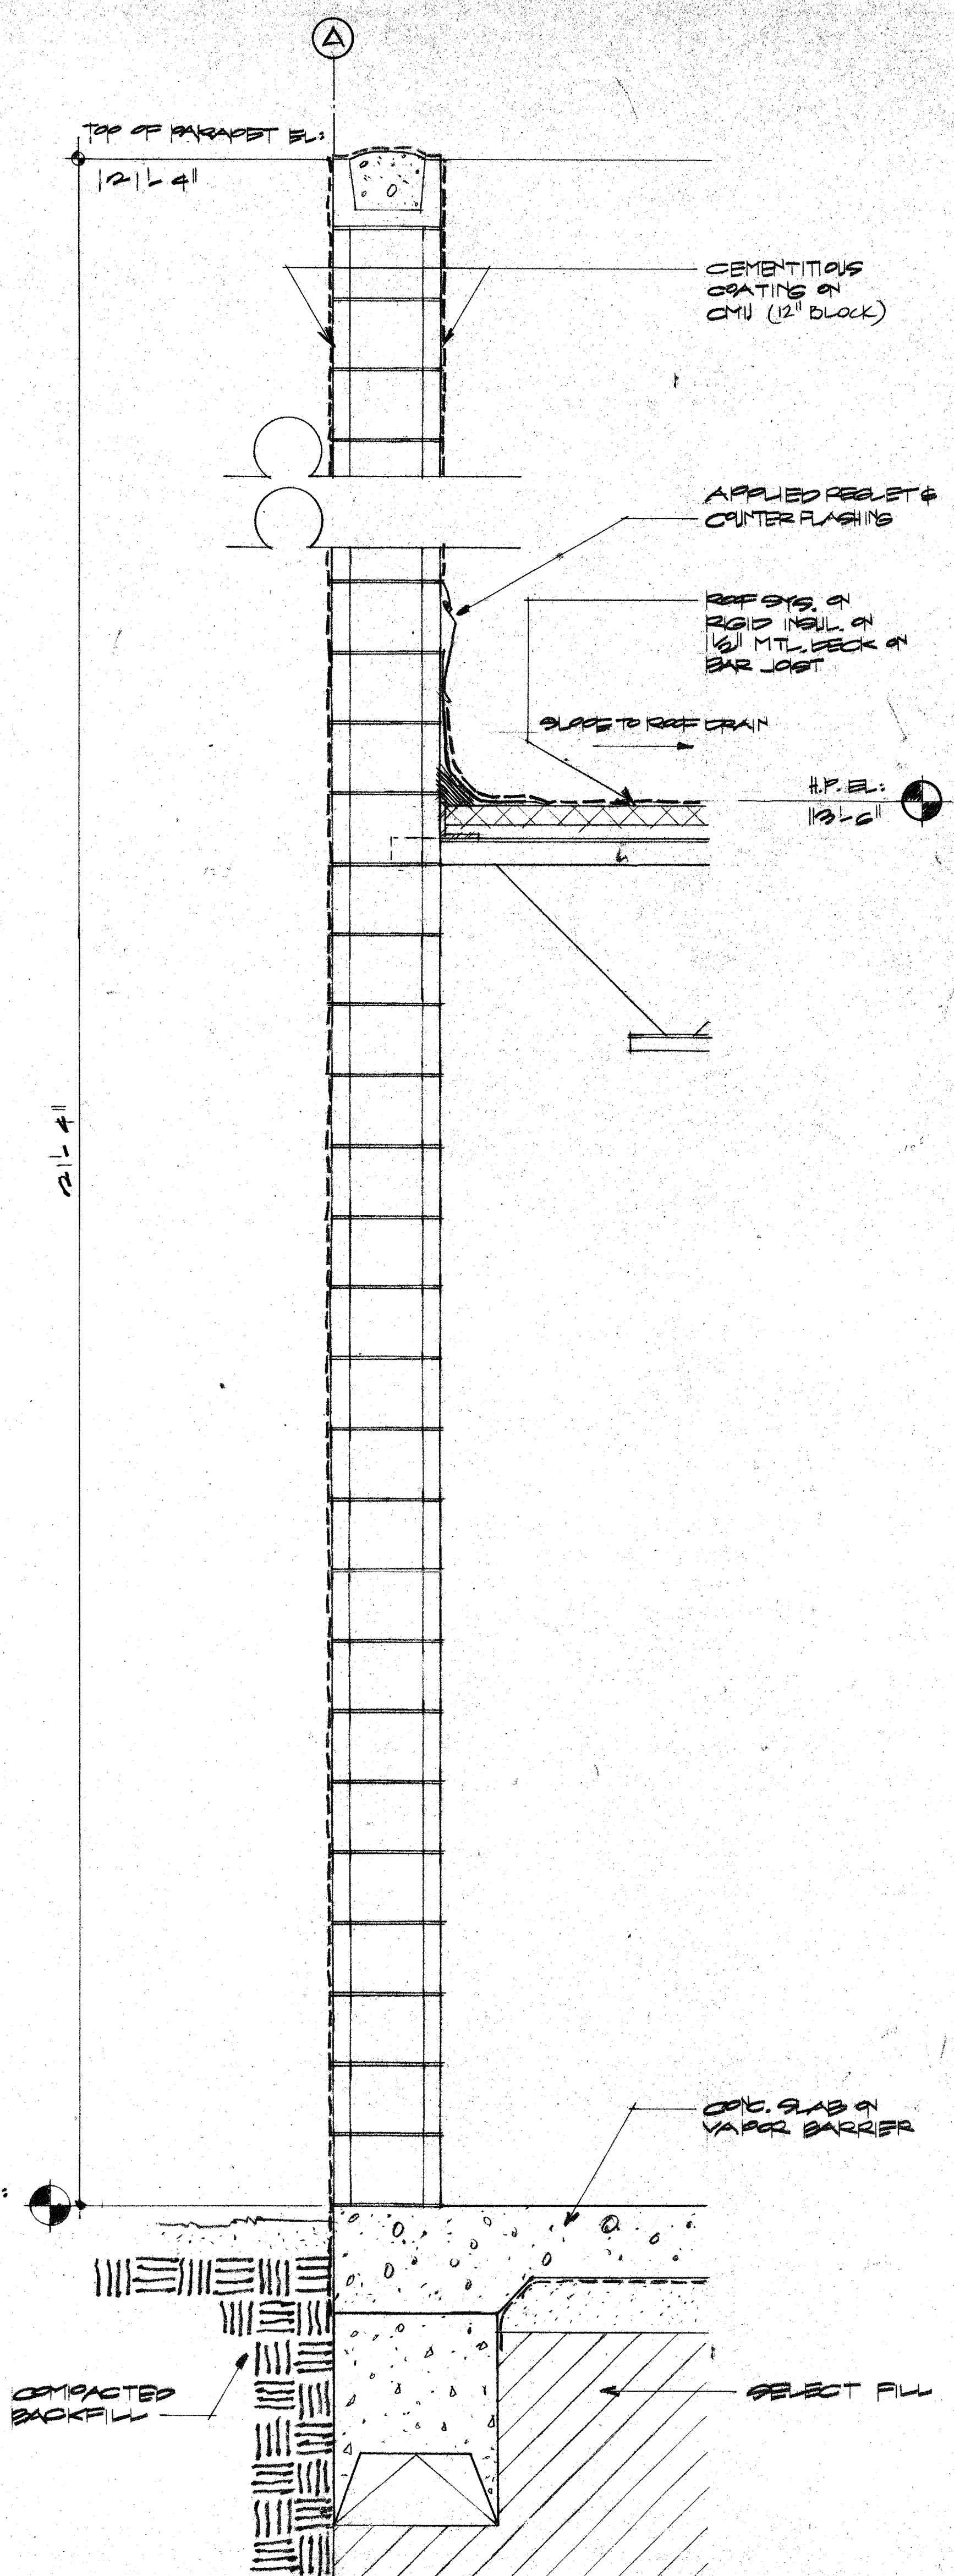

3 WALL SECTION
121.41



ACC ADDISON ACT

| OWNER | LANDSCAPE | STRUCTURAL | METFORMAN | Issue | Category | Subcategory | Sheet |
|--|-----------------------------------|------------------------------------|------------------------------------|-----------------------|----------|-------------|-------|
| Town of Addison | The Kellams Group 317-776-1417 | Elisor Tanner 214-387-8393 | Alan Mason 214-691-7822 | ISSUE FOR BID 8-17-90 | 4 | 8 | 12 |
| ARCHITECT | THEATRE CONSULTANT | M.E.P. | LIGHTING | | | | |
| Cunningham Architects 2700 Fairmount Dallas, Texas 75201 214-896-5272 | Theatre Projects 203-431-3849 | MEP Systems 214-754-4741 | Pamela Hull Wilson 214-823-8542 | | | | |
| INTERIORS | CRSS | CIVIL | GRAPHICS | | | | |
| 713-552-2000 | | Kurtz & Associates 214-690-3322 | Notstetad Design 214-954-9778 | | | | |