


1 WALL SECTION
1/2" = 1'-0"

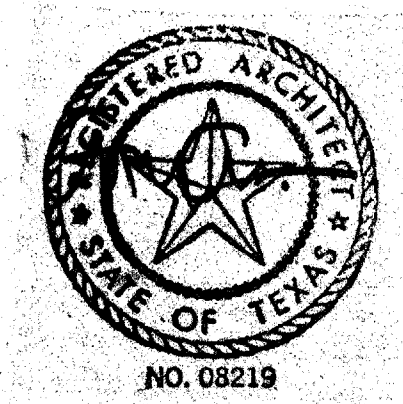

ACC ADDISON ACT

OWNER	LANDSCAPE	STRUCTURAL	MECHANICAL	Issue	Category	Subcategory	Sheet
Town of Addison	The Kellams Group 397-776-1417	Elisor Turner 214-387-8393	Alan Mason 214-691-7822		4	8	11
ARCHITECT	THEATRE CONSULTANT	M.E.P.	LIGHTING				
Cummins/ham Architects 2700 Fairmount Dallas, Texas 75201 214-855-5772	Theatre Projects 203-431-3948	MEP Systems 214-754-4741	Pamela Hull Wilson 214-823-6542				
	INTERIORS	CIVIL	GRAPHICS				
	CHSS 713-552-2000	Kurtz & Associates 214-690-3322	Northstad Design 214-954-1978				
		ACOUSTICS					
		Jonas-Rose Group 214-392-7800					