



3 WALL SECTION
1/2" = 1'-0"

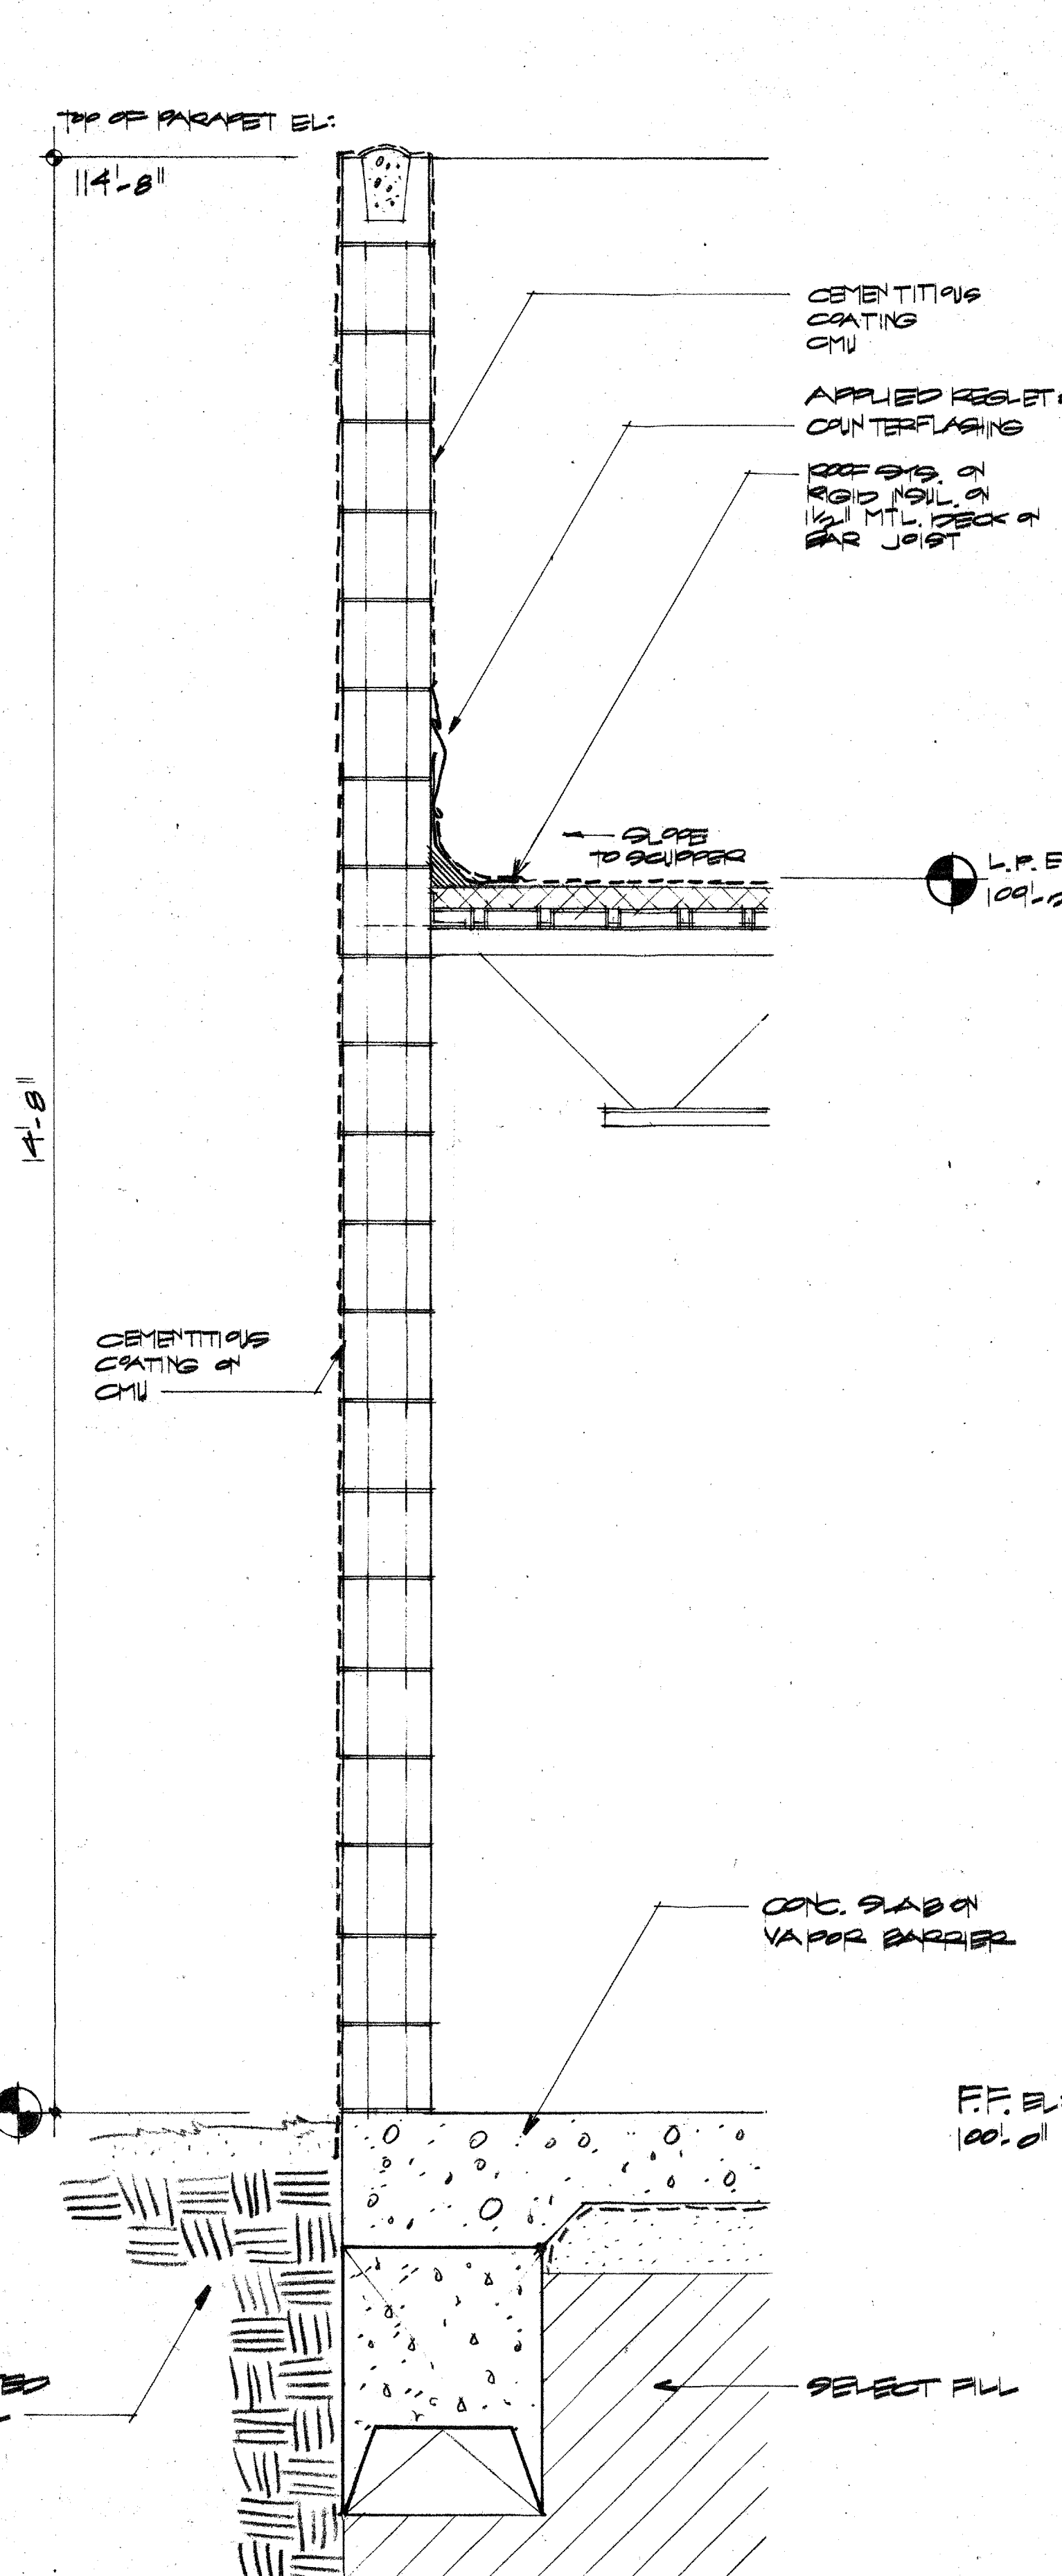

2 WALL SECTION
1/2" = 1'-0"

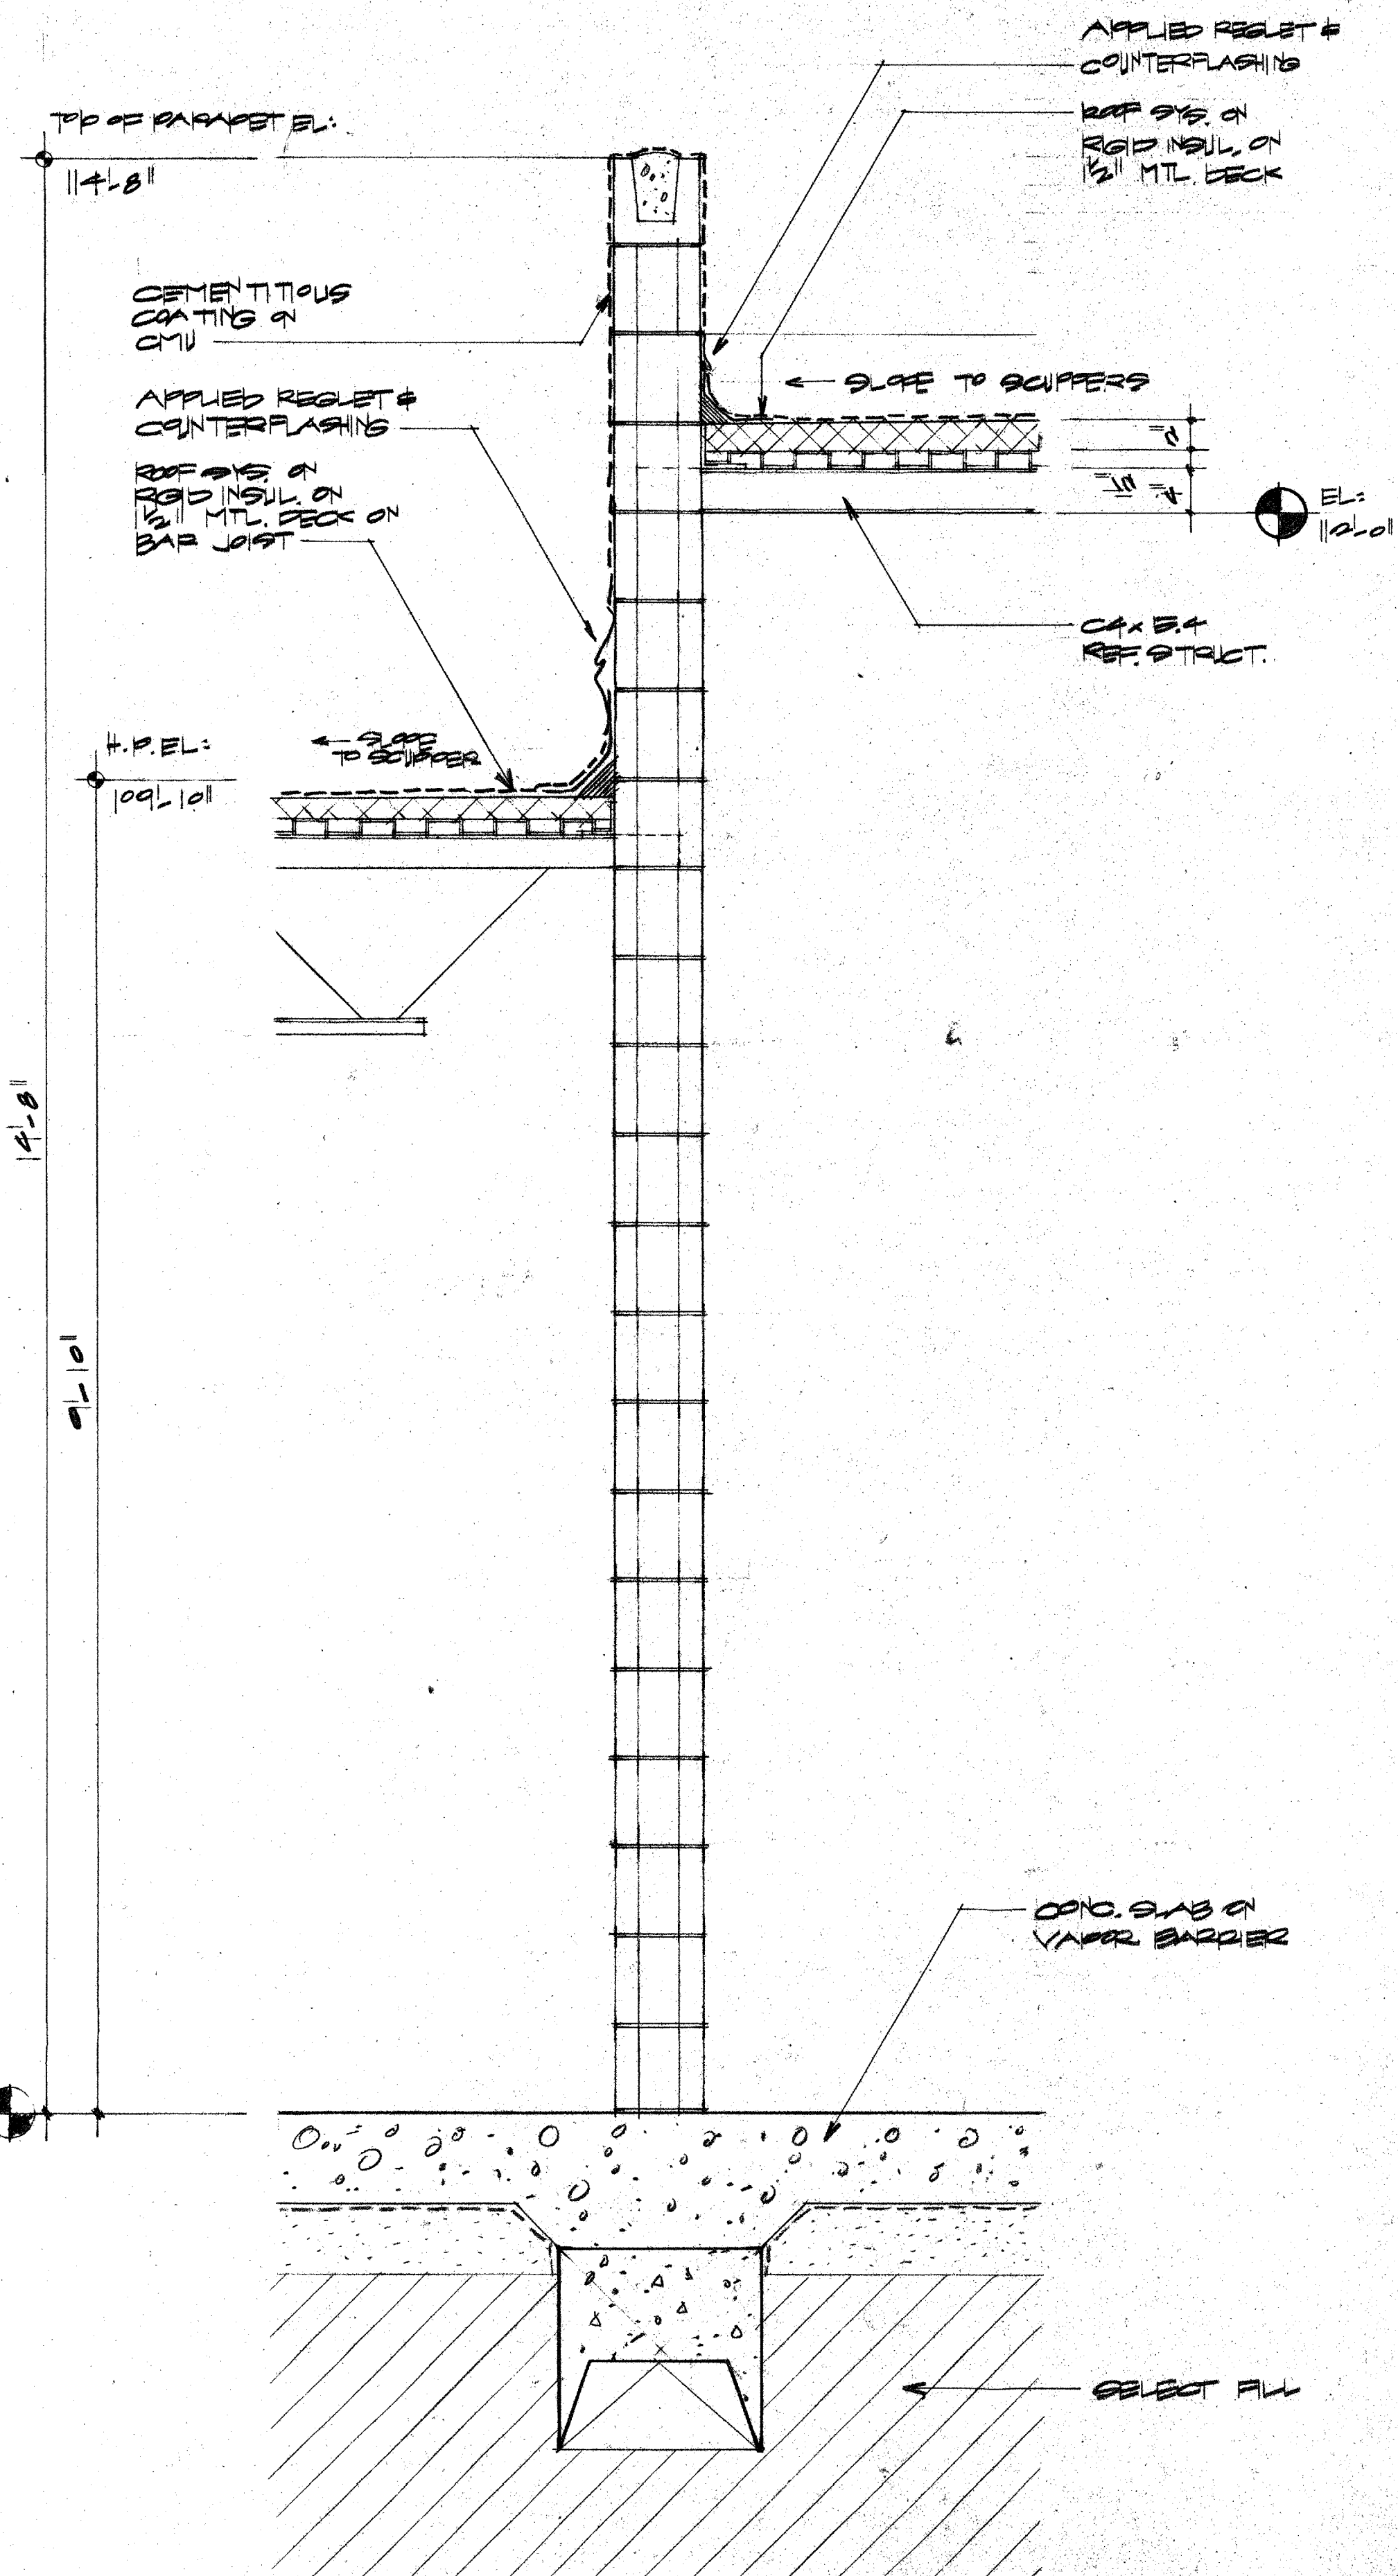

1 WALL SECTION
1/2" = 1'-0"



ACC ADDISON ACT

OWNER Town of Addison	LANDSCAPE The Kellams Group 207-776-1417	STRUCTURAL Eliseo Turner 214-387-8393	HISTORIAN Alan Mason 214-691-7182	Issue	Category	Subcategory	Sheet
ARCHITECT Cunningham Architects 2700 Fairmount Dallas, Texas 75201 214-855-5272	THEATRE CONSULTANT Theatre Projects 203-431-3849	M.E.P. MEP Systems 214-754-4741	LIGHTING Pamela Hull Wilson 214-823-6542	ISSUE FOR BID 8-17-90	4	8	10
INTERIORS CRSS 70-552-2000	CIVIL Kurtz & Associates 214-690-3322	GRAPHICS Notestad Design 214-954-1978	ACOUSTICS Joiner-Rose Group 214-392-7800				T