




③ DETAIL  
1/2" = 1'-0"

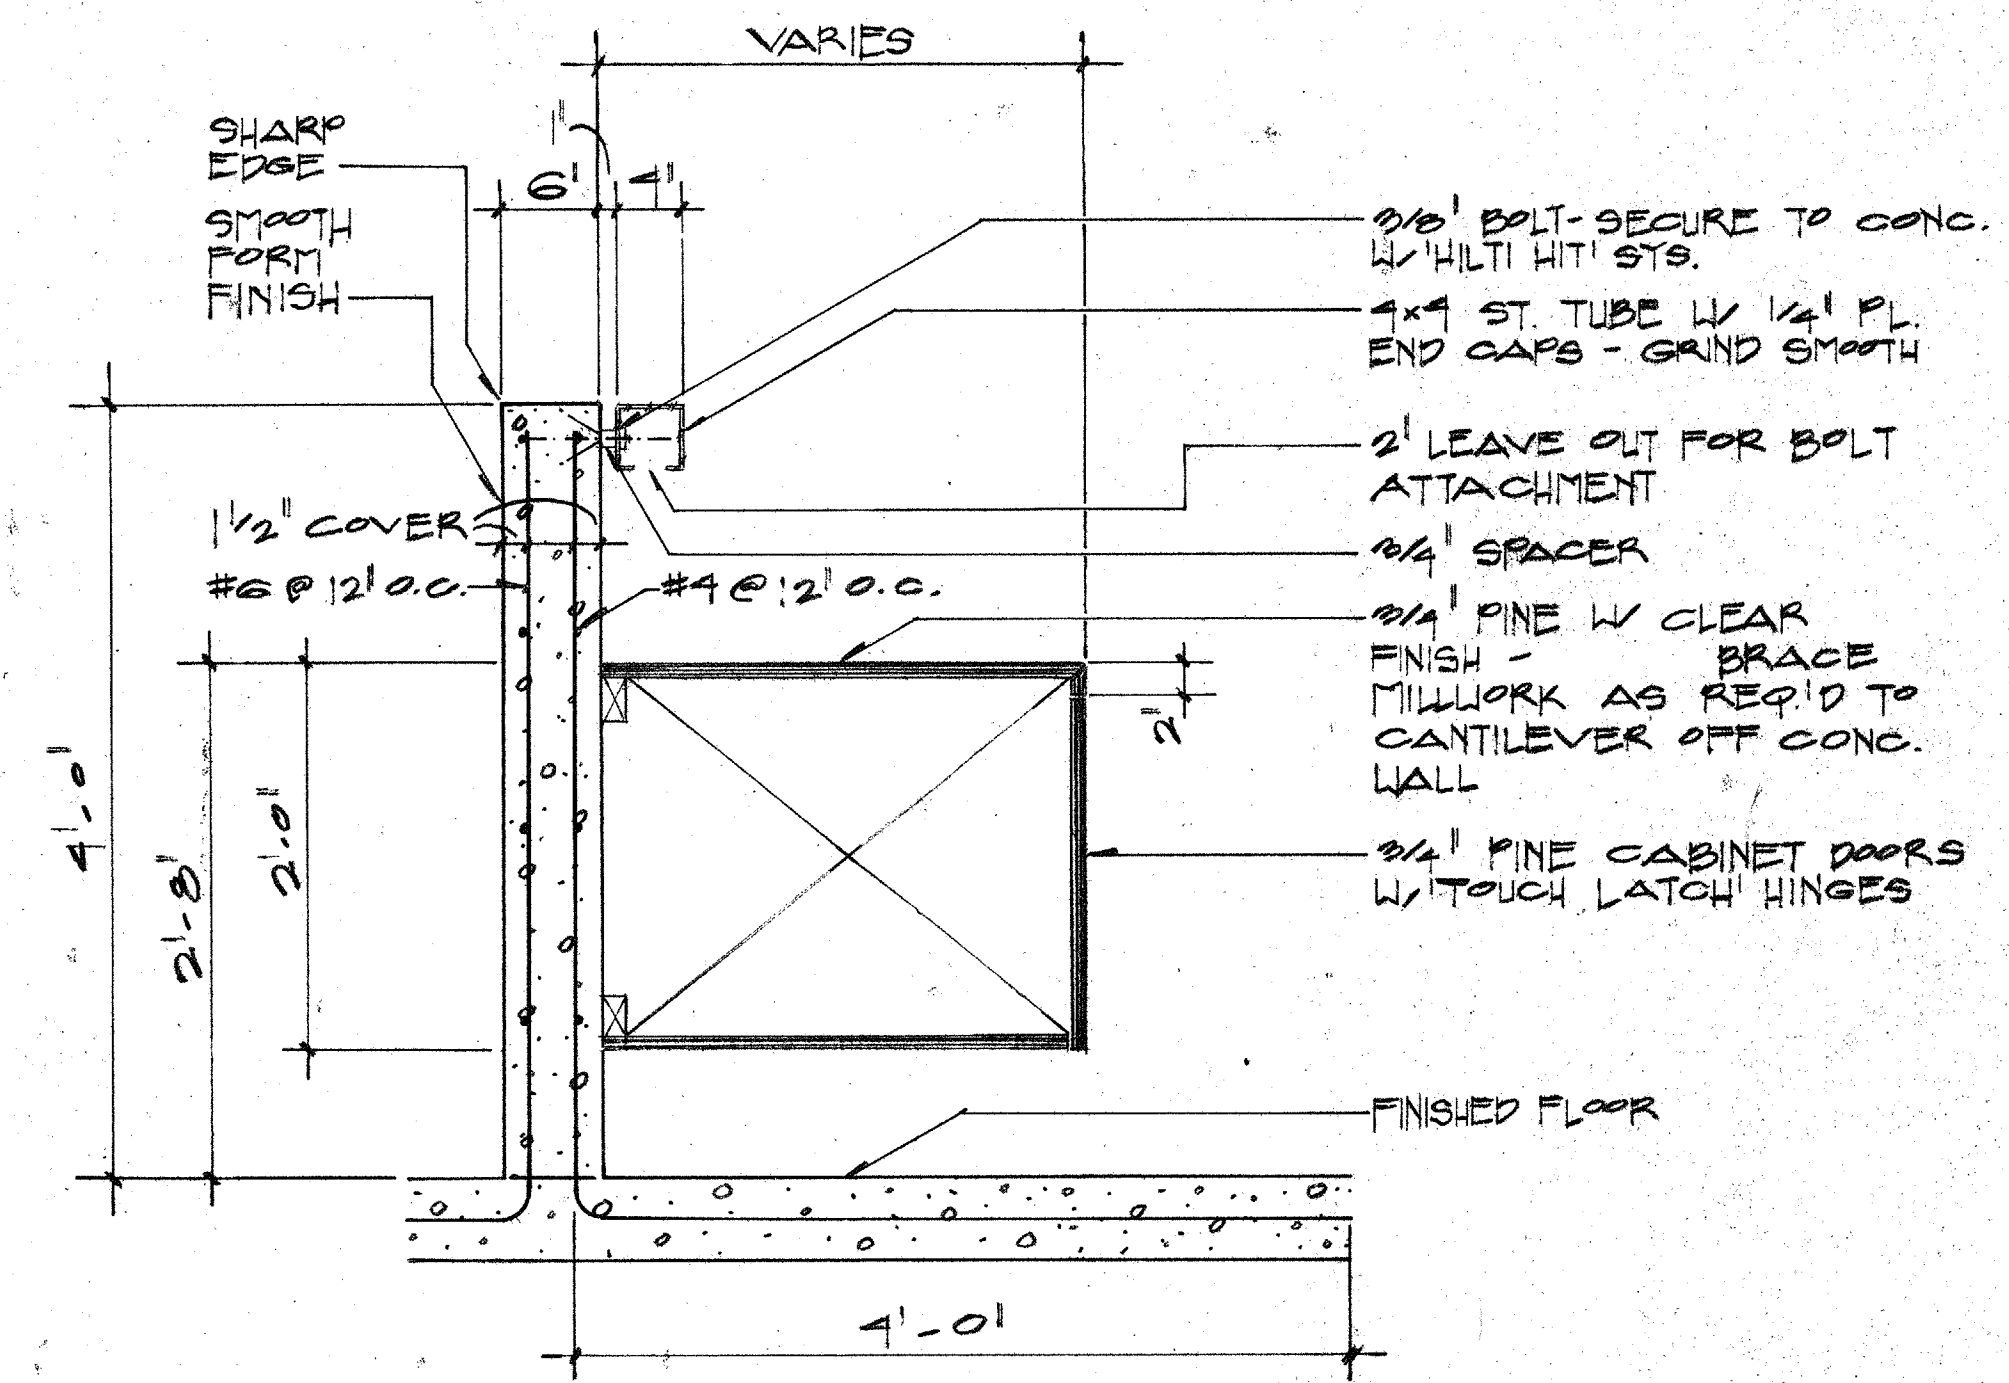

② DETAIL  
1/2" = 1'-0"

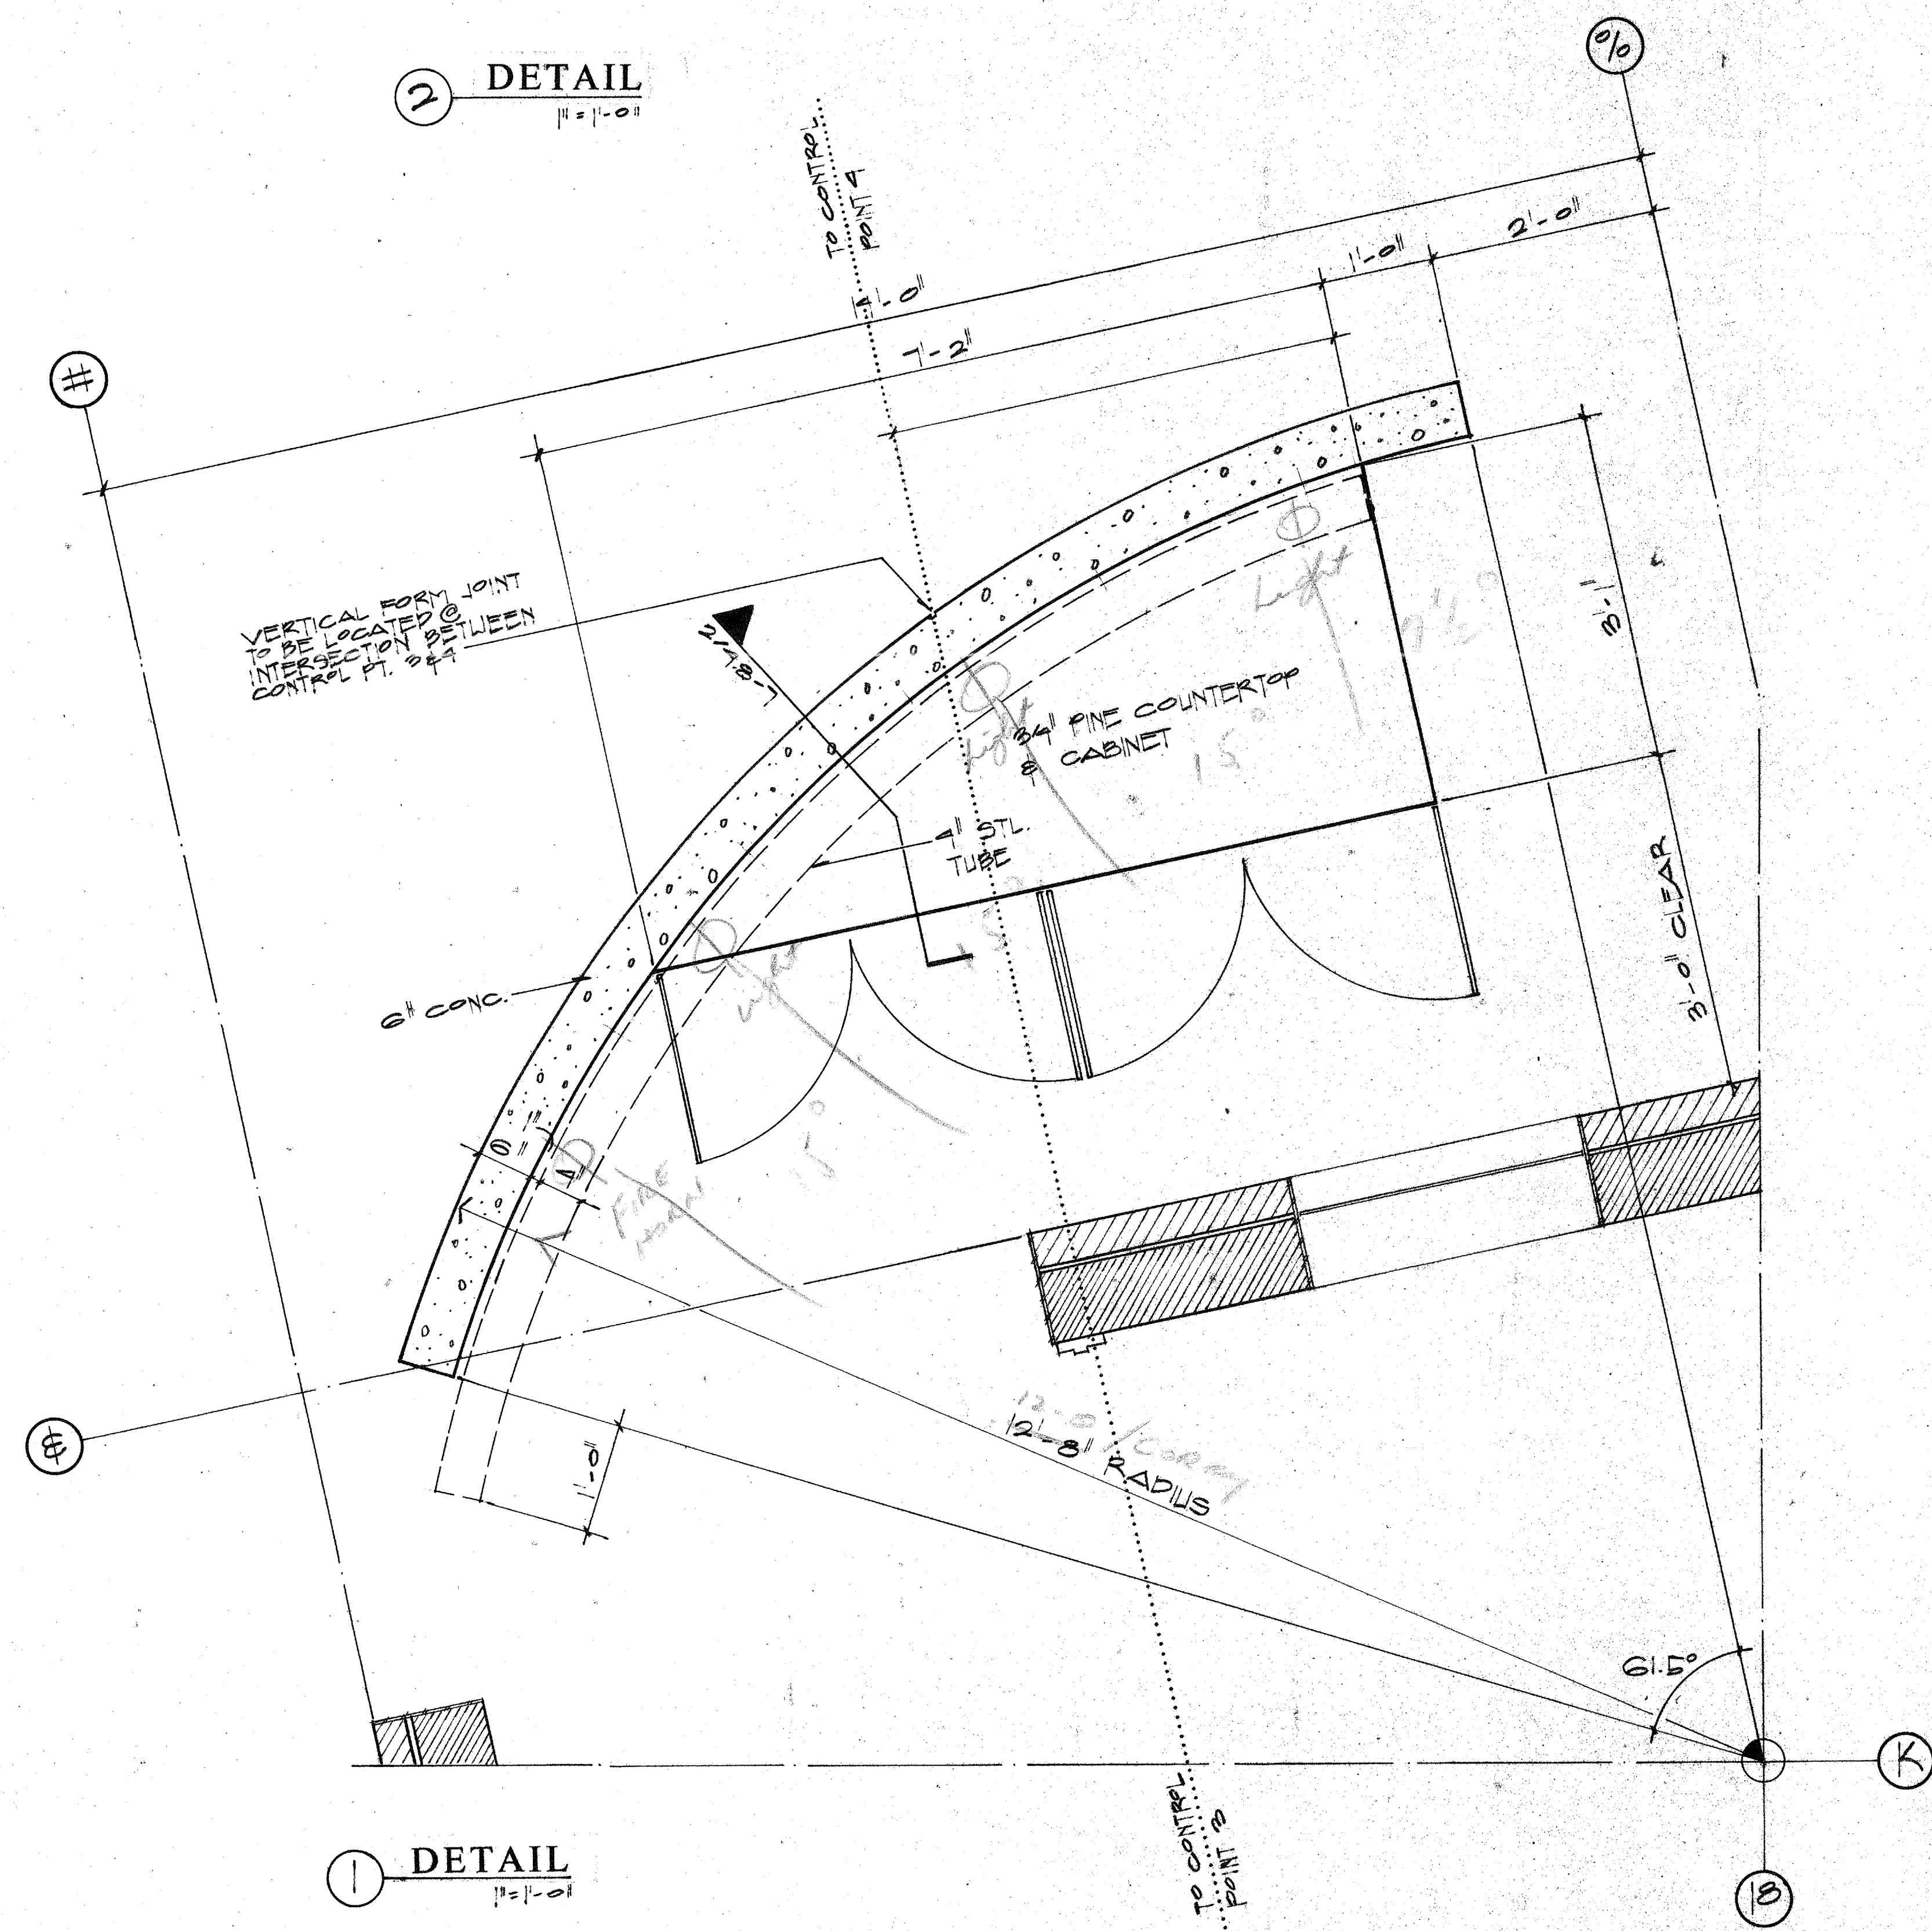

① DETAIL  
1/2" = 1'-0"

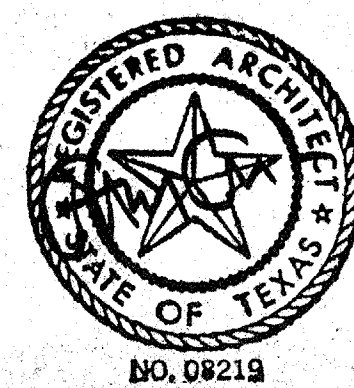

# ACC ACT

OWNER	LANDSCAPE	STRUCTURAL	HISTORIAN	Issue	Category	Subcategory	Sheet
Town of Addison The Kellams Group 307-776-1417	Edgar Turner 214-387-8393	Eligor Turner 214-387-8393	Alan Mason 214-891-782	ISSUE FOR BID 8-17-90	4	8	7
ARCHITECT Cunningham Architects 2700 Fairmount Dallas, Texas 75201 214-855-5272	THEATRE CONSULTANT Theatre Projects 203-431-3949	M.E.P. MEP Systems 214-754-4741	LIGHTING Pamela Hull Wilson 214-823-6542				
INTERIORS CRSS 713-552-2000	CIVIL Kurtz & Associates 214-890-3322	GRAPHICS Notstated Design 214-954-9778					
	ACOUSTICS Joiner-Rose Group 214-392-7800						