



NOTE ALL SPRINKLER HEADS UPRIGHT THIS FLOOR LINO

PENDANT

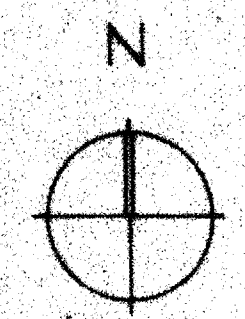

1 FIRE PROT. THEATRE 3

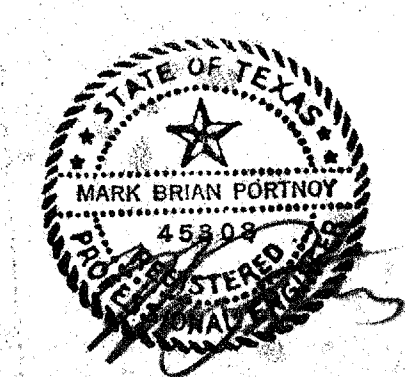

ACC ADDISON ACT

OWNER	LANDSCAPE	STRUCTURAL	HISTORIAN	Issue	Category	Subcategory	Sheet
Town of Addison The Kellams Group 310-776-4177	Elisor Tenner 214-387-8333	Elisor Tenner 214-387-8333	Alap Mason 214-881-7882	ISSUE FOR BID 8-17-90			
ARCHITECT Cunningham Architects 2700 Fairmount Dallas, Texas 75201 214-855-5272	THEATRE CONSULTANT Theatre Projects 203-431-3949	M.E.P. MEP Systems 214-754-4788	LIGHTING Pamela Hall Wilson 214-853-8842				
INTERIORS CDS 713-552-2000	CIVIL Karr & Associates 214-880-3322	SUPPLIER Mechanical Design 214-864-9378					

7 2 4