


CIRCUIT #	CONTROLLED BY	LOAD	NOTES
S-44 S-46 S-48 S-50 S-52 S-54 S-56	TC/P	BL(18) BF(5) BL(23) BF(4) BF(5) BF(6) BL(14)	USE 8 POLE CONTACTOR (UNDER LINE ITEM A)
A-64 A-66 A-68 A-75	TC/P	TREE LIGHTS	NEAR CONVENTION CENTER
M-37	TC/P	UPLIGHTS @ W4(2)	CANOPY PARAPET
EA			
1A-20 1A-34	TC/P	R YW(18) H1(1)	GALLERY
3A-19		R	
1M-43	TC/P		
2M-42	TC/P		
EA			
1B-1 1B-3 1B-5 1B-7 1B-9 1B-11 1B-13 1B-15 1B-17	TC/P	R AC(14) Z3(4) Z5(1)	WINDMILL
1B-38	TC/P	Z(8)	PLAY AREA
7 1A-36 1A-38 1A-40	R R R	YW(4) D(7) D(7)	GALLERY LEVEL 1

ITEM	DESCRIPTION	LIGHT CONTROL ELEMENT	LOADS	FINISH	LOCATION	SYMBOL
A	QUARTZ DOWNLIGHT, PERMANENT MOUNTED AT 14" AFF (ADJUST WITH LENGTHS), HEAVY GLOSS ALUMINUM HOUSING, 2 1/2" DIA, 1 1/2" DIA (MAXIMUM), LITONIA # C211-SH-AC-100-100-14" KURT VERSEN # 1195	CLEAR ALUMINUM	300 W A-117 PEX PROVIDED 130 V	BLACK BASED ON POWDERED ENAMEL	CONVENTION CENTER BIG ROOM	
A1	SURFACE MOUNTED INCANDESCENT DOWNLIGHT, 1" DIA, 1 1/2" HIGH, 1 1/2" DIA (MAXIMUM), LITONIA # C211-SH-AC-100-100-14" KURT VERSEN # 1195	CLEAR ALUMINUM	150 W PAR 38 FL 130 V	BLACK	CONVENTION PRE-FUNCTION LOBBY	
A2	PERMANENT MOUNTED INCANDESCENT DOWNLIGHT, 1 1/2" DIA, 1 1/2" HIGH, 1 1/2" DIA (MAXIMUM), LITONIA # C211-SH-AC-100-100-14" KURT VERSEN # 1195	CLEAR ALUMINUM	150 W PAR 38 FL 130 V	BLACK	CONVENTION LOBBY	
A3	METAL HALIDE FLOOD LIGHT, FLOOR MOUNTED, TO ILLUMINATE STAIR WALL, CAST ALUMINUM HOUSING, CYLINDRICAL SHAPE, WITH INTEGRAL COOLING FINS, CAST DOOR FRAME WITH LIMITED OPENING BY STOP ARM, REAR ONE PIECE LENS GASKET, ROTARY TYPE ANGLE ADJUST DRIVE, LOW VOLTAGE TUBE BALLAST, KIM # AF1170M120/BL-P780	SPECULAR ALUMINUM	70 W MH ALUMINUM	BLACK	THEATRE LOBBY	
B	RECESSED INCANDESCENT DOWNLIGHT SUITABLE FOR OVERHEAD CEILING, KURT VERSEN # C731 LITONIA # 3A48	CLEAR ALUMINUM REFLECTOR	100 W A-117 IF 130 V	BLACK	CONVENTION PRE-FUNCTION THEATRE	
B1	RECESSED HONEYCOMB VAPOR STEP LIGHT, 120V, MUFFLER # 930-7453-120V-2	E-17 MPL/DLK	300 W 130 V	WHITE	HOLLANDS AT STREET	
B2	DIRECT BURIAL UPLIGHT "MINI-FLOOD" BRONZE 703 SERIES		175 W MH	BLACK	HOLLANDS AT STREET	
C	SURFACE MOUNTED INCANDESCENT WALLWASHER, TO MATCH FIXTURE TYPE "A" SERIES, KURT VERSEN # 1508-BLACK		150 W E-18 FL 130 V	BLACK	CONFERENCE LOBBY	
C1	FLUORESCENT STRIP ASYMMETRIC REFLECTOR, 120 V E27, COLUMBIA # FS-100-100-PAR-4		740/120W	WHITE	THEATRE CONFERENCE ROOM	
D	INCANDESCENT DOWNLIGHT SUITABLE FOR RECESSED HOUSING IN CONCRETE, MUFFLER # 930-7453-120V-2	CLEAR ALUMINUM REFLECTOR	200 W A-117 IF 130 V	SATIN BLACK	CONVENTION ENTRANCE, THEATRE	
D1	CONTINUOUS A-LAMP STRIP, 2" x 4" EXTENSION, MEDIUM BASE, SOCKETS, 12" O.C., OVERALL LENGTH 2' x 4", 3 LAMPS TOTAL, REF # 714-7-10 ROBERT REIFER # 2001		40W IF A LAMP ALUMINUM 130 V	NATURAL	DRESSING ROOM	
E	EMERGENCY "TWO EYES" YORK COORDINATE IN FIELD			WHITE		
F	SURFACE MOUNTED QUARTZ UPLIGHT, 10" WIDE, 10" DEEP, 3" HIGH, WITH GLASS COVER, FINISH TO MATCH TYPE "A" SERIES, KURT VERSEN # 1955CC-BLACK		225 W T-4 PROVIDED 130 V	BLACK ENAMEL	CONVENTION CENTER BIG ROOM	
F1	QUARTZ UPLIGHT SIMILAR TO TYPE "F" KURT VERSEN # 1955CC-BLACK		225 W T-4 PROVIDED 130 V	BLACK ENAMEL	COMMUNITY MOUSE	
G	INCANDESCENT PERMANENT FIXTURE SUSPENDED AT 3'-0" ABOVE CEILING TOP, WITH WHITE GLASS, BLACK SHADE, AND BLACK CONO, 9" HIGH, 12" DIAMETER, LINDING GLASS # 4450 BLACK		100 W A-117 IF 130 V	BLACK	CONVENTION CENTER LOBBY	
G1	DIRECT BURIAL UPLIGHT, METAL HALIDE LAMP, SINGLE BRONZE CASTING OF HOUSING, CAST BRONZE COVER, ADJUSTABLE REFLECTOR, ANTI-SIPHON CHAMBER BETWEEN BALLAST AND HOUSING, COMPANIMENT, GROUT MAKE, 130 V RBY BALLAST, KIM # CL110M120/BL/P780/1034	CLEAR ALUMINUM REFLECTOR	100 W MH E-17	BRONZE	RE CORNER REAR REHEARSAL	
G2	DIRECT BURIAL METAL HALIDE UPLIGHT, SUITABLE FOR WALL MOUNTING, SIMILAR TO TYPE "G1", EXCEPT VERY WIDE FLOOD DISTRIBUTION, CAST ALUMINUM HOUSING, KIM # 3012 MH120	SPECULAR ALUMINUM REFLECTOR	100 W MH E-17	BRONZE	EXTENSION SIDE OF STAIR HALL	
G3	DIRECT BURIAL METAL HALIDE TO UPLIGHT CANOPY, SIMILAR TO TYPE "G1", EXCEPT WIDER DISTRIBUTION, HARBOR FLOOD	SPECULAR ALUMINUM REFLECTOR	100 W MH E-17	BRONZE	CONVENTION CENTER	
H	SURFACE MOUNTED FLUORESCENT 2 LAMP STRIP, MOUNTED 4" LONG, LITONIA # C216		(1)F40T12W	WHITE		
H1	BATTERY POWERED EMERGENCY VERSION OF TYPE "H" LITONIA # C216 EL		(1)F40T12W	WHITE		
L	RECESSED 2x4 FLUORESCENT GRID TRIGGER, TUBE ALUMINUM HOOR FRAME, 1/8" MINIMUM LENS, 120 V RBY E27, LITONIA 207 440 A12 125 27RES	A12 125 PRISMATIC ACRYLIC LENS	(4)F40T12W	WHITE	CONVENTION KITCHEN	
L2	RECESSED 2x4 FLANGED TRIGGER SIMILAR TO TYPE "L", NOT 210 A12 125 LENS	A12 125 PRISMATIC ACRYLIC	(2)F40 W	WHITE	CONVENTION TOILET OFFICE	
L3	RECESSED 2x4 PARABOLIC FLUORESCENT LOW INDEPENDENCE OPTICAL LOUVER, 3 1/2" DIA, 120 V OCTOON BALLAST, LITONIA # 2PMD P032	SPECULAR PARABOLIC OPTICAL LOUVER	(1)F032 130W	WHITE		
M	SURFACE MOUNTED 4" FLUORESCENT STRIP LITONIA # 8140		F40T12W	WHITE		
M1	4" FLUORESCENT STRIP, 120 V RBY E27, LITONIA # C172 120 E2		(1)F40T12W	WHITE	BOX OFFICE CYLINDER	
M2	SIMILAR TO M1 EXCEPT 1 LAMP WIDE LITONIA # C196		(1)F40T12W	WHITE		
M3	4" ONE LAMP STRIP, EMERGENCY BALLAST WITH BATTERY BACK, UP 120 W 277 V AS INDICATED SIMILAR TO M1 LITONIA # C196 EL					

ITEM	DESCRIPTION	LOADS	FINISH	LOCATION	SYMBOL
N	SURFACE MOUNTED FLUORESCENT UNDER-COUNTER FIXTURE, LENS OR SHOWN OF DRAWING ALSO # SUPER TRAC #115-R24				78 154
P	METAL HALIDE PARKING AREA LIGHT, POLE MOUNT AT 14' ON CONCRETE BASE, AERODYNAMIC HOUSING, COOLING RIBS, SEALED OPTICAL CHAMBER, KIM # 2818/130M120/BL-P14-25/1	MH 175 MH 250	GRAY BASED ON ENAMEL	PARKING LOT	
Q	1 1/2" DIA QUARTZ UPLIGHT, PERMANENT MOUNTED	200 W		CHILD CARE	
Q1	SIMILAR TO Q EXCEPT 2" DIA	300 W		THEATRE ALLEY	
R	PERMANENT SURFACE MOUNTED FLUORESCENT STRIP WITH HARBOR HOUSING OF BALLAST TUBE, 4 1/2" WIDE, 4" LONG, MOUNTED END TO END, REFRAY LIGHTING #211-4	F40T12		THEATRE OFFICE CORRIDOR	
R1	3 LAMP 4" STRIP, 277 V E27, COLUMBIA # FS-100-100-PAR-4	(3)F40T12	WHITE	REHEARSAL	
R2	2 LAMP 4" FLUORESCENT STRIP W/REFLECTOR	(2)F40T12	WHITE	SHOP	
T	RECESSED INCANDESCENT ADJUSTABLE ACCENT LIGHT, KURT VERSEN #7436			SPECULAR BLACK ALUMINUM ENAMEL	THEATRE DRAWING FOUNTAIN
T1	HONEYCOMB VAPOR STEP LIGHT, INTEGRAL LIGHT SHIELD, "BULLET" BRAD, CAST MARINE GRADE ALUMINUM, ROTABLE ON 3 AXES, WITH SELF-ADJUSTING TREE HOUSING BOX AND ROTARY LOW VOLT POWER FACTOR BALLAST, ALL ASSEMBLIES WATER TIGHT, GREENLEE 201-0-1739V-AD-120-T	175 W 40 CLEAR W/ MFL TEXTURED GRAB		POLYESTER POWDER TEXTURED GRAB	IN TREE
T2	HONEYCOMB VAPOR STEP LIGHT, INTEGRAL LIGHT SHIELD, "BULLET" BRAD, CAST MARINE GRADE ALUMINUM, ROTABLE ON 3 AXES, WITH SELF-ADJUSTING TREE HOUSING BOX AND ROTARY LOW VOLT POWER FACTOR BALLAST, ALL ASSEMBLIES WATER TIGHT, GREENLEE 201-0-1739V-AD-120-T	175 W 40 CLEAR W/ MFL TEXTURED GRAB		POLYESTER POWDER TEXTURED GRAB	BELOW TREES
U	WALL MOUNTED INCANDESCENT, ROUND ANODIZED ALUMINUM AND BLACK THERMOPLASTIC "AREA"	100 W A-117 IF 130 V	BLACK W/ ALUMINUM	THEATRE GREEN ROOM	
V	SURFACE MOUNTED ROUND FLUORESCENT "ASPIRIN", 1 1/2" DIA, 1 1/2" HIGH, WHITE, STAFF #140A	OPAL GLASS 2-1/2" W PL LAMP	WHITE	CONFERENCE BOX-OFFICE	
V1	"ASPIRIN" WALL MOUNTED				
W	SURFACE MOUNTED ADJUSTABLE INCANDESCENT SPOT, LITELAB # LP38-2-50PAR38-MH	50 W PAR 38 VNSP	BLACK	THEATRE LOBBY, STAIRS	
W1	SURFACE MOUNTED ADJUSTABLE SPOT, LITELAB LP38-2-120PAR38-MH	120 W PAR 38 VNSP	BLACK	ON ROOF	
X	METAL HALIDE FLOOD, 1500 W MH, 120V, WIDELITE # PH-1500-C	1500 W MH	GRAY	STAIR TOWER	
X1	METAL HALIDE FLOOD, 1500 W MH, 120V, WIDELITE # PH-1500-C	1500 W MH	GRAY	STAIR TOWER	
NOTES:  
1. FIXTURES SHOWN WITH TWO MANUFACTURER SOURCES WHERE POSSIBLE. REFERENCE SPECIFICATIONS FOR ALL APPROVED MANUFACTURERS. REFERENCE DIVISION 1 FOR SUBSTITUTIONS.  
2. LIGHTING SUBSTITUTIONS WILL BE CONSIDERED ONLY IF ACCOMPANIED BY CATALOG INFORMATION, PHOTOMETRICS, TESTING REPORTS AND IF REQUESTED SAMPLES OF THE ITEM TO BE SPECIFIED. SUBSTITUTIONS MUST BE REQUESTED IN WRITING PRIOR TO SUBMITTAL OF SHOP DRAWINGS. REFERENCE DIVISION 1 INSTRUCTIONS.

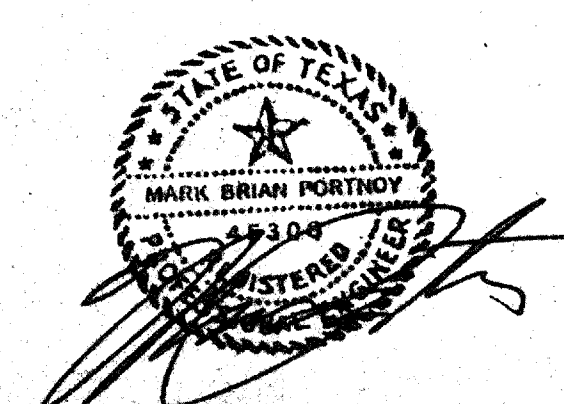

# ACC ACT

ADDISON

OWNER Texas of Addison	LANDSCAPE The Fellows Group 214-776-1417	STRUCTURAL Ellen Turner 214-681-8283	MECHANICAL Alton Moore 214-681-7822
ARCHITECT Covington Architects 2700 Fairwood Dallas, Texas 75201 214-655-5272	THEATRE CONSULTANT Theatre Project 203-438-2948 214-655-5272	M.E.P. NEP Systems 214-724-4744	LIGHTING Parsons Brinckerhoff 214-623-6542
INTERIORS CRSS 713-552-2000	CIVIL Kurtz & Associates 214-680-3222	GRAPHICS Wetzel Design 214-654-8789	