


ELECTRICAL LIGHTING PLAN - CONFERENCE

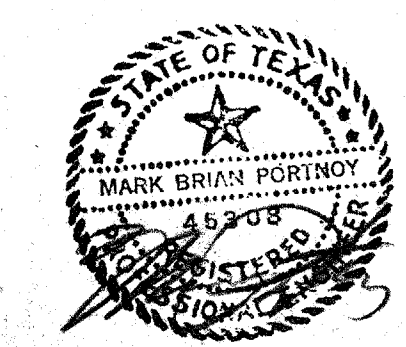

ACC ADDISON ACT

OWNER Town of Addison The Kellams Group 371-776-1417	LANDSCAPE Cunningham Architects 2700 Fairmount Dallas, Texas 75201 214-855-5272	STRUCTURAL Elisor Tanner 214-387-8333	HISTORIAN Alan Mason 214-681-782	Issue ISSUE FOR BID 8-17-90	Category 8	Subcategory 2	Sheet 1
ARCHITECT Cunningham Architects 2700 Fairmount Dallas, Texas 75201 214-855-5272	THEATRE CONSULTANT Theatre Projects 214-754-4741	M.E.P. MEP Systems 214-754-4741	LIGHTING Pamela Hull Wilson 214-823-8542				
INTERIORS CRSS 714-662-2000	CIVIL Kurtz & Associates 214-662-3322	GRAPHICS Northstad Design 214-964-8976					