



1 ELECTRICAL POWER PLAN - CONFERENCE

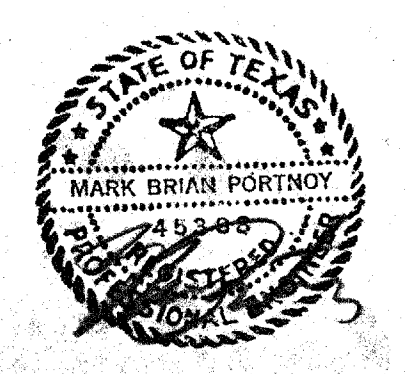

ACC  ACT

OWNER	LANDSCAPE	STRUCTURAL	HISTORIAN	Issue	Category	Subcategory	Sheet
Town of Addison The Kollins Group 307-716-4417	THEATRE CONSULTANT Cunningham Architects 2700 Fairmount Dallas, Texas 75201 214-855-5272	MEP MEP Systems 214-754-4741	Alan Mason 214-891-7822	ISSUE FOR BID 8-17-90	8	2	2
INTERIORS CRSS 713-652-2000		CIVIL Kurtz & Associates 214-680-3222	PANELING Panama Hall Wilson 214-823-8542				