


1 ELECTRICAL ROOF PLAN- THEATRE

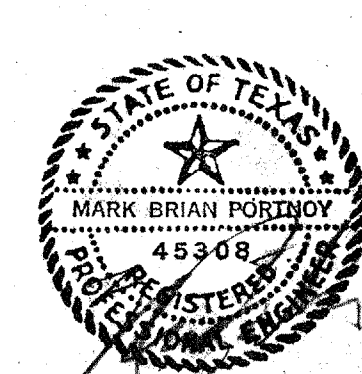

ACC ADDISON ACT

|   |  |  |  |                                |               |                  |            |
|---|--|--|--|--------------------------------|---------------|------------------|------------|
| OWNER<br>Town of Addison<br>The Kellams Group<br>317-75-1417                                | LANDSCAPE<br>The Kellams Group<br>317-75-1417                          | STRUCTURAL<br>Elisor Tanner<br>214-387-8393  | HISTORIAN<br>Alan Mason<br>214-691-7162        | Issue<br>ISSUE FOR BID 8-17-90 | Category<br>8 | Subcategory<br>2 | Sheet<br>7 |
| ARCHITECT<br>Cunningham Architects<br>2700 Fairmount<br>Dallas, Texas 75201<br>214-855-5272 | THEATRE CONSULTANT<br>Theatre Projects<br>203-431-3949<br>214-855-5272 | M.E.P.<br>MEP Systems<br>214-754-4789        | LIGHTING<br>Pamela Hall Wilson<br>214-823-8642 |                                |               |                  |            |
| INTERIORS<br>CRSS<br>713-552-2000   | CIVIL<br>Kurtz & Associates<br>214-693-3322                            | GRAPHICS<br>Northstar Design<br>214-954-9578 |  |                                |               |                  |            |