


1 ELECTRICAL PLAN- LEVEL 2 THEATRE POWER

NOTE  
SEE FNLED SCHED FOR  
MECH EQUIP CEILING

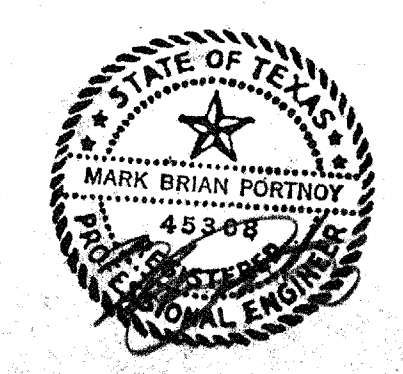

ACC ADDISON ACT

OWNER Town of Addison The Kellams Group 317-776-1417	LANDSCAPE Cunningham Architects 2700 Fairmount Dallas, Texas 75201 214-855-5272	STRUCTURAL The Kellams Group 317-776-1417	HISTORIAN Alan Mason 214-881-7882	ME P MEP Systems 214-754-4799	INTERIORS CRSS 710-552-7000	LANDSCAPE Cunningham Architects 2700 Fairmount Dallas, Texas 75201 214-855-5272	ME P MEP Systems 214-754-4799	CIVIL Kurtz & Associates 214-884-3322	HISTORIAN Alan Mason 214-881-7882	LIGHTING Pamela Hull Wilson 214-883-8842	MECHANICAL Hortelstad Design 214-884-8878	Issue ISSUE FOR BID 8-17-00	Category 8	Subcategory 2	Sheet 9
---	---	---	---	-------------------------------------	-----------------------------------	---	-------------------------------------	---	---	--	---	--------------------------------	---------------	------------------	------------