


1 ELECTRICAL PLAN- LEVEL 3 THEATRE POWER

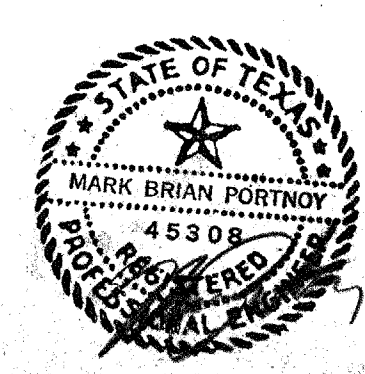

ACC ADDISON ACT

OWNER Towers of Addison The Kellams Group 371.776.1417	LANDSCAPE The Kellams Group 214.387.8383	STRUCTURAL Elisor Tenner 214.691.7822	HISTORIAN Alex Mason 214.691.7822	Issue ISSUE FOR BID 8-17-90	Category 8	Subcategory 2	Sheet 10
ARCHITECT Cawlingham Architects 2700 Fairmount Dallas, Texas 75201 214.855.5272	THEATRE CONSULTANT Theatre Projects 203.431.3949 214.855.5272	M.E.P. MEP Systems 214.754.4789	LIGHTING Parsons Hall Wilson 214.822.8542				
INTERIORS CRSS 703.552.2000		CIVIL Kurtz & Associates 214.890.3322	GRAPHICS Northland Design 214.854.8778				