
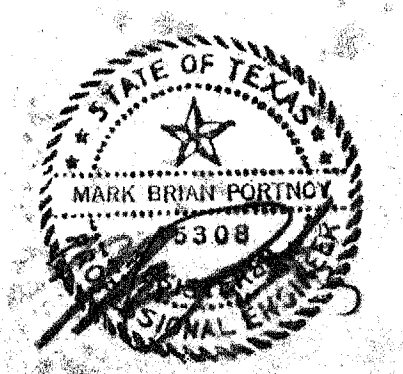


**1 THEATRICAL LIGHTING PLAN- LEVEL 1**

NOTE:  
 THEATRE WORK (SOUND, VIDEO AND  
 INTERCOMMUNICATIONS WORK, TERMINATION OF  
 THEATRE LIGHTING AND INSTRUMENTS, THEATRE  
 DIMMER WORK, STAGE RIGGING, STAGE  
 DRAPERIES) IS NOT PART OF THIS CONTRACT.  
 IT IS INCLUDED FOR INFORMATION AND  
 COORDINATION PURPOSES ONLY.

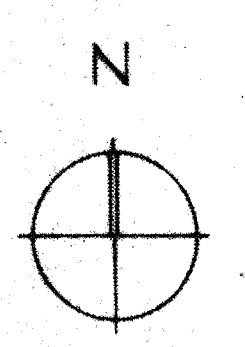

**ACC ADDISON ACT**

OWNER Town of Addison The Kellams Group 317-76-1417	LANDSCAPE The Kellams Group 317-76-1417	STRUCTURAL Elsor Tanner 214-387-8393	HISTORIAN Alan Mason 214-691-782	Issue ISSUE FOR BID 8-17-90	Category	Subcategory	Sheet
ARCHITECT Cunningham Architects 2700 Fairmount Dallas, Texas 75201 214-855-5272	THEATRE CONSULTANT Theatre Projects 203-431-3949 214-855-5272	M.E.P. MEP Systems 214-754-4789	LIGHTING Pamela Hull Wilson 214-823-8542		9	2	1
INTERIORS CRSS 713-552-7000	CIVIL Kurtz & Associates 214-880-3322	GRAPHICS Northstad Design 214-854-9778					