


1 THEATRICAL LIGHTING PLAN- LEVEL 2

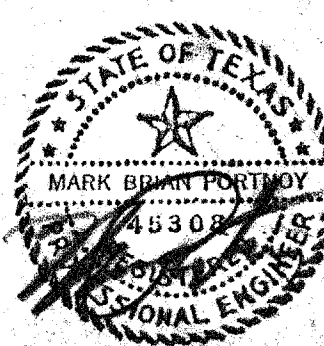

ACC ADDISON ACT

OWNER	LANDSCAPE	STRUCTURAL	HISTORIAN	Issue	Category	Subcategory	Sheet
Town of Addison 2700 Fairmount Dallas, Texas 75201 214-856-5272	The Killams Group 317-76-4017	Elisor Tanner 214-387-8393	Alan Mason 214-691-7862	ISSUE FOR BID 8-17-90	9	2	2
ARCHITECT Cunningham Architects 203-431-3945 214-856-5272	THEATRE CONSULTANT Theatre Projects 214-754-4789	M.E.P. MEP Systems 214-754-4789	LIGHTING Parsons Hall Wilson 214-822-8542				
INTERIORS CRSS 713-562-7000	CIVIL Karr & Associates 214-690-3322	ENGINEERS Northwood Design 214-864-8878					