


1 THEATRICAL LIGHTING PLAN- LEVEL 3

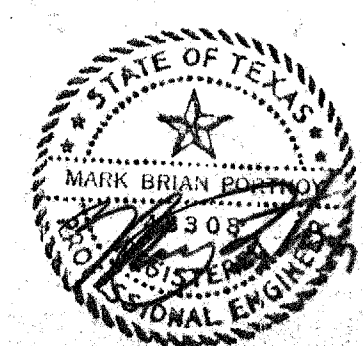

ACC ADDISON ACT

OWNER Town of Addison The Kellams Group 317-776-1417	LANDSCAPE The Kellams Group 317-776-1417	STRUCTURAL Elisor Tanner 214-387-8393	HISTORIAN Alan Mason 214-651-7182	Issue ISSUE FOR BID 8-17-90	Category 9	Subcategory 2	Sheet 3
ARCHITECT Cunningham Architects 2700 Farmout Dallas, Texas 75201 214-855-5272	THEATRE CONSULTANT Theatre Projects 203-437-3949	M.E.P. MEP Systems 214-754-4748	LIGHTING Pamela Hull Wilson 214-653-8542				
INTERIORS CRSS 713-552-2000	CIVIL Kurtz & Associates 214-654-3222	GRAPHIC Horizontal Design 214-654-8878					