


1 THEATRICAL LIGHTING PLAN- ROOF

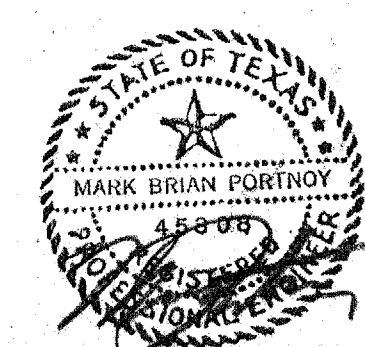

# ACC ADDISON ACT

|   |  |  |  |
|---|--|--|--|
| OWNER<br>Town of Addison  | LANDSCAPE<br>The Kellams Group<br>317-776-1417         | STRUCTURAL<br>Elisor Tanner<br>214-387-8393  | HISTORIAN<br>Alan Meen<br>214-691-7182         |
| ARCHITECT<br>Carrington Architects<br>2700 Fairmount<br>Dallas, Texas 75201<br>214-855-5272 | THEATRE CONSULTANT<br>Theatre Projects<br>203-431-3949 | M.E.P.<br>MEP Systems<br>214-754-4787        | LIGHTING<br>Pamela Hull Wilson<br>214-823-8642 |
| INTERIORS<br>CRSS<br>710-552-2000   | CIVIL<br>Kurtz & Associates<br>214-880-3322            | GRAPHICS<br>Northstad Design<br>214-854-9378 | Issue<br>ISSUE FOR BID 8-17-90                 |
|   |  |  | Category<br>9                                  |
|   |  |  | Subcategory<br>2                               |
|   |  |  | Sheet<br>4                                     |